


CONSTRUCTION PLANS
FOR
WATER SYSTEM IMPROVEMENTS
FOR

**HARRIMAN UTILITIES BOARD
HARRIMAN, TENNESSEE**

CONTRACT W93-04

WATER TREATMENT FACILITIES

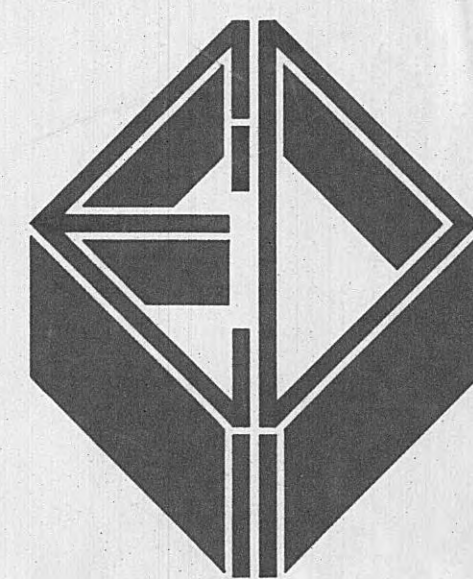


ELROD · DUNSON, INC.
CONSULTING ENGINEERS

Nashville · Knoxville
Lexington, KY

AS BUILT
DATE: 3-20-95
APPROVED: *[Signature]*

Accepted By: *Alvin B. Pole*
Title: *Chairman*
For: *Harriman Utility Board*
Date: *3-29-93*

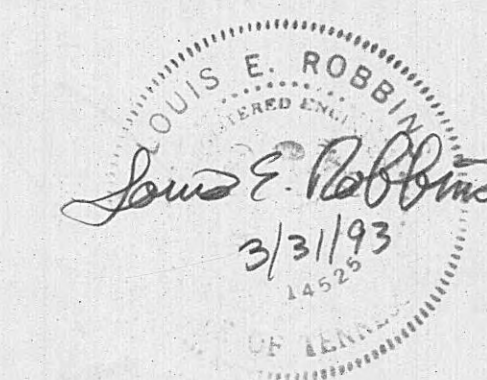


PROJECT NO. 0592


SET NO.

**Return to Engineering
Flat File Drawer 8**


Flat File Drawer

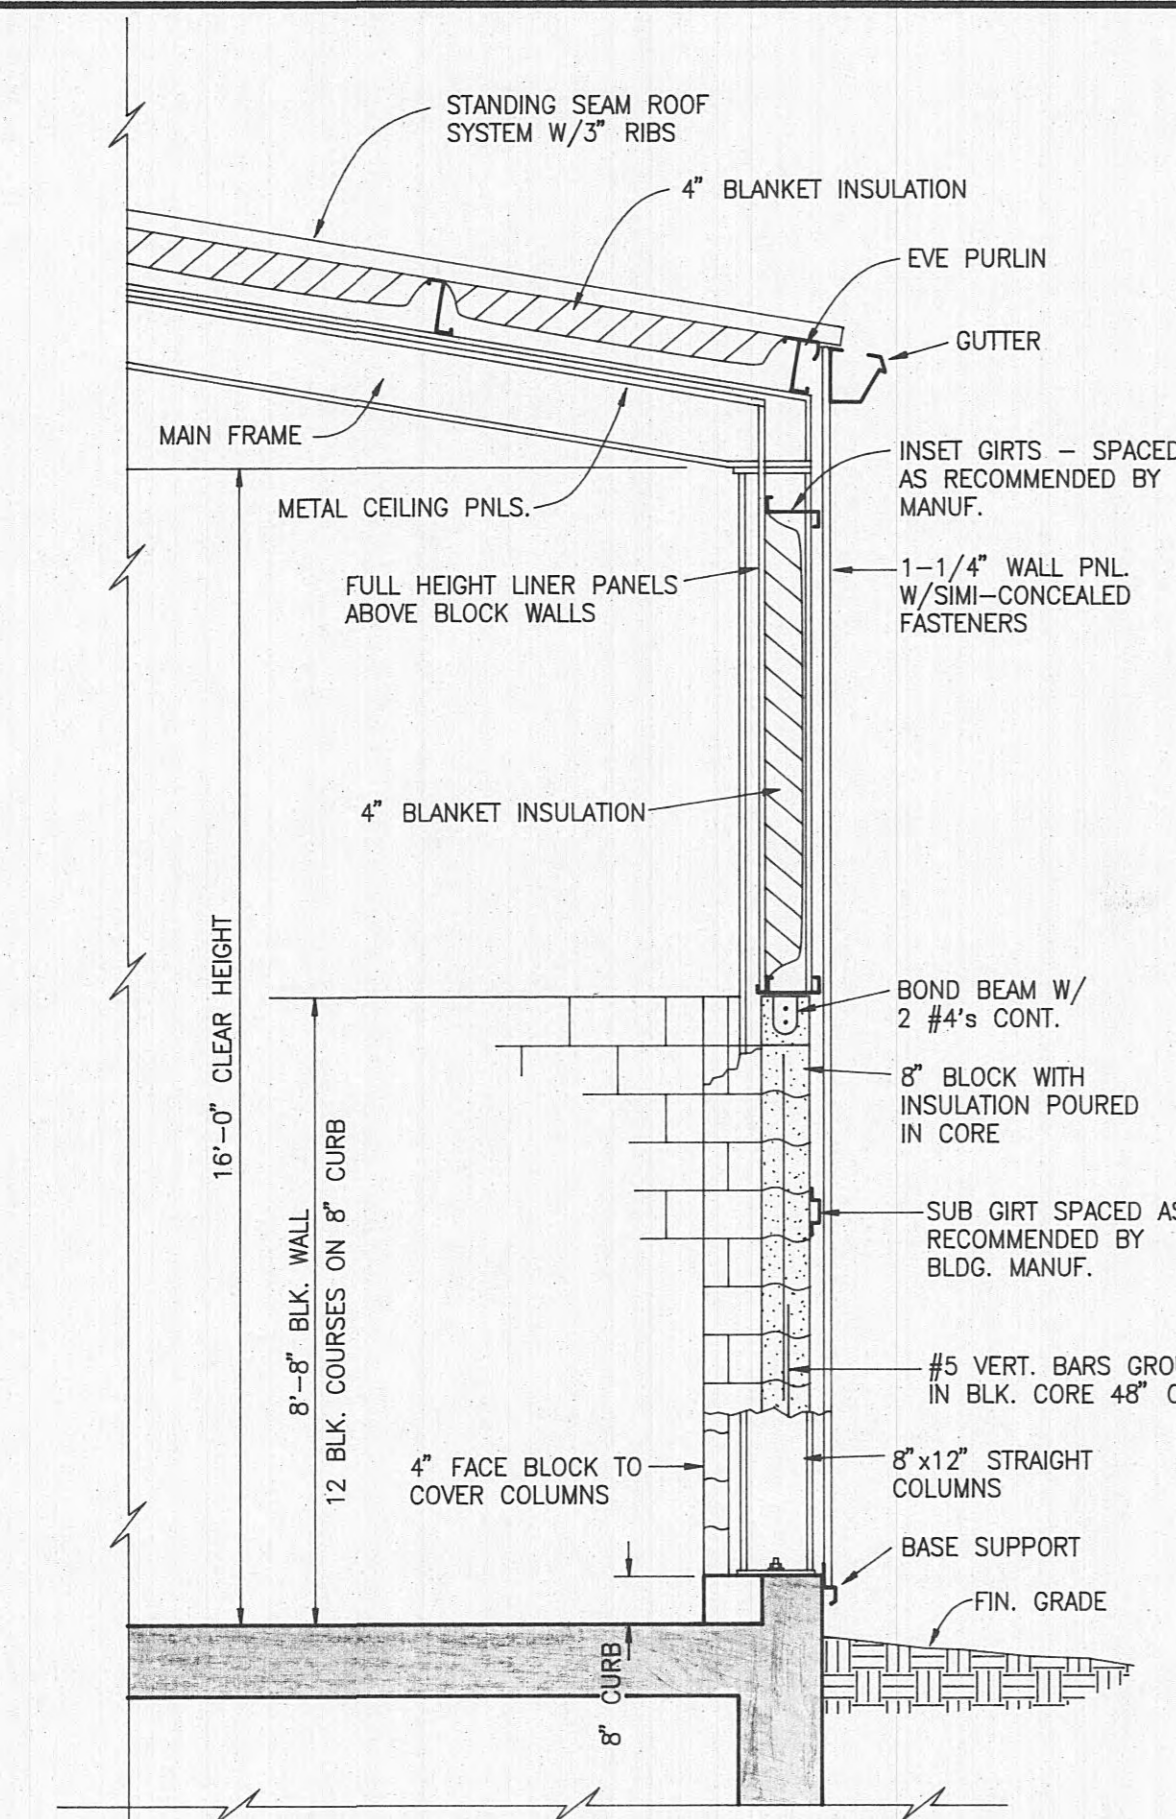


TYPICAL FILTER BLDG. WALL SECTION
SCALE: 3/8"=1'-0"

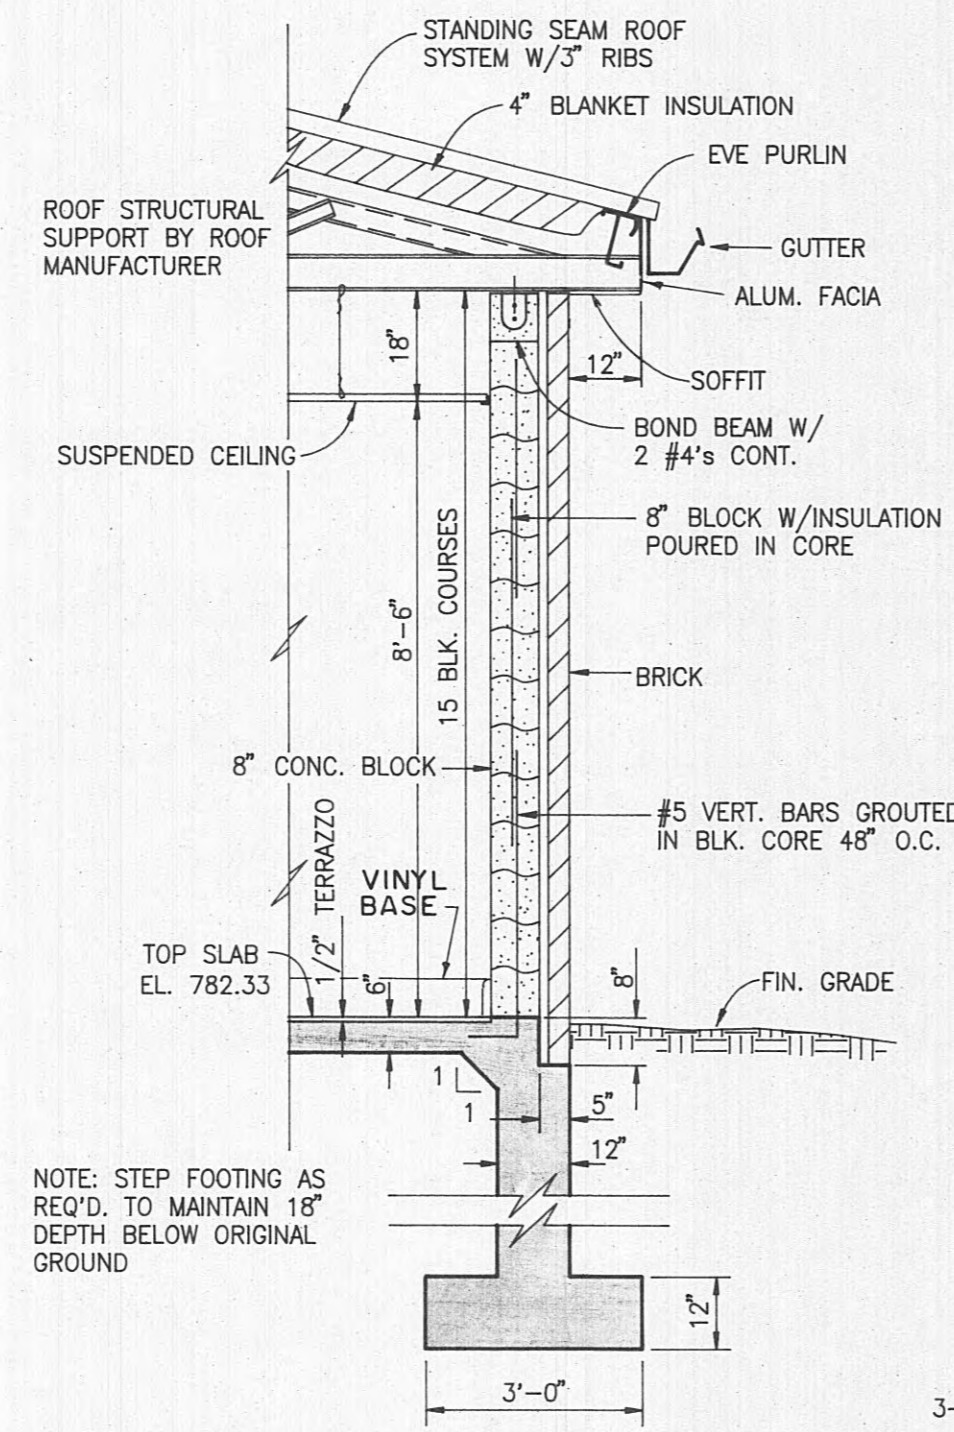


TYPICAL OPERATIONS BLDG. WALL SECTION
SCALE: 3/8"=1'-0"

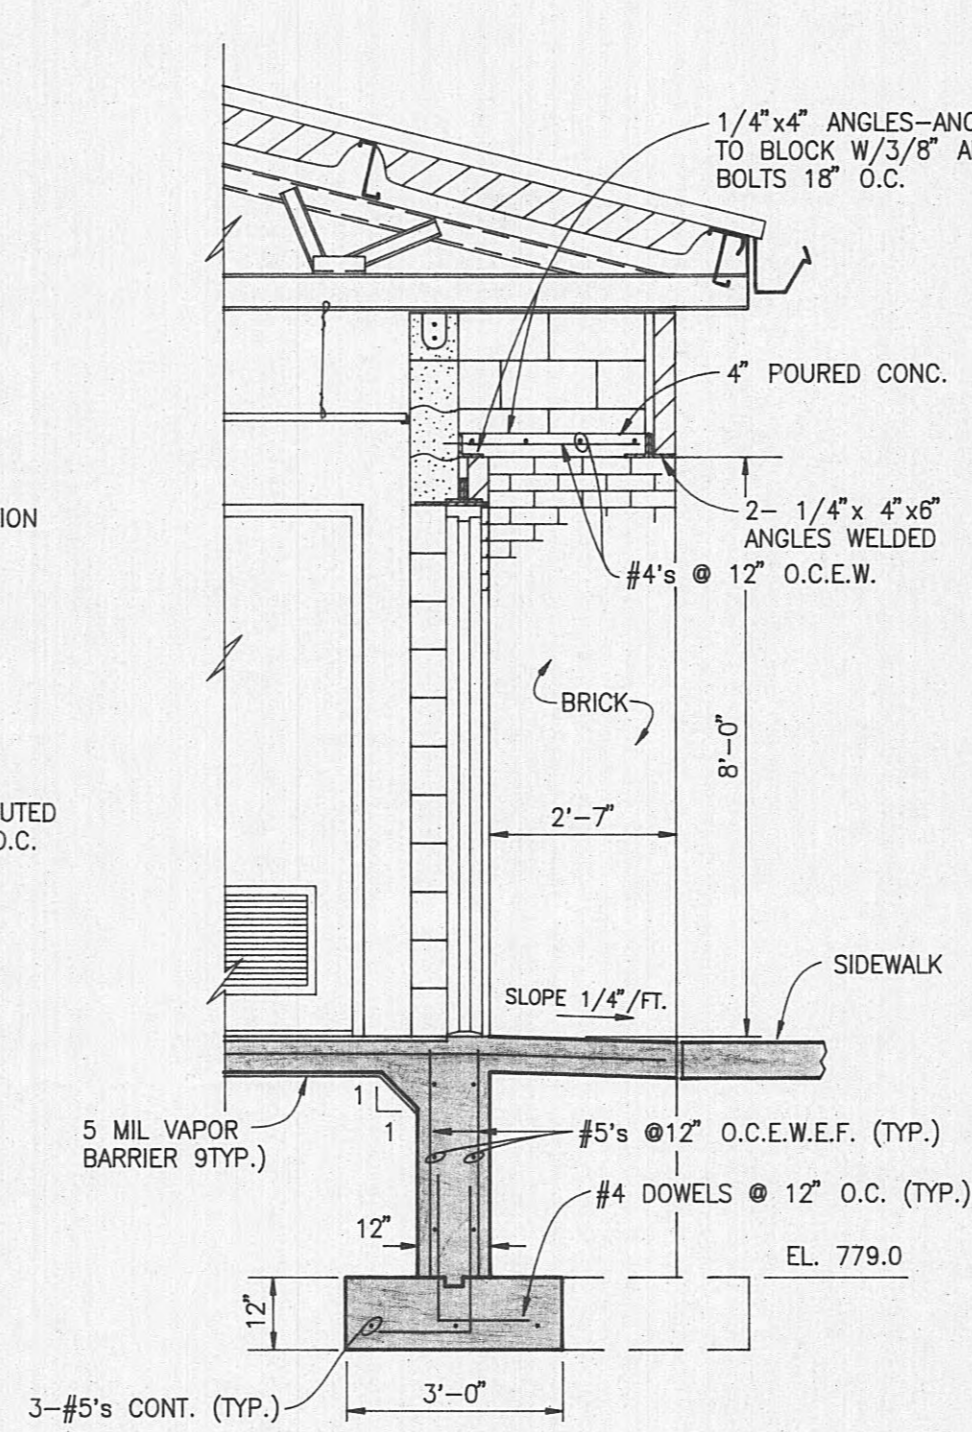


SECTION J-9
MAIN ENTRANCE SECTION
SCALE: 3/8"=1'-0"

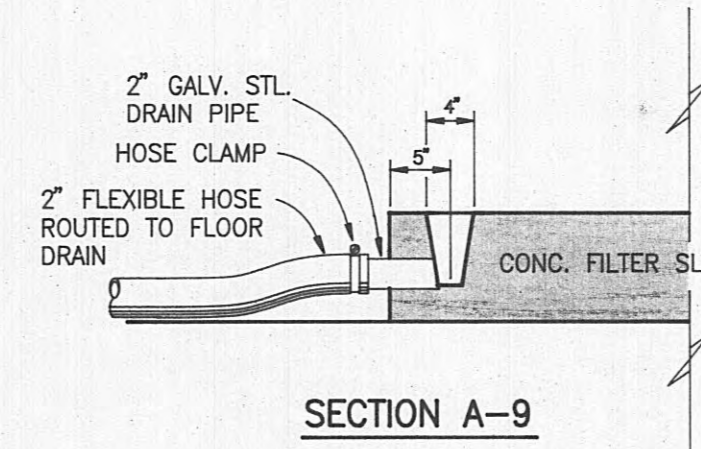


SECTION A-9

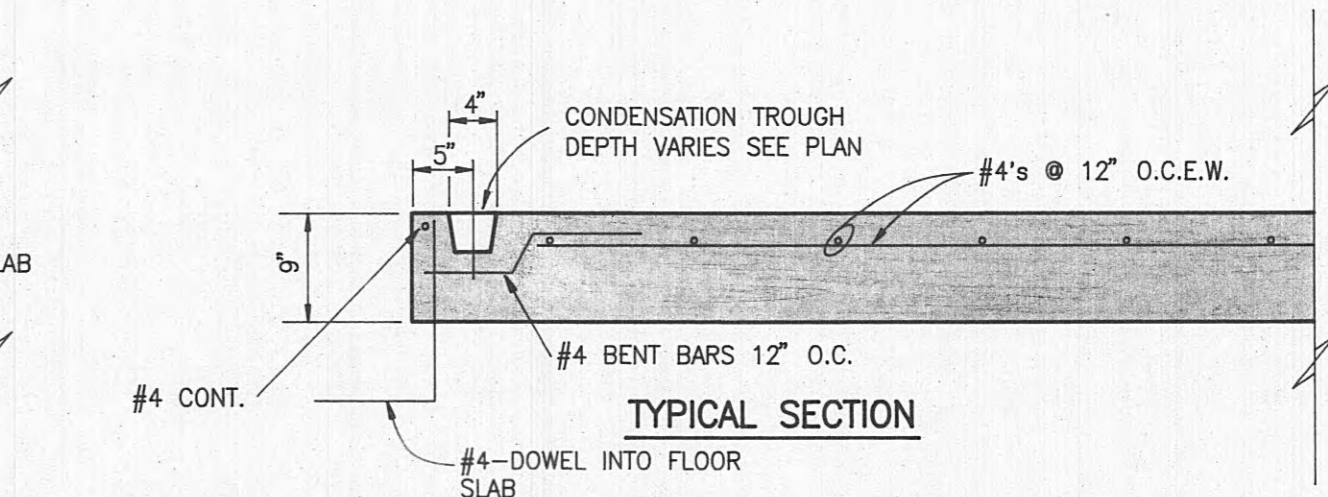


FILTER PAD DETAILS
SCALE: 3/4"=1'-0"

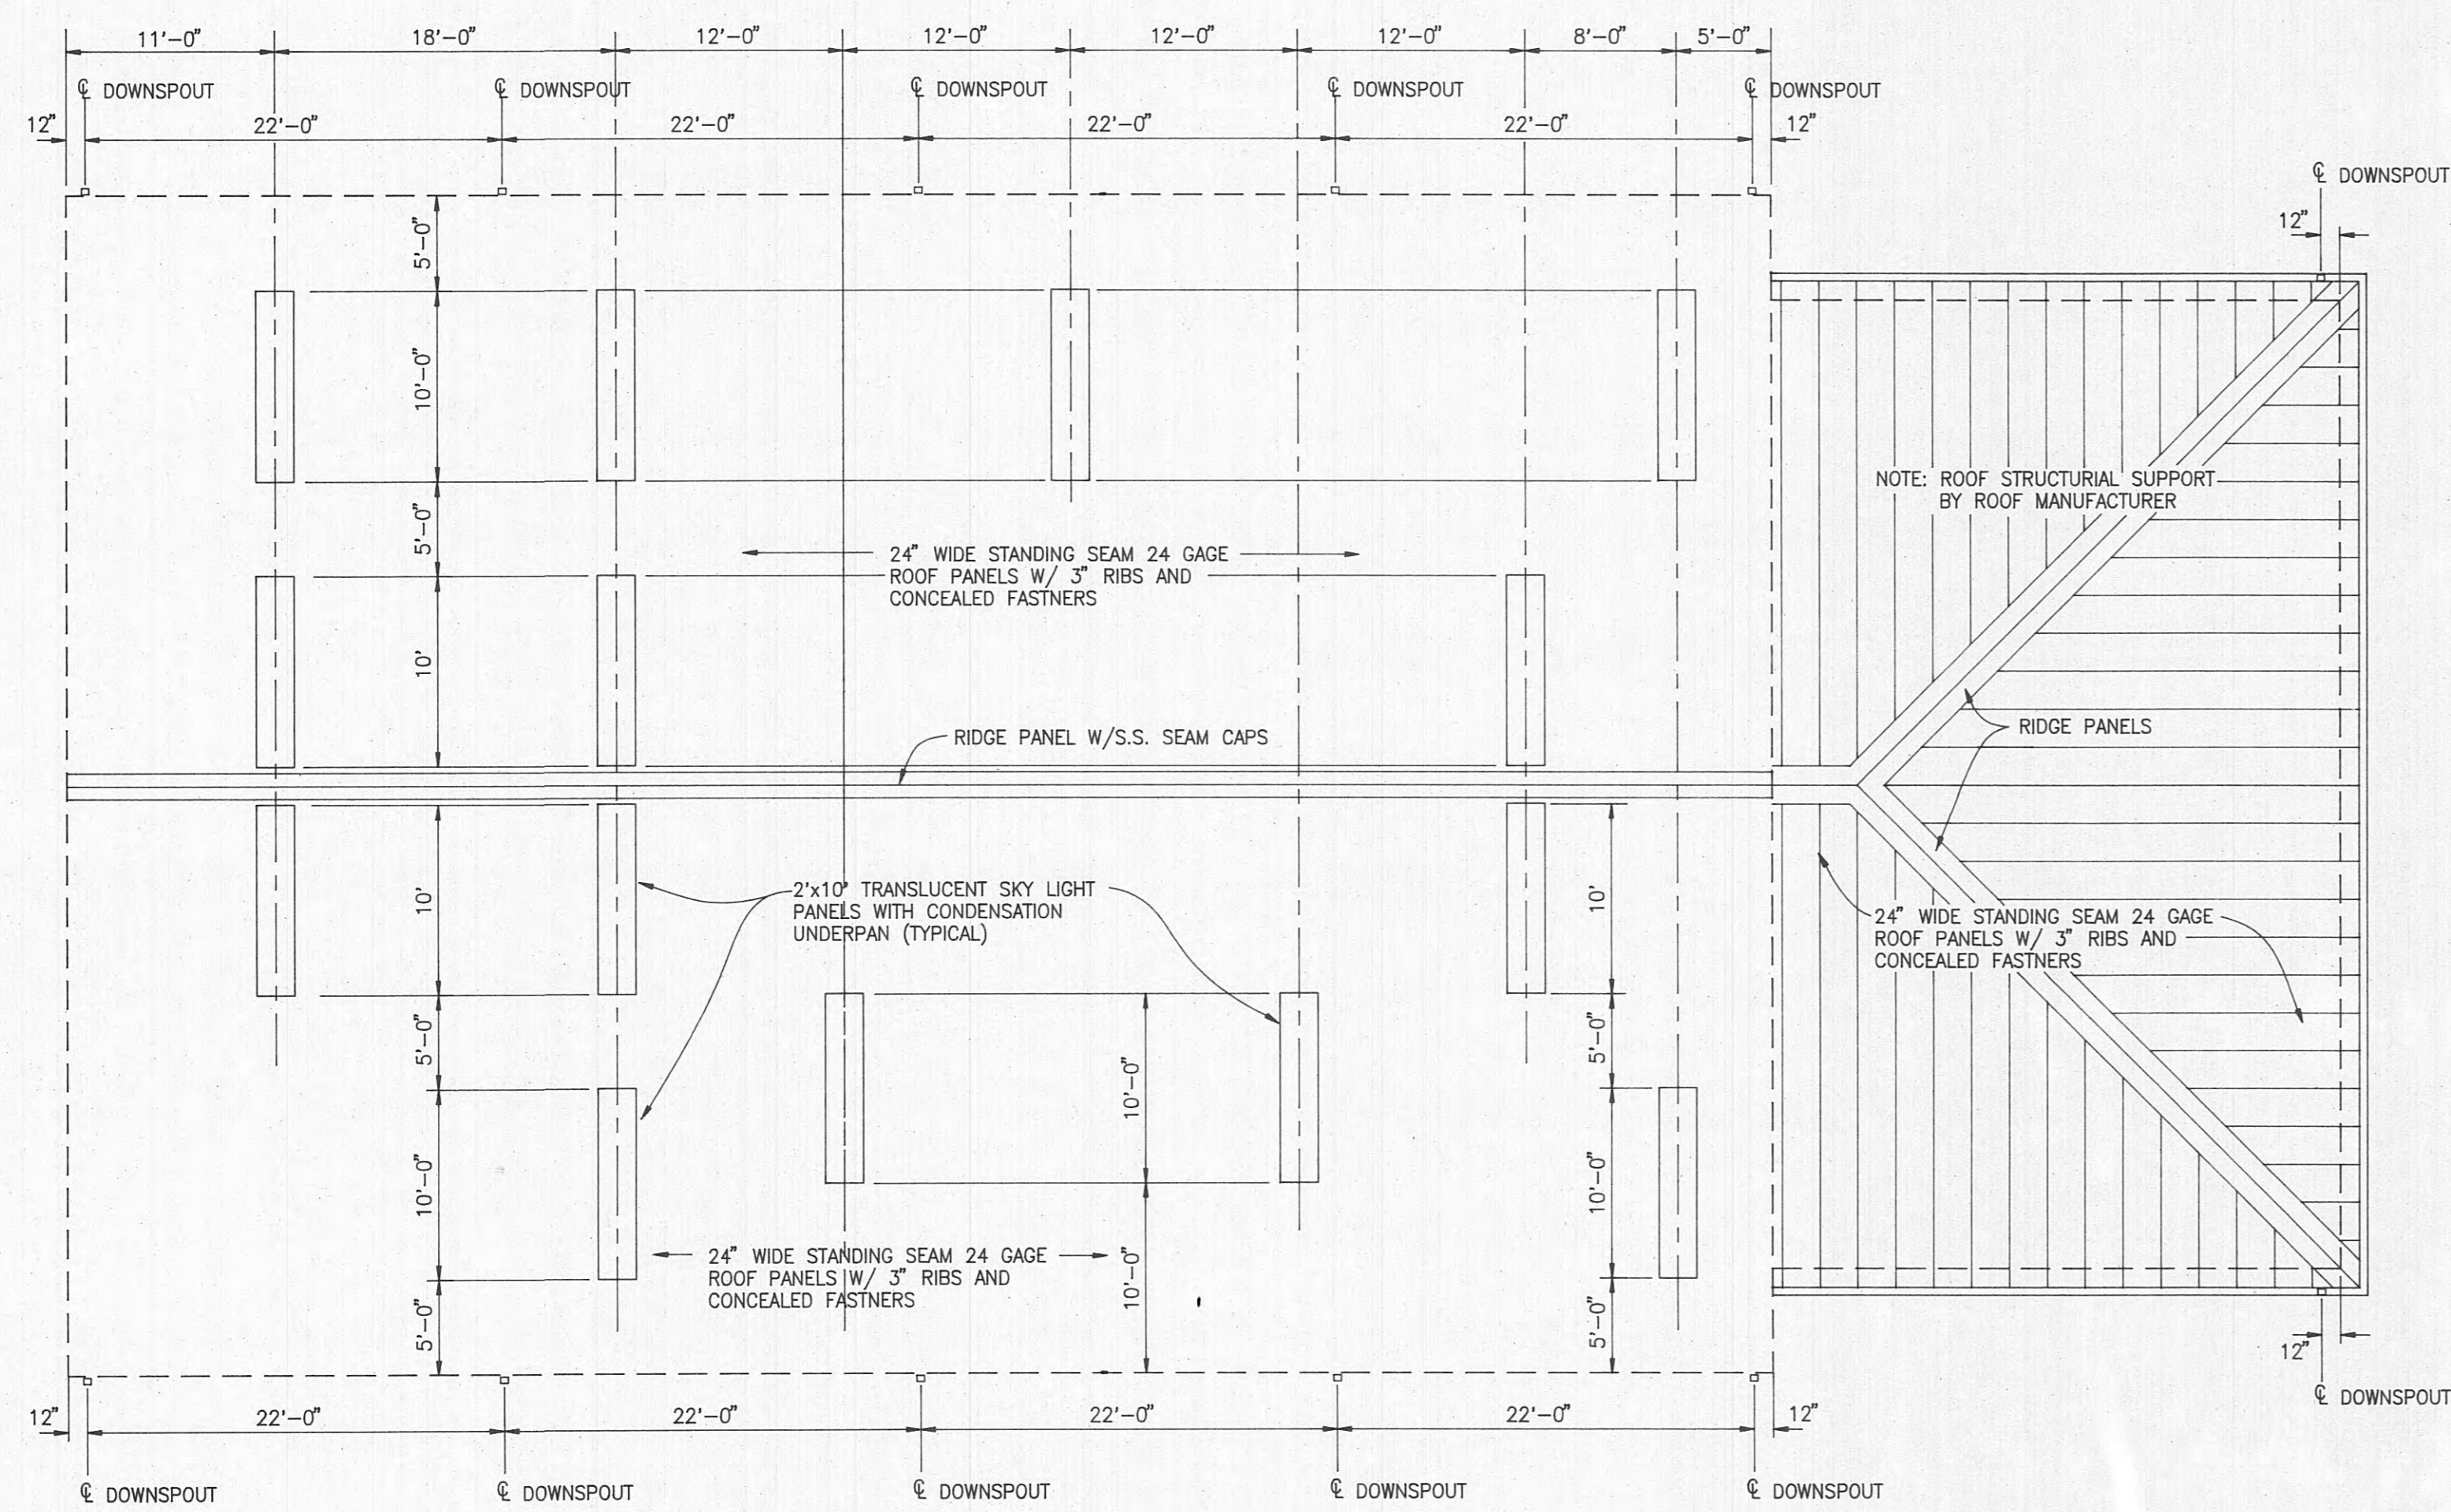

ROOF PLAN - FILTER/OPERATIONS BUILDING
SCALE: 1/8"=1'-0"

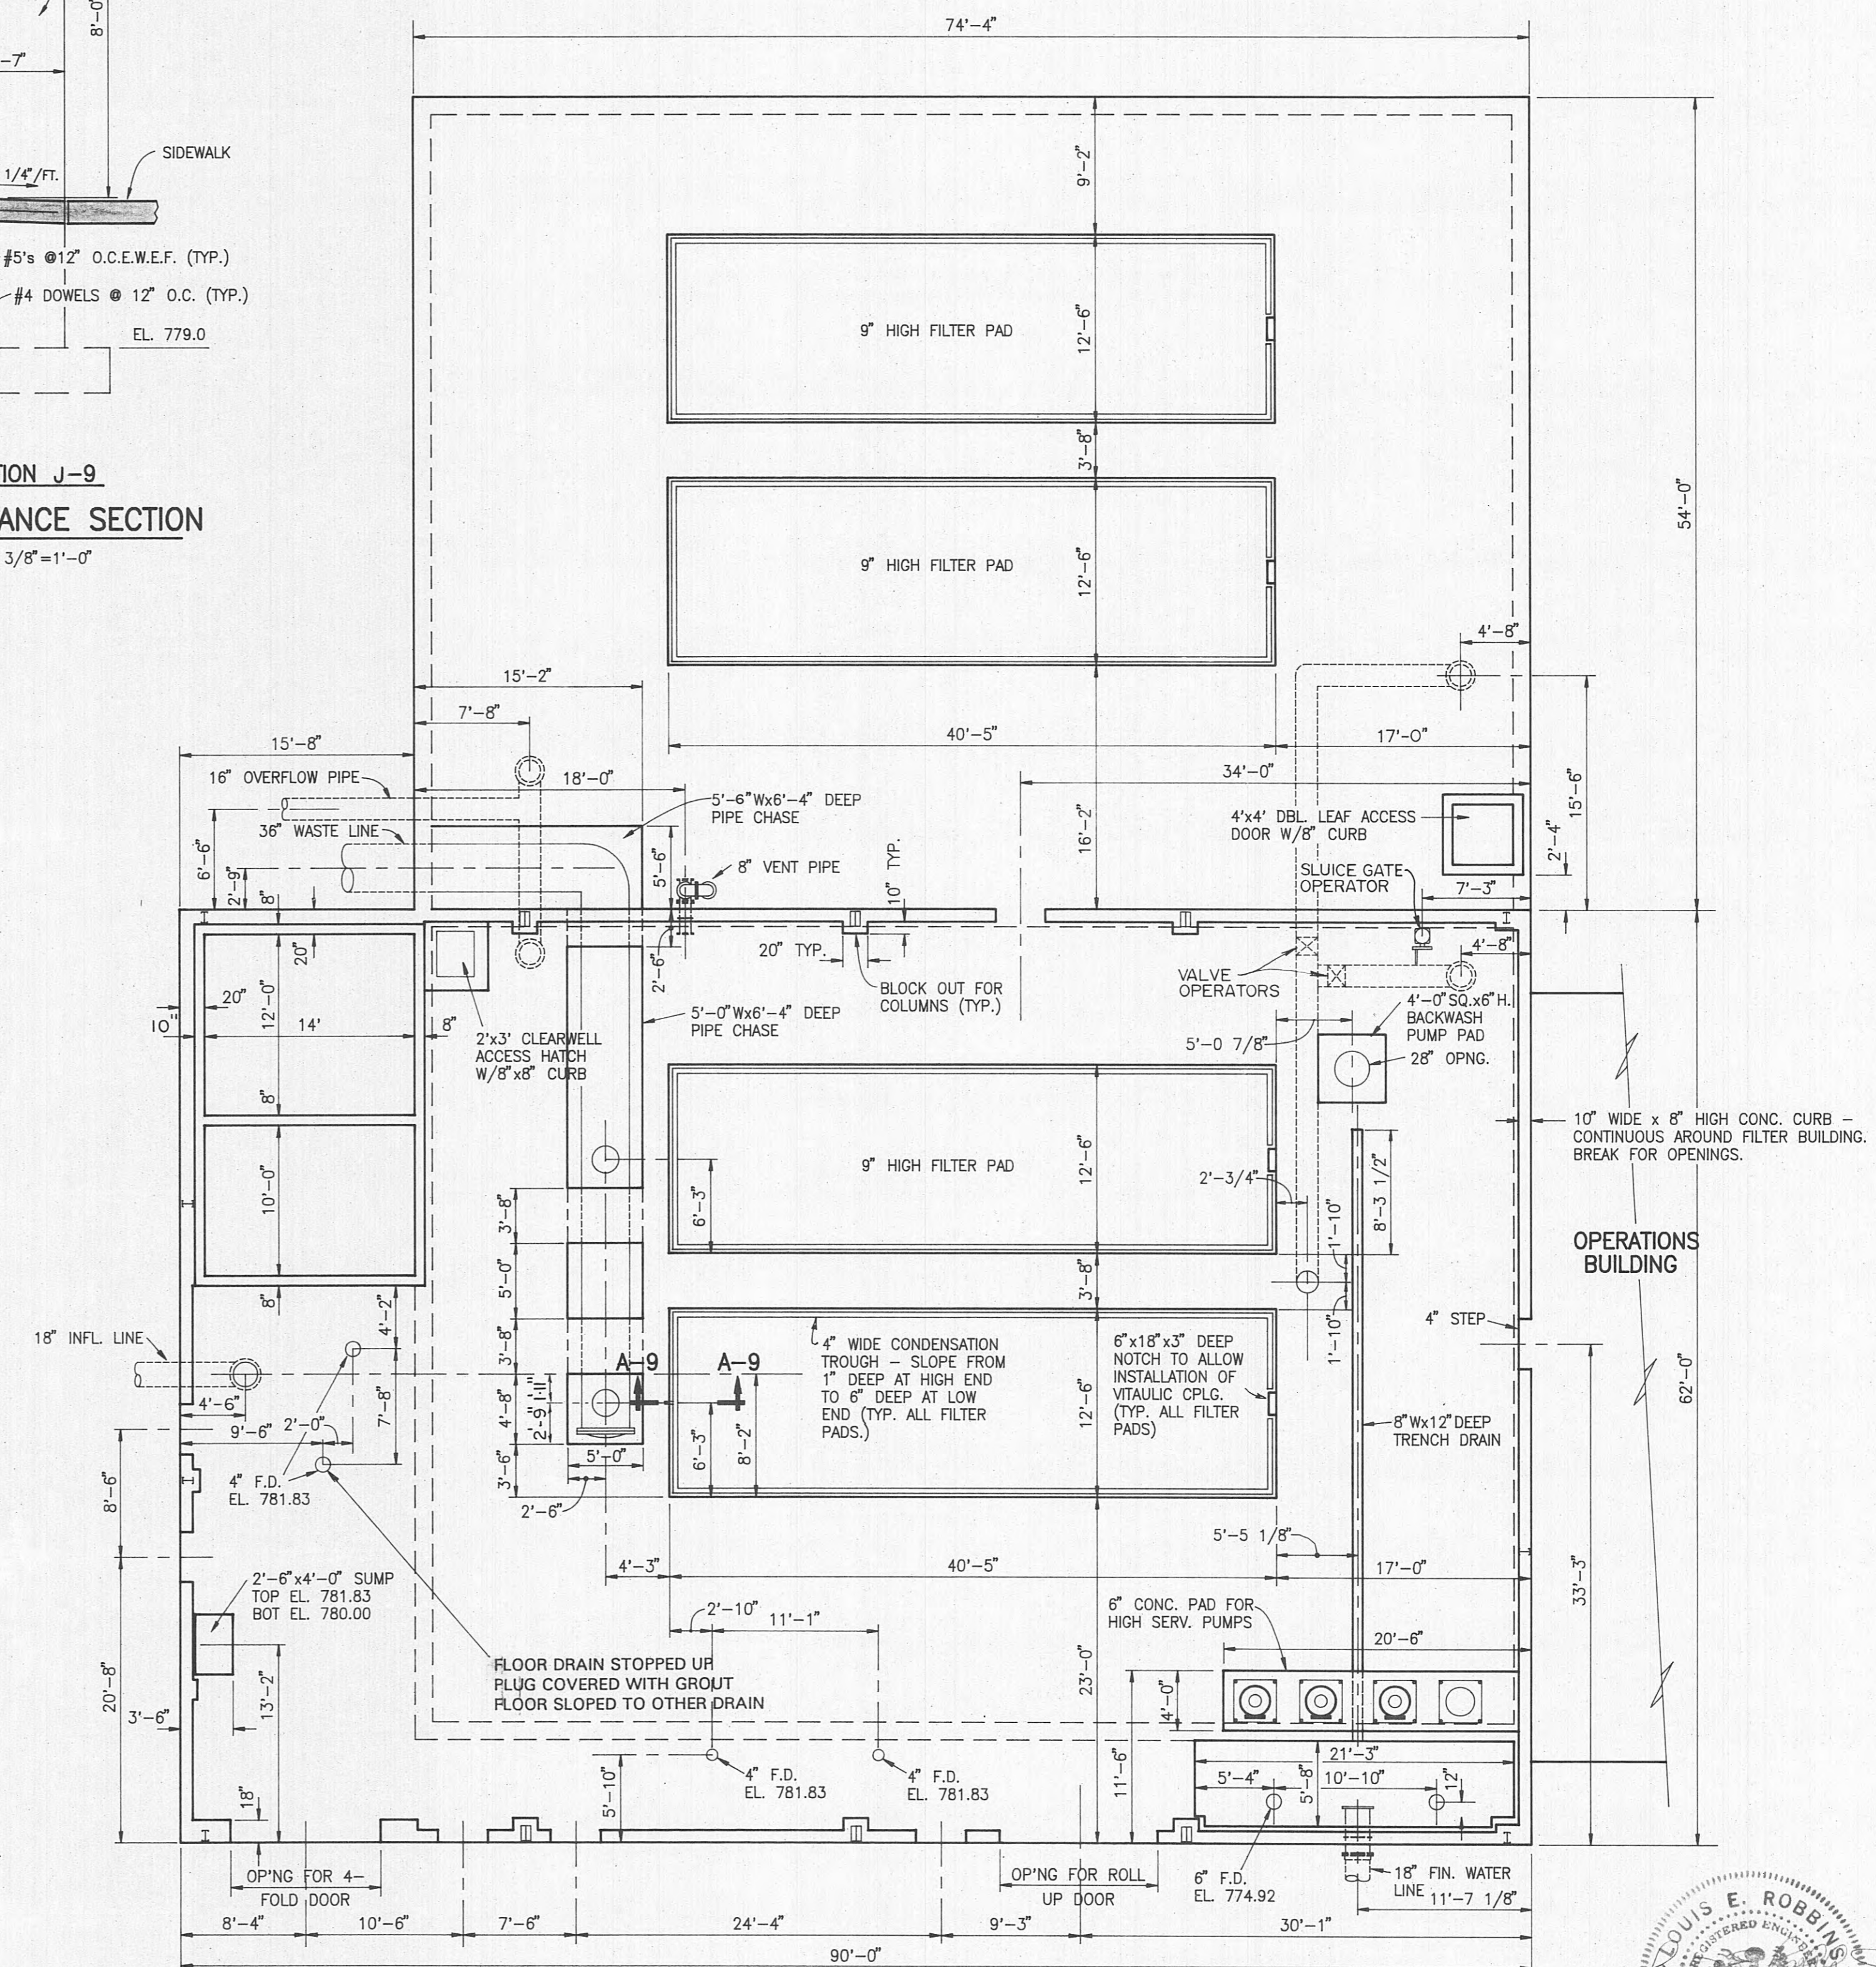

TOP PLAN - FILTER/BUILDING
SCALE: 1/8"=1'-0"

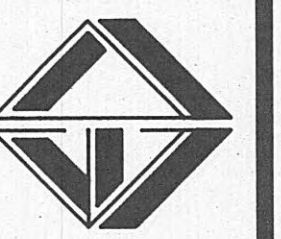


REVISIONS

4/19/93	ADDED TRENCH DRAIN AND PIPE CHASE
---------	-----------------------------------

DESIGNED: L.E.R.
DRAWN: S.C.G.
CHECKED: L.E.R.
DATE: MARCH, 1993
SCALE: NOTED
PROJ. NO. 0593




AS BUILT
DATE: 3-20-95
APPROVED: D.M.

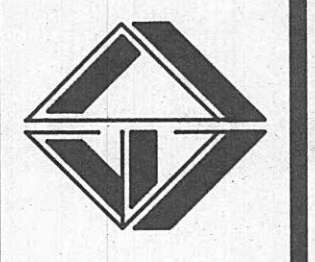


REVISIONS


DESIGNED: L. E. R.
 DRAWN: S. C. G.
 CHECKED: L. E. R.
 DATE: MARCH, 1993
 SCALE: AS NOTED
 PROJ. NO. 0592

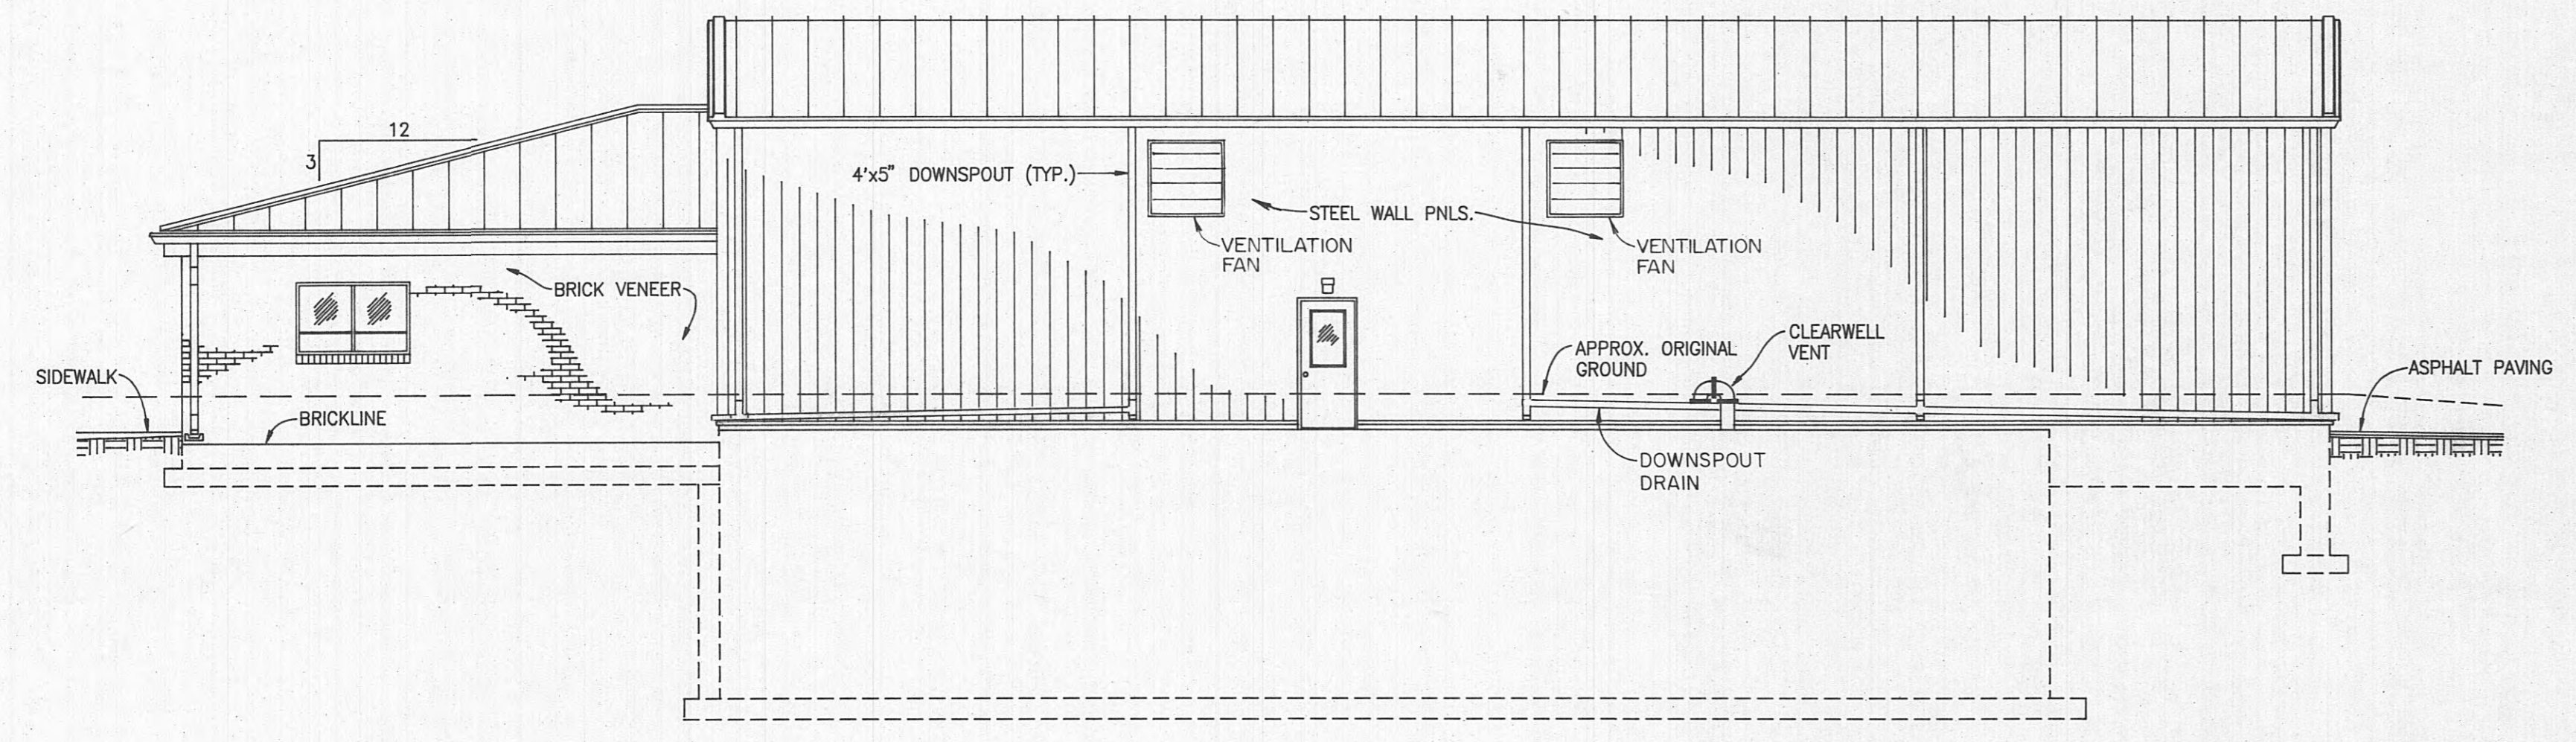


WEST ELEVATION
 SCALE: 1/8" = 1'-0"

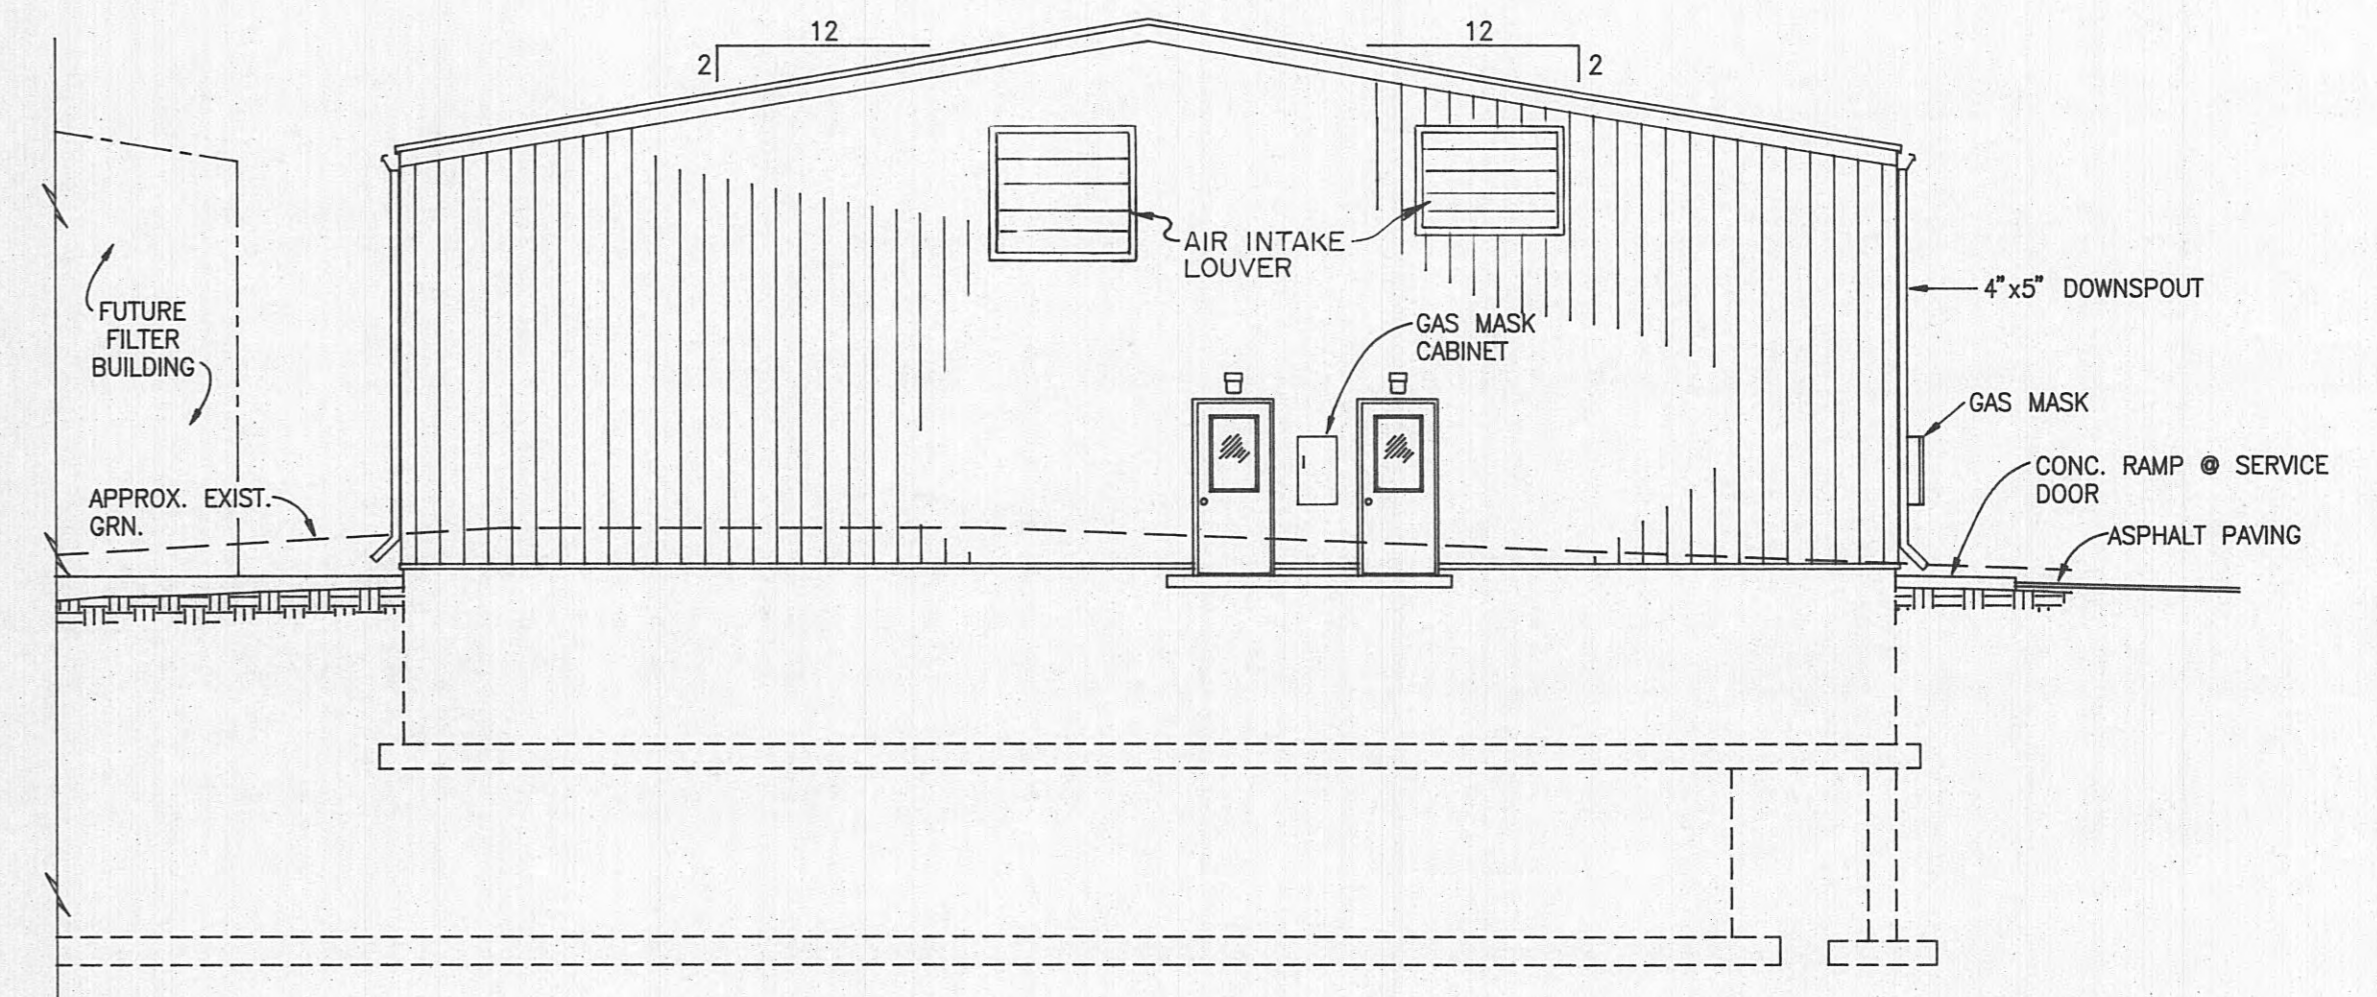


SOUTH ELEVATION
 SCALE: 1/8" = 1'-0"

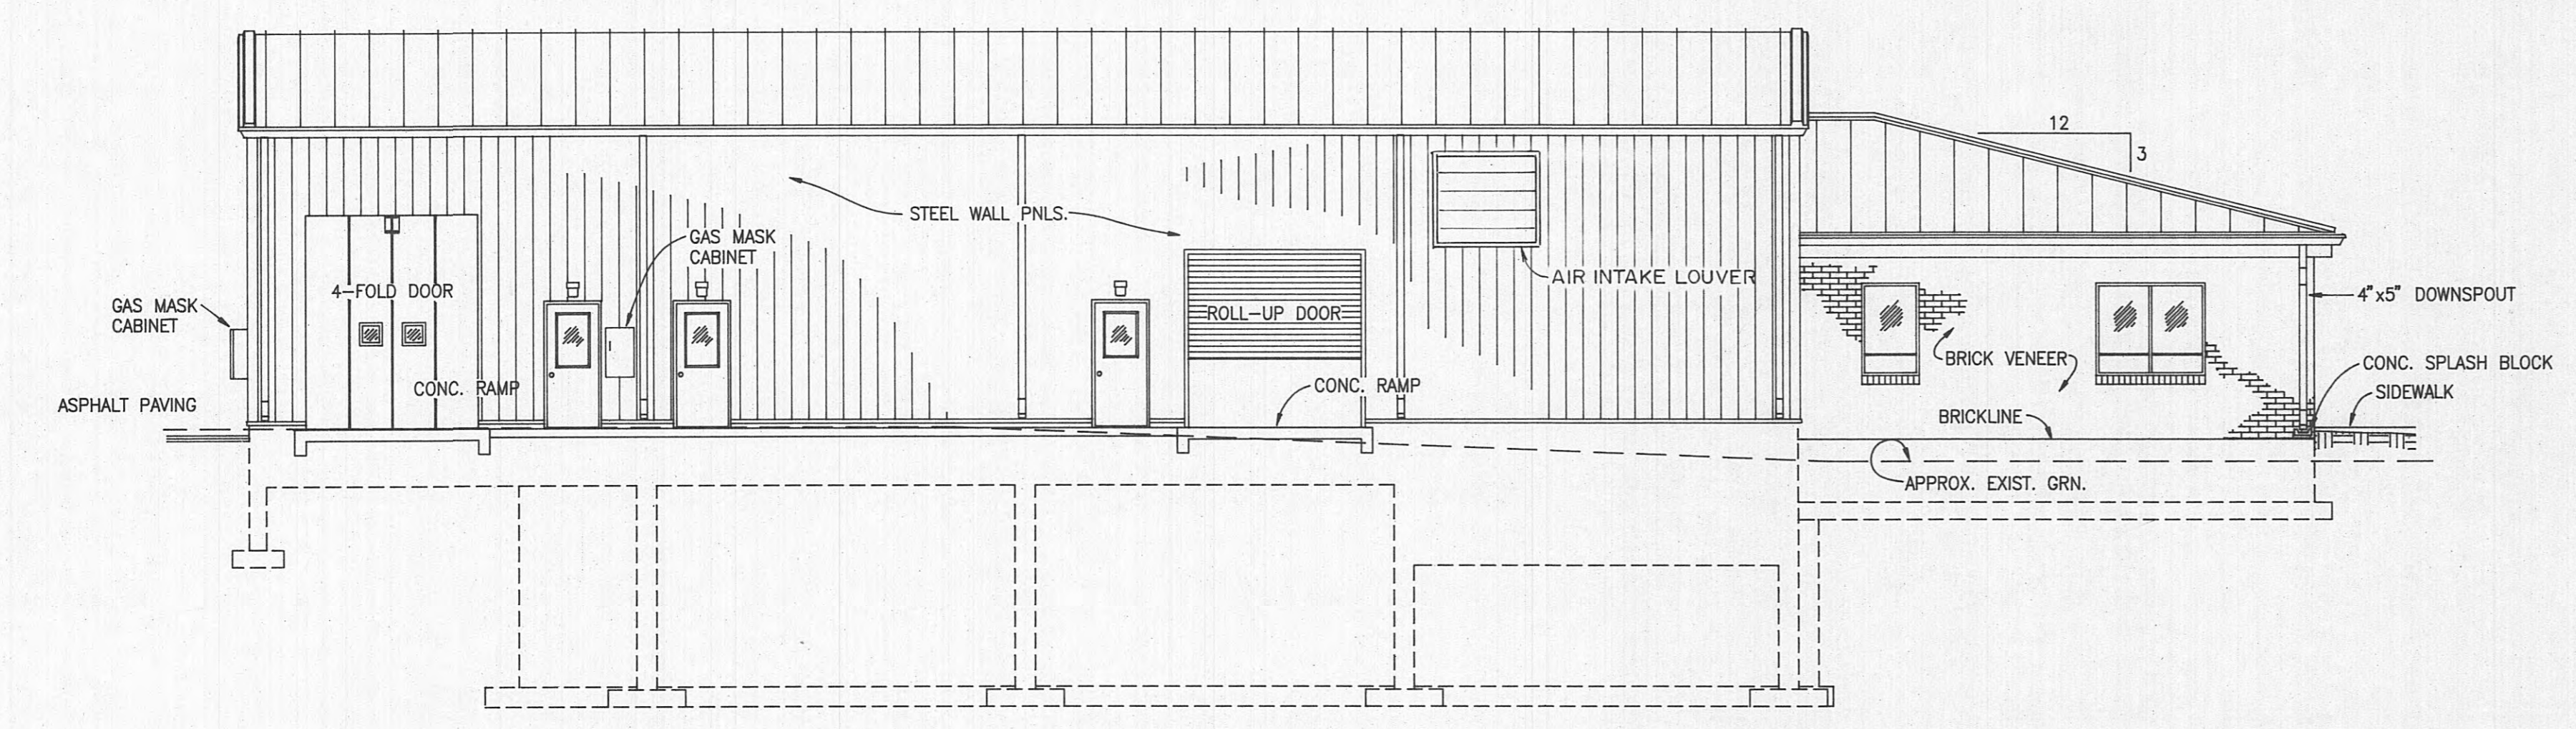


EAST ELEVATION
 SCALE: 1/8" = 1'-0"

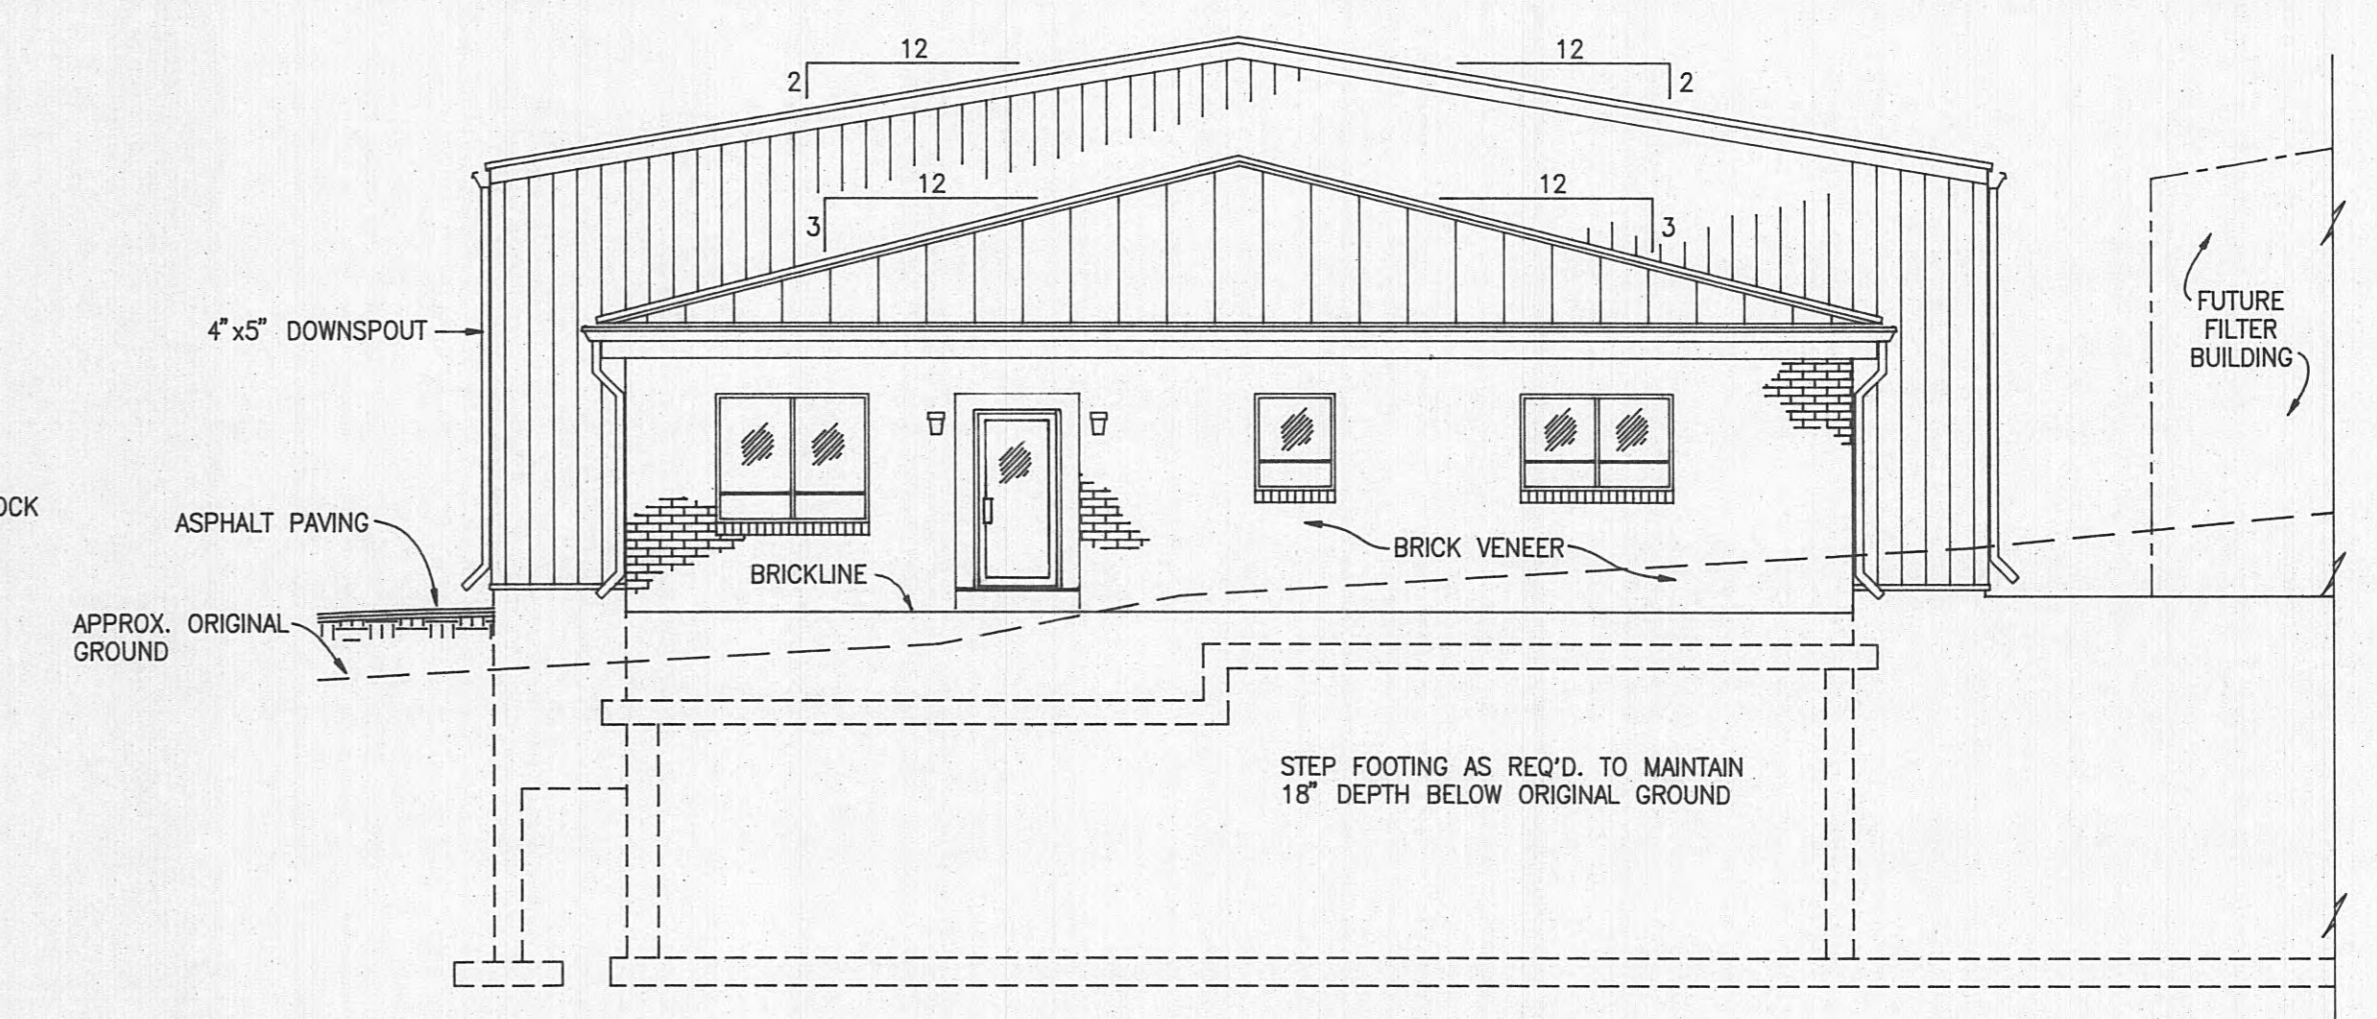

NORTH ELEVATION
 SCALE: 1/8" = 1'-0"

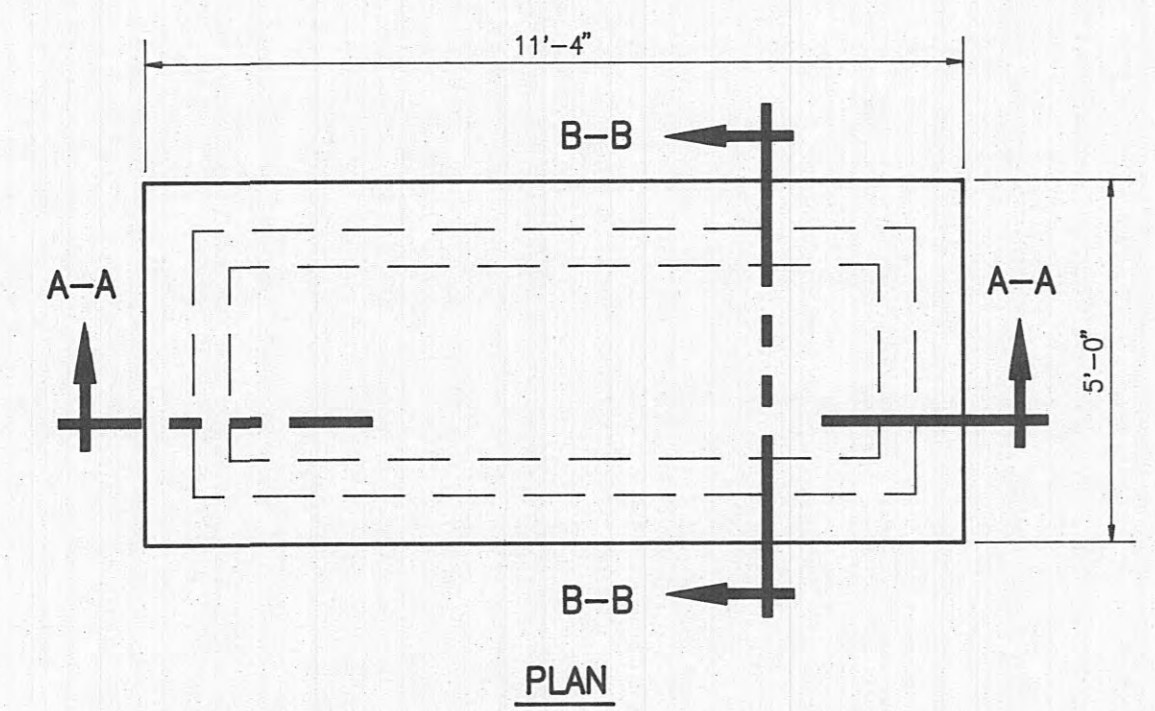


PLAN

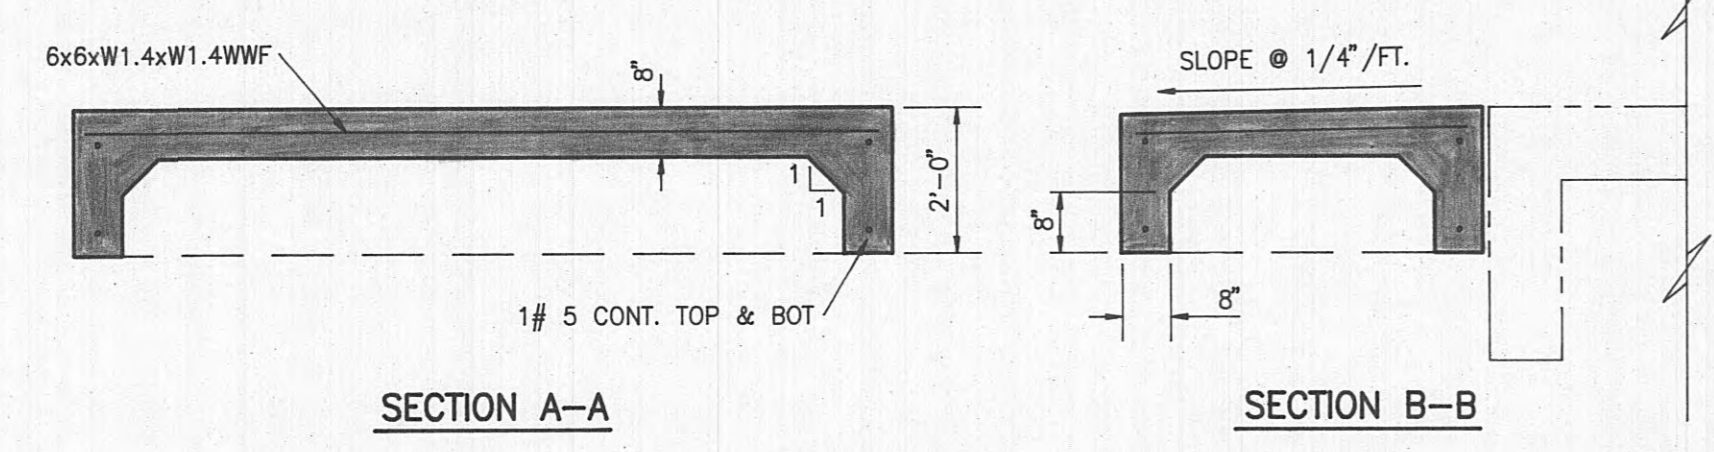

SECTION A-A

SECTION B-B

CONCRETE RAMP DETAIL
 SCALE: 3/8" = 1'-0"

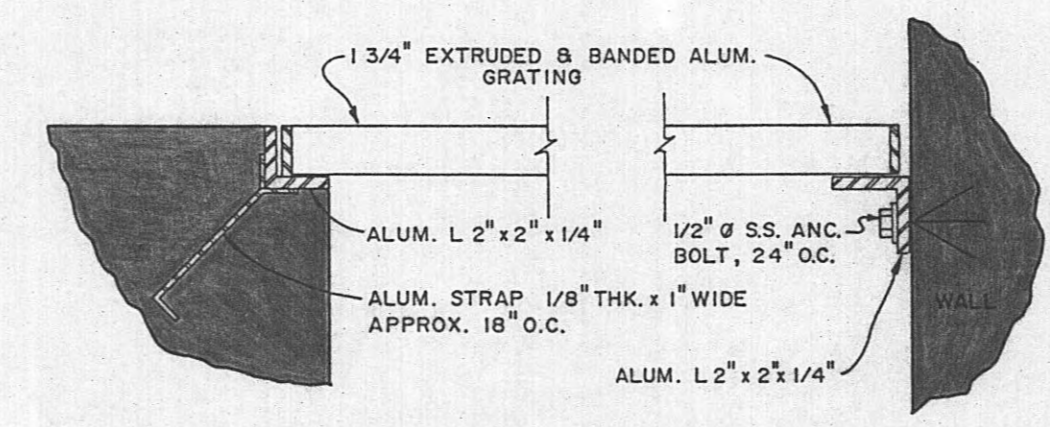

TYPICAL GRATING DETAIL
 NOT TO SCALE

DESIGN LOADS


1. WIND DESIGN DATA: BASIC WIND VELOCITY = 80 M.P.H., I = 1.0, SITE EXPOSURE FACTOR = C.
2. ROOF LIVE LOADS 25 PSF - NO REDUCTION IN LIVE LOAD PERMITTED FOR COLUMNS, RAFTERS, FRAMES & PURLINS. COLLATERAL LOAD 3 PSF.
3. SEISMIC DESIGN DATA: ZONE = 2, K = 1.0, I = 1.0.
4. DESIGN LIVE LOADS: SUPPORTED FLOORS - 200 P.S.F.


MISCELLANEOUS AND SUBMITTALS

1. METAL BUILDING TO BE DESIGNED IN ACCORDANCE WITH STANDARD BUILDING CODE AND ANSI A58.1 - 1982 STANDING SEAM ROOF SHALL BE 24 GAUGE.
2. PRE-ENGINEERED SYSTEMS


THE DESIGN OF PRE-ENGINEERED SYSTEMS SPECIFIED IN THE CONTRACT DOCUMENTS WHICH ARE DESIGNED/ENGINEERED BY OTHERS, IS THE SOLE RESPONSIBILITY OF THE SUPPLIER AND IT'S DESIGN ENGINEER LICENSED IN THE STATE OF THE PROJECT. SUBMITTALS OF SUCH SYSTEMS TO THE STRUCTURAL ENGINEER OF RECORD SHALL BE REVIEWED FOR CONFORMANCE WITH THE CONTRACT DOCUMENTS WITH REGARD TO THE ARRANGEMENT AND/OR SIZES OF MEMBERS SHOWN ON THE STRUCTURAL CONTRACT DOCUMENTS AND THE SUPPLIERS INTERPRETATION OF THE DESIGN INFORMATION INCLUDED IN THE CONTRACT DOCUMENTS. SUCH REVIEW BY THE STRUCTURAL ENGINEER OF RECORD SHALL NOT IMPLY ANY RESPONSIBILITY FOR THE ACTUAL DESIGN OF SUCH SYSTEMS. THE CONTRACTOR SHALL BE RESPONSIBLE FOR THE DIMENSIONAL ACCURACY AND CONFORMANCE WITH THE INFORMATION CONTAINED IN THE CONTRACT DOCUMENTS. SUBMIT 4 COPIES OF ENGINEERING CALCULATIONS.

AS BUILT
 DATE: 3-20-95
 APPROVED: D.M.

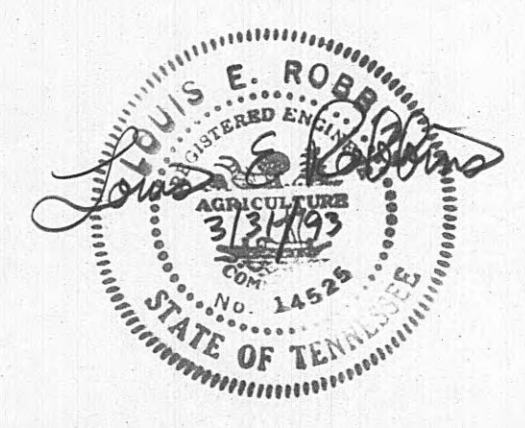


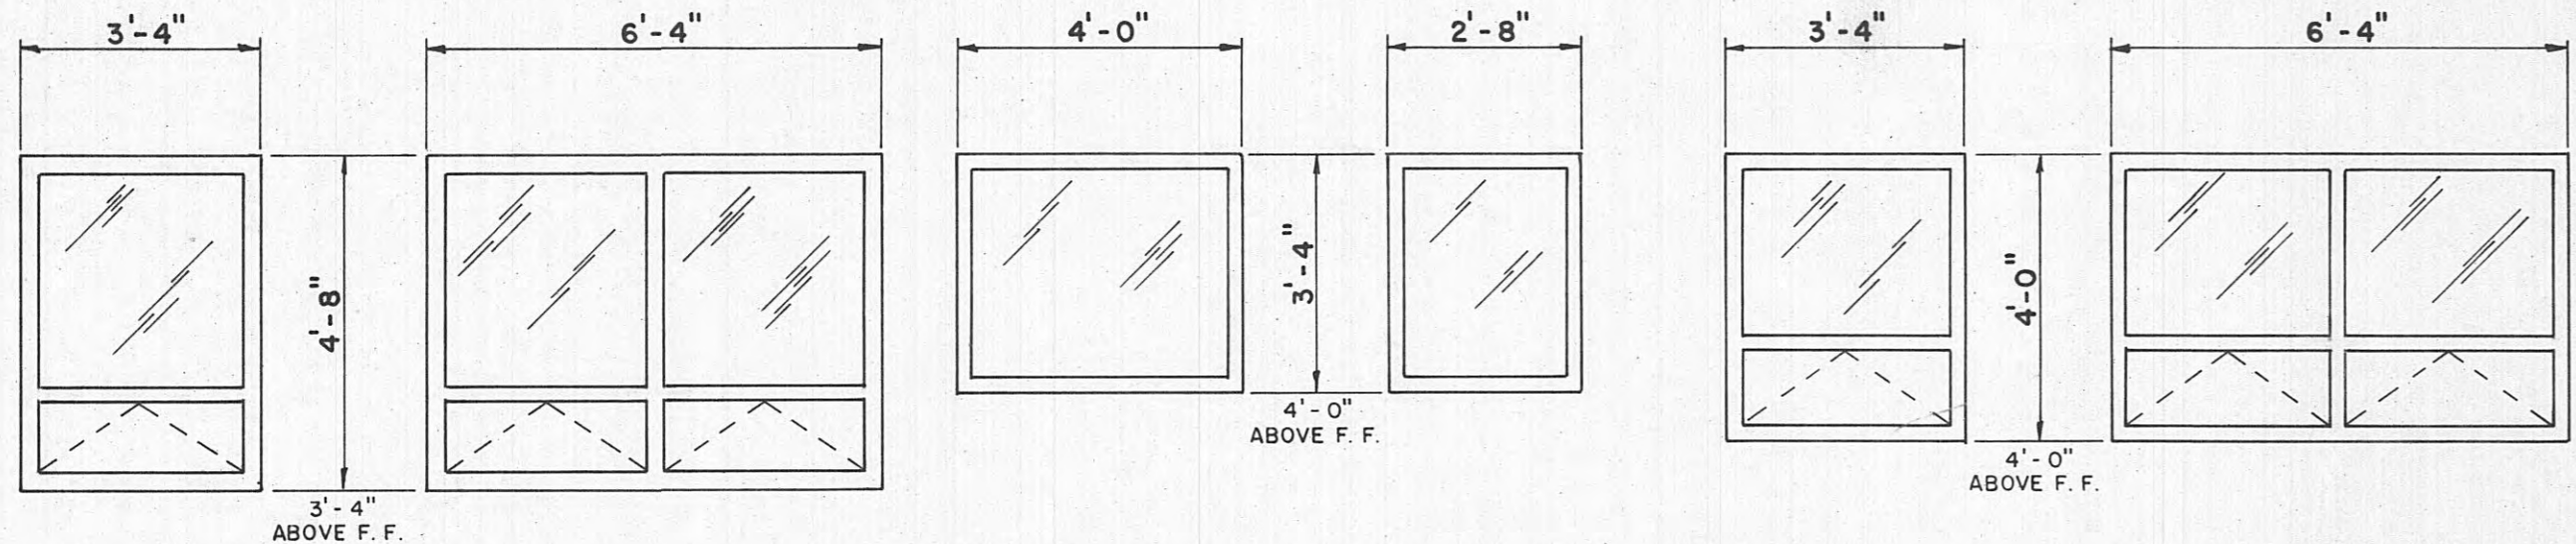


TYPE A TYPE B TYPE C TYPE F TYPE D TYPE E

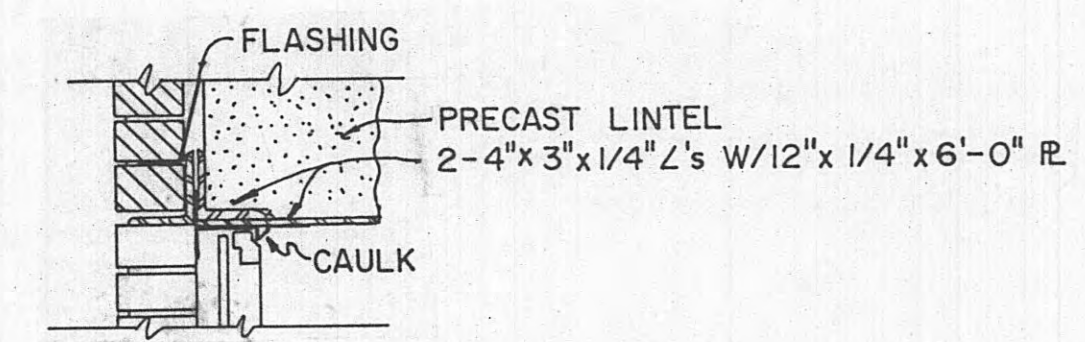


HEAD A

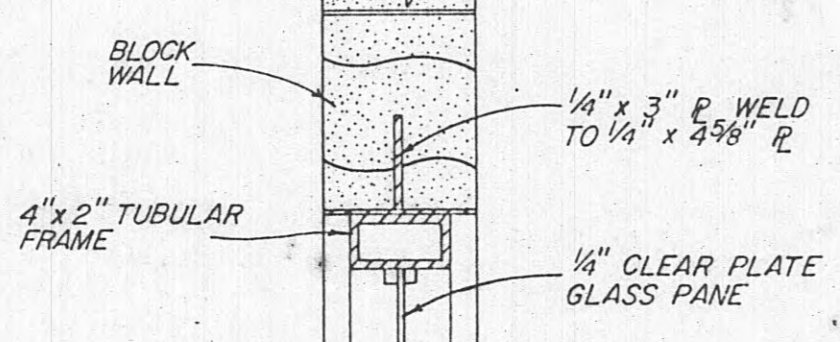


HEAD B

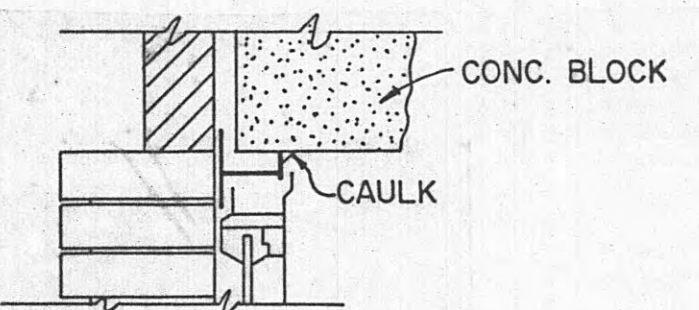


JAMB A

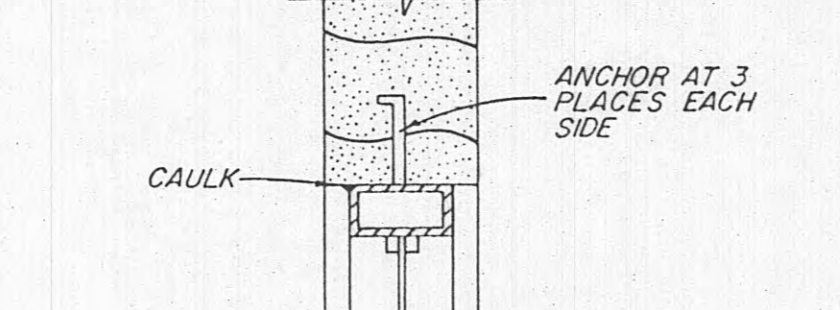

JAMB B

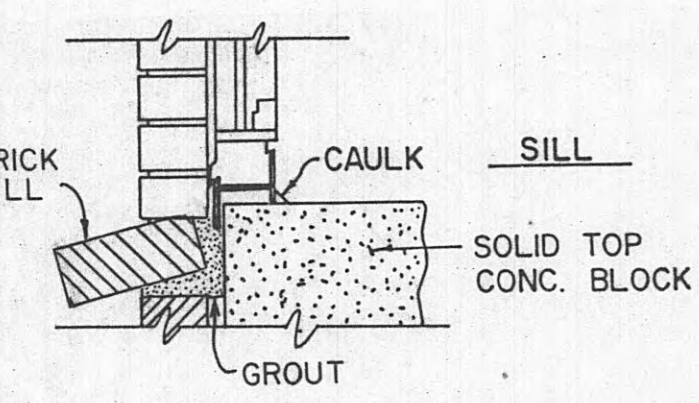

SILL A

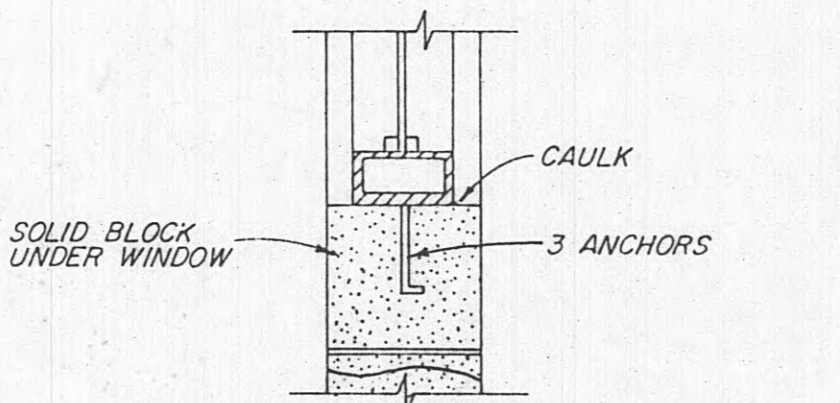

SILL B

WINDOW ELEVATIONS AND SECTIONS
N. T. S.

WINDOW SCHEDULE								
MARK	LOCATION	MASONARY	OPENING	SILL	HEAD	JAMB	PRECAST LINTEL	REMARKS
A-1	BREAK ROOM	AS REQ'D FOR WINDOW	A	A	A	A	B	NOTE 1
B-1	OFFICE	AS REQ'D FOR WINDOW	A	A	A	A	A	NOTE 1
B-2	OFFICE	AS REQ'D FOR WINDOW	A	A	A	A	A	NOTE 1
C-1	CARBON ROOM	AS REQ'D FOR WINDOW	B	B	B	N/A	N/A	FIXED
C-2	FLUORIDE ROOM	AS REQ'D FOR WINDOW	B	B	B	N/A	N/A	FIXED
C-3	CHLORINE ROOM	AS REQ'D FOR WINDOW	B	B	B	N/A	N/A	FIXED
D-1	BACTERIAL LAB	AS REQ'D FOR WINDOW	A	A	A	A	A	NOTE 1
E-1	LAB ROOM	AS REQ'D FOR WINDOW	A	A	A	A	A	NOTE 1
E-2	LAB ROOM	AS REQ'D FOR WINDOW	A	A	A	A	A	NOTE 1
F-1	CHLORINE STORAGE	AS REQ'D FOR WINDOW	B	B	B	B	B	FIXED


NOTE 1 WINDOWS TO BE FURNISHED WITH HARDWARE, SCREENS, WEATHER STRIPPING AND NECESSARY ITEMS FOR PROPER INSTALLATION

FINISH SCHEDULE			
ROOM	WALL	FLOOR	CEILING
OPERATIONS/EXTERIOR	BRICK	N/A	N/A
FILTER BLDG/EXTERIOR	METAL PANELS	N/A	N/A
ENTRANCE HALL	PAINTED CONC. BLK.	TERRAZZO	SUSPENDED (8'-6")
STORAGE RM	PAINTED CONC. BLK.	HARDENED CONC.	SUSPENDED (8'-6")
OFFICE	PAINTED CONC. BLK.	TERRAZZO	SUSPENDED (8'-6")
BREAK ROOM	PAINTED CONC. BLK.	TERRAZZO	SUSPENDED (8'-6")
BACT. LAB	PAINTED CONC. BLK.	TERRAZZO	SUSPENDED (8'-6")
LAB ROOM	PAINTED CONC. BLK.	TERRAZZO	SUSPENDED (8'-6")
ELECT. RM.	PAINTED CONC. BLK.	HARDENED CONC.	SUSPENDED (8'-6")
FILTER BLDG.	PAINTED CONC. BLK.	HARDENED CONC.	METAL LINER PNLS.
POLYMER FEED RM	PAINTED CONC. BLK.	HARDENED CONC.	PRECAST CONC. PAINTED
CARBON FEED RM	PAINTED CONC. BLK.	HARDENED CONC.	PRECAST CONC. PAINTED
FLUORIDE FEED RM	PAINTED CONC. BLK.	HARDENED CONC.	PRECAST CONC. PAINTED
CL. FEED ROOM	PAINTED CONC. BLK.	HARDENED CONC.	PRECAST CONC. PAINTED
CL. CYL. STORAGE	PAINTED CONC. BLK.	HARDENED CONC.	PRECAST CONC. PAINTED
RESTROOM	PAINTED CONC. BLK.	TERRAZZO	SUSPENDED (8'-6")
STORAGE BLDG (BLOCK)	PAINTED CONC. BLK.	HARDENED CONC.	POURED CONCRETE
INTAKE PUMP ROOM	PAINTED CONC. BLK.	HARDENED CONC.	POURED CONCRETE


DOOR SCHEDULE								
MARK	LOCATION	HAND	DOOR SIZE	HDW	THRES-HOLD	JAMB	HEAD	REMARKS
A-1	OUTSIDE/MAIN ENTRANCE	RHR	3'-0" X 7'-2"	1	YES	-	-	ALUM. DOOR & FRAME
B-1	OUTSIDE/FILTER ROOM	ROLL-UP	10'-0" X 10'-0"	*	NO	-	-	**
B-2	OUTSIDE/STORAGE BLDG.	ROLL-UP	10'-0" X 10'-0"	*	NO	-	-	**
C-1	BACT. LAB/ENTRANCE HALL	RH	3'-0" X 7'-2"	2	NO	B	B	NO LOUVER REQ'D.
C-2	ENTRANCE HALL/OFFICE	LH	3'-0" X 7'-2"	2	NO	B	B	NO LOUVER REQ'D.
C-3	ENTRANCE HALL/BREAK RM.	RH	3'-0" X 7'-2"	5	NO	B	B	NO WINDOW REQ'D.
C-4	ENTRANCE HALL/STORAGE	RHR	3'-0" X 7'-2"	2	NO	B	B	NO WINDOW/LOUVER REQ'D.
C-5	HALL/RESTROOM	LH	3'-0" X 7'-2"	4	NO	B	B	NO WINDOW/LOUVER REQ'D.
C-6	HALL/LAB ROOM	LHR	3'-0" X 7'-2"	2	NO	B	B	NO WINDOW REQ'D.
C-7	HALL/ELEC. ROOM	RHR	3'-0" X 7'-2"	6	NO	B	B	NO WINDOW REQ'D.
C-8	LAB ROOM/BACT. LAB	LHR	3'-0" X 7'-2"	5	NO	B	B	NO LOUVER REQ'D.
C-9	FILTER ROOM/POLYMER RM.	LHR	3'-0" X 7'-2"	5	NO	B	B	NO LOUVER REQ'D.
D-1	FILTER ROOM/HALL	LH	3'-0" X 7'-2"	2	YES	B	B	
D-2	OUTSIDE/FLUORIDE	LHR	3'-0" X 7'-2"	2	YES	B	B	
D-3	OUTSIDE/CARBON ROOM	LHR	3'-0" X 7'-2"	2	YES	B	B	
D-4	OUTSIDE/CL. FEED RM.	LHR	3'-0" X 7'-2"	3	YES	B	B	
D-5	OUTSIDE/CHLORINE STORAGE	LHR	3'-0" X 7'-2"	3	YES	B	B	
D-6	OUTSIDE/FILTER RM	LHR	3'-0" X 7'-2"	2	YES	B	B	
D-7	OUTSIDE/FILTER RM	RHR	3'-0" X 7'-2"	2	YES	B	B	
D-8	OUTSIDE/STORAGE BLDG.	LHR	3'-0" X 7'-2"	2	YES	B	B	
D-9	OUTSIDE/INTAKE PUMP BLDG.	RHR	3'-0" X 7'-2"	2	YES	B	B	
D-10	OUTSIDE/INTAKE PUMP BLDG.	LH	3'-0" X 7'-2"	2	YES	A	A	
D-11	INSIDE/STORAGE BLDG.	RH	2'-8" X 6'-8"	3	YES	B	B	
E-1	OUTSIDE/CHLORINE STORAGE	FOUR-FOLD	10'-0" X 12'-4"	*	YES	C	C	

* DOOR HDW. FURNISHED BY DOOR MANUFACTURER
** STL. FRAME FOR ROLL-UP DOOR FURNISHED BY BLDG. MANUFACTURER

HARDWARE SCHEDULE					
NO.	BUTTS	DOOR STOPS & HOLDERS	LOCKSET	LATCHSET	CLOSER
1	1-1/2 PAIR	YES	KEY-KEY	PULL & BAR	YES
2	1-1/2 PAIR	YES	KEY-BUTTON	KNOB-KNOB	YES
3	1-1/2 PAIR	YES	KEY-BUTTON	KNOB-PANIC BAR	YES
4	1-1/2 PAIR	STOP ONLY	KEY-TURN LEVER	PLATE HANDLE	YES
5	1-1/2 PAIR	YES	NONE	KNOB-KNOB	NO
6	1-1/2 PAIR	YES	NONE	KNOB-PANIC BAR	NO

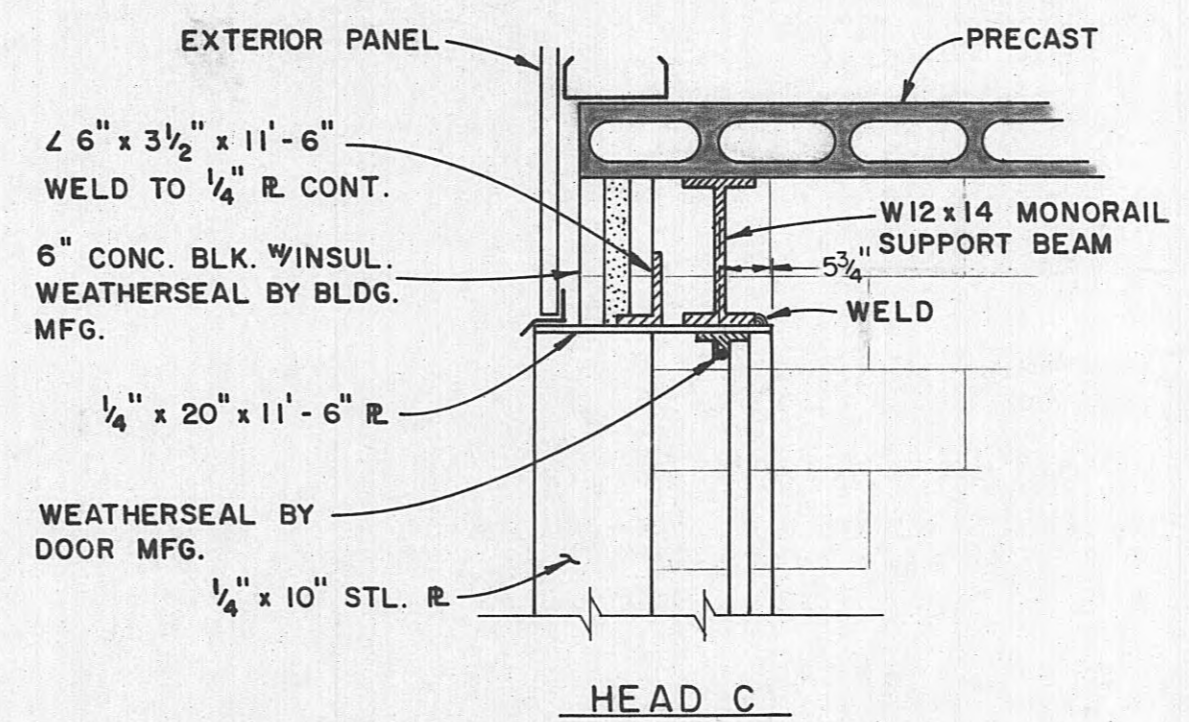


HEAD C

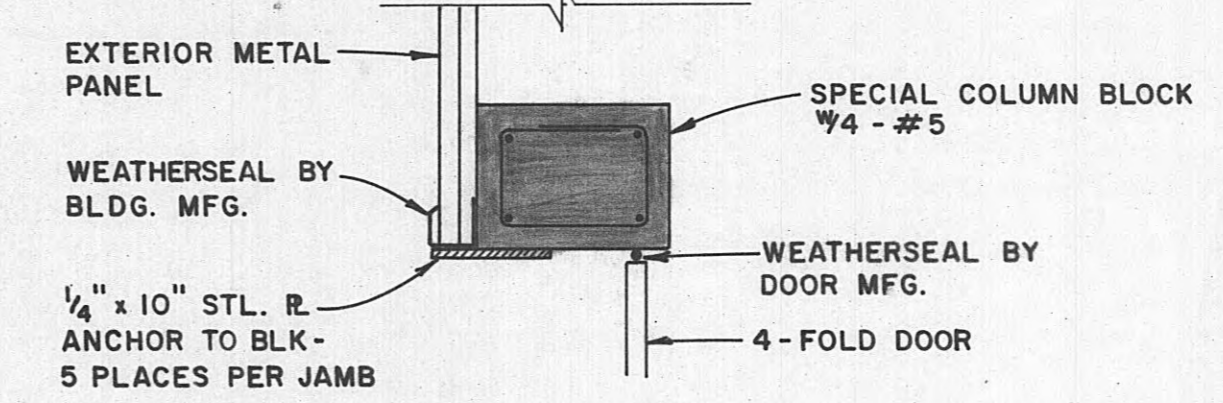


JAMB C


FOUR FOLD SECTIONS
SCALE: 3/4" = 1'-0"

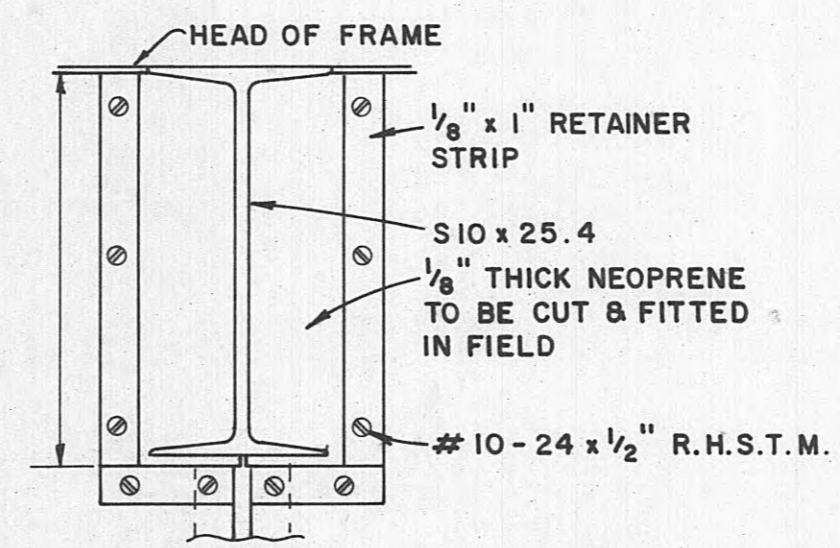


CUT OUT DETAIL FOR FOLDING DOOR
N. T. S.

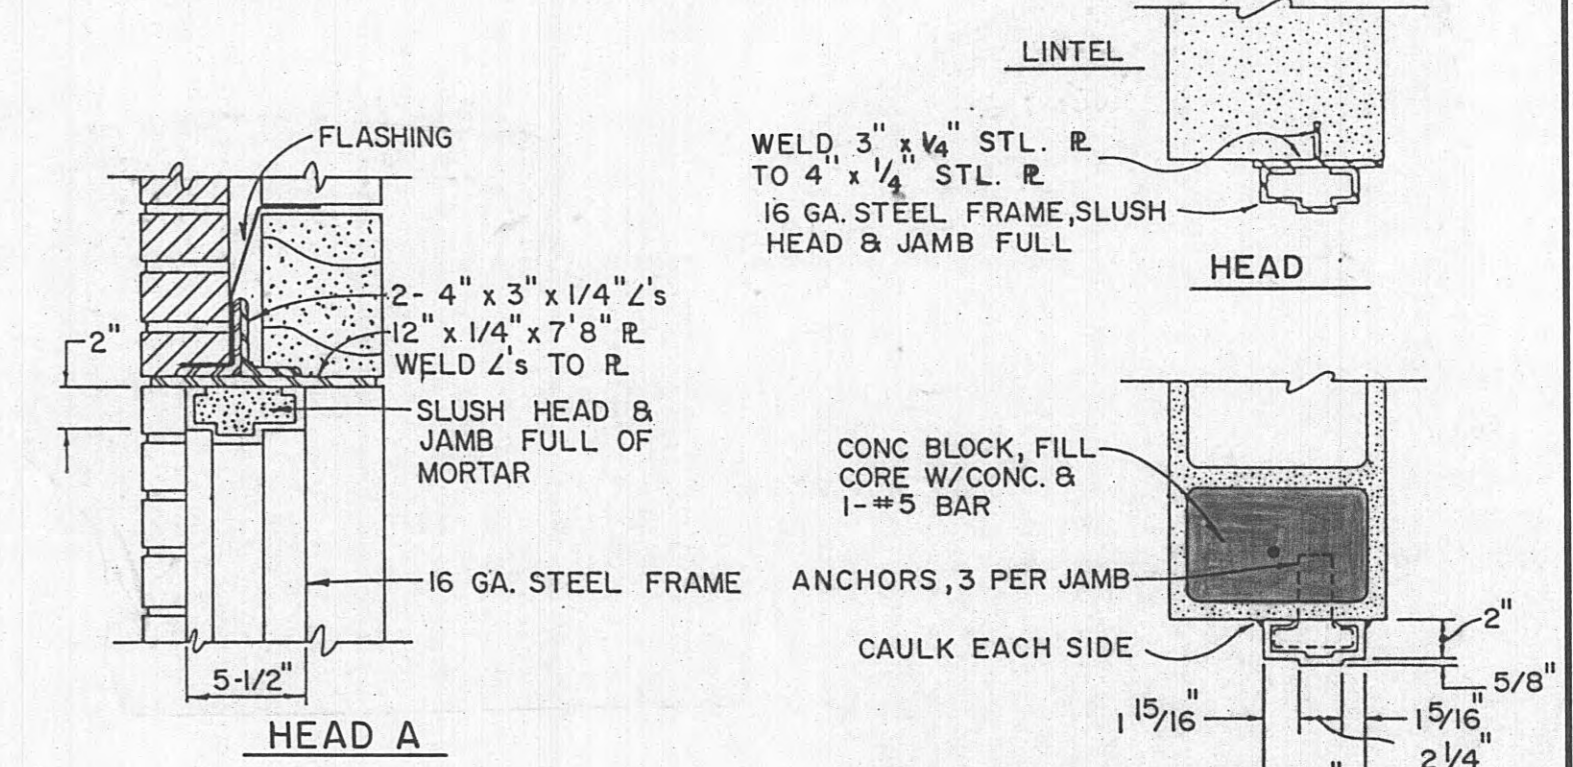


HEAD A

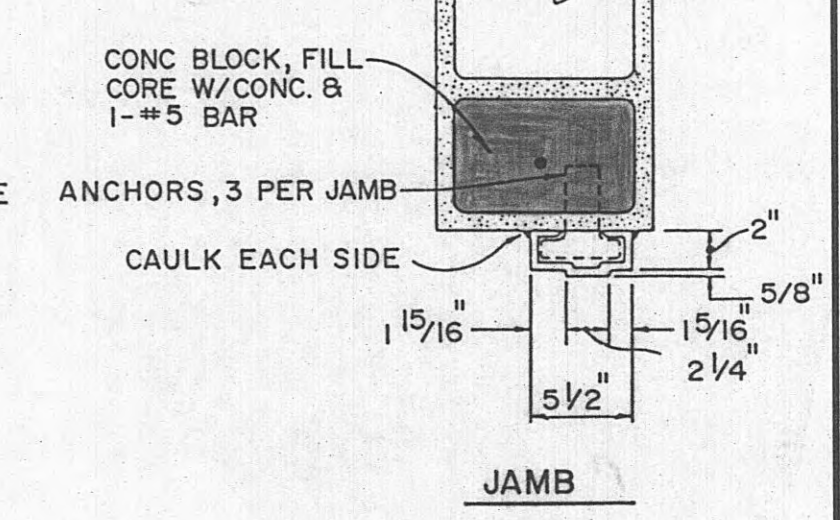

JAMB

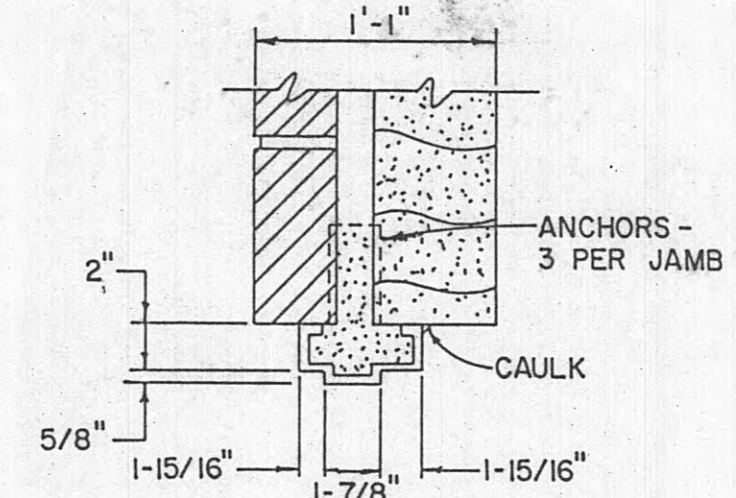


JAMB A

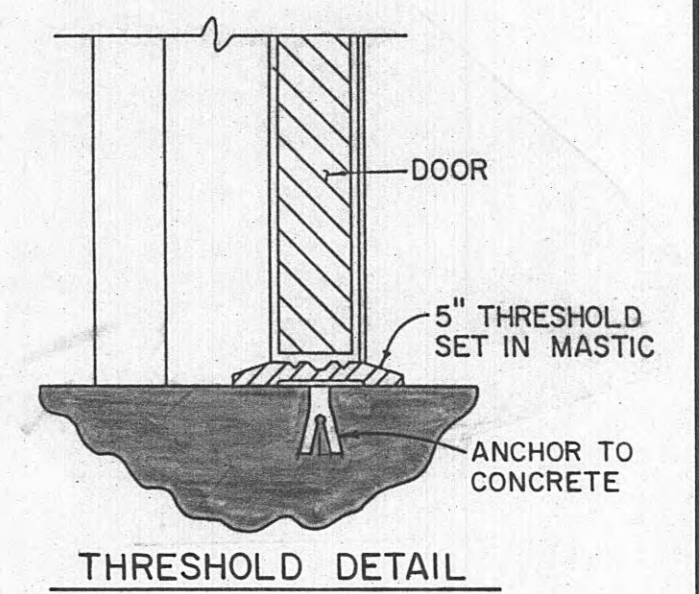


THRESHOLD DETAIL


DOOR SECTIONS
N. T. S.

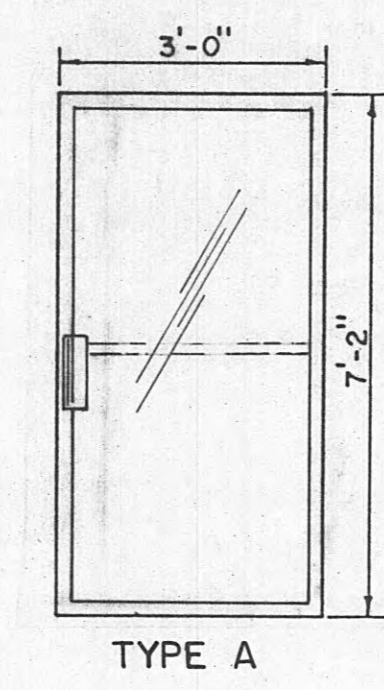


TYPE A

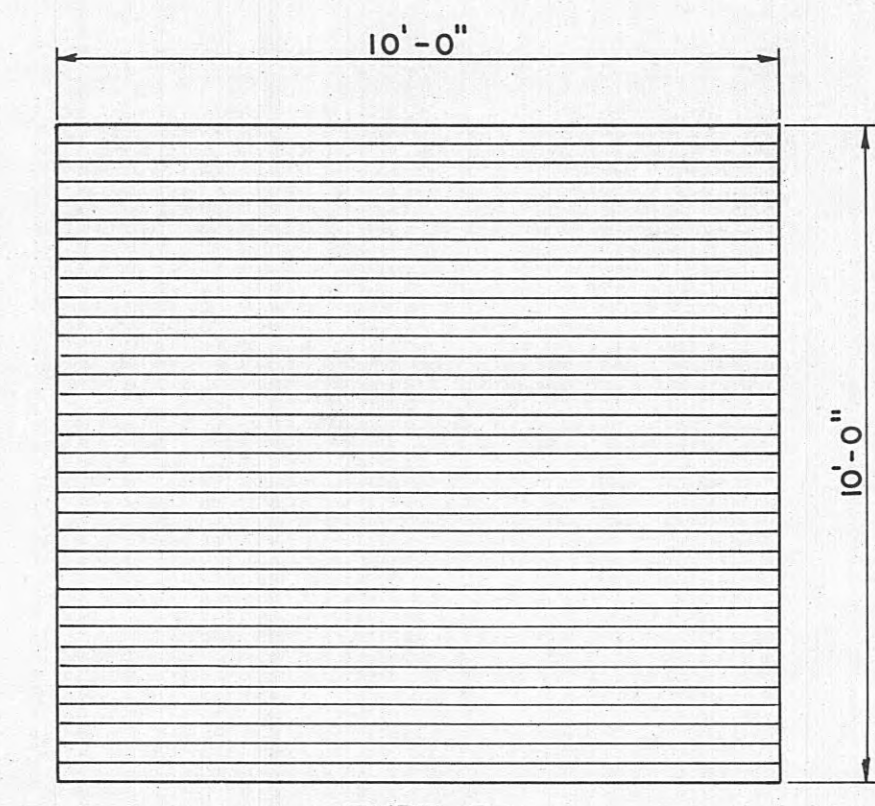


TYPE B

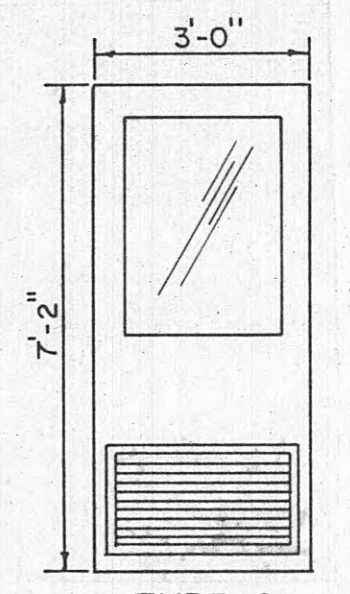

TYPE C

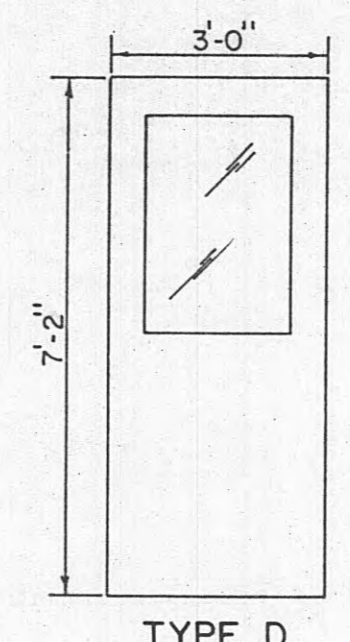


TYPE D

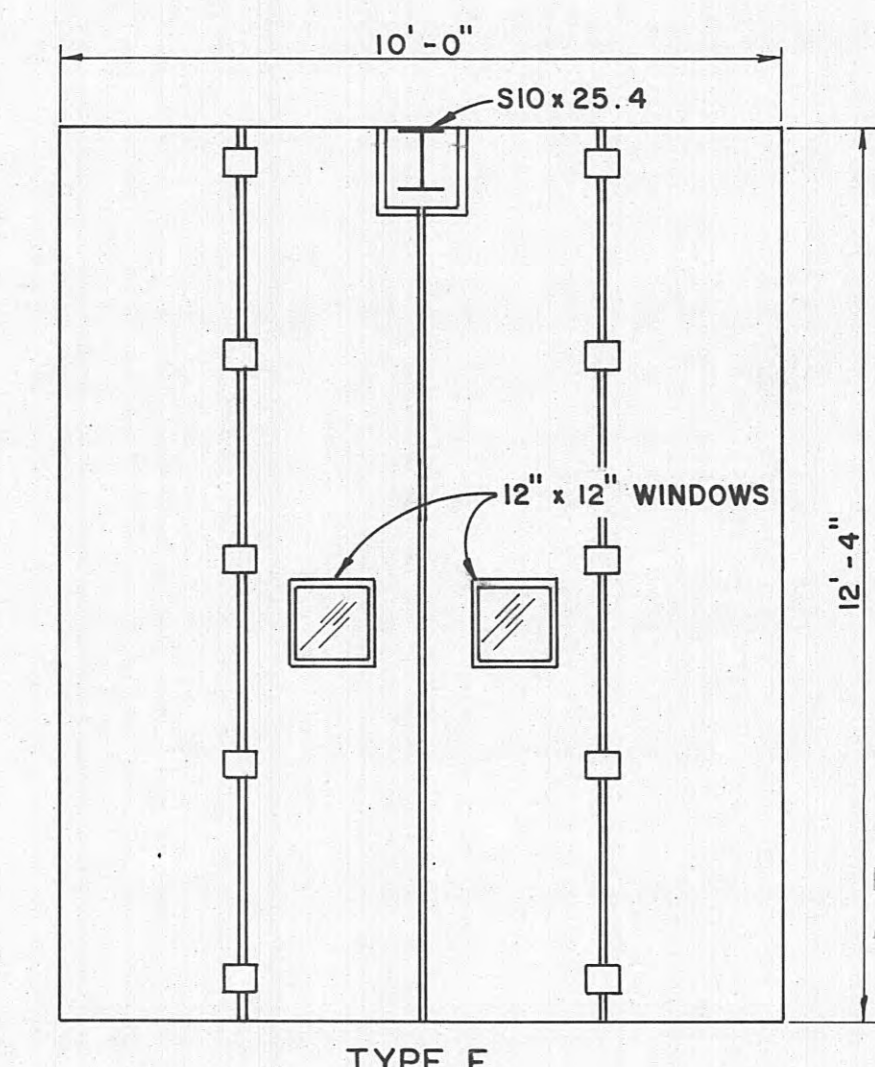

TYPE E

DOOR DETAILS
N. T. S.

AS BUILT
DATE: 3-20-95
APPROVED: [Signature]

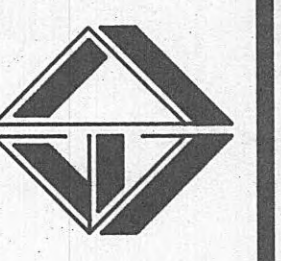

REVISIONS


DESIGNED: L. E. R.
DRAWN: D. M.
CHECKED: L. E. R.
DATE: MARCH, 1993
SCALE: AS NOTED
PROJ. NO. 0592

FOUNDATION NOTES


1. INDIVIDUAL FOOTINGS ARE DESIGNED TO BEAR ON SOIL CAPABLE OF SUPPORTING 2500 P.S.F.
2. THE SOIL BEARING CAPACITY SHALL BE VERIFIED WHEN FOUNDATION EXCAVATIONS HAVE BEEN CARRIED DOWN TO THE PROPOSED ELEVATIONS OR PROPER BEARING STRATUM.
3. ANCHOR BOLTS SHALL BE ASTM A307. BOLT SIZE TO BE DETERMINED BY METAL BUILDING CONTRACTOR.

REINFORCED CONCRETE


1. ALL CONCRETE WORK SHALL CONFORM TO THE BUILDING CODE REQUIREMENTS FOR REINFORCED CONCRETE: (ACI 318-89).
2. REINFORCING STEEL SHALL BE DEFORMED BARS ASTM A615 (GRADE 60).
3. THE COMPRESSIVE STRENGTH AT 28 DAYS OF ALL CAST IN PLACE CONCRETE SHALL BE: 4000 PSI AS SPECIFIED.
4. LAP SPLICES FOR REINFORCING BARS SHALL BE 30 BAR DIAMETERS, UNLESS NOTED OTHERWISE.
5. THE LONGITUDINAL REINFORCING STEEL IN WALLS AND FOOTINGS SHALL BE CONTINUOUS & SHALL BE CONTINUOUS AROUND CORNERS.
6. ALL DOWELS TO BE SAME SIZE AS WALL STEEL UNLESS NOTED OTHERWISE.

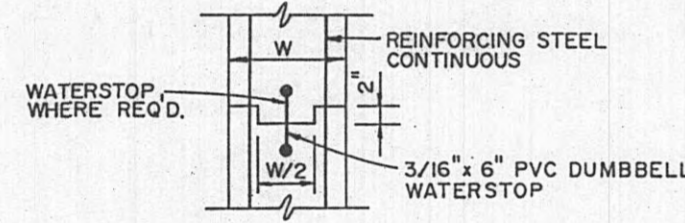

CONSTRUCTION JOINT IN WALL
NO SCALE

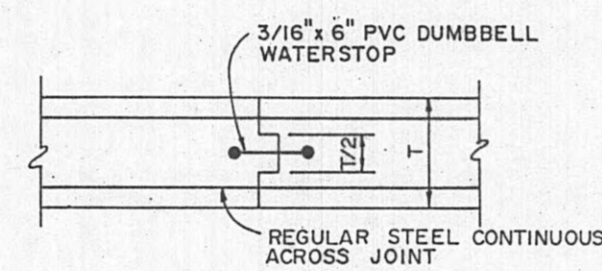


CONSTRUCTION JOINT IN SLAB
NO SCALE

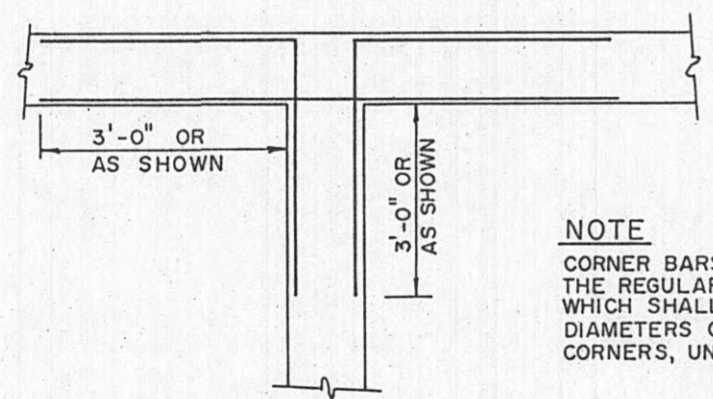

CORNER BAR DETAILS
REGULAR STEEL OMITTED FOR CLARITY
NO SCALE

NOTE
CORNER BARS ARE IN ADDITION TO THE REGULAR HORIZONTAL STEEL WHICH SHALL BE CARRIED 30 BAR DIAMETERS OR 12" MIN. AROUND CORNERS, UNLESS OTHERWISE SHOWN.

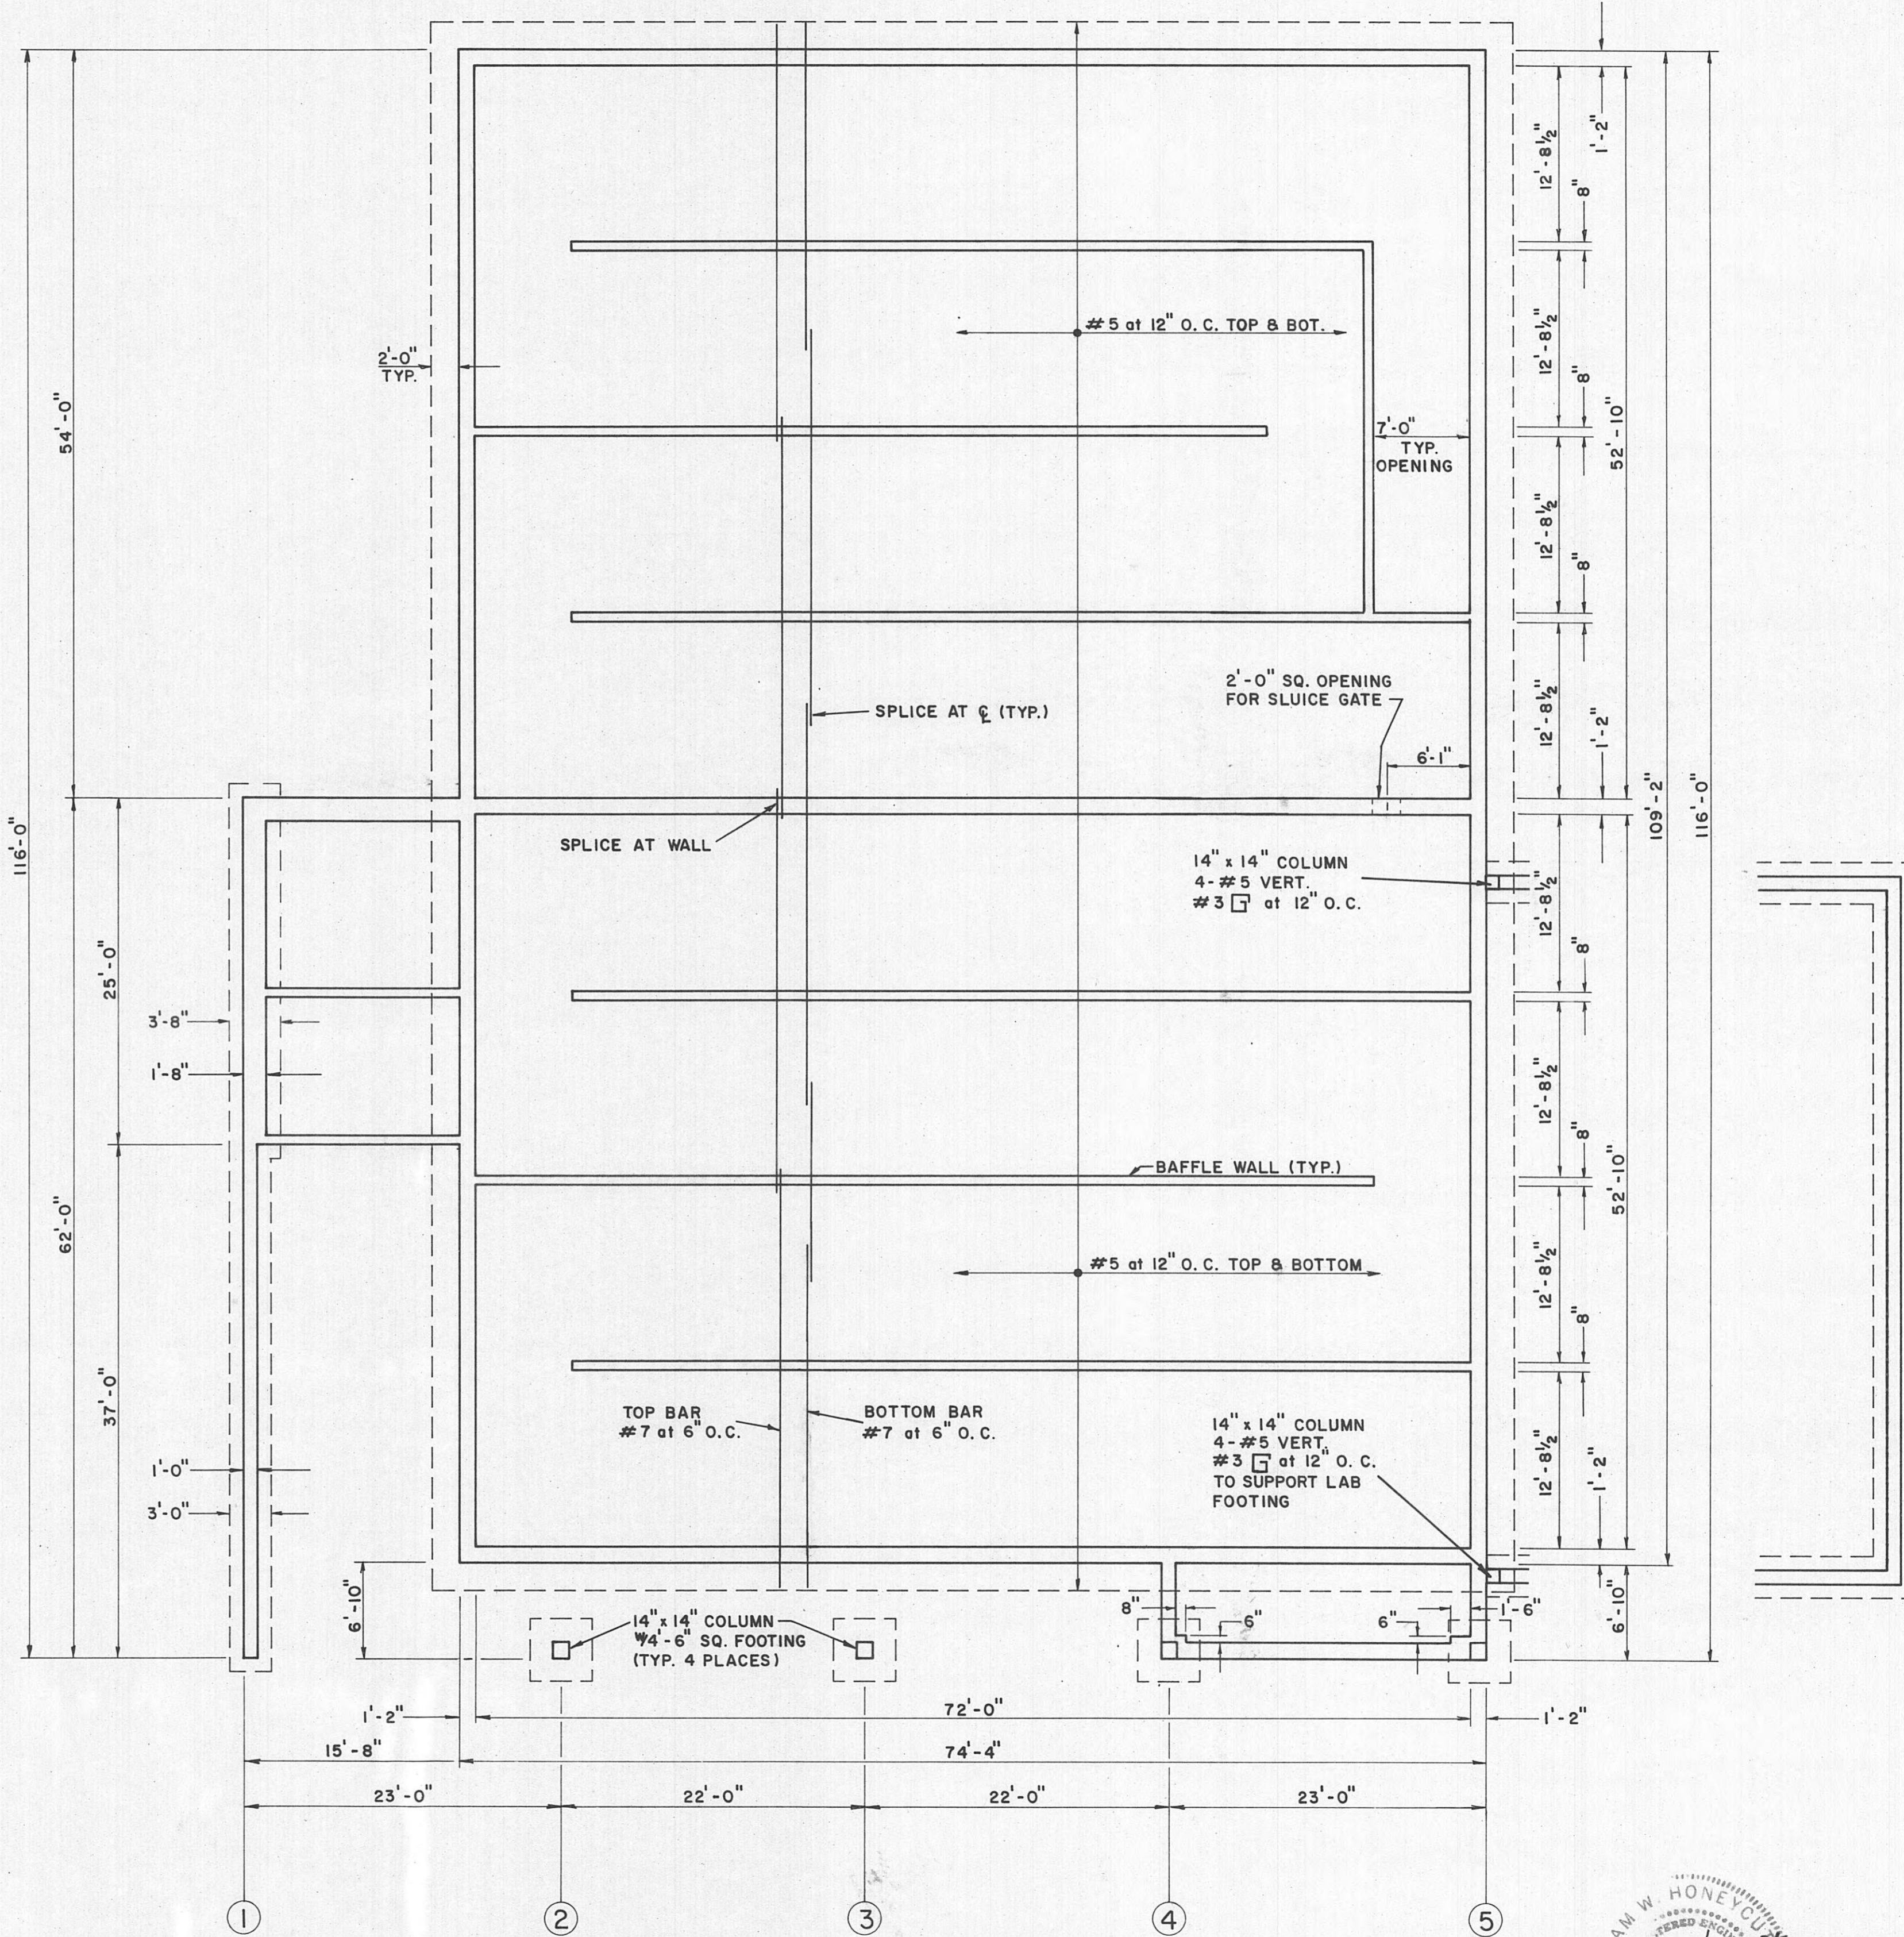

STRUCTURAL - FLOOR SLAB ELEVATION 767.00
SCALE: 1/8" = 1'-0"




AS BUILT
DATE: 3-20-95
APPROVED: *[Signature]*



REVISIONS


DESIGNED: L. E. R.
DRAWN: S.C.G., D.M.
CHECKED: L. E. R.
DATE: MARCH, 1993
SCALE: AS NOTED
PROJ. NO. 0592

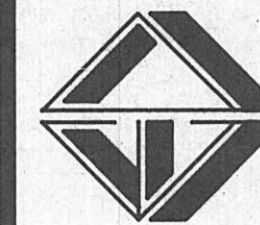

REVISIONS



4-19-93 ADDED
PIPE CHASE AND
TRENCH DRAIN (DR)

DESIGNED: L. E. R.
DRAWN: S. C. G., D. M.
CHECKED: L. E. R.
DATE: MARCH, 1993
SCALE: AS NOTED
PROJ. NO. 0592

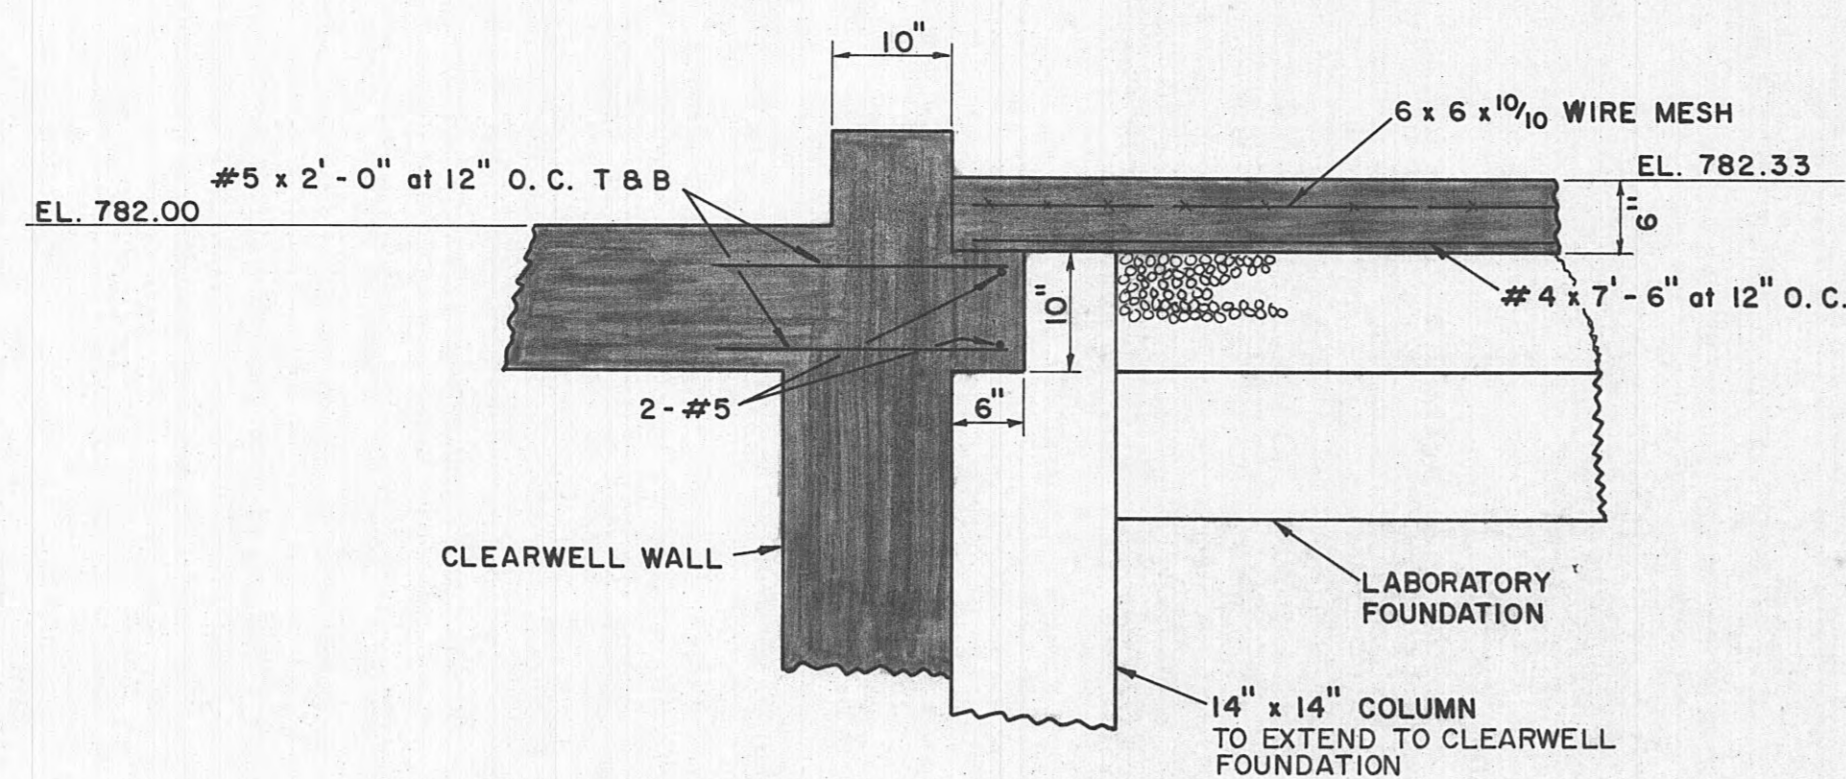


SECTION A-13
SCALE: 3/4" = 1'-0"

MARK	TYPE	REINFORCING		REMARKS
		BOTTOM	TOP	
FS1	12" SOLID	#5 @ 12"	#7 @ 7"	
FS2	12" SOLID	FROM FS1	FROM FS1	
FS3	12" SOLID	#7 @ 7"	#7 @ 7"	
FS4	12" SOLID	FROM FS3	FROM FS3	
FS5	12" SOLID	#7 @ 7"	#7 @ 7"	
FS6	12" SOLID	#6 @ 12"	FROM FS5	
FS7	12" SOLID	#7 @ 7"	#7 @ 7"	
FS8	12" SOLID	#7 @ 7"	FROM FS7	
FS9	12" SOLID	FROM FS8	FROM FS8	
FS10	12" SOLID	#5 @ 12"	#6 @ 12"	
FS11	12" SOLID	#5 @ 12"	#6 @ 12"	
FS11A	12" SOLID	FROM FS10	FROM FS10	
FS12	12" SOLID	#5 @ 12"	#6 @ 12"	
FS13	12" SOLID	FROM FS12	FROM FS12	
FS14	12" SOLID	#5 @ 12"	#6 @ 12"	
FS15	12" SOLID	#5 @ 12"	FROM FS14	
FS16	12" SOLID	#5 @ 12"	#6 @ 12"	
FS17	12" SOLID	#5 @ 12"	FROM FS16	
FS18	12" SOLID	FROM FS17	FROM FS16	
FS18	12" SOLID	#7 @ 12"	#5 @ 12" O.C.	
FS20	14" SOLID	#7 @ 6"	#5 @ 12 O.C.	

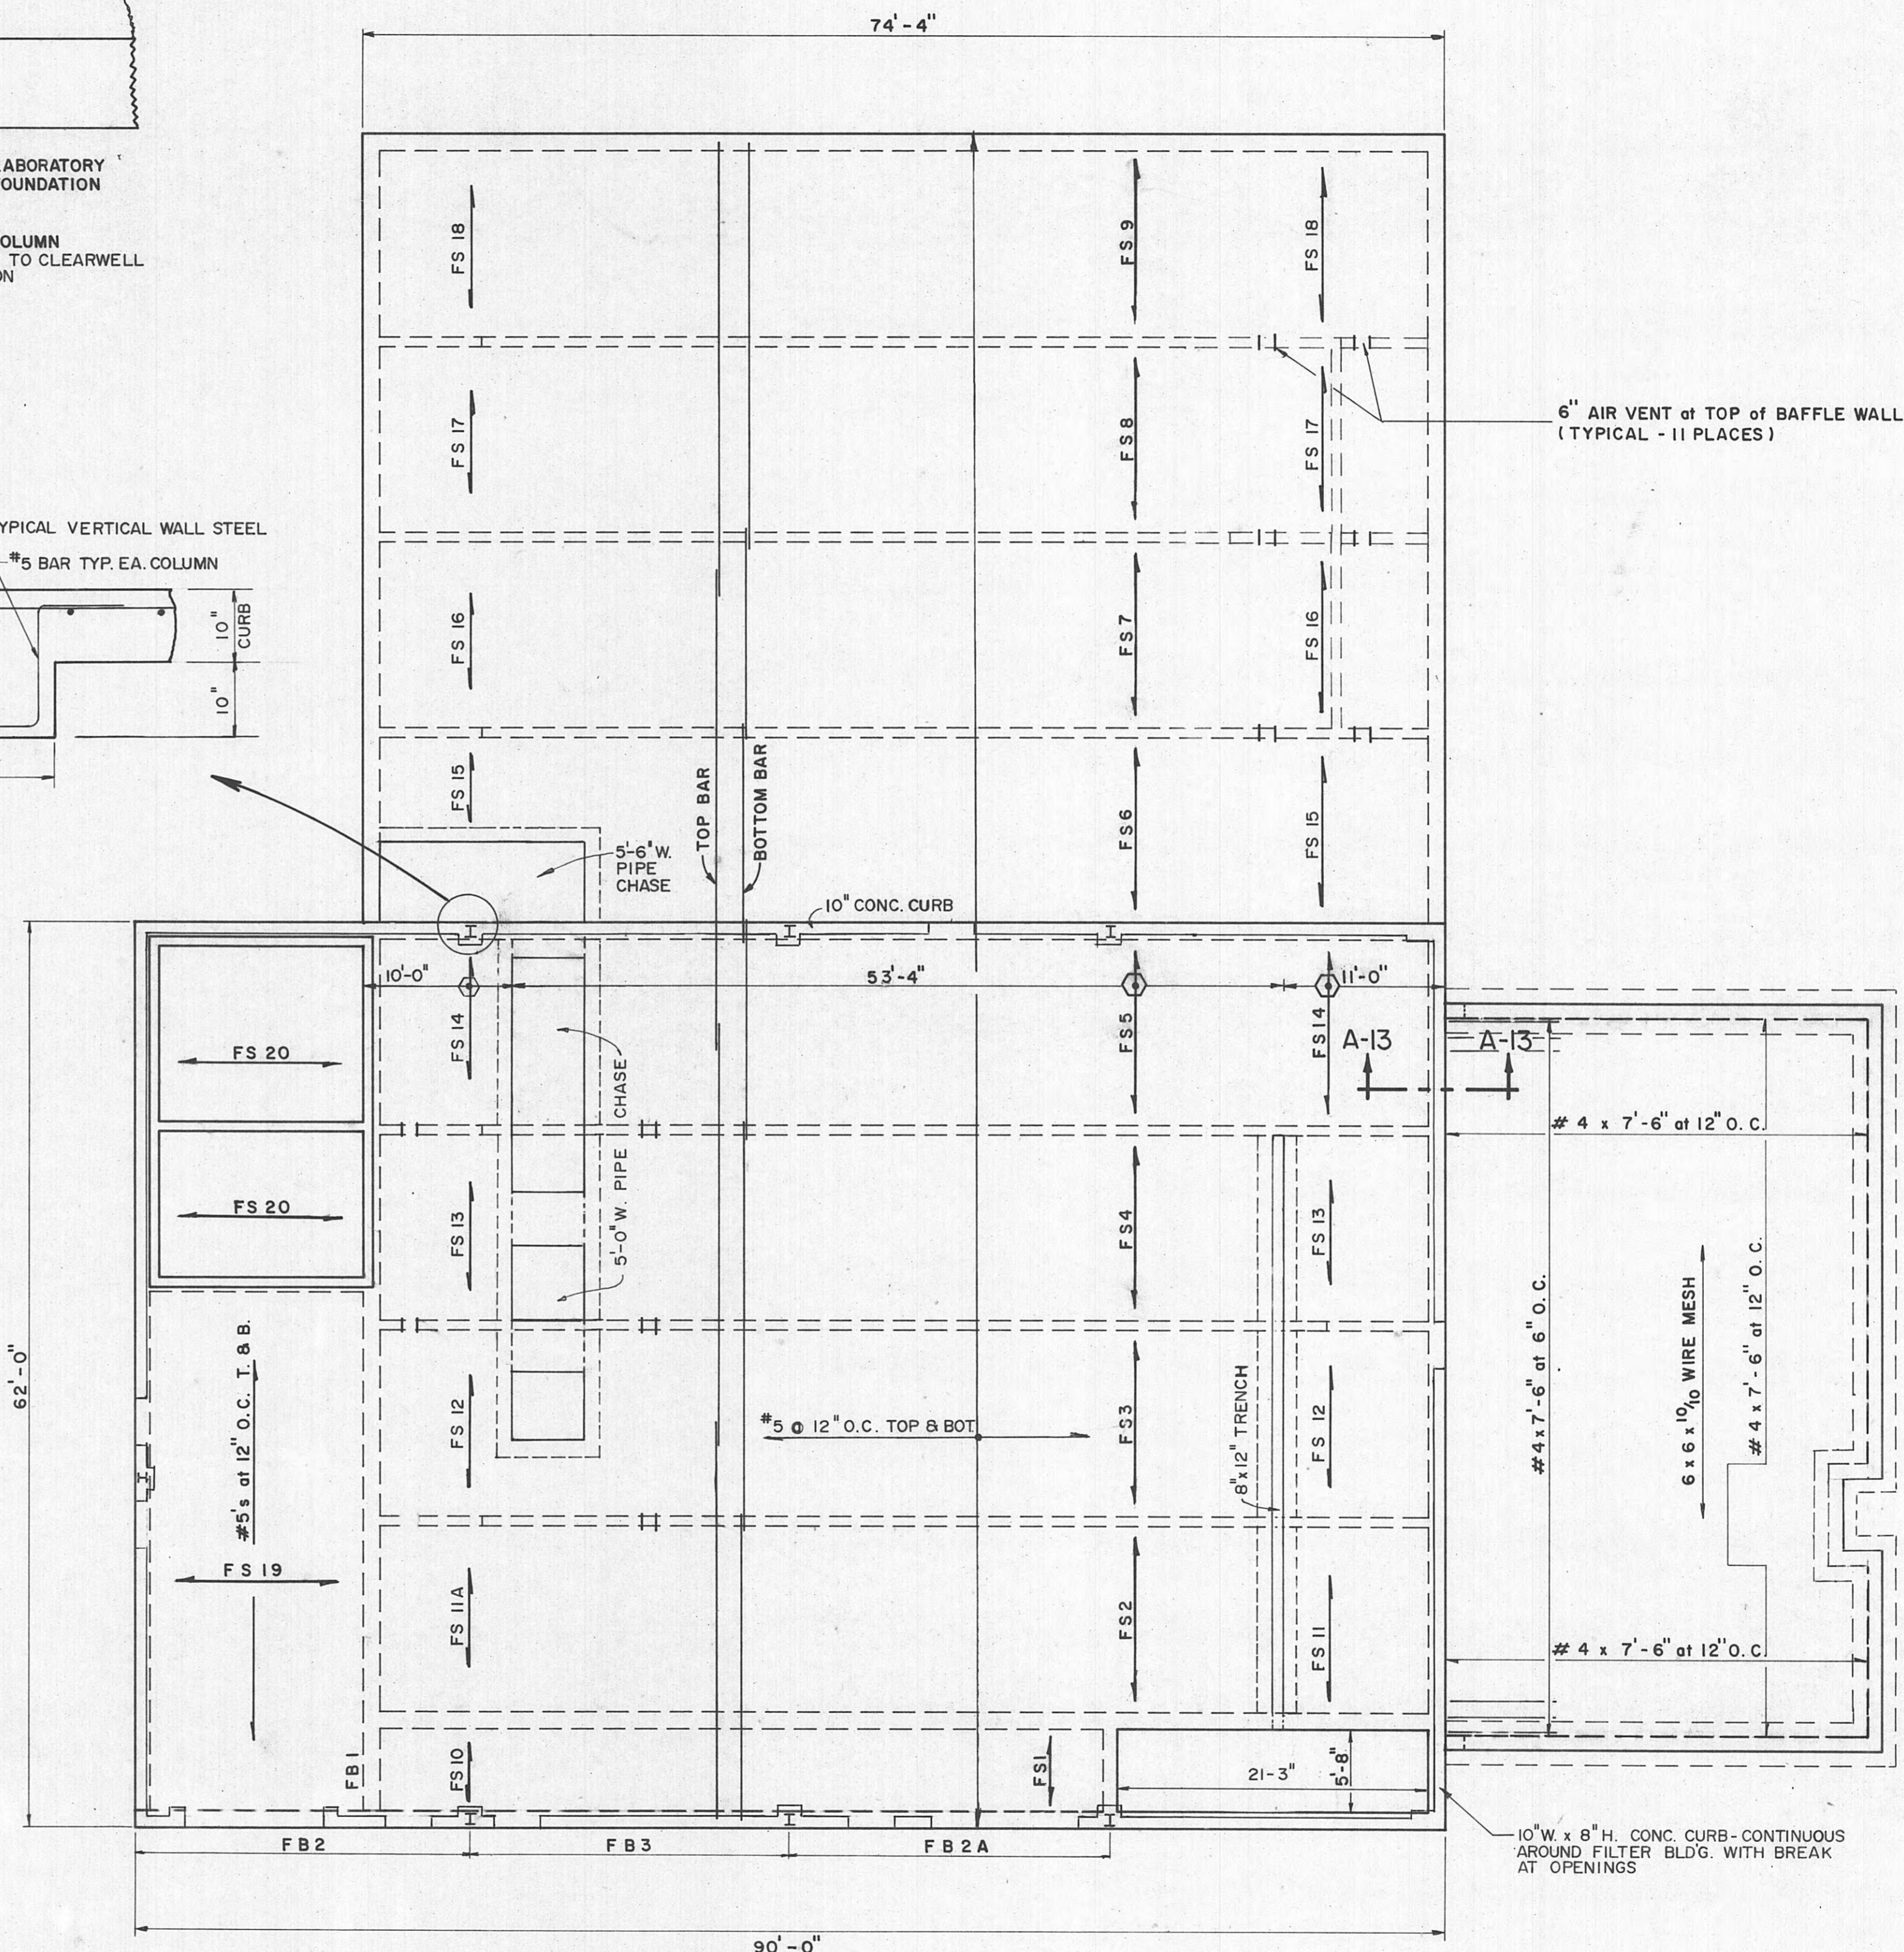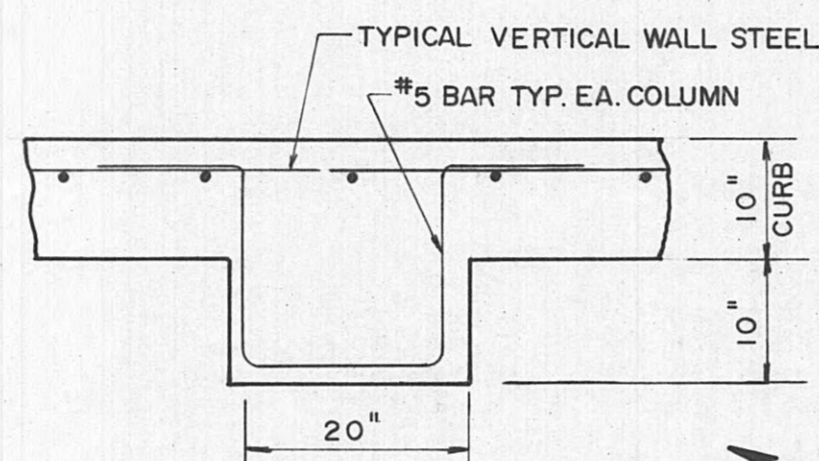

MARK	SIZE B X D	REINFORCING		STIRRUPS		REMARKS
		BOTTOM	TOP	SIZE	SPACING	
FB1	14 X 18	3 # 6	2 # 6	#3 □	2" - 12" O.C. CONT.	SEE DETAIL
FB2	14 X 30	3 # 8	3 # 8	#3 □	2" - 12" O.C. CONT.	SPLICE TOP BARS @ FB3
FB3	14 X 30	3 # 8	FROM FB2	#3 □	2" - 12" O.C. CONT.	

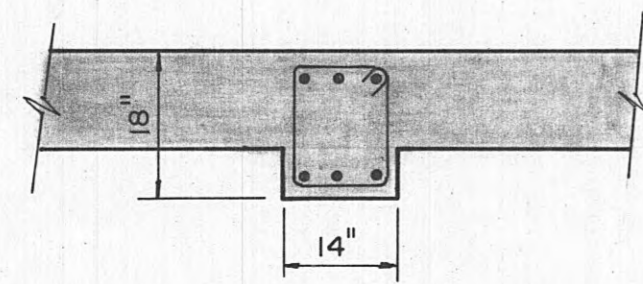

DETAIL FB1


STRUCTURAL - FLOOR SLAB ELEVATION 782.0

SCALE: 1/8" = 1'-0"



AS BUILT

DATE: 3-20-95
APPROVED: D.M.

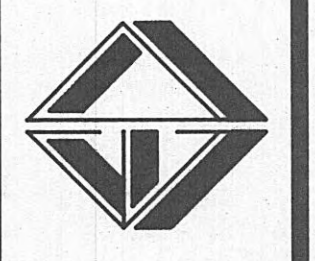

CONTRACT W93-04

HARRIMAN, TENNESSEE
 FLOW DIAGRAM

REVISIONS


DESIGNED: L. E. R.
 DRAWN: S. C. G.
 CHECKED: L. E. R.
 DATE: MARCH, 1993
 SCALE: NONE
 PROJ. NO. 0592

SHEET 14

OF 36


LEGEND

- PROCESS FLOW
- - - BACKWASH FLOW & SURFACE WASH
- 60-80 PSI AIR
- 20 PSI AIR
- 3-15 PSI PNEUMATIC SIGNAL LINE
- LOW PRESSURE AIR
- ELECTRICAL LINE
- CHEMICAL FEED LINE
- PRV --- PRESSURE RELIEF VALVE
- FI --- FLOW INDICATOR
- PR --- PRESSURE REGULATOR
- CV --- CONTROL VALVE
- PI --- PRESSURE INDICATOR
- VRV --- VACUUM RELEASE VALVE
- ARV --- AIR RELEASE VALVE
- PI --- PRESSURE INDICATOR
- PS --- PRESSURE SWITCH
- LC --- LEVEL CONTROLLER
- POS --- VALVE POSITIONER
- M --- MOTOR
- SCD --- STREAMING CURRENT DETECTOR
- SV --- SOLENOID VALVE
- AS --- AIR SUPPLY 65-80 PSI CLEAN & DRY

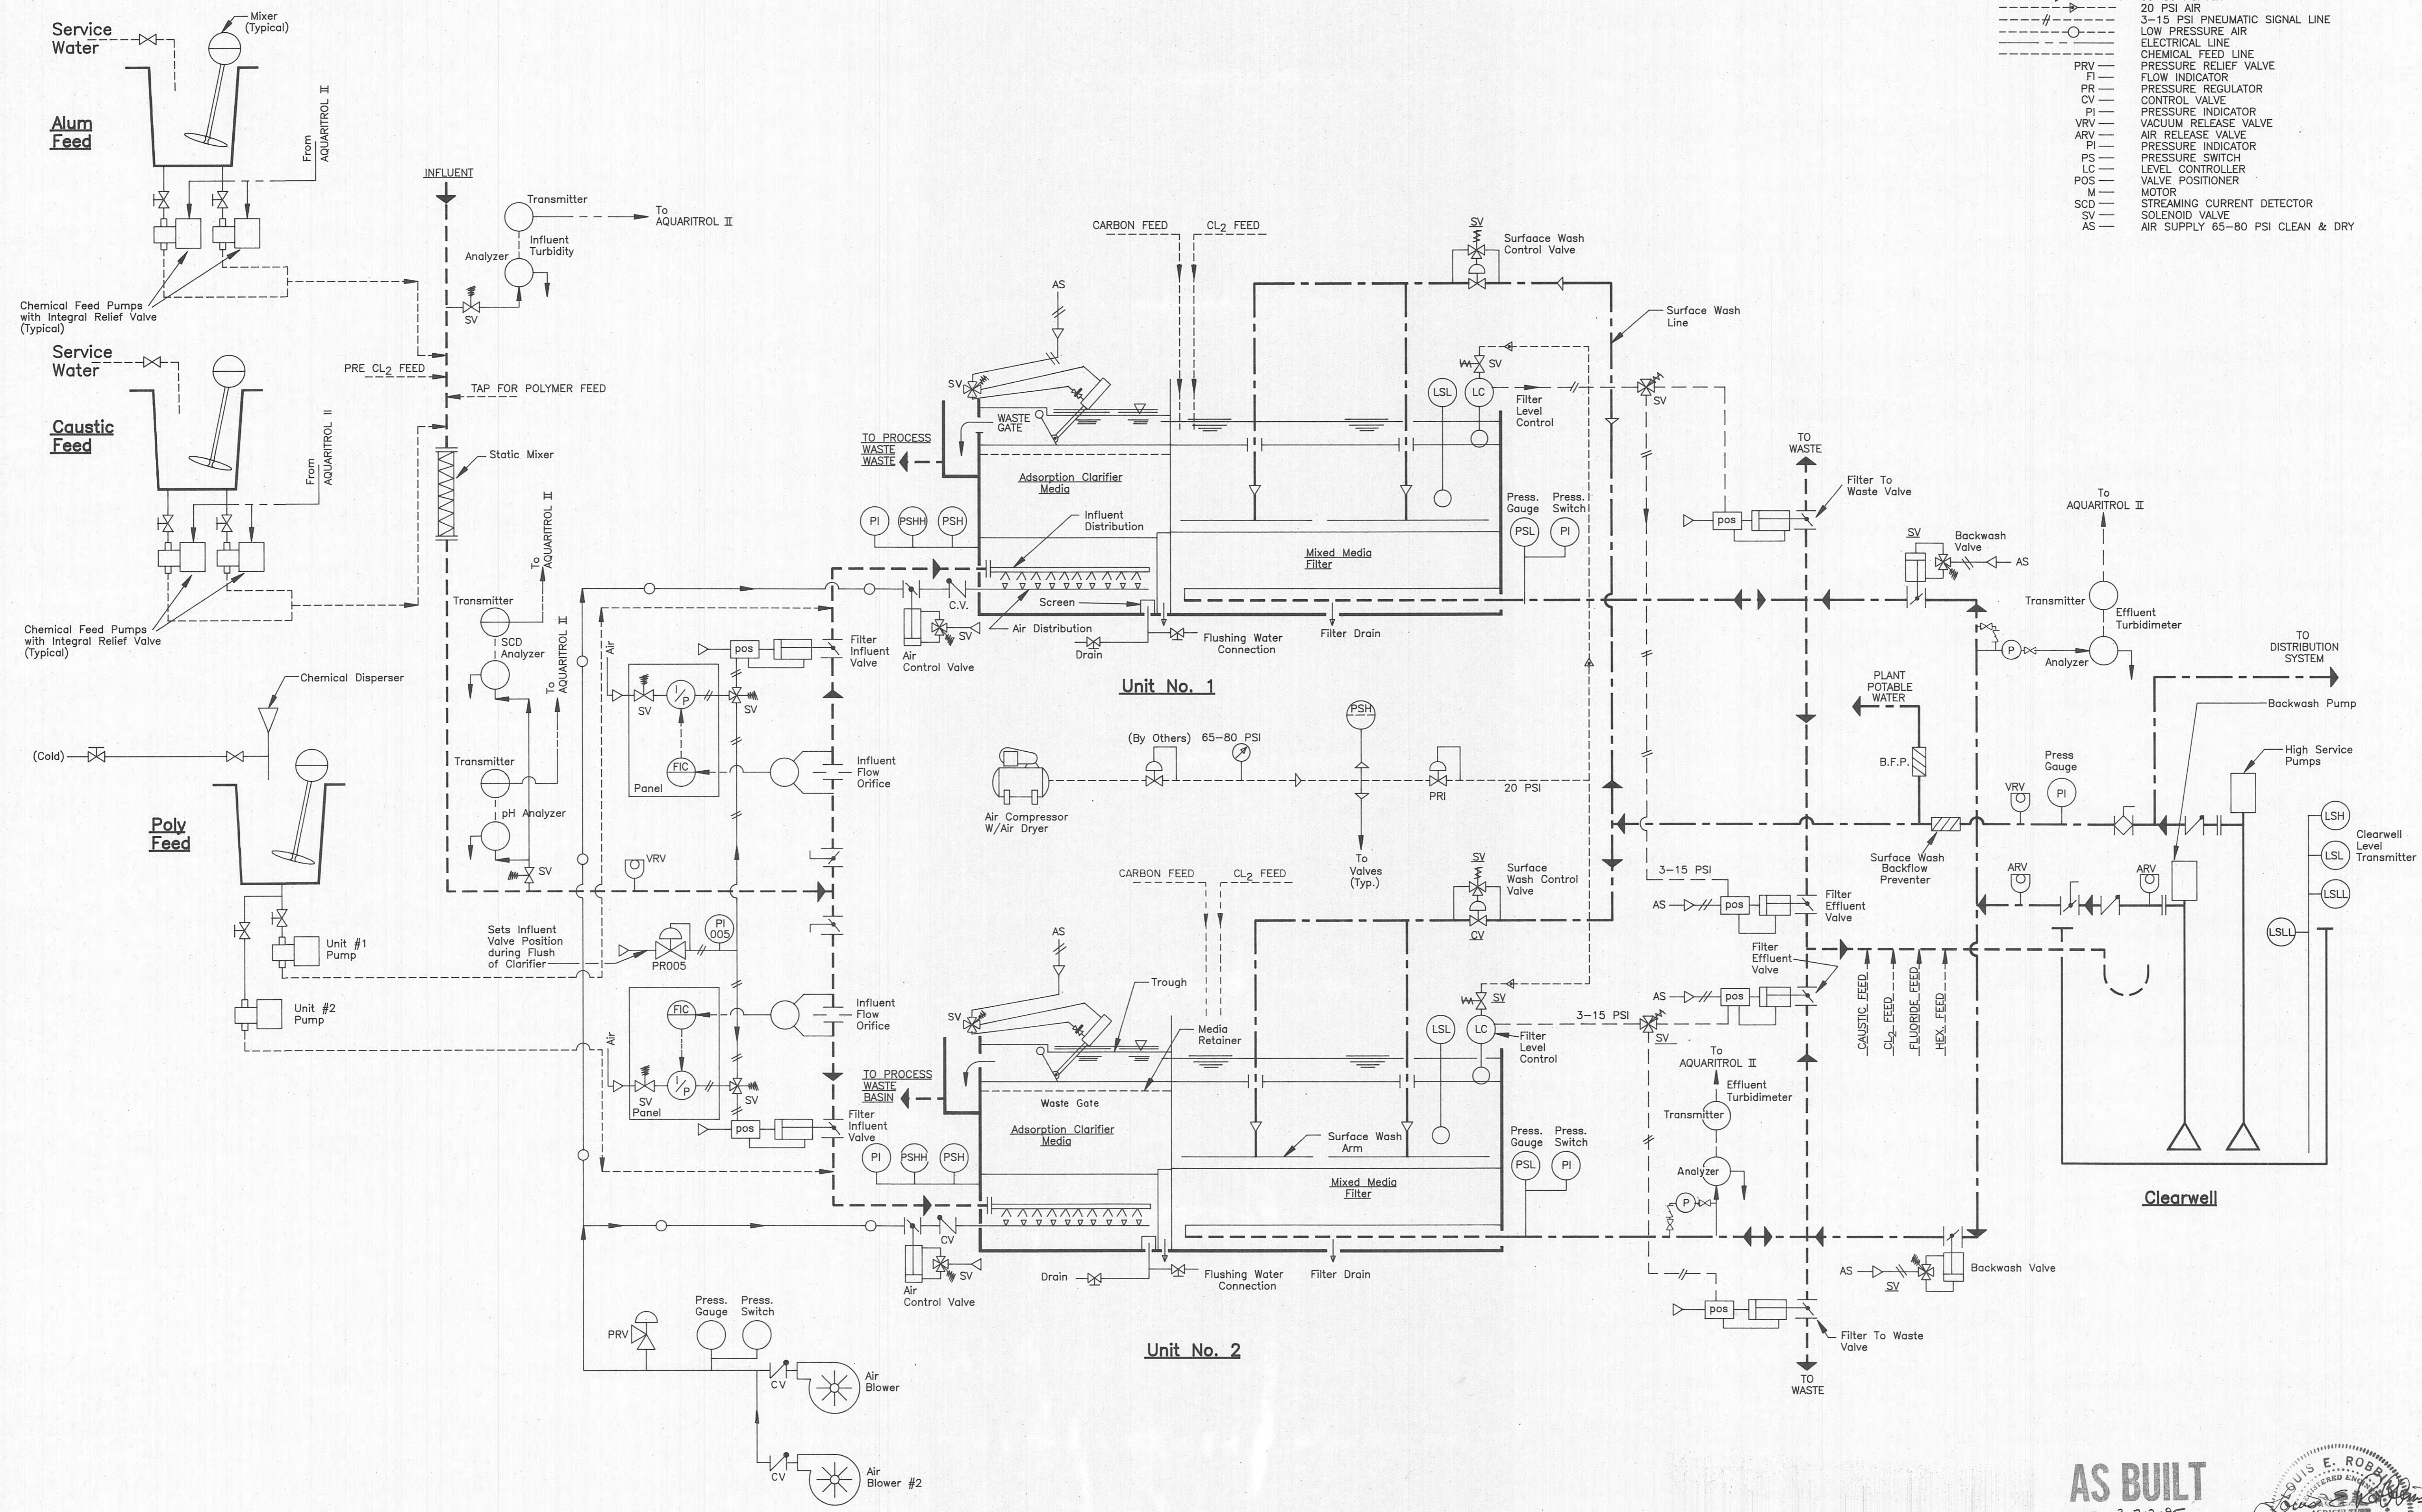


AS BUILT
 DATE: 3-20-95
 APPROVED: D.M.




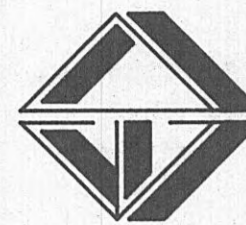


- CHLORINATION LEGEND
- A. TON CYLINDERS
 - B. CAPTIVE YOLK TYPE TON CYLINDER VALVE
 - C. HEADER VALVE
 - D. BALL VALVE
 - E. AMMONIA UNION
 - F. FILTER
 - G. CHLORINE GAS PRESSURE GAUGE W/HEADER VALVE
 - H. HEATER - DRIP LEG
 - I. VACUUM REGULATOR
 - J. REMOTE PRESSURE RELIEF VALVE
 - K. CHLORINATOR
 - L. WATER PRESSURE GAUGE
 - M. SOLENOID VALVE
 - N. PRESSURE REGULATING VALVE
 - O. Y-STRAINER
 - P. HOSE BIBB
 - Q. VENT SCREEN
 - R. TON CYLINDER SCALES
 - S. SCALES DIAL INDICATOR (REMOTE LOCATION)
 - T. UNION
 - U. CHECK VALVE
 - V. CORPORATION COCK MAIN CONNECTION

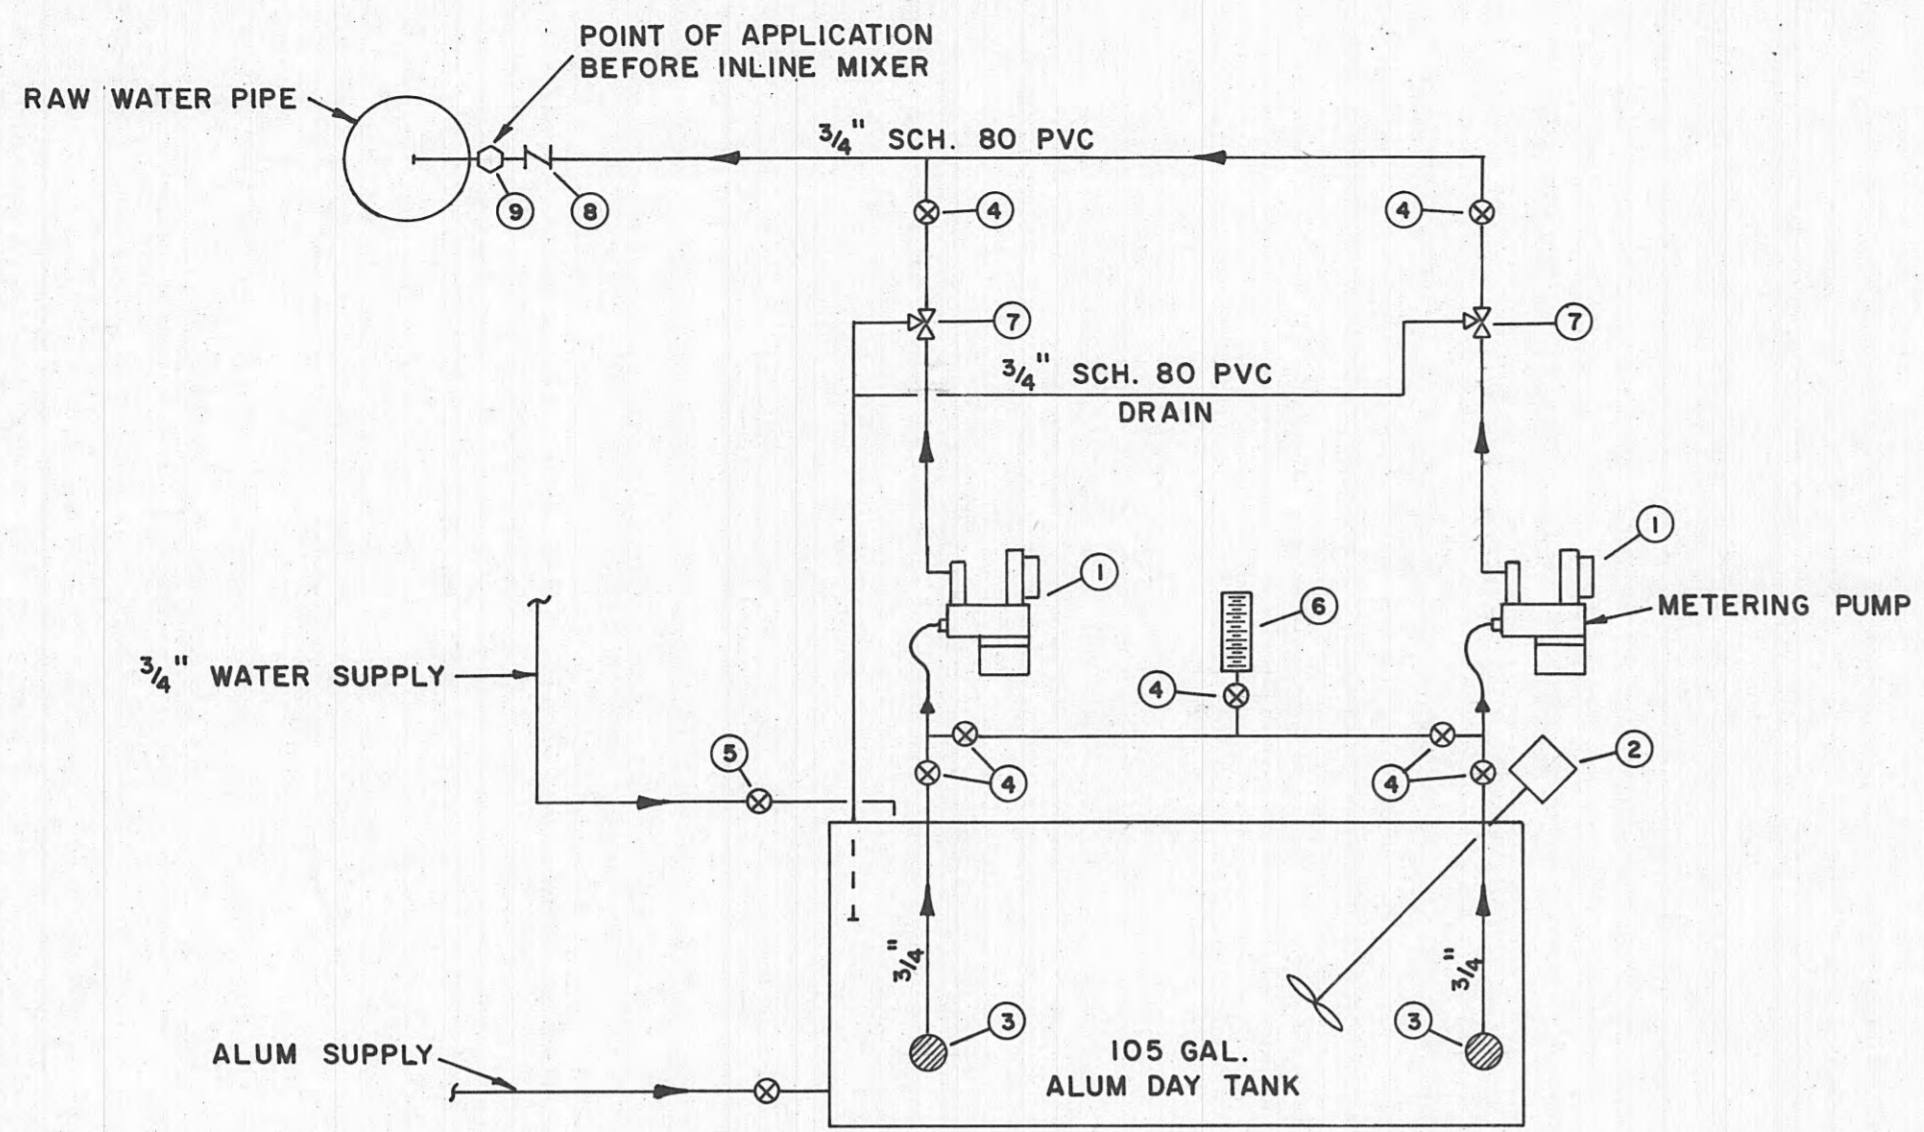


LIQUID ALUM FEED SCHEMATIC

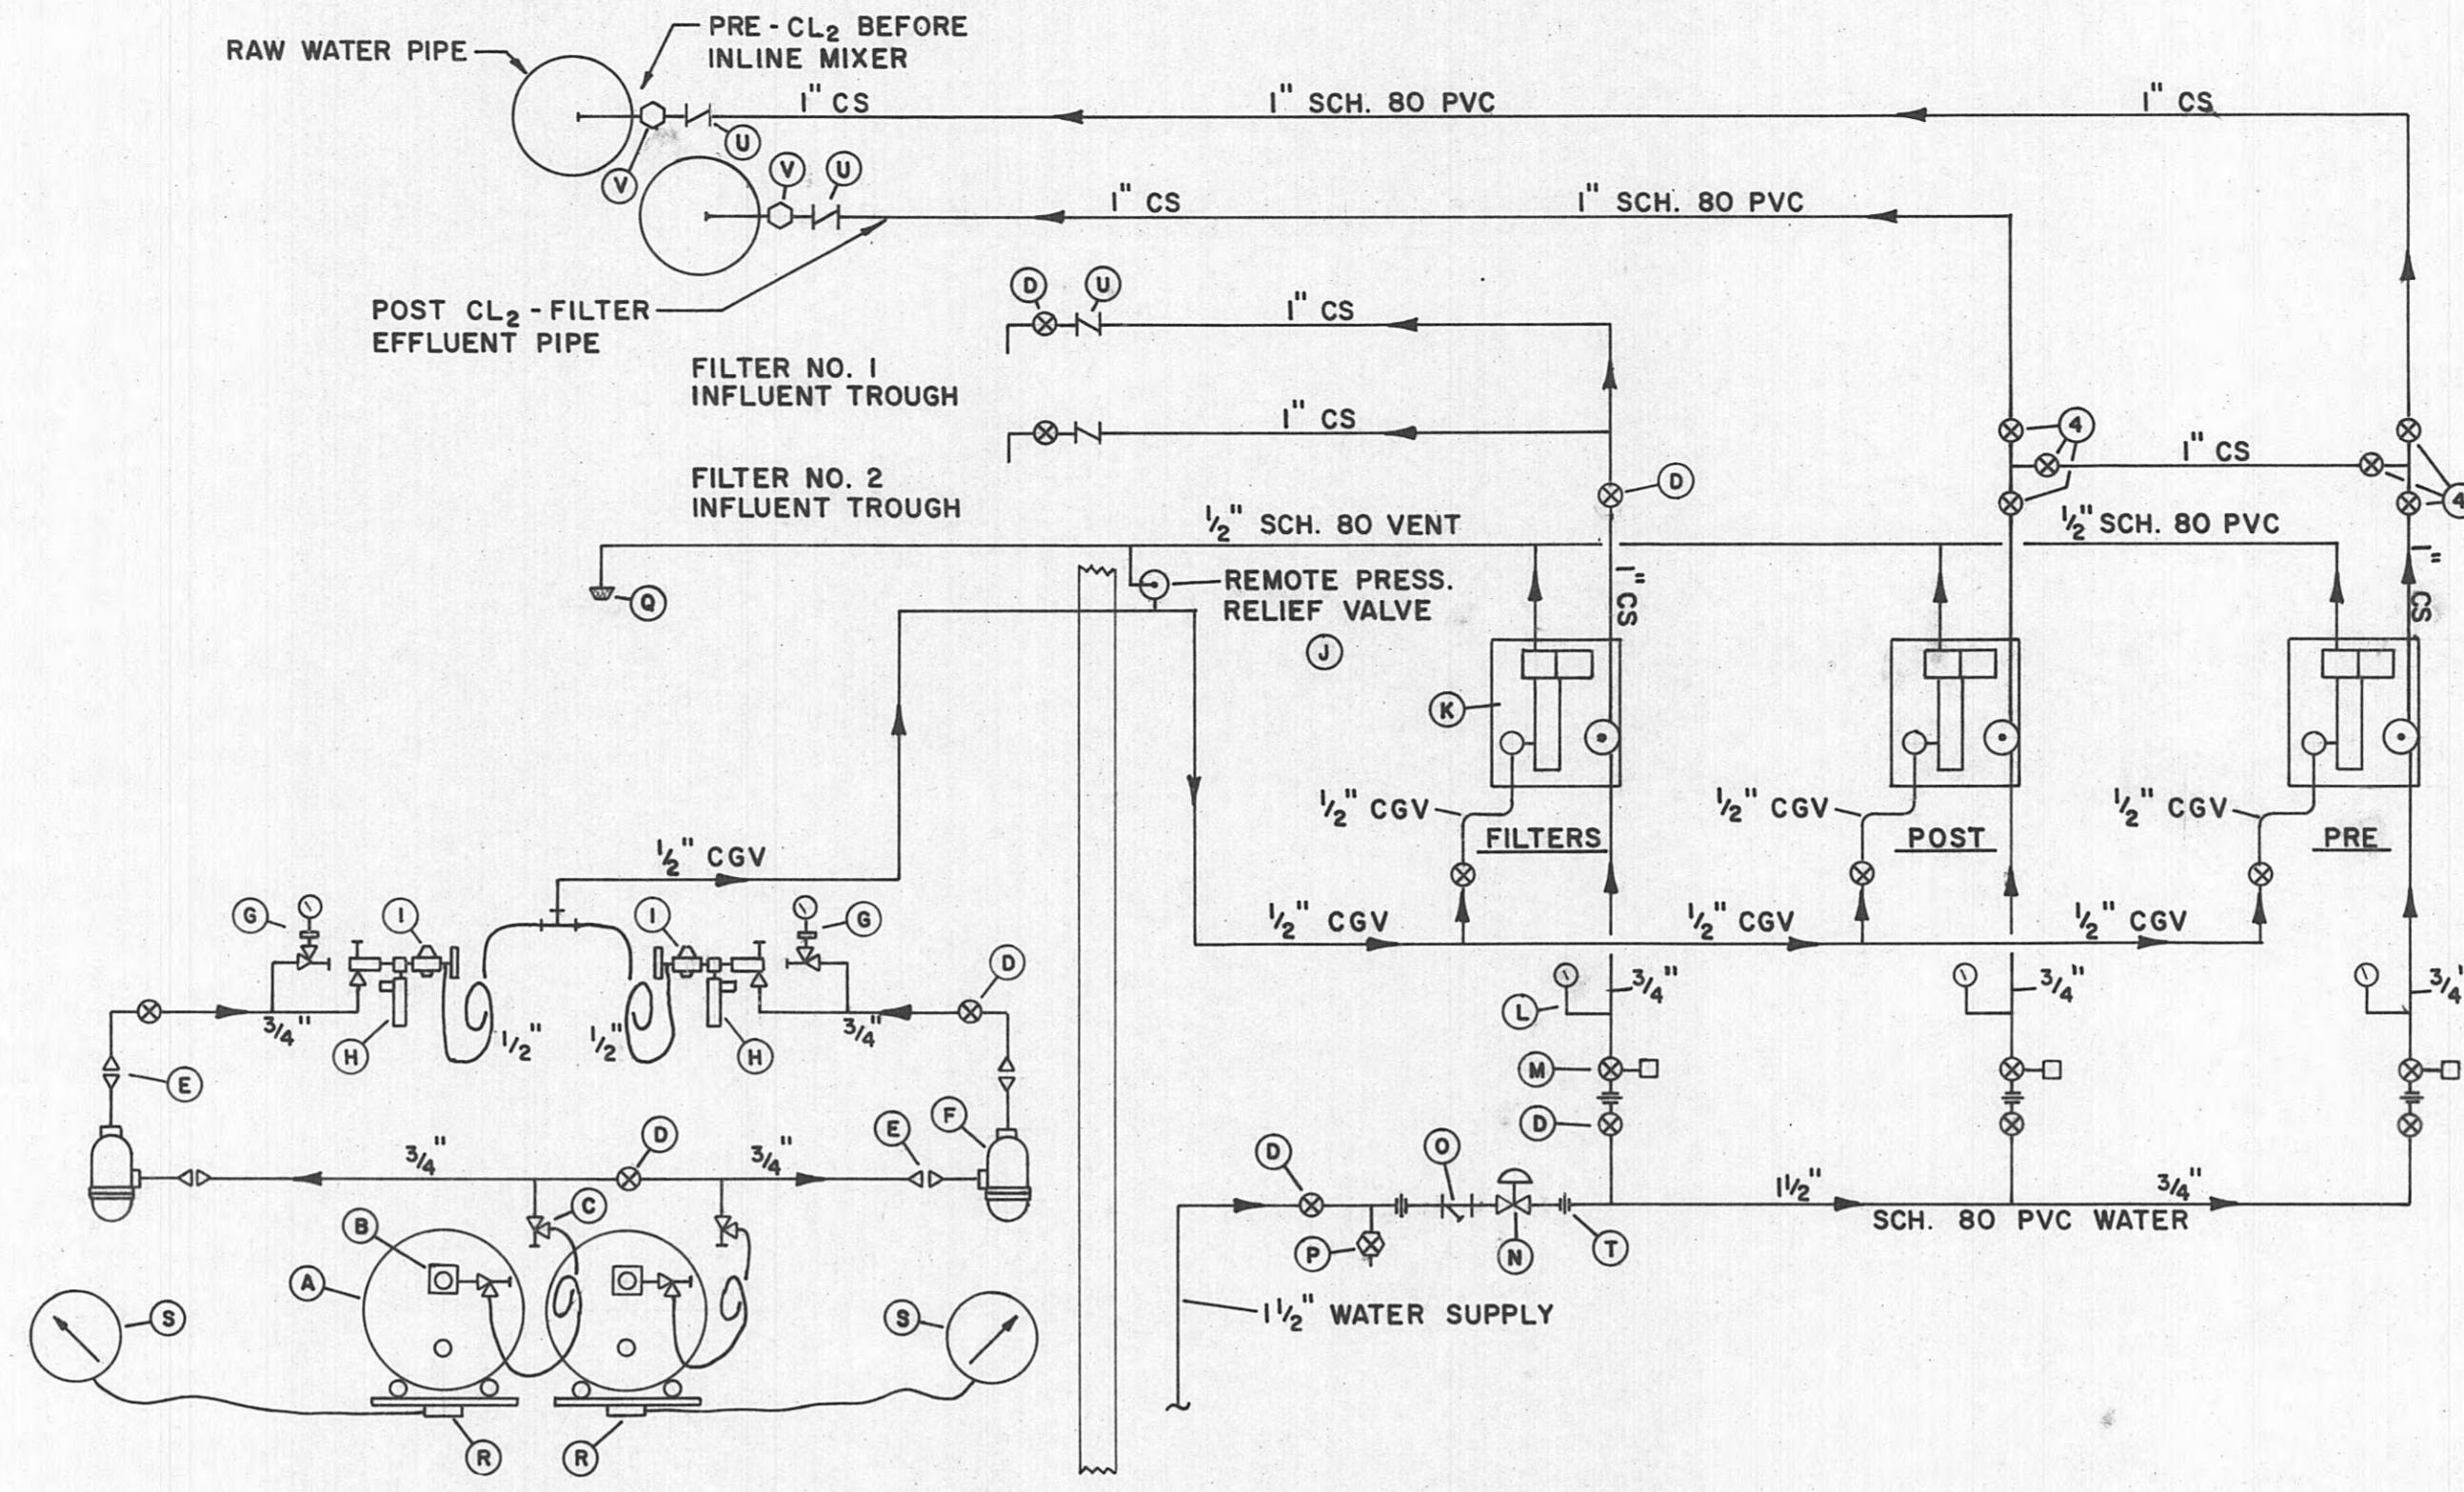


CHLORINATION SCHEMATIC

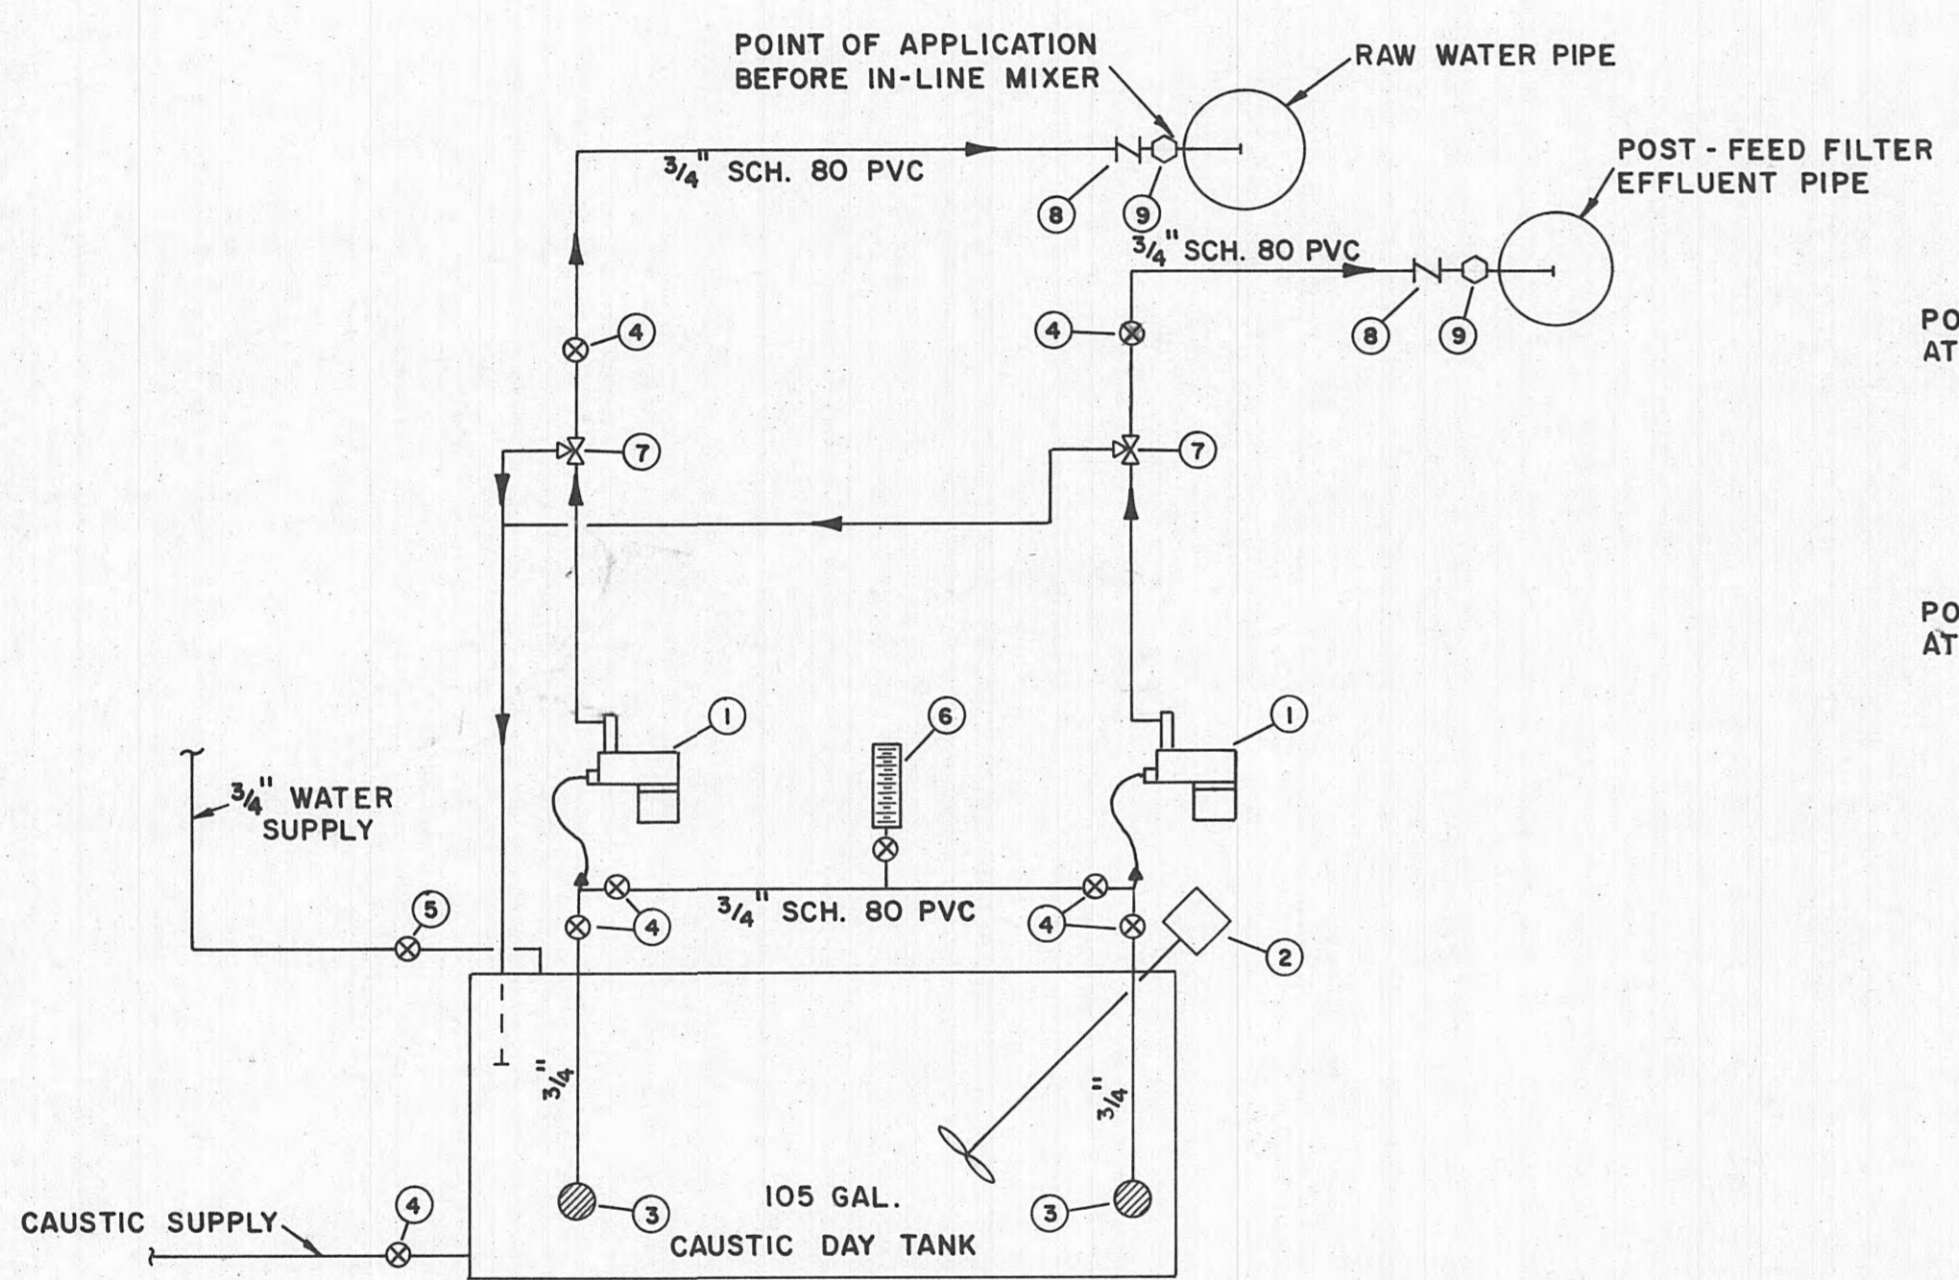


LIQUID CAUSTIC FEED SCHEMATIC

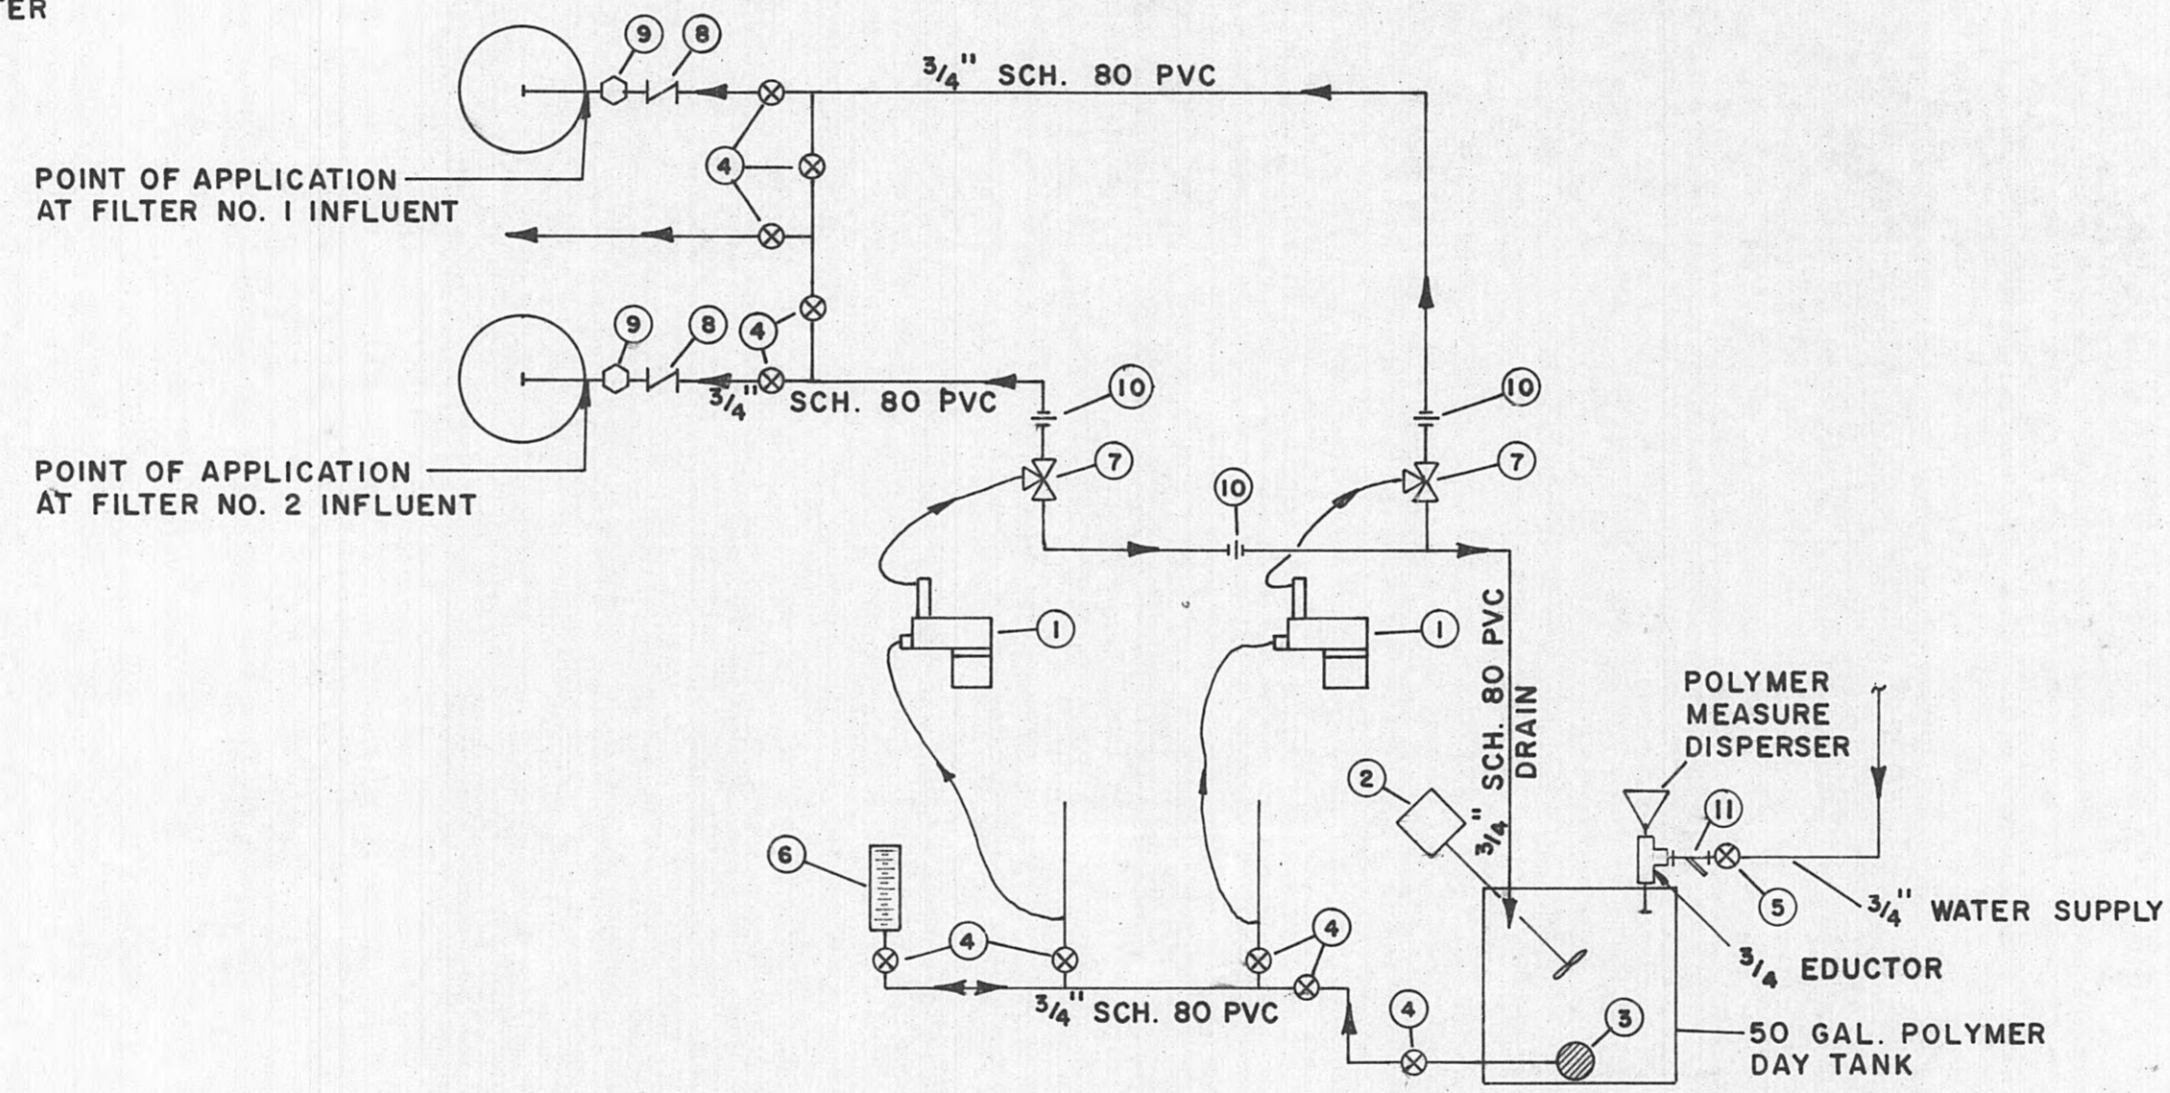


LIQUID POLYMER FEED SCHEMATIC

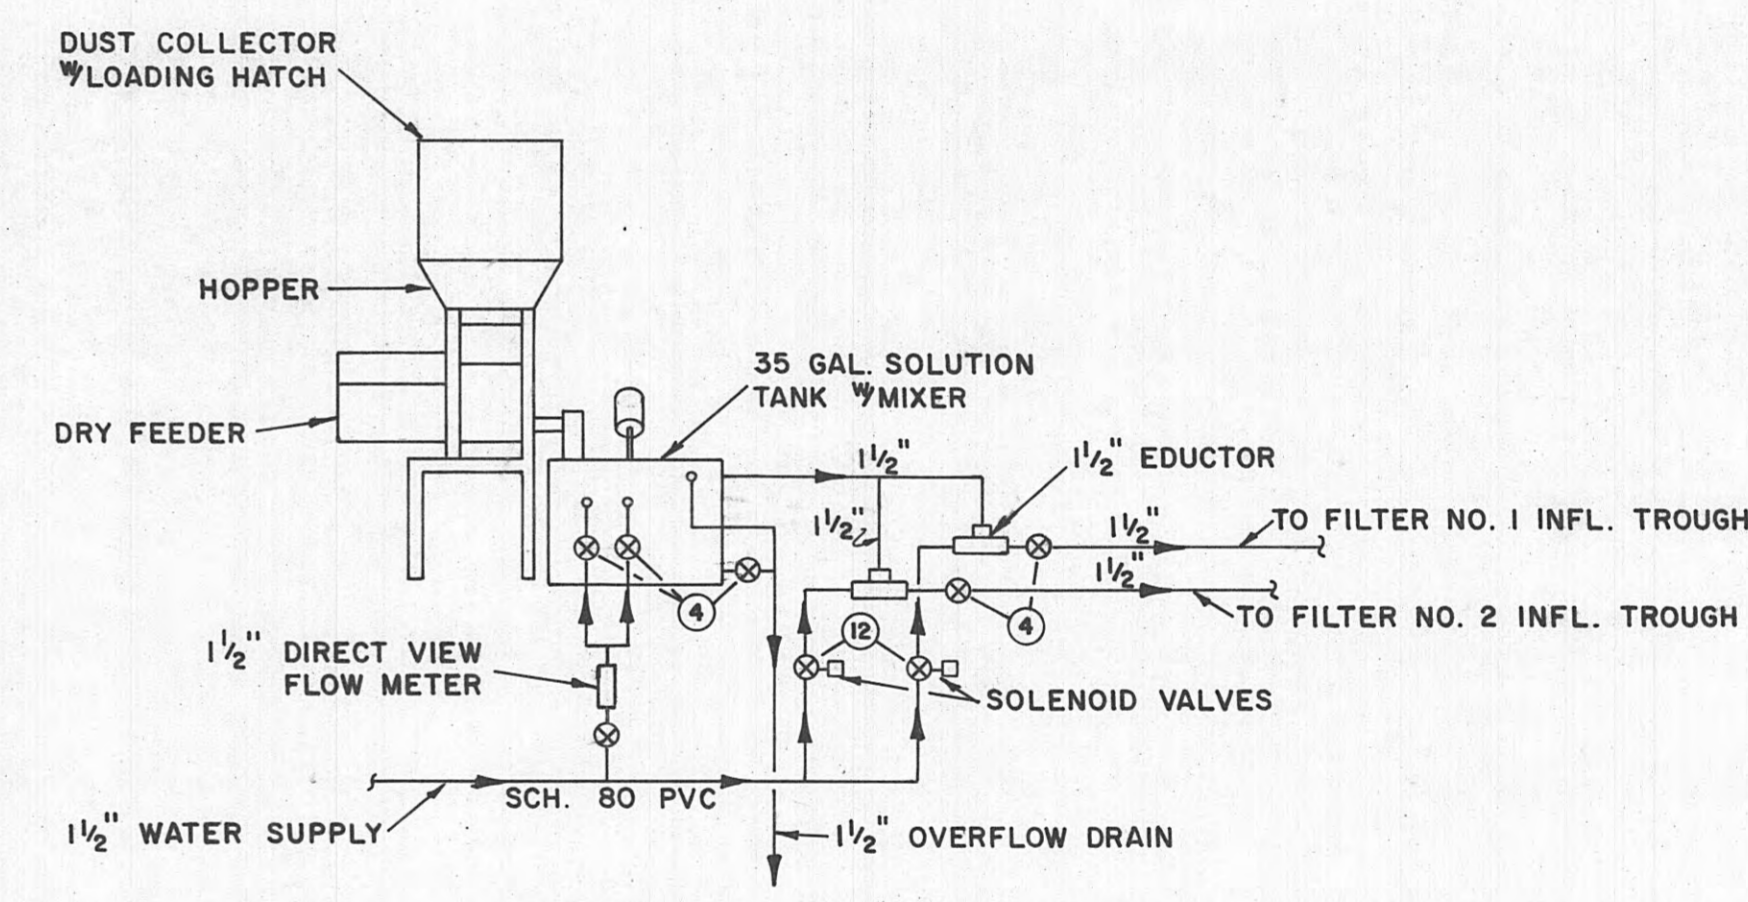


CARBON (DRY) FEED SCHEMATIC

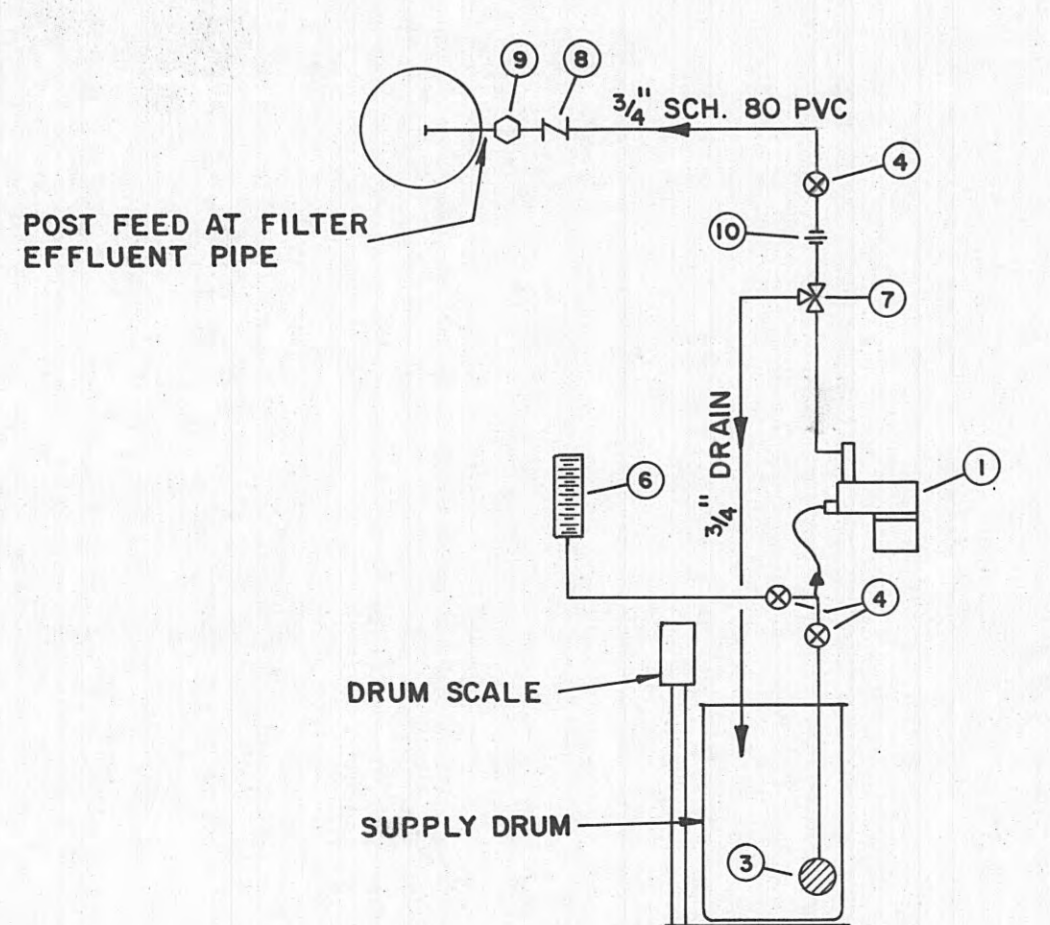

LIQUID FLUORIDE FEED SCHEMATIC

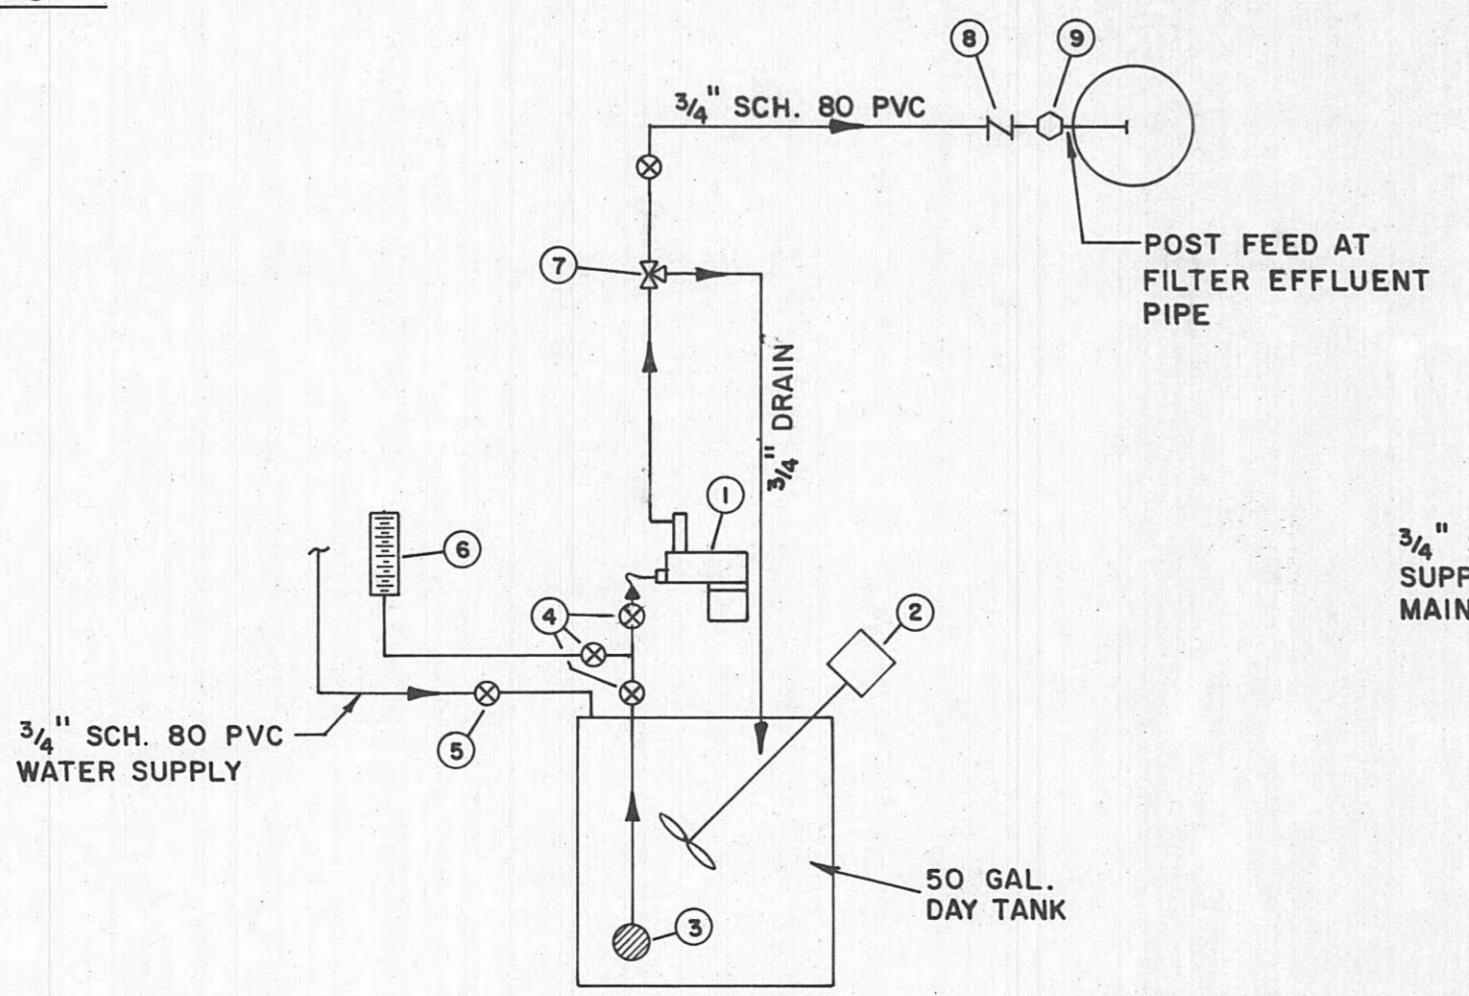


LIQUID PHOSPHATE FEED SCHEMATIC

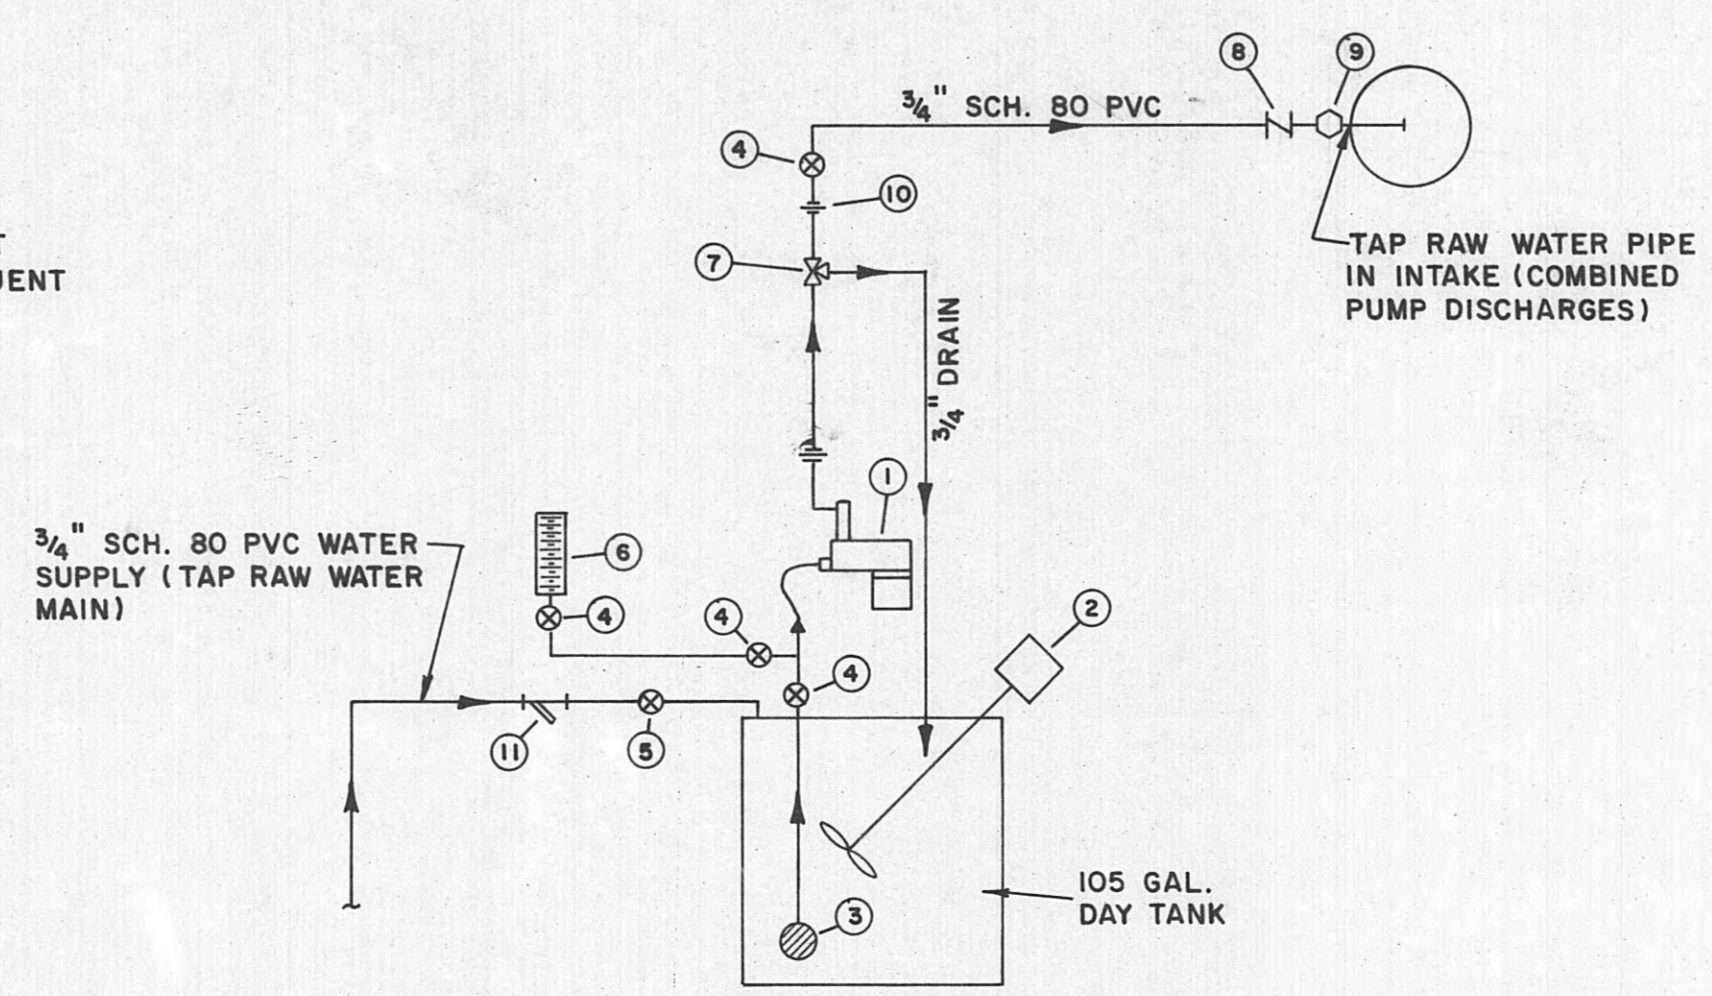


POTASSIUM PERMANGANATE FEED SCHEMATIC
(LOCATED IN INTAKE PUMP BUILDING)



- CHEMICAL FEED LEGEND
- 1. CHEMICAL METERING PUMP
 - 2. CHEMICAL MIXER
 - 3. FOOT VALVE/STRAINER
 - 4. BALL VALVES
 - 5. HOSE BIBB
 - 6. CALIBRATION CHAMBER
 - 7. PRESSURE RELIEF VALVE
 - 8. CHECK VALVE
 - 9. CORPORATION COCK MAIN CONNECTION
 - 10. UNION
 - 11. STRAINER
 - 12. SOLENOID VALVES

AS BUILT
DATE: 3-20-95
APPROVED: D.M.

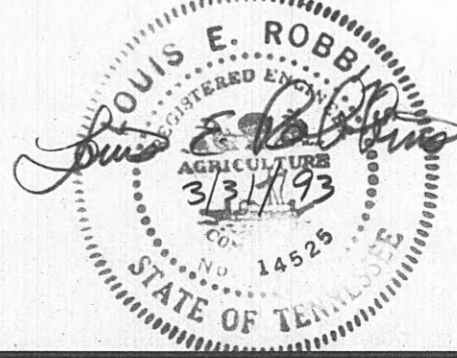


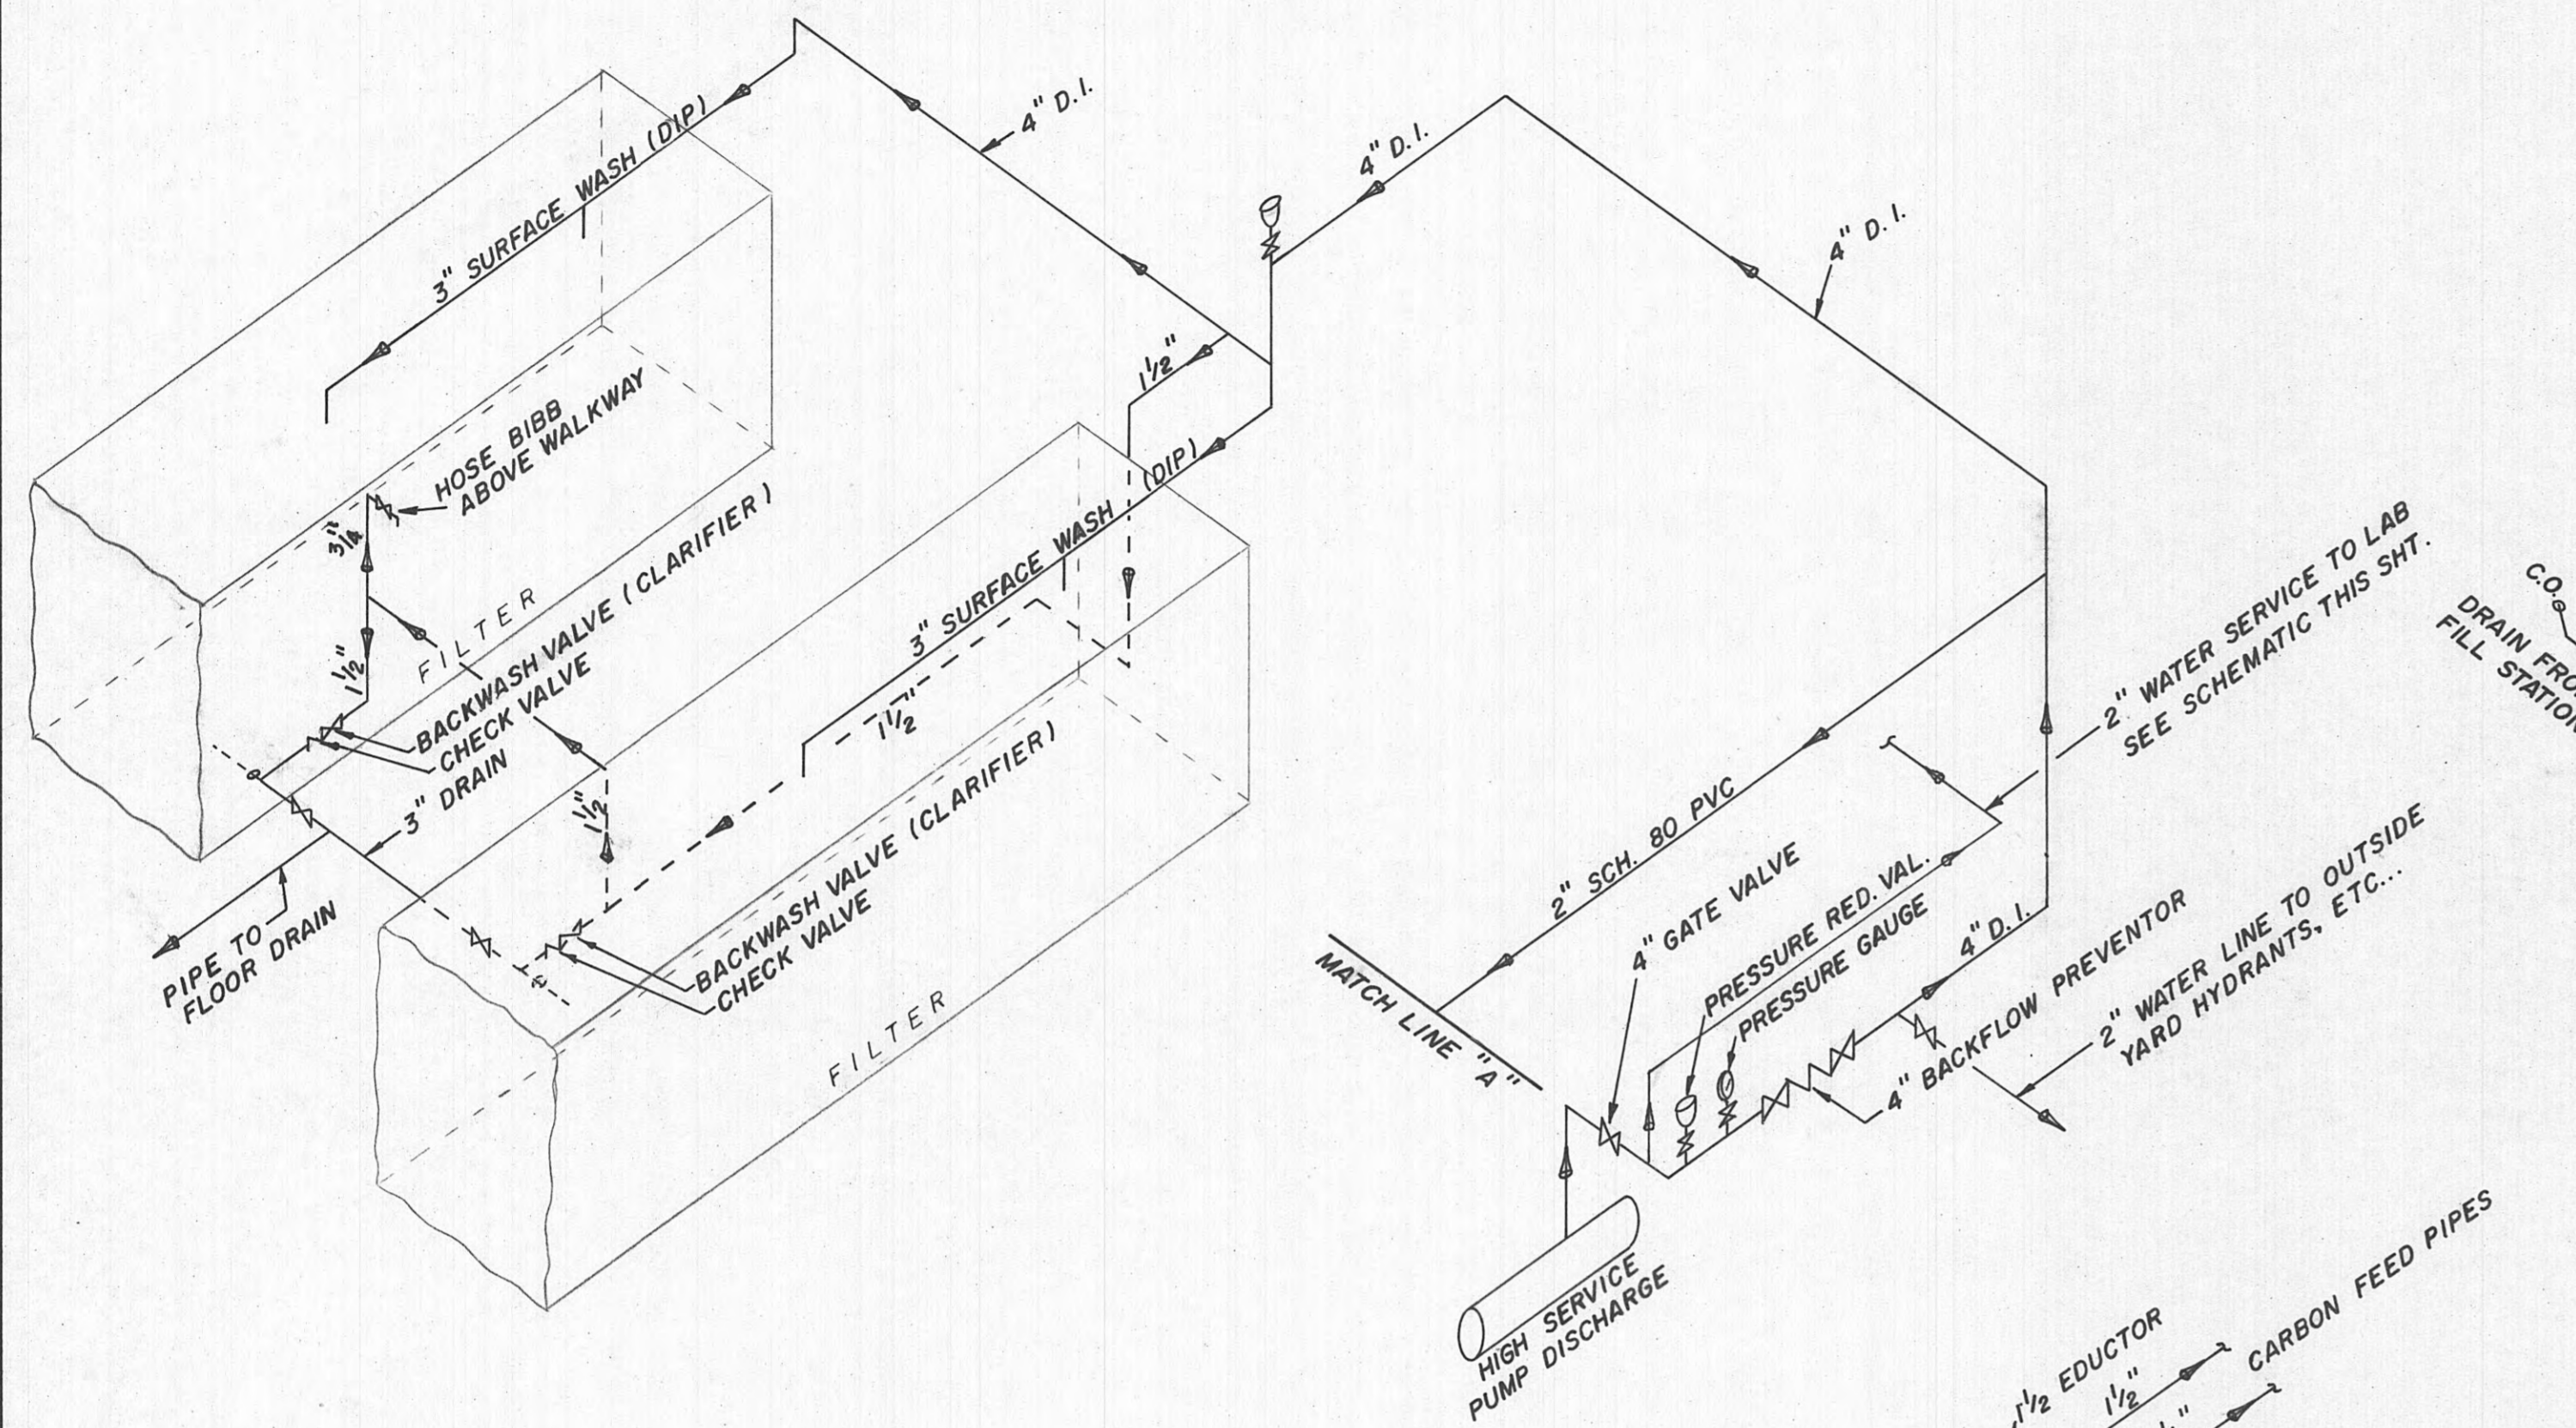


SURFACE WASH/CHEMICAL FEED WATER SCHEMATIC

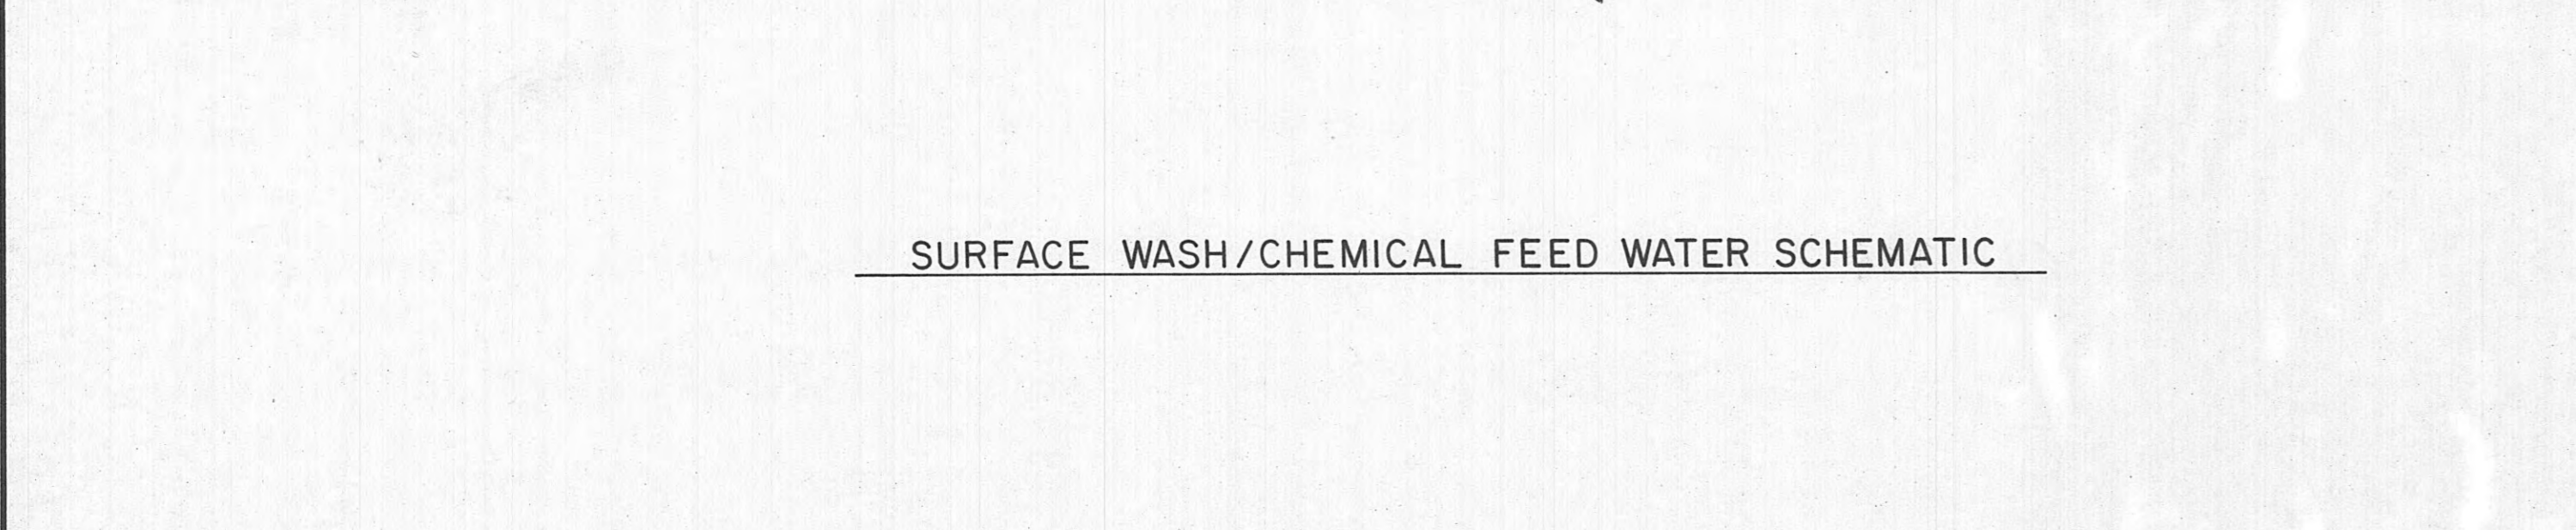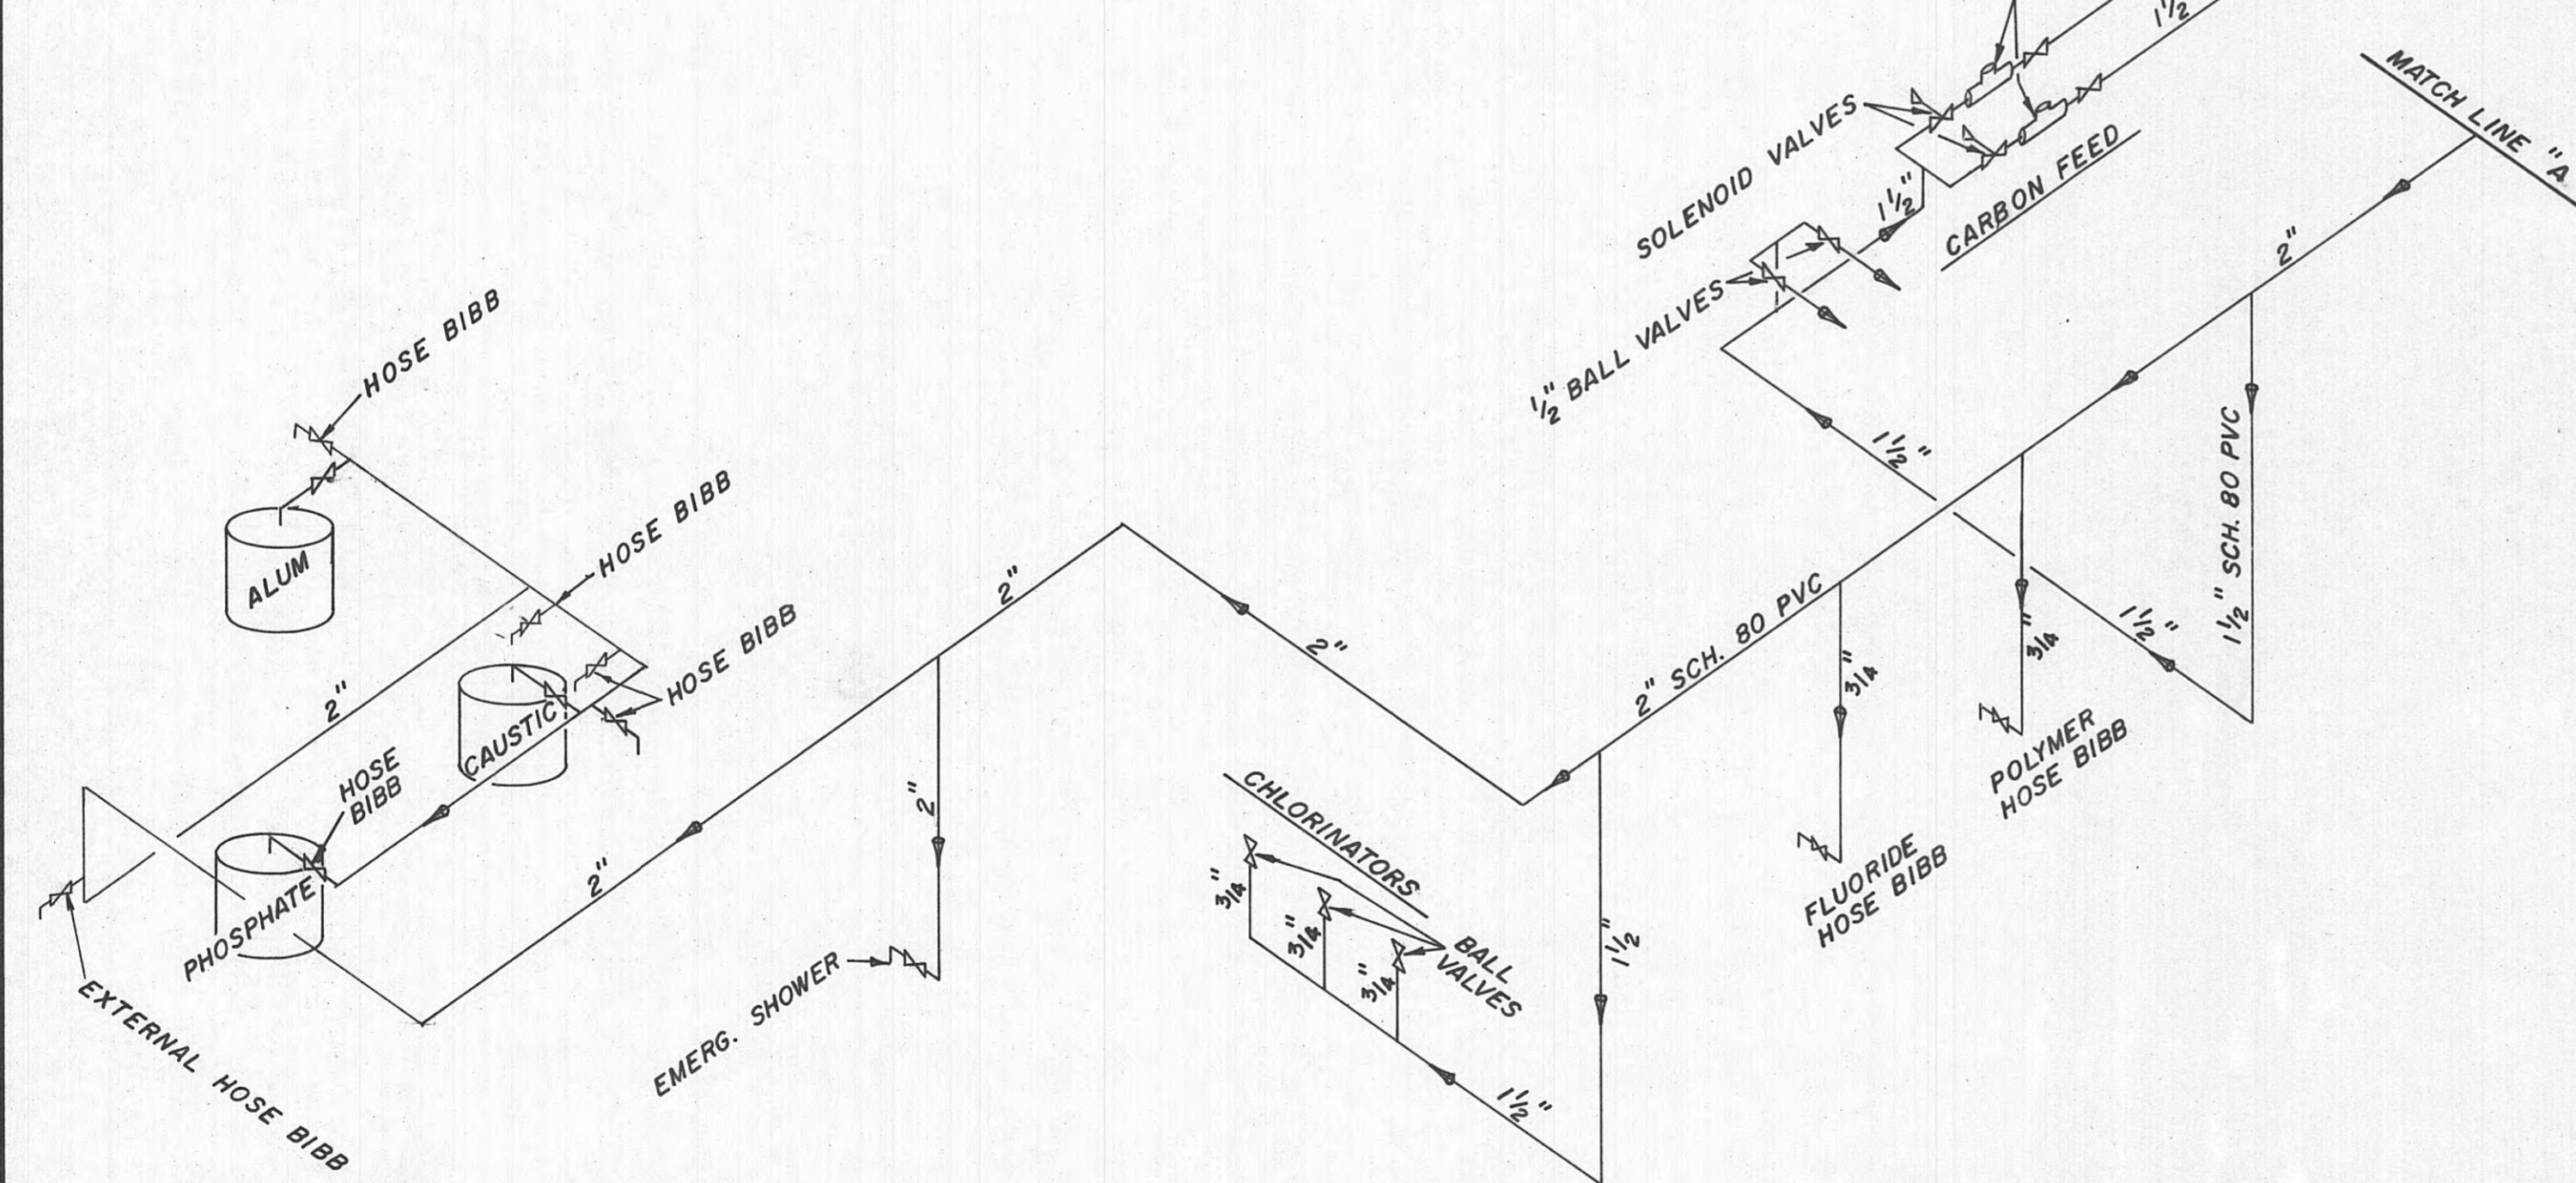

LABORATORY WATER SCHEMATIC

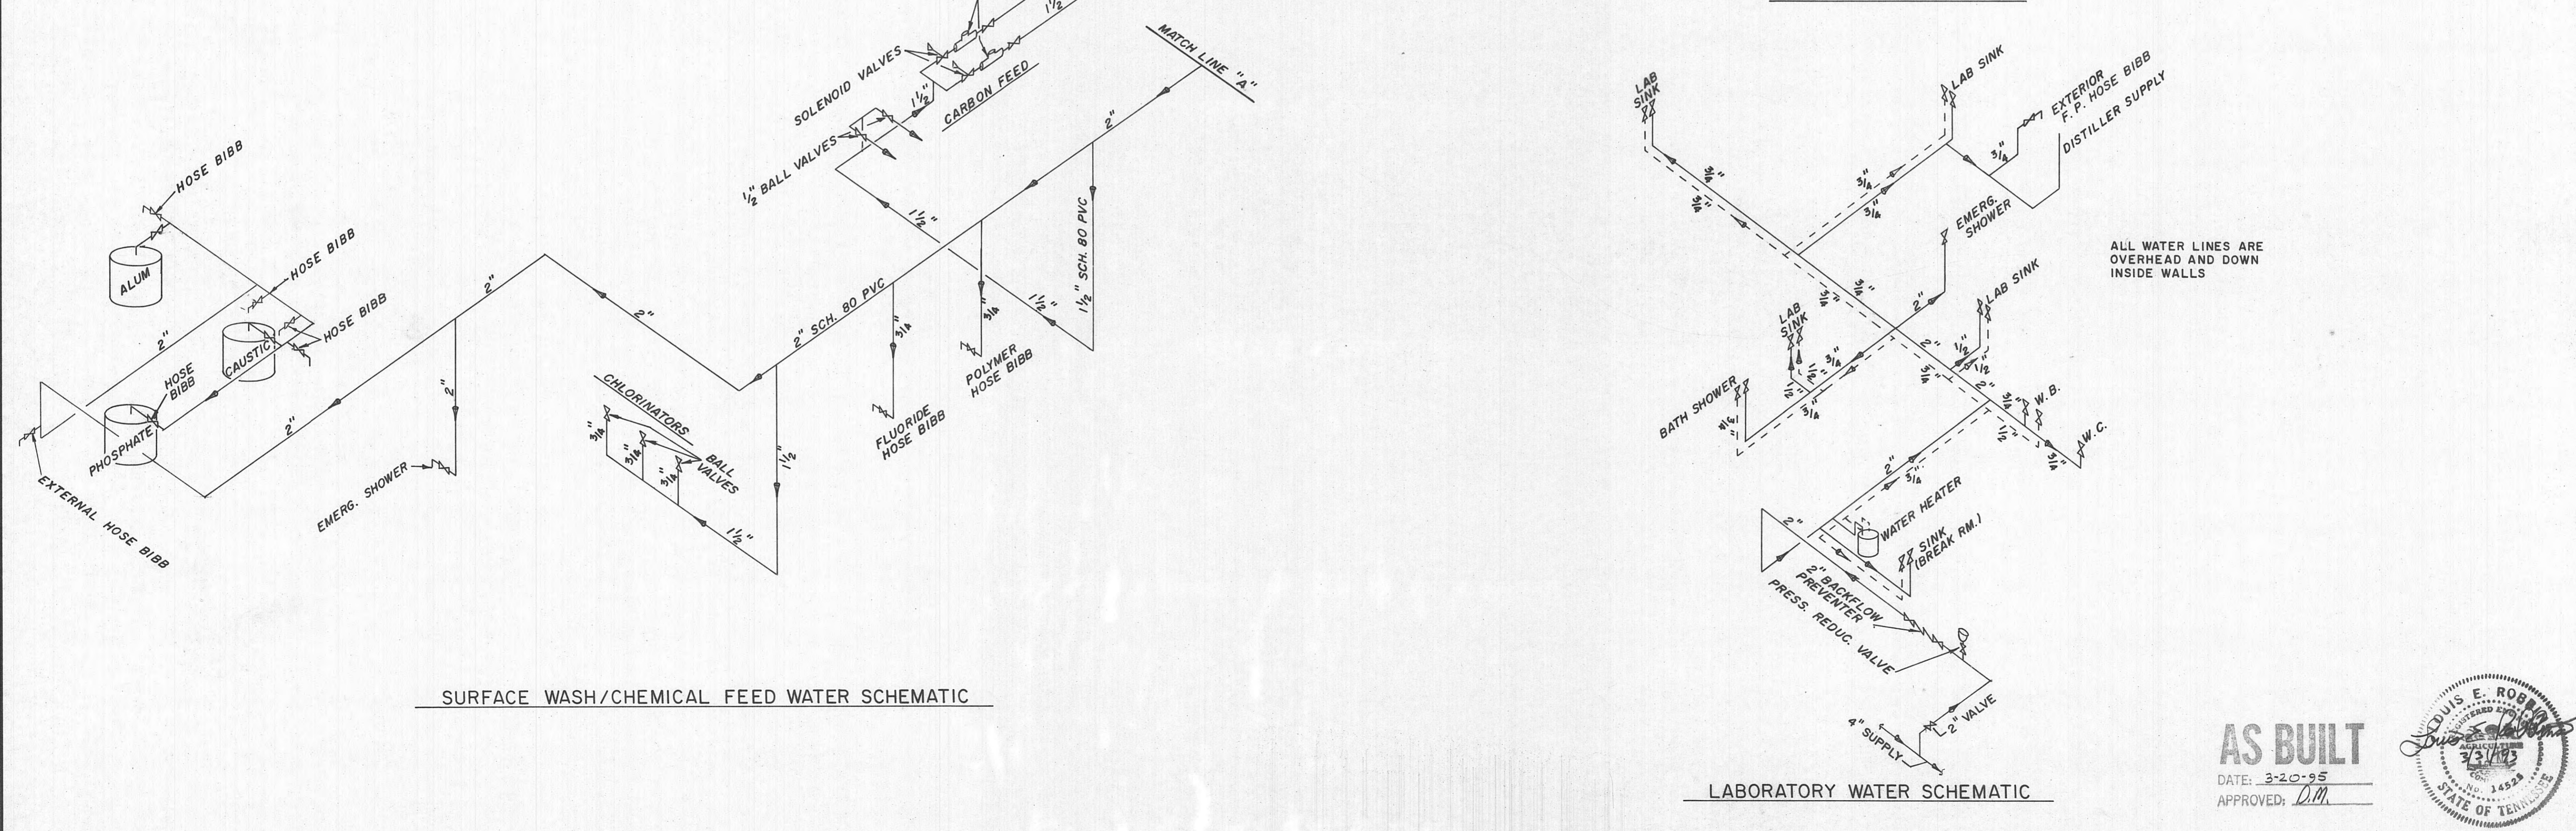

PLUMBING SCHEMATIC

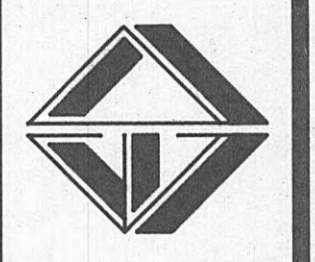



REVISIONS

4/19/93	ADD DRAIN FOR FILTER WASTE CHANNEL.
---------	-------------------------------------

DESIGNED: L. E. R.
DRAWN: D. G. R., D. M.
CHECKED: L. E. R.
DATE: MARCH, 1993
SCALE: NONE
PROJ. NO. 0592







AS BUILT
DATE: 3-20-95
APPROVED: *D.M.*

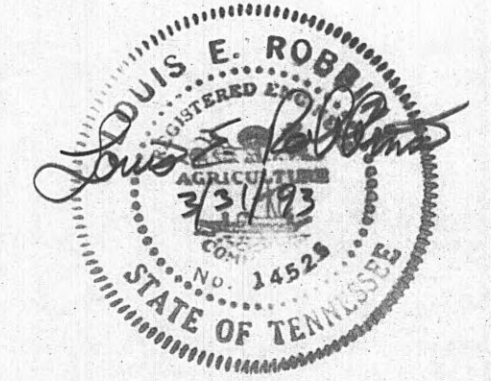

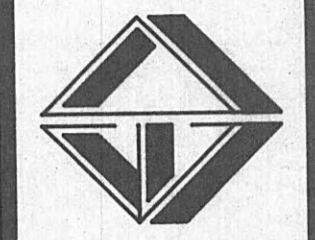


REVISIONS

DESIGNED: L.E.R.
 DRAWN: D.G.R., D.M.
 CHECKED: L.E.R.
 DATE: MARCH, 1993
 SCALE: AS NOTED
 PROJ. NO. 0592

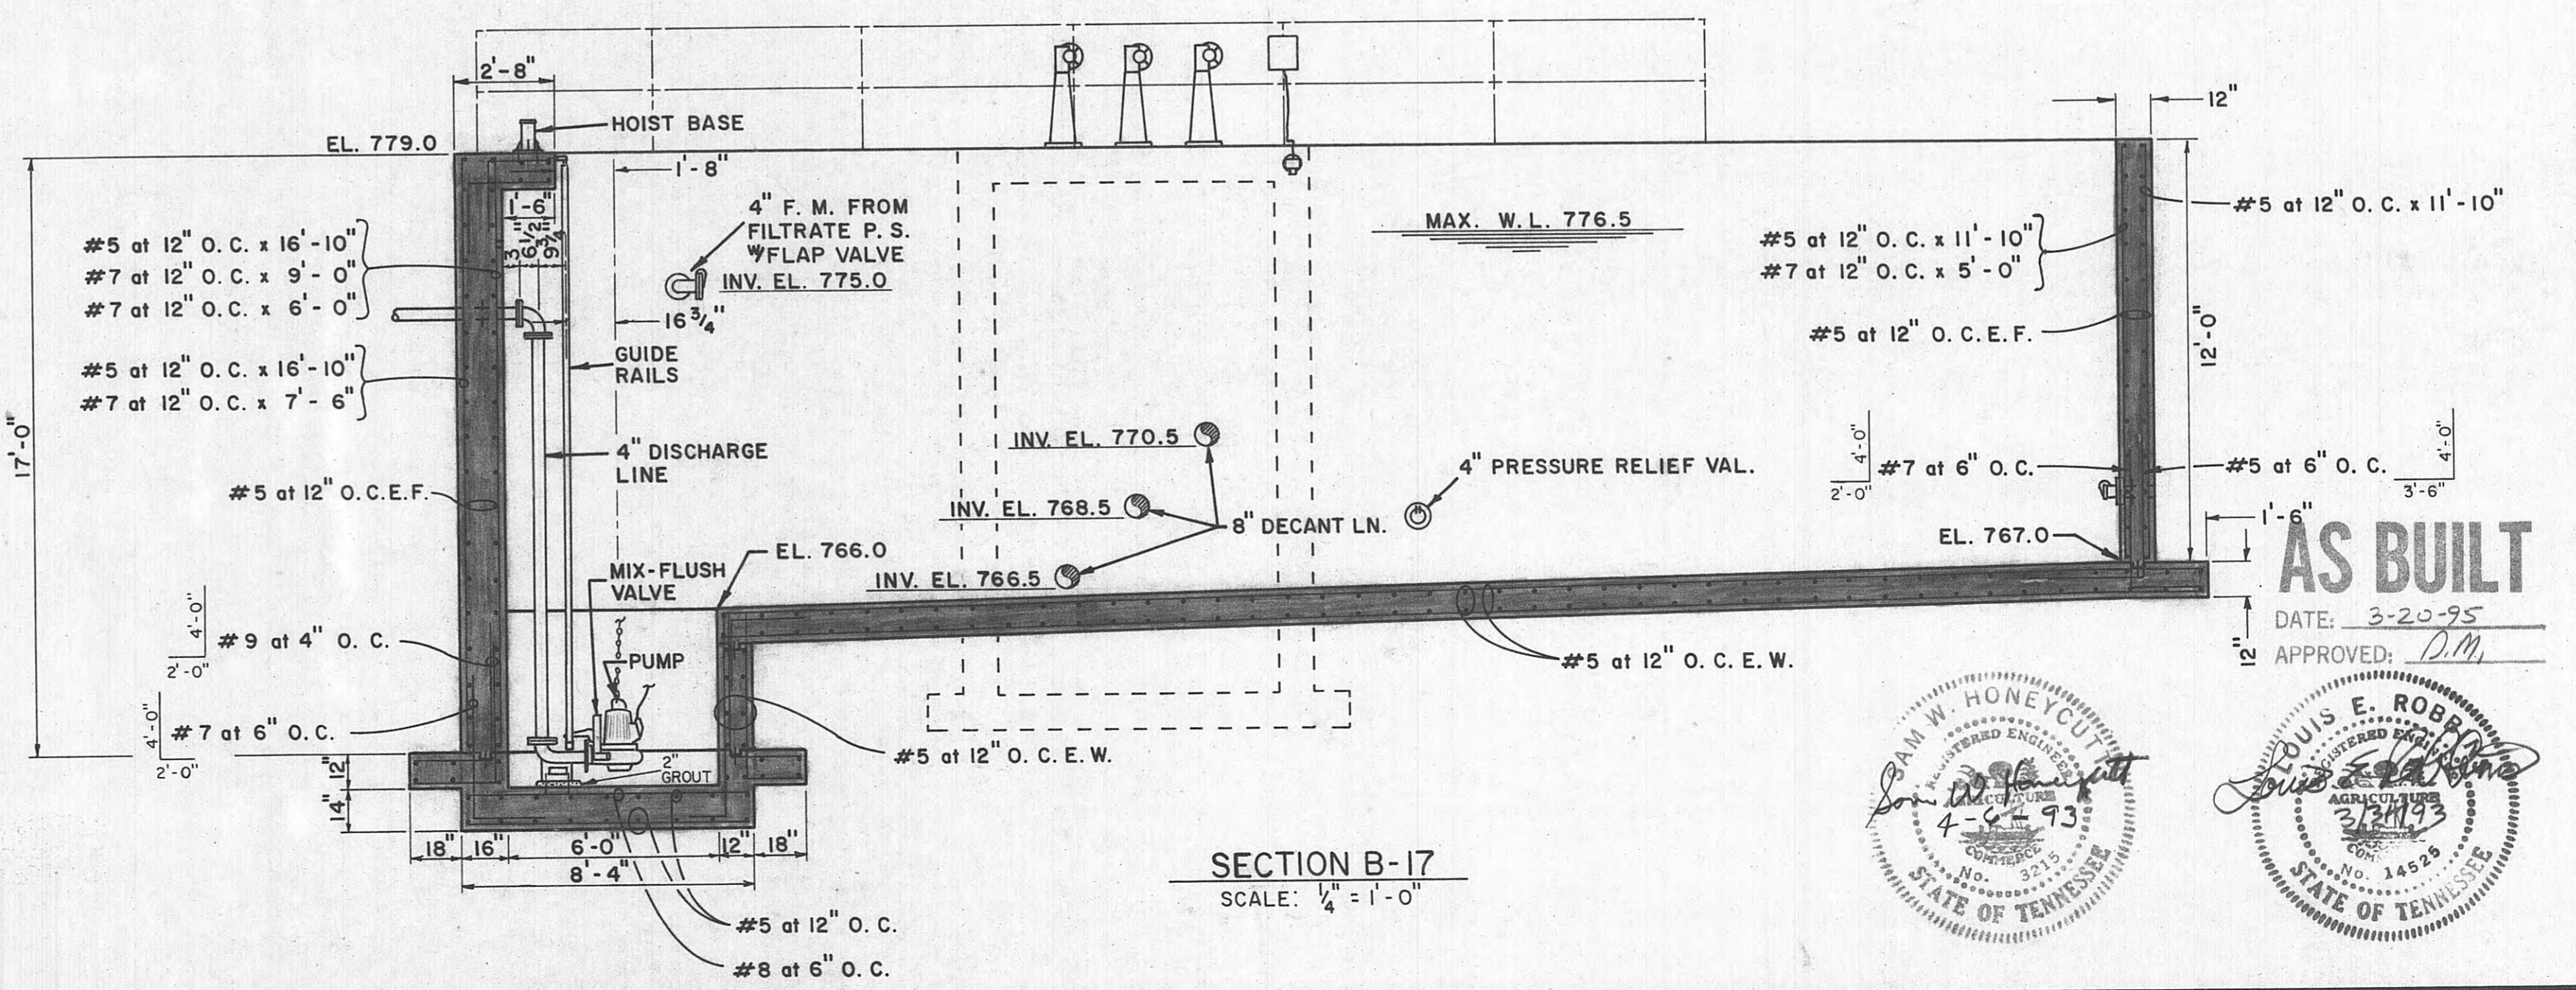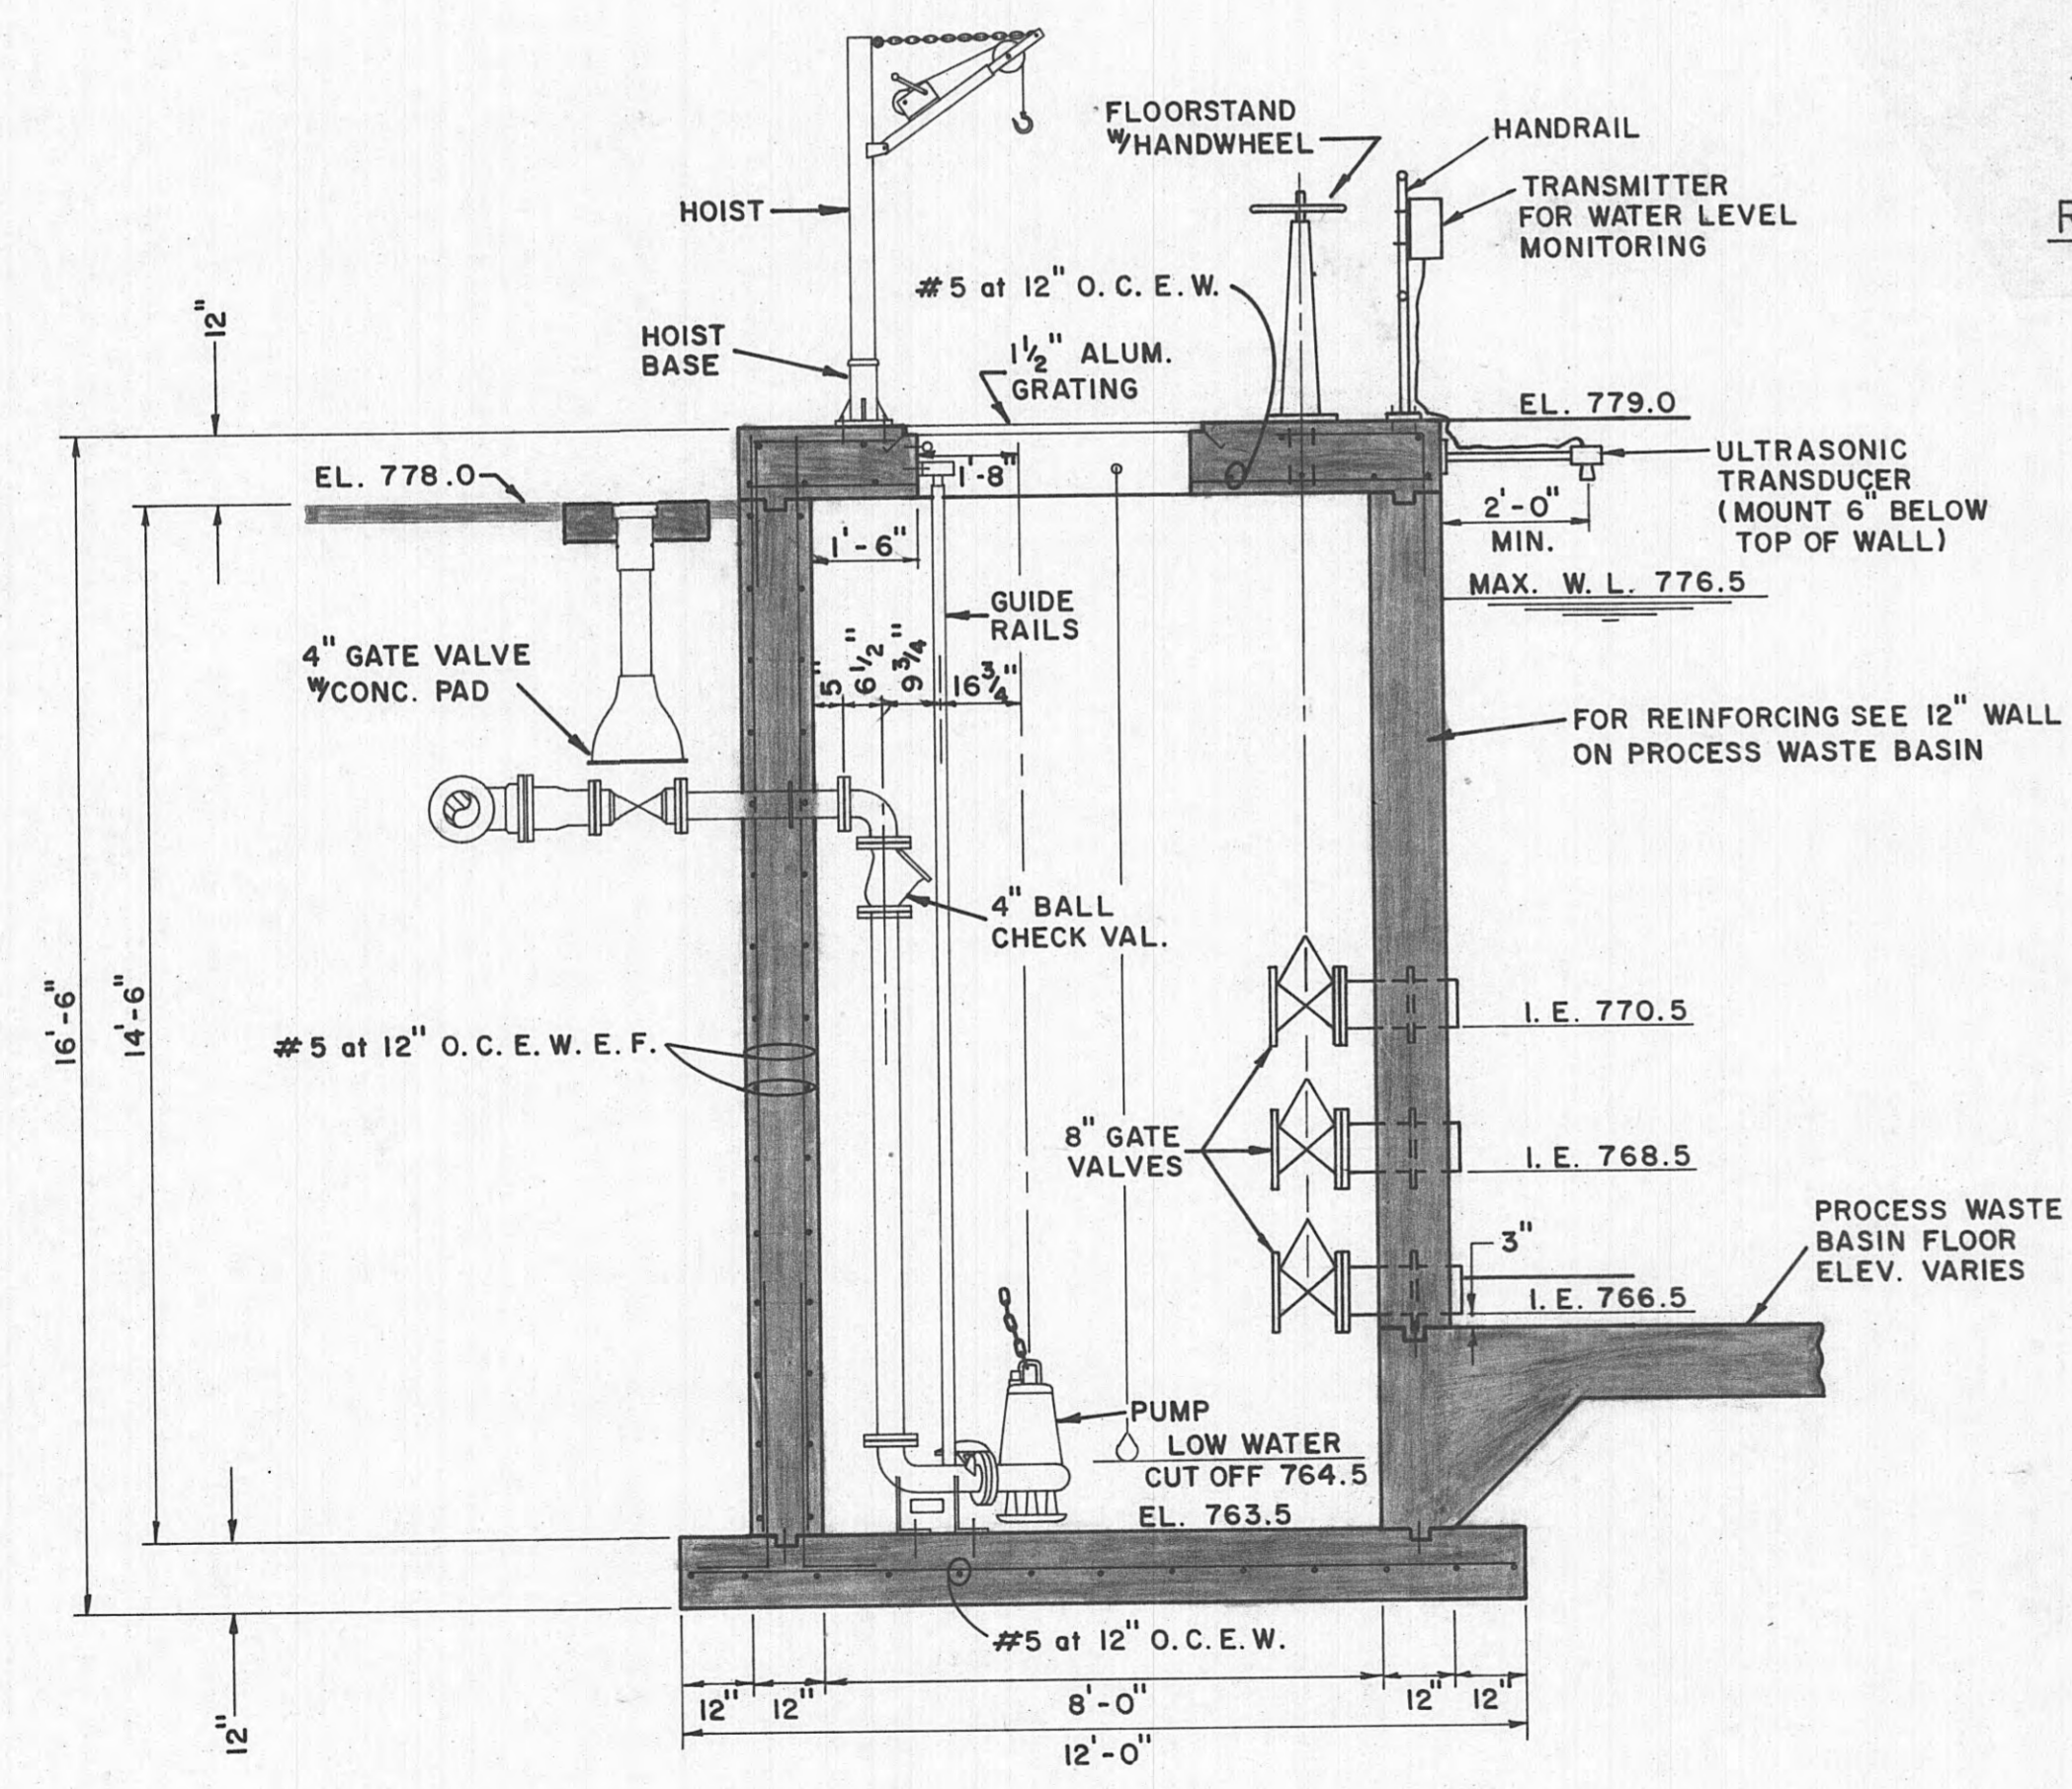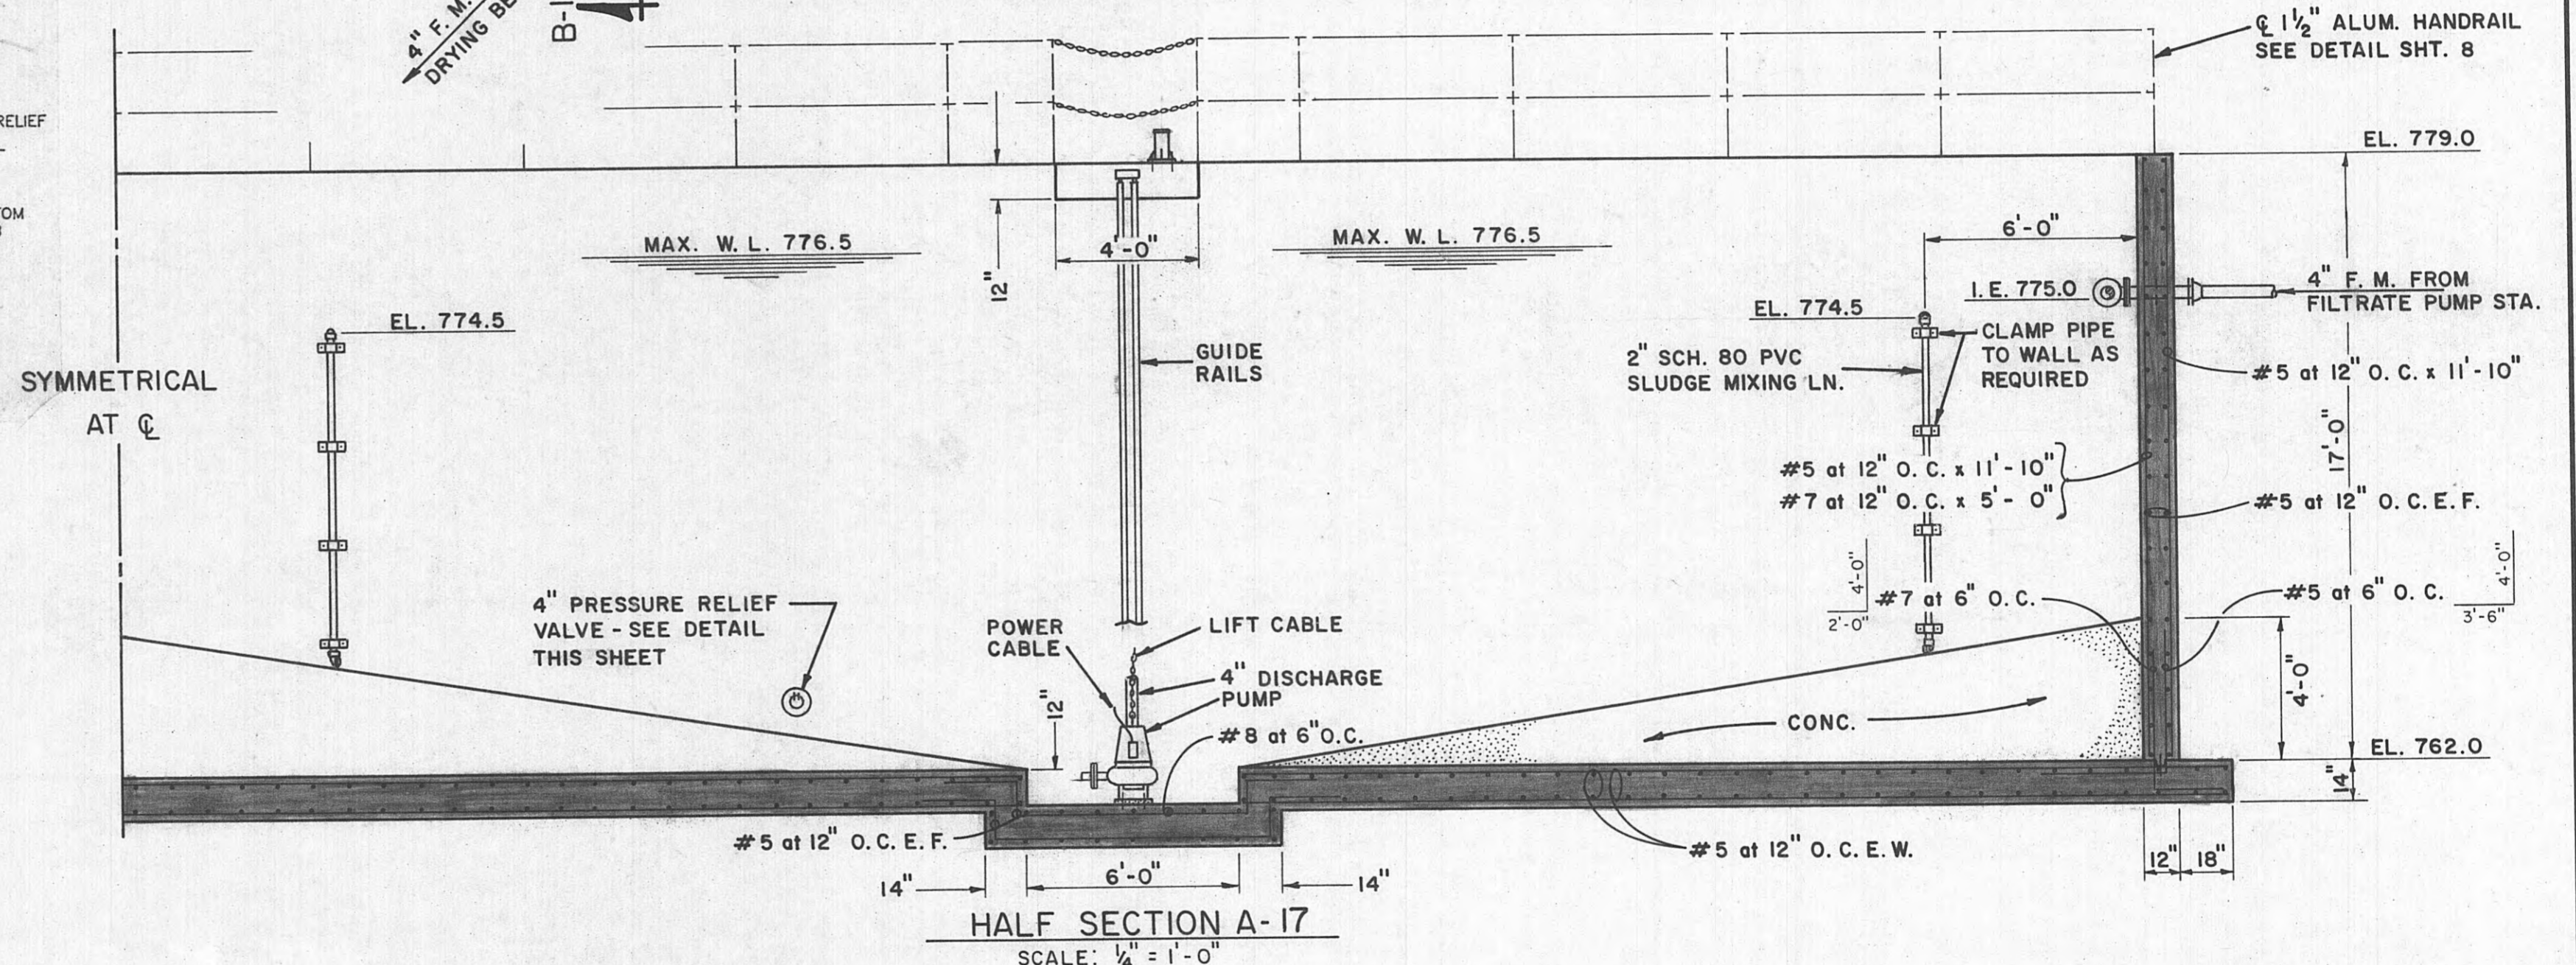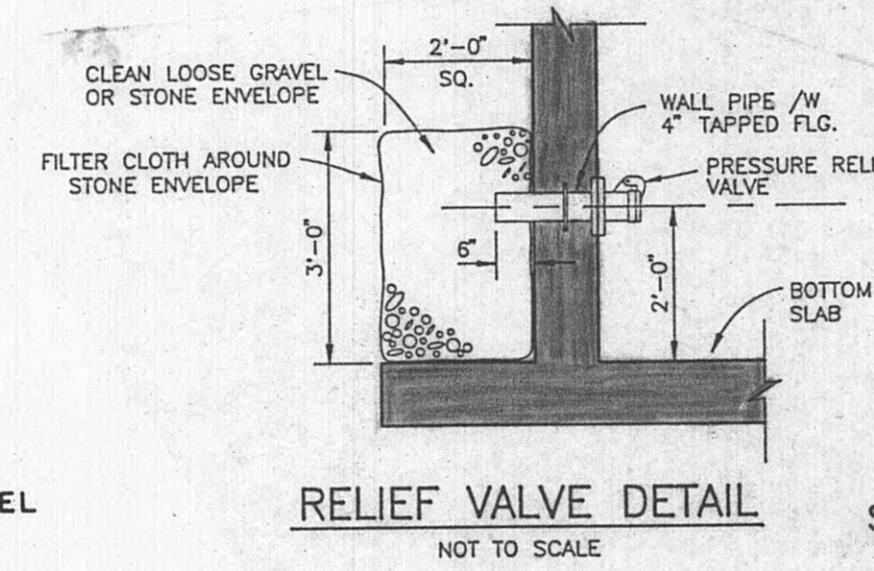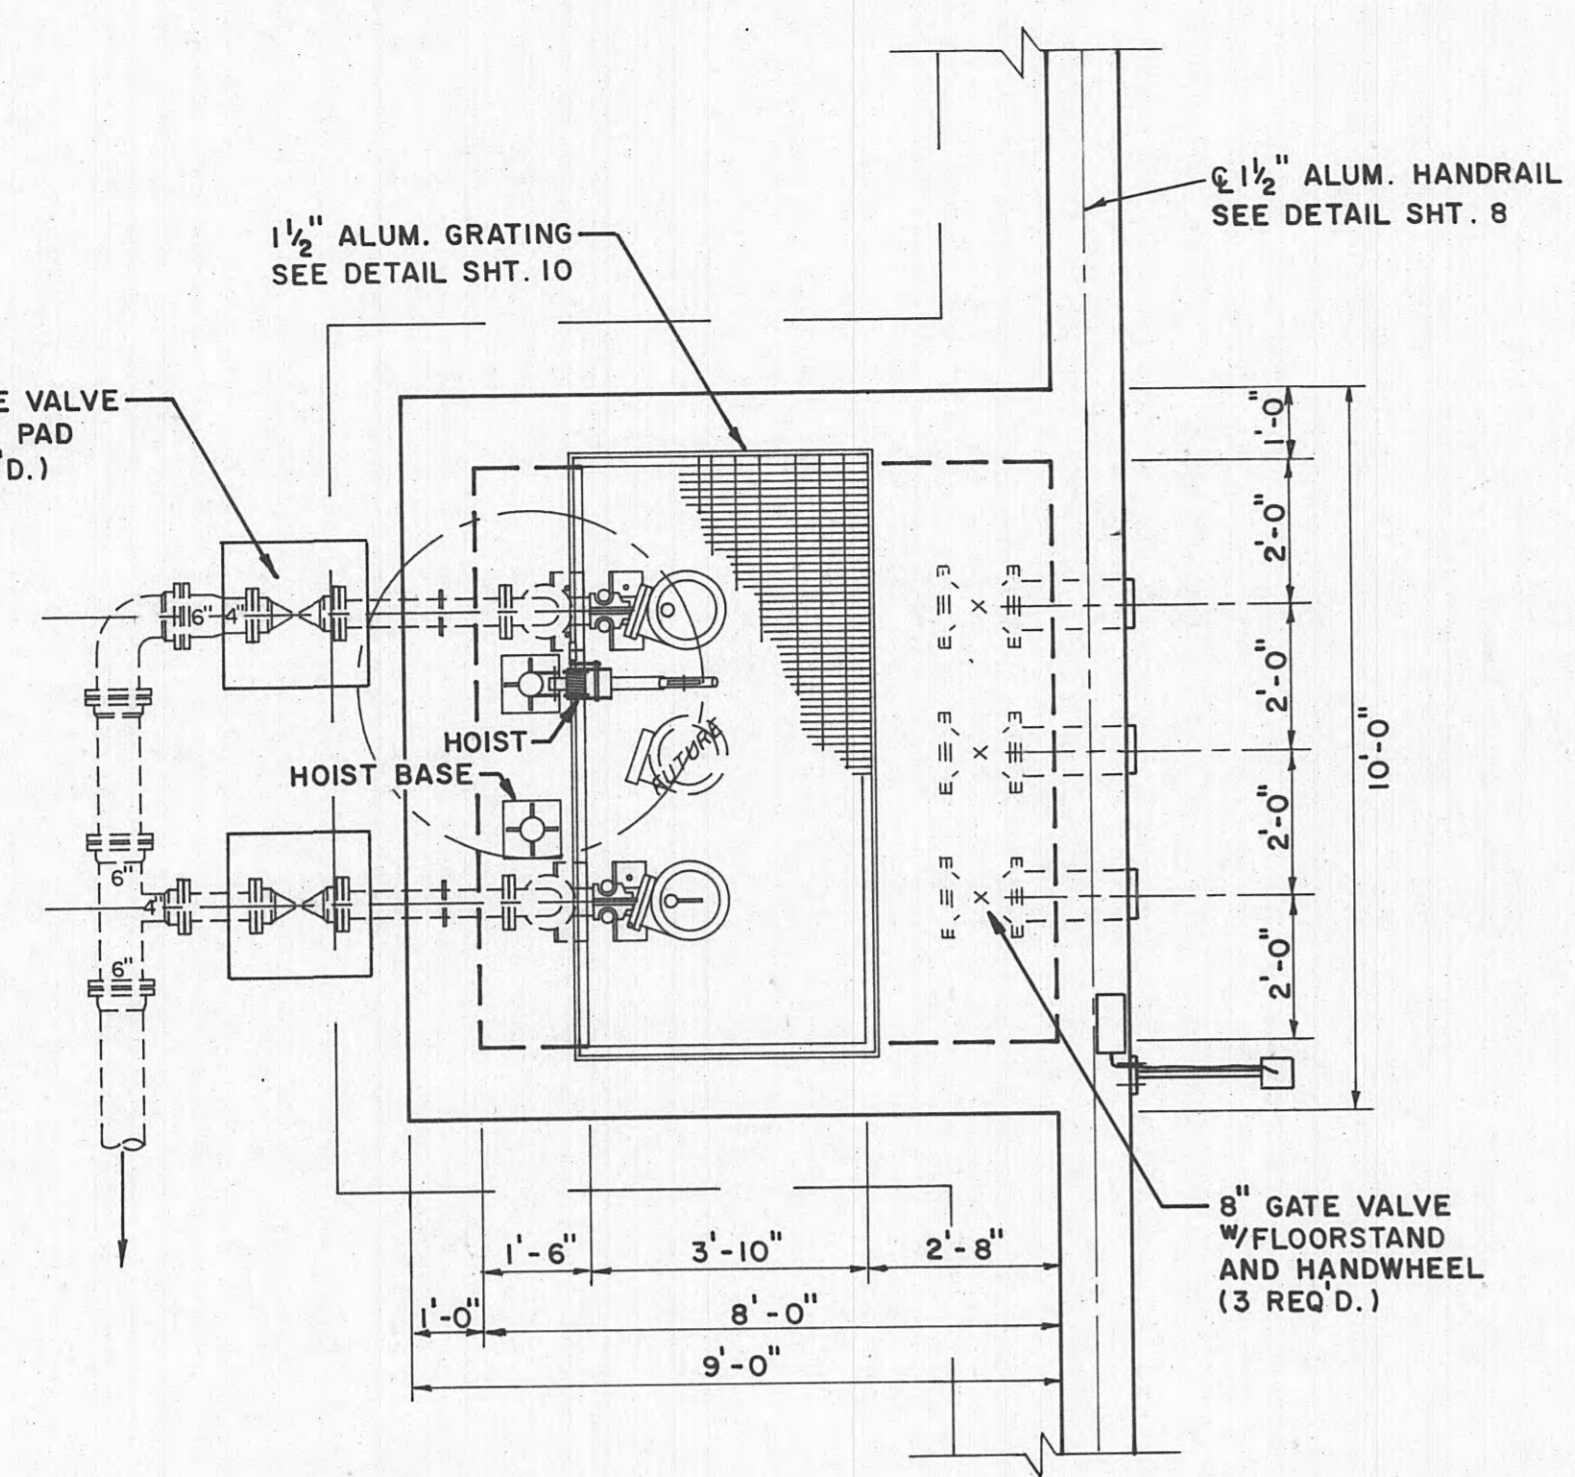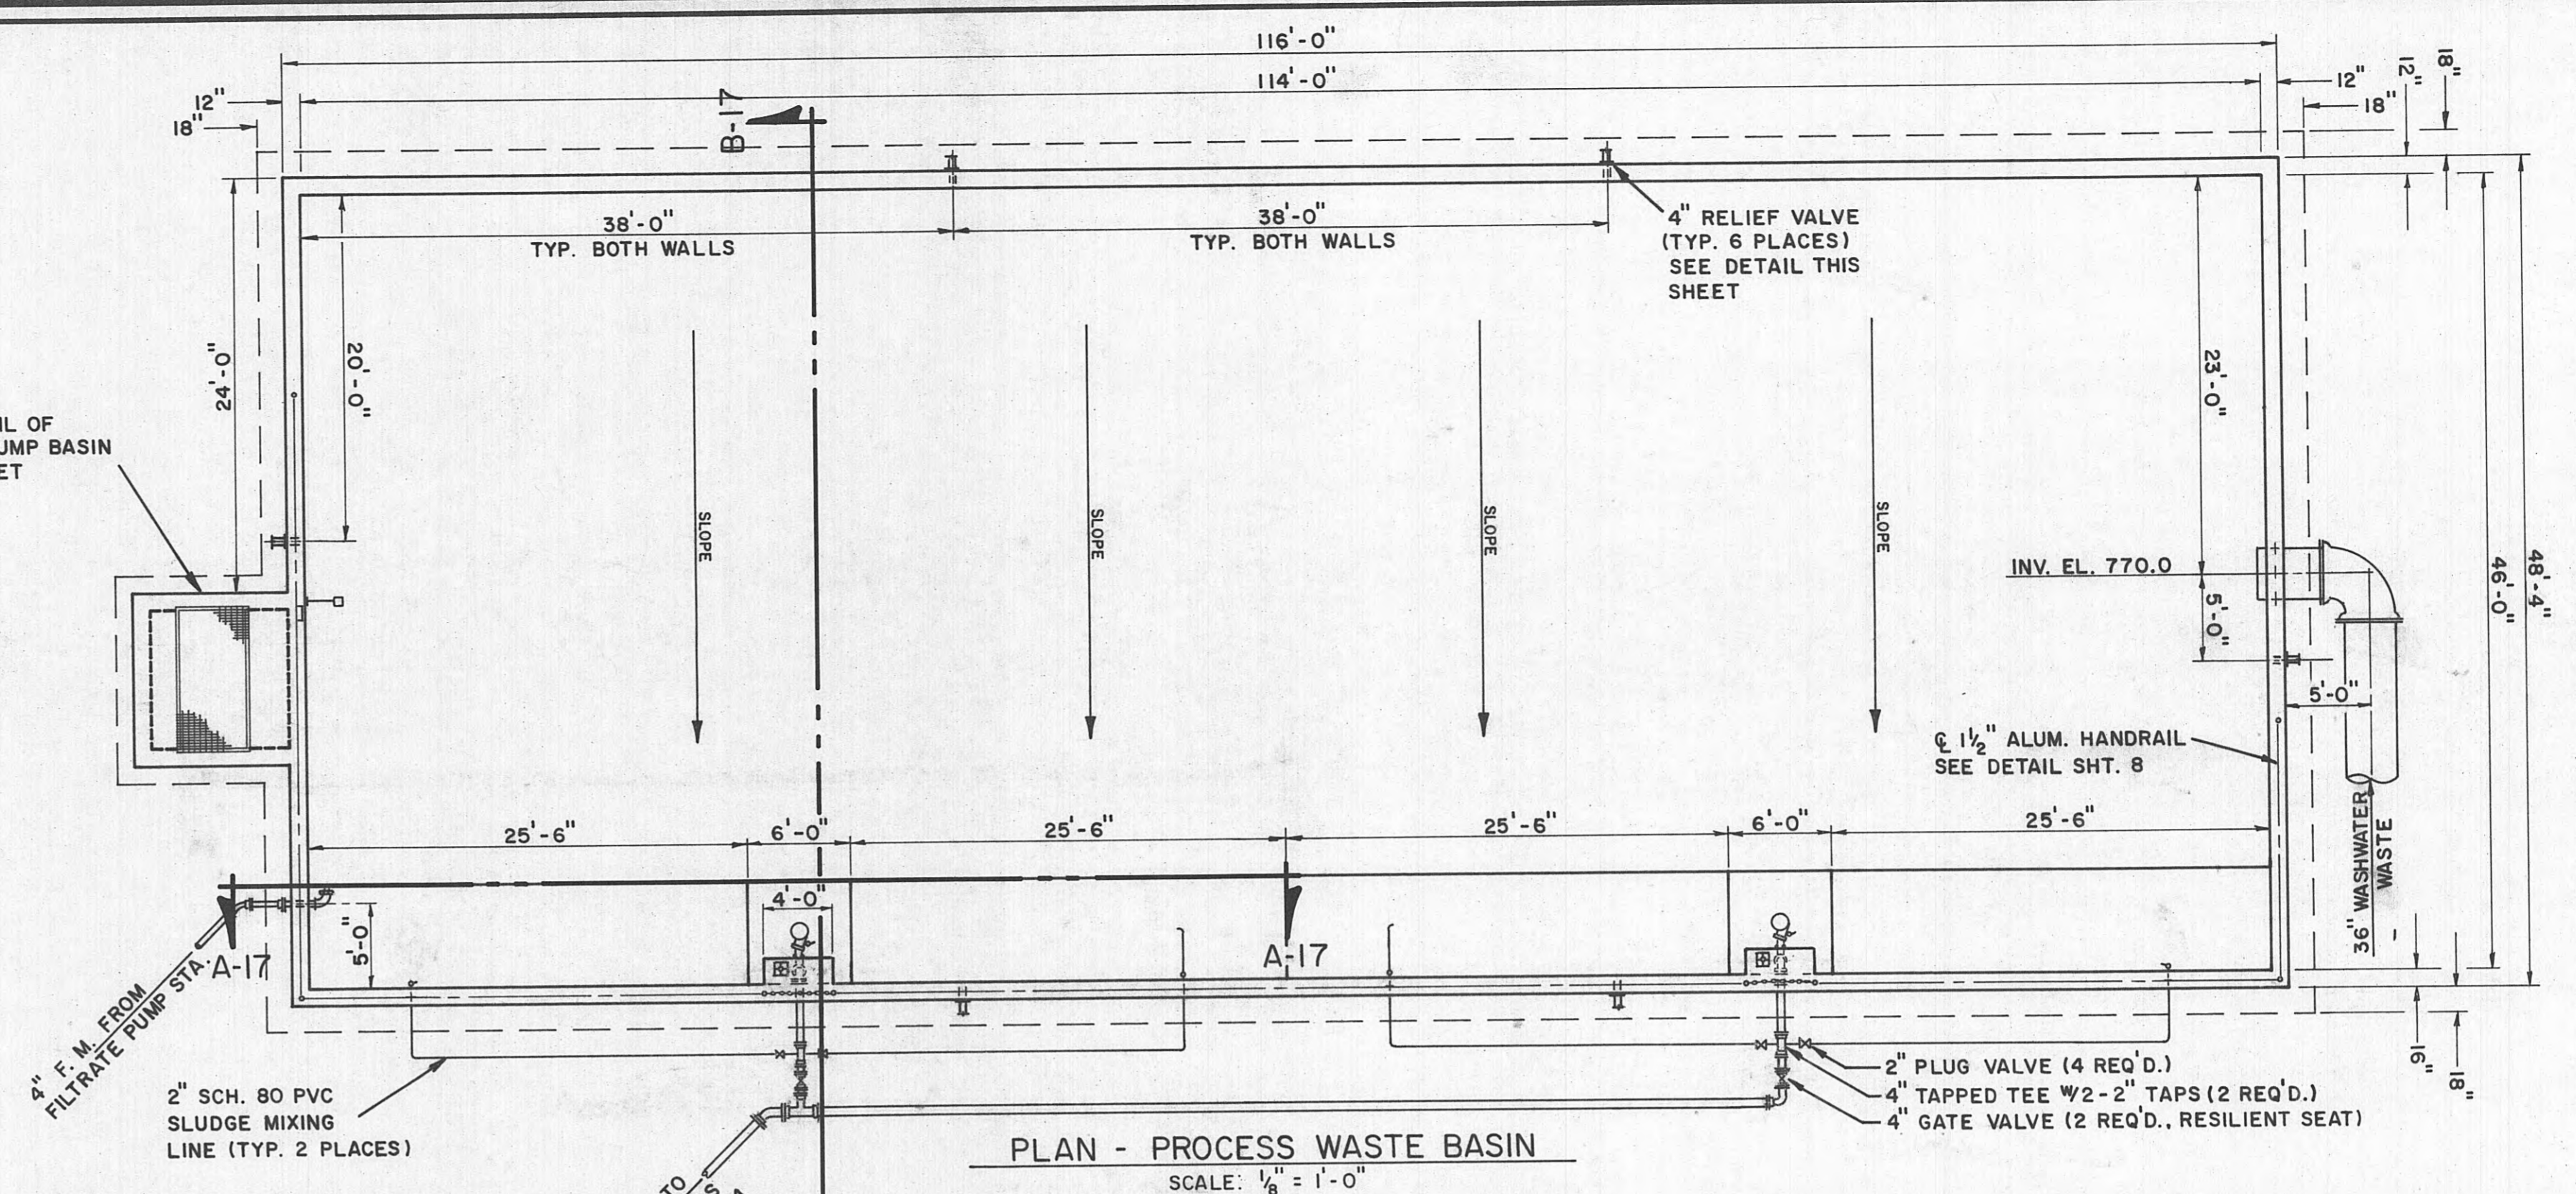

AS BUILT

DATE: 3-20-95
 APPROVED: *[Signature]*

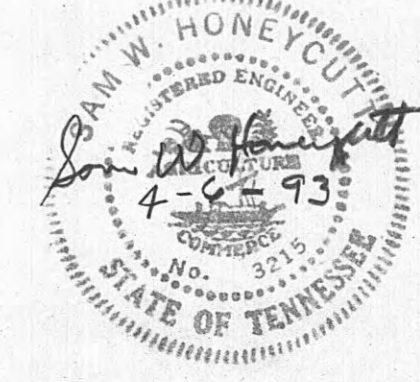




REVISIONS


DESIGNED: L. E. R.
DRAWN: S. C. G.
CHECKED: L. E. R.
DATE: MARCH, 1993
SCALE: AS NOTED
PROJ. NO. 0592

SHEET 18


OF 36

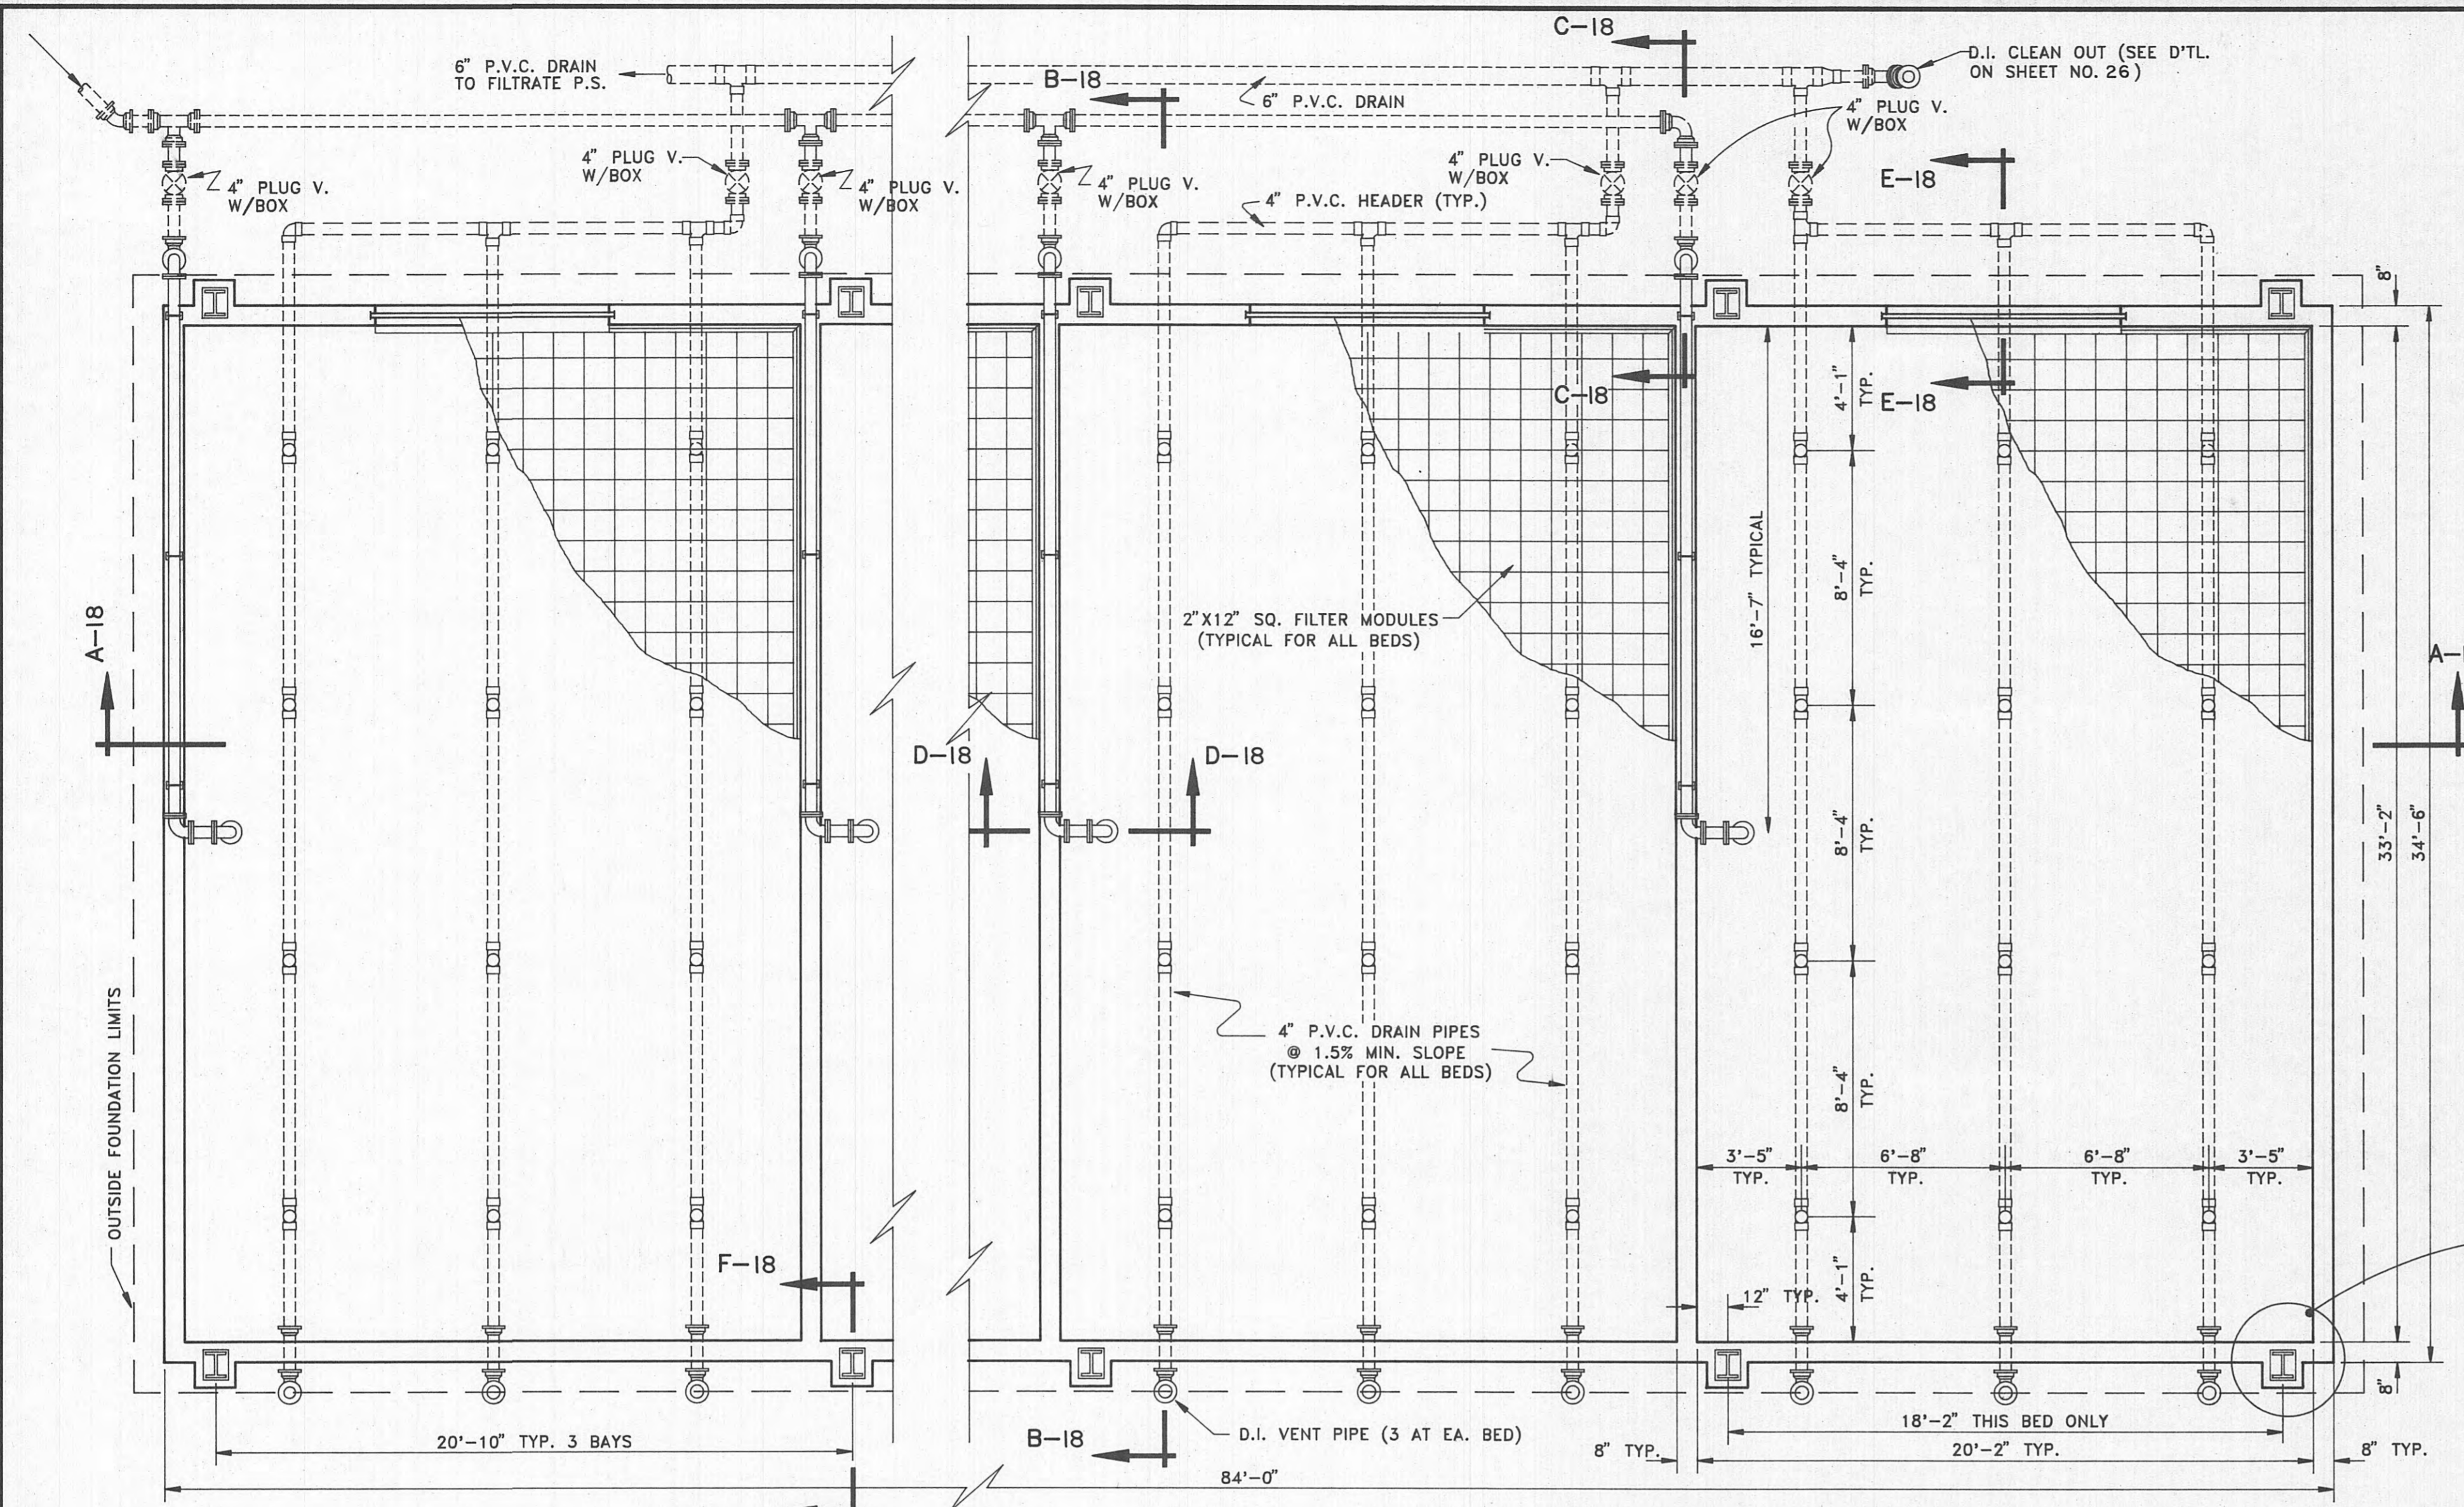



PLAN VIEW - DRYING BEDS
SCALE: 1/4"=1'-0"

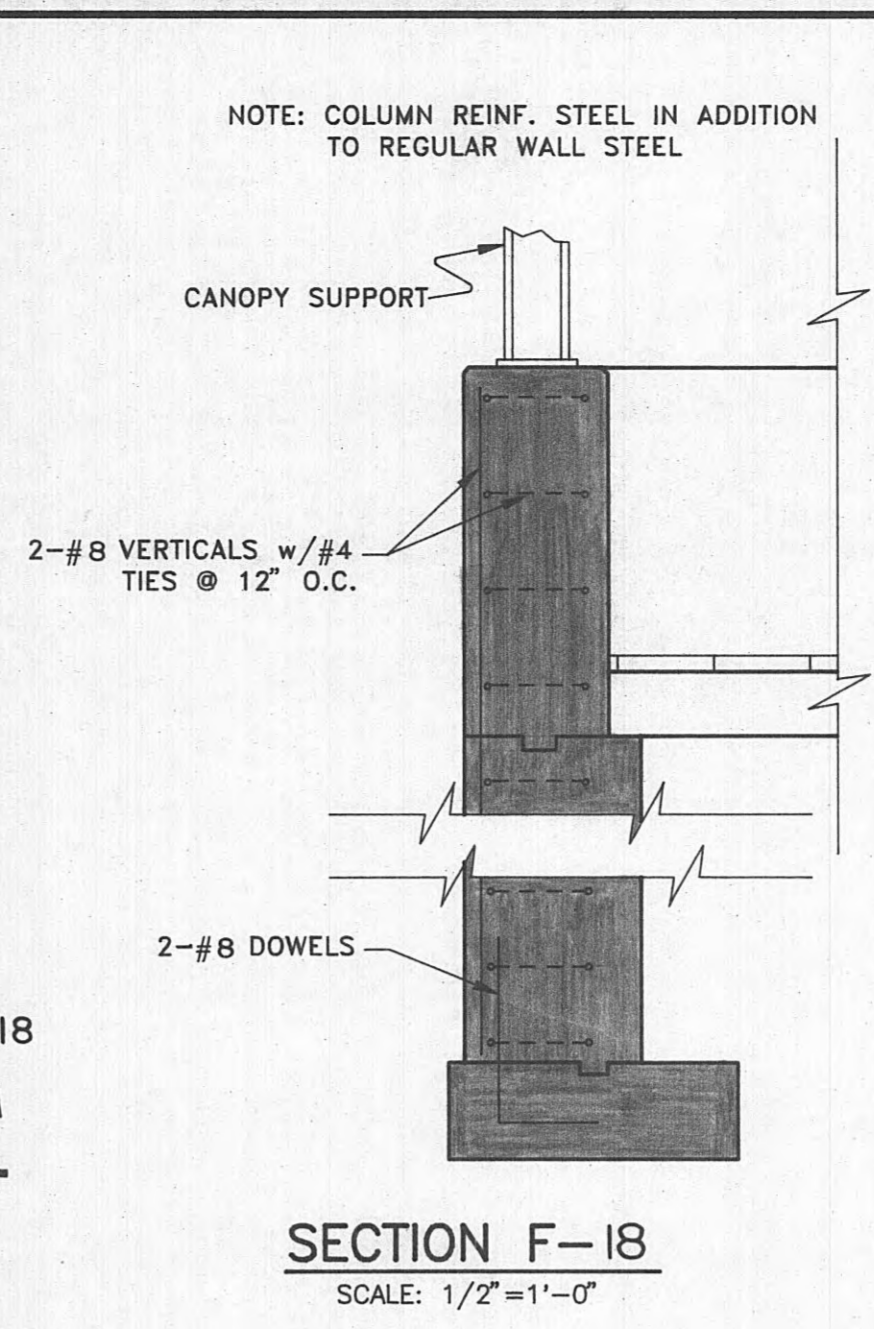

SECTION F-18
SCALE: 1/2"=1'-0"

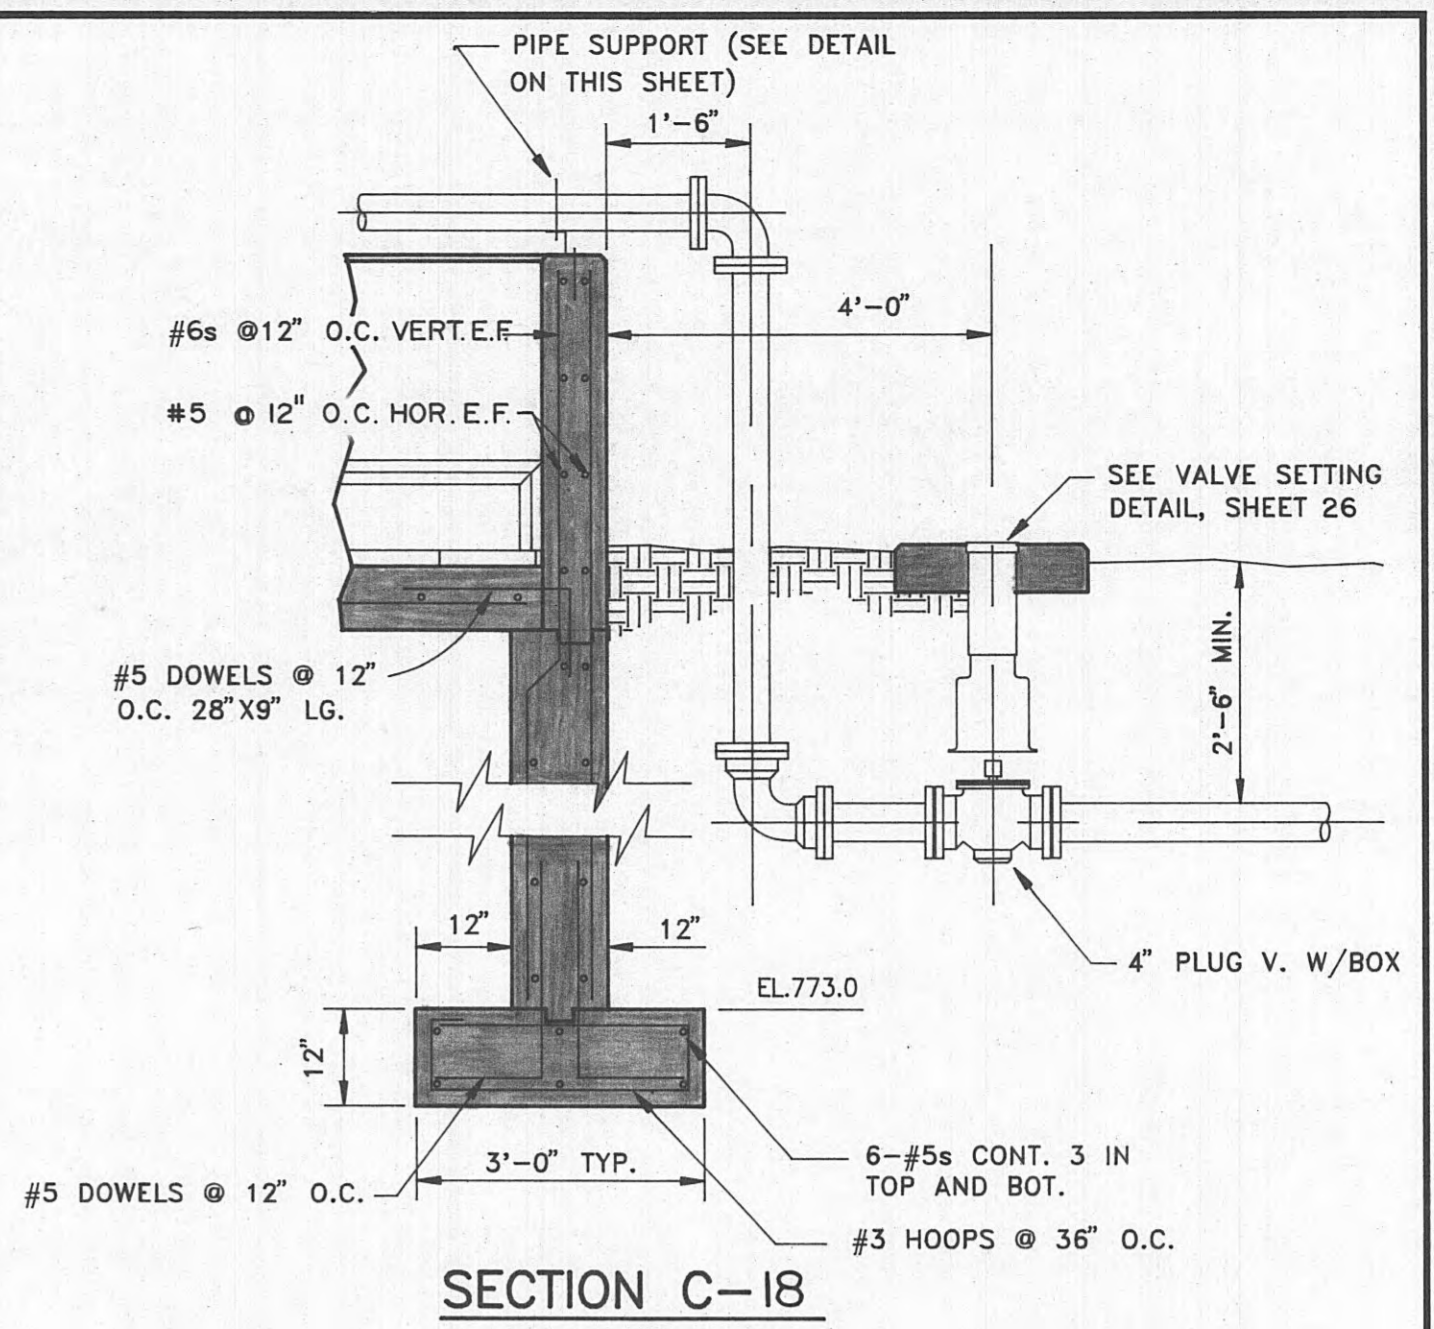


SECTION C-18
SCALE: 1/2"=1'-0"

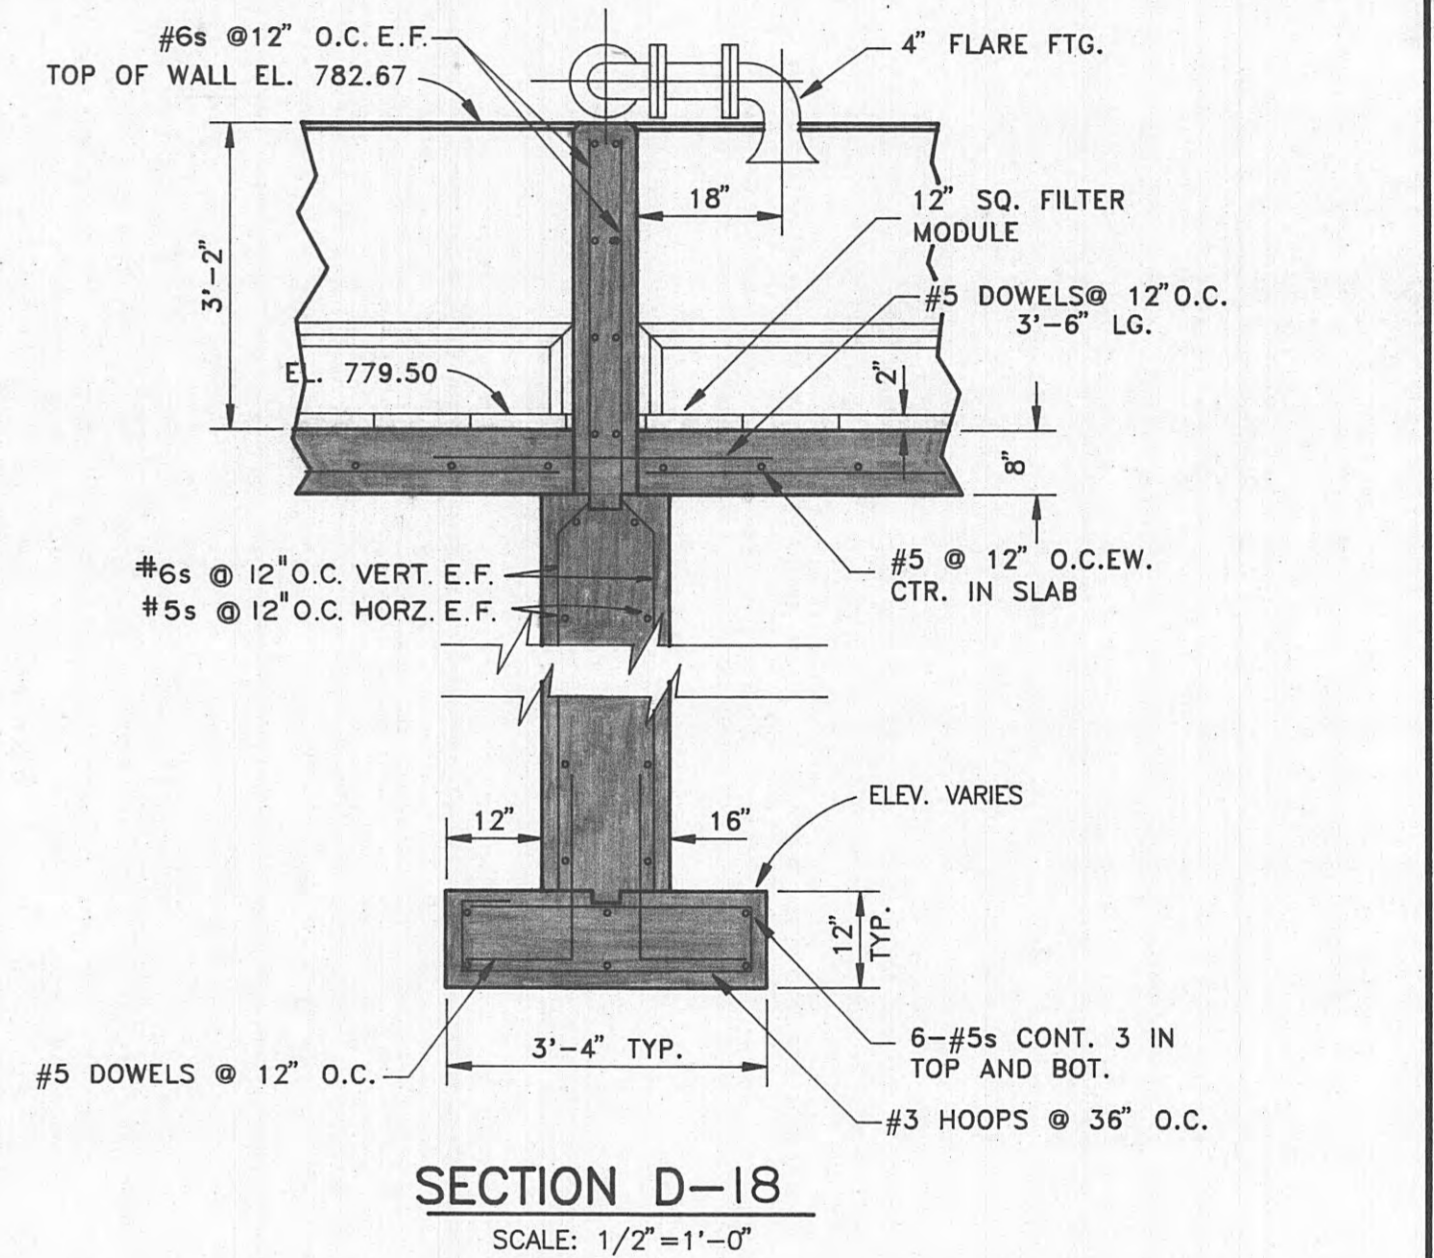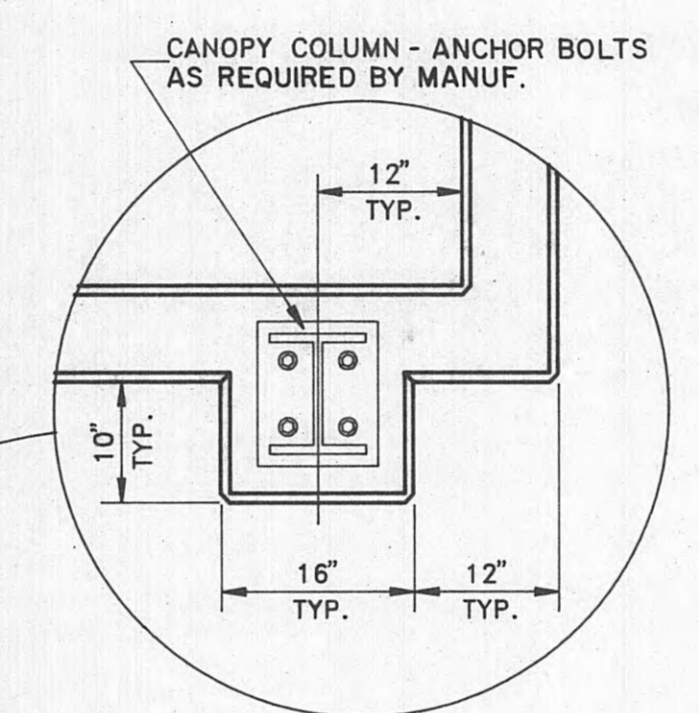


SECTION D-18
SCALE: 1/2"=1'-0"



NOTES:
CONCRETE FLOOR OF DRYING BEDS SHALL BE STEEL TROWEL FINISHED (1/4" IN 10" MAXIMUM SURFACE VARIATION).
CHAMFER ALL EXPOSED EDGES 3/4"x45"

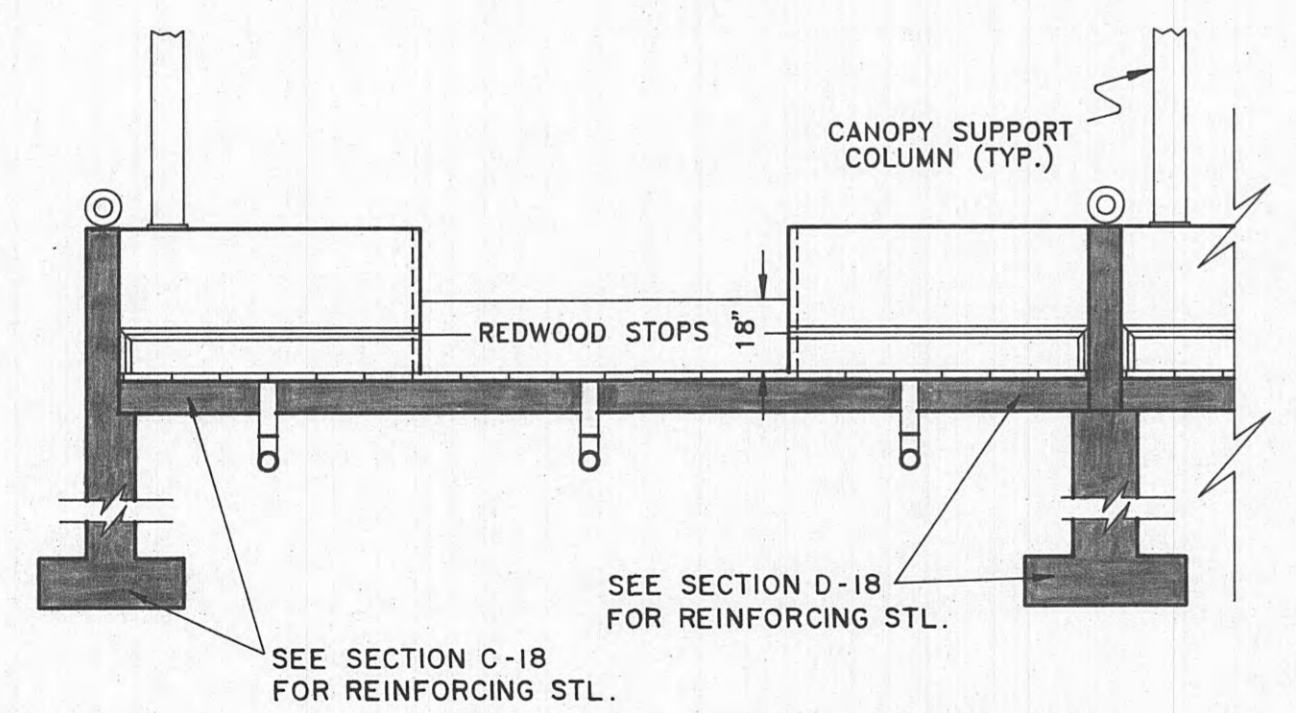


SECTION A-18
SCALE: 1/4"=1'-0"

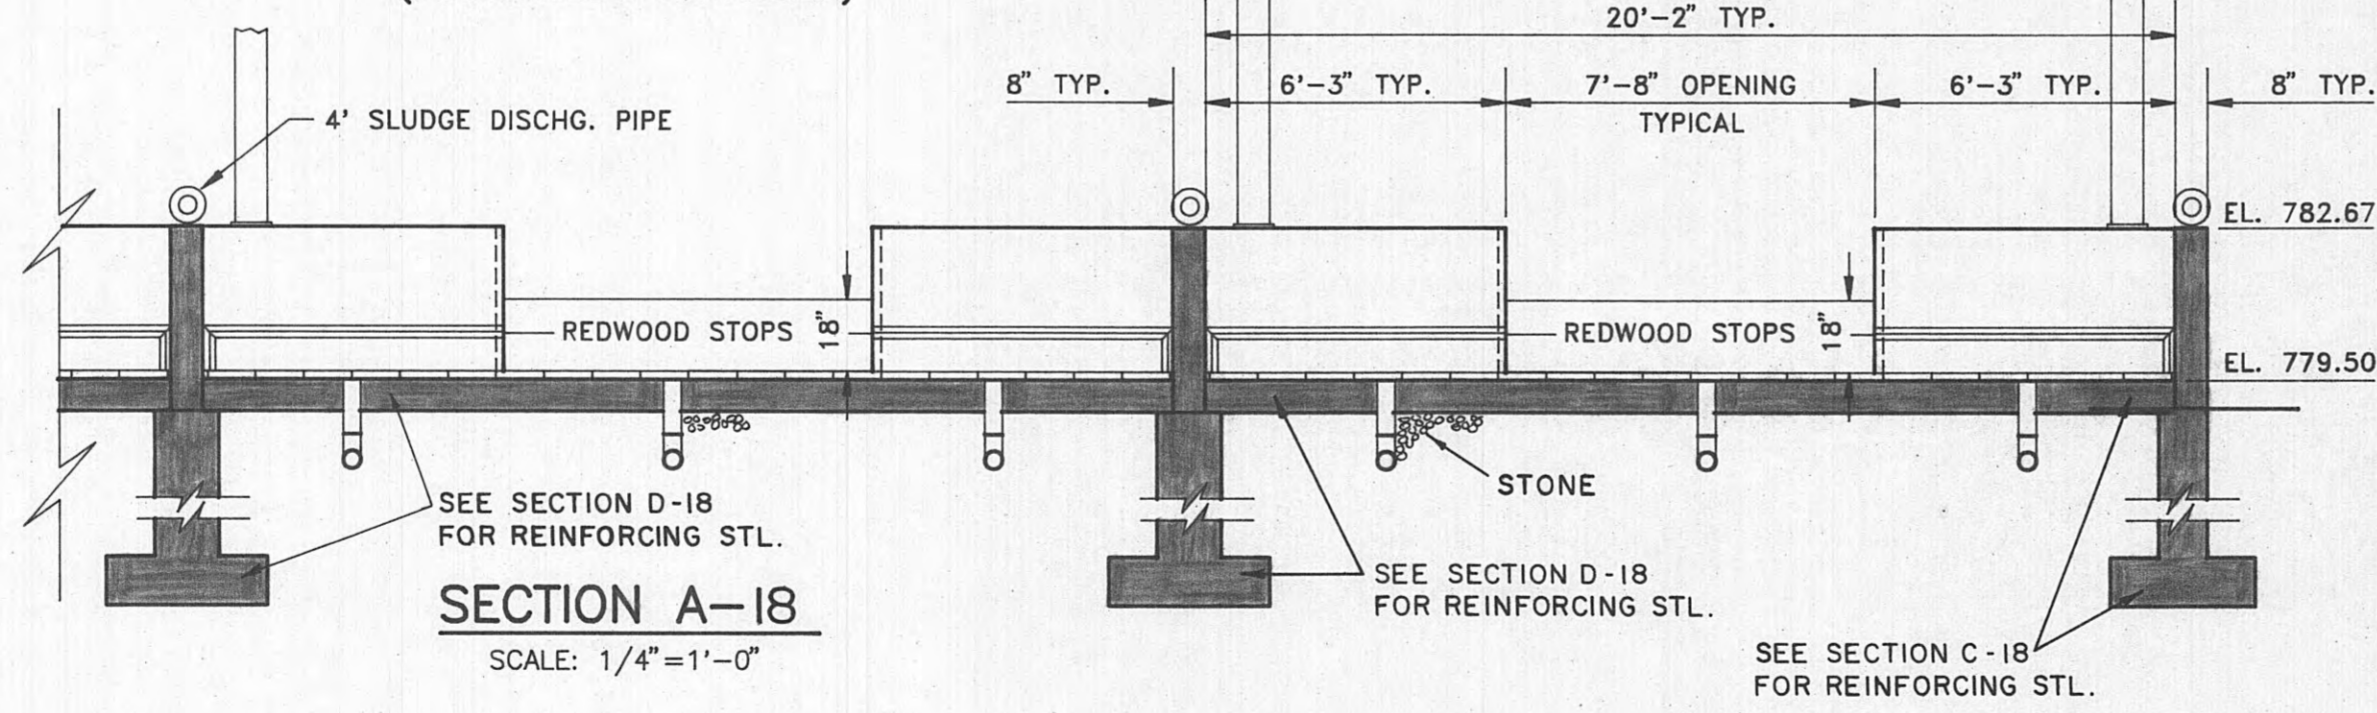


SECTION B-18
SCALE: 1/4"=1'-0"

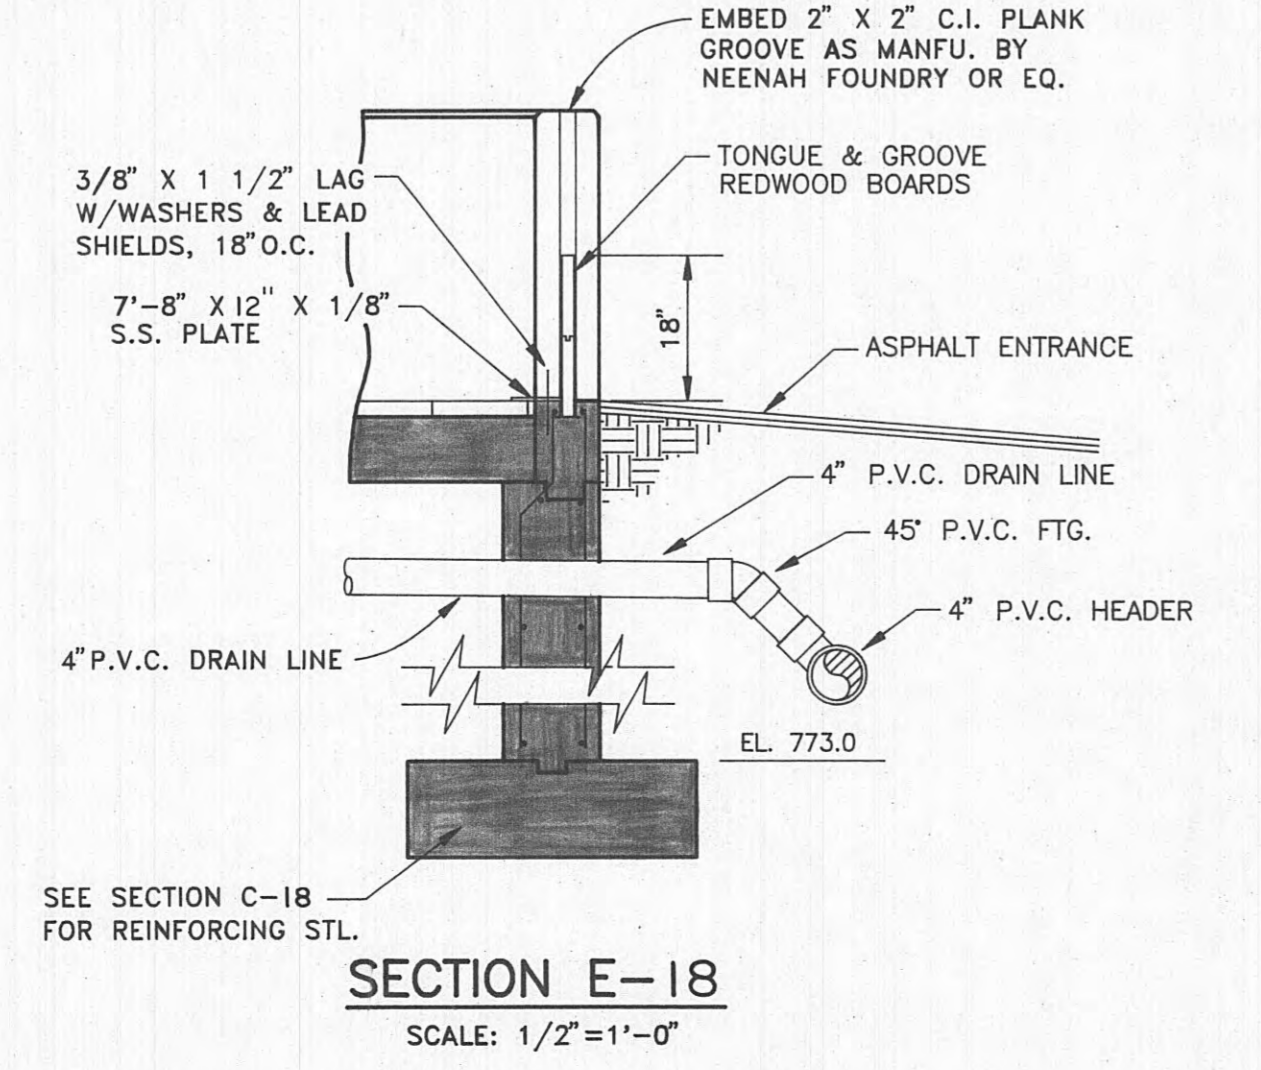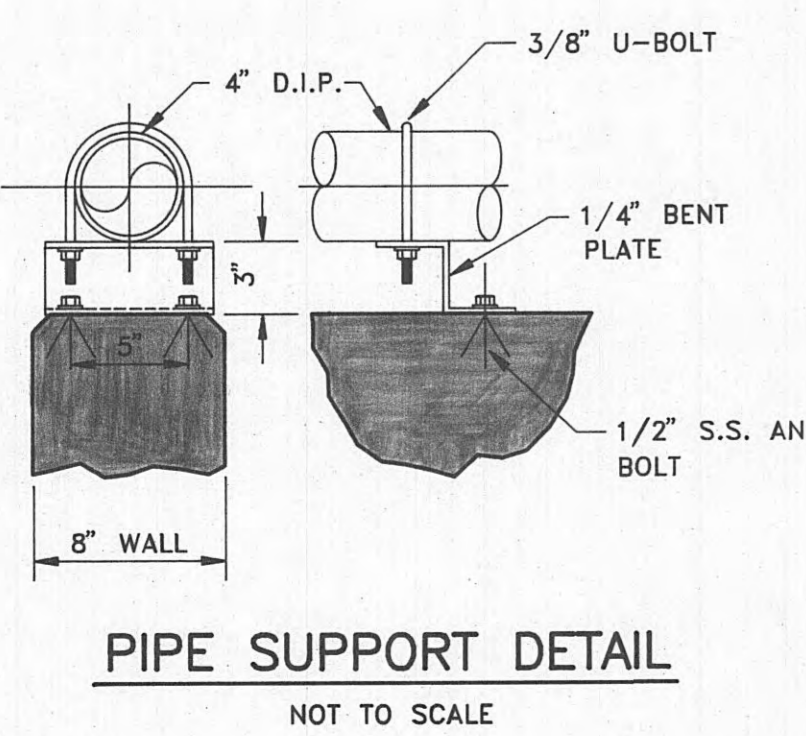

SECTION E-18
SCALE: 1/2"=1'-0"

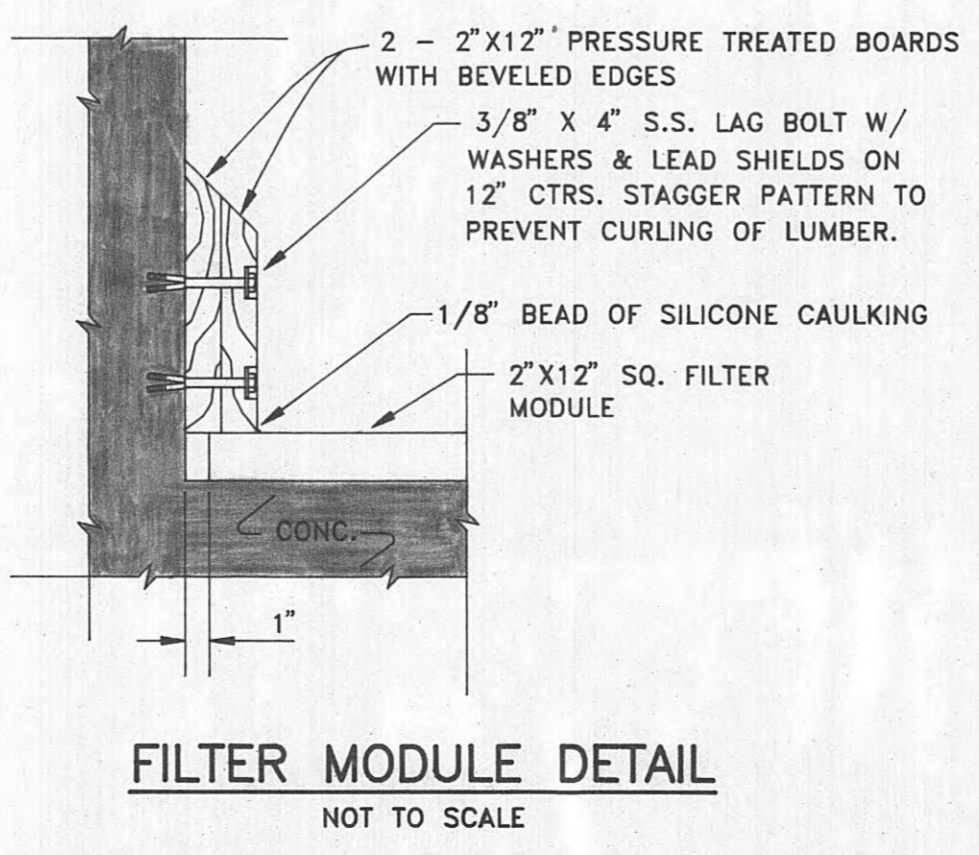


FILTER MODULE DETAIL
NOT TO SCALE

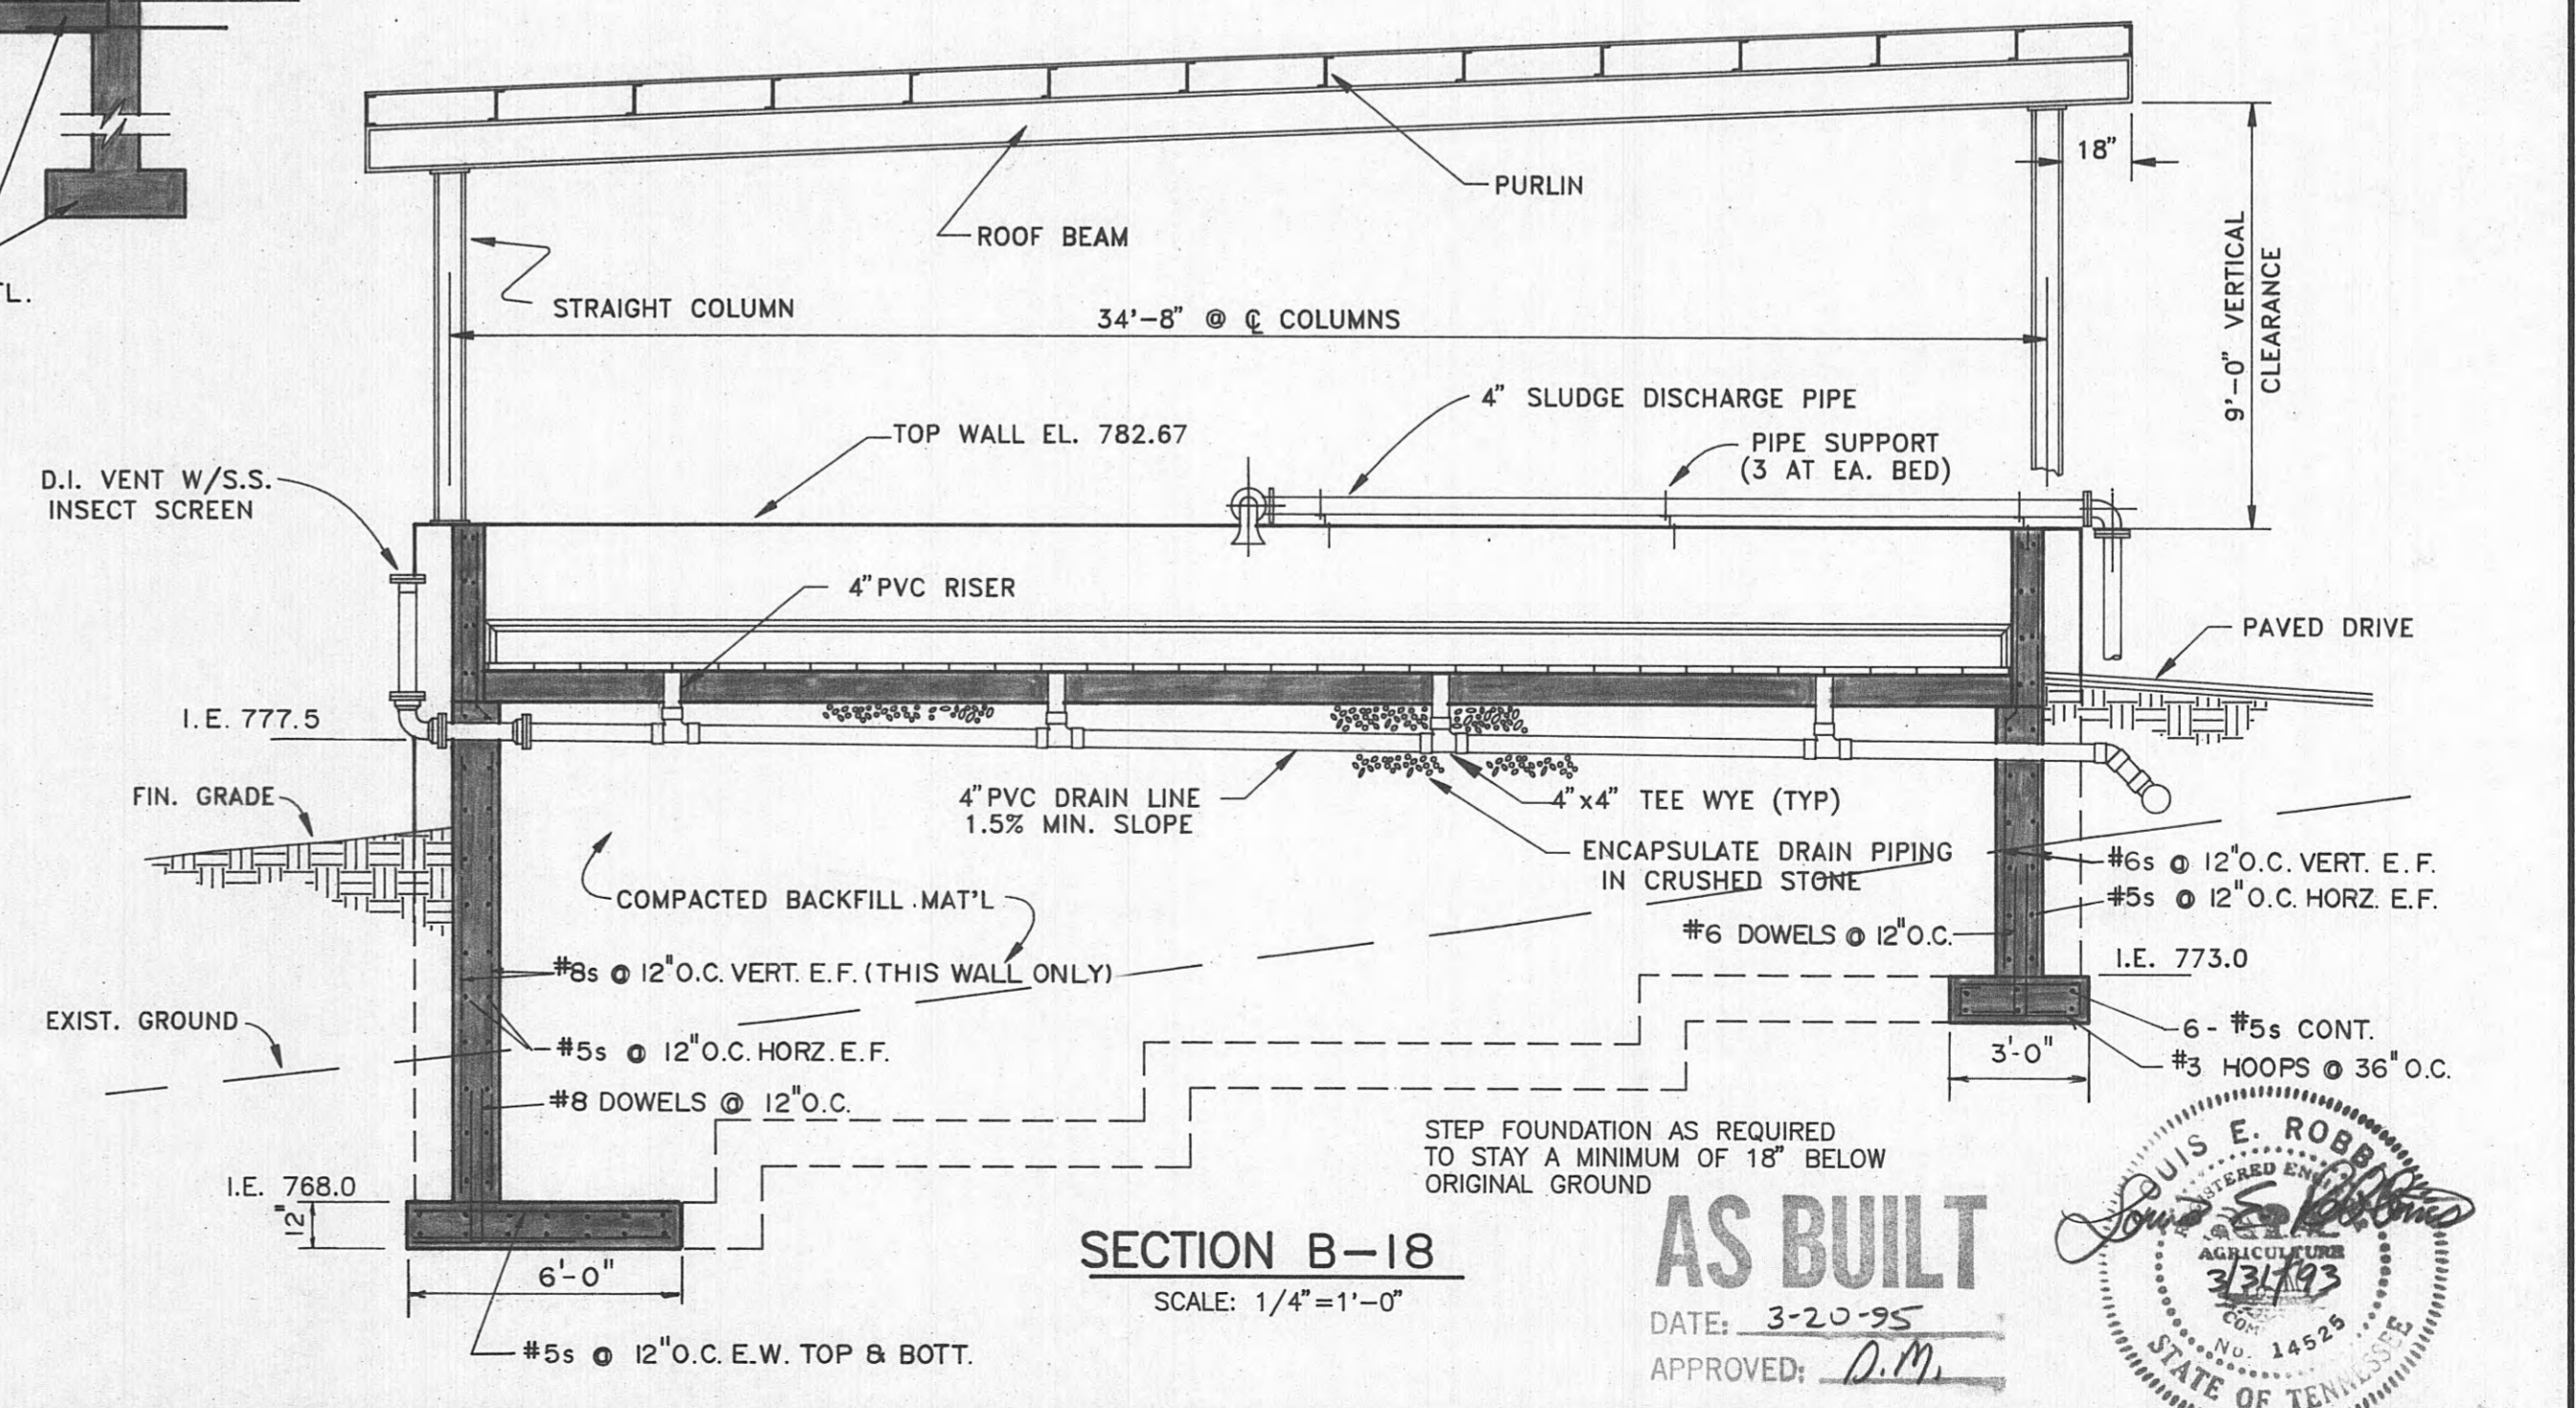


AS BUILT
DATE: 3-20-95
APPROVED: [Signature]



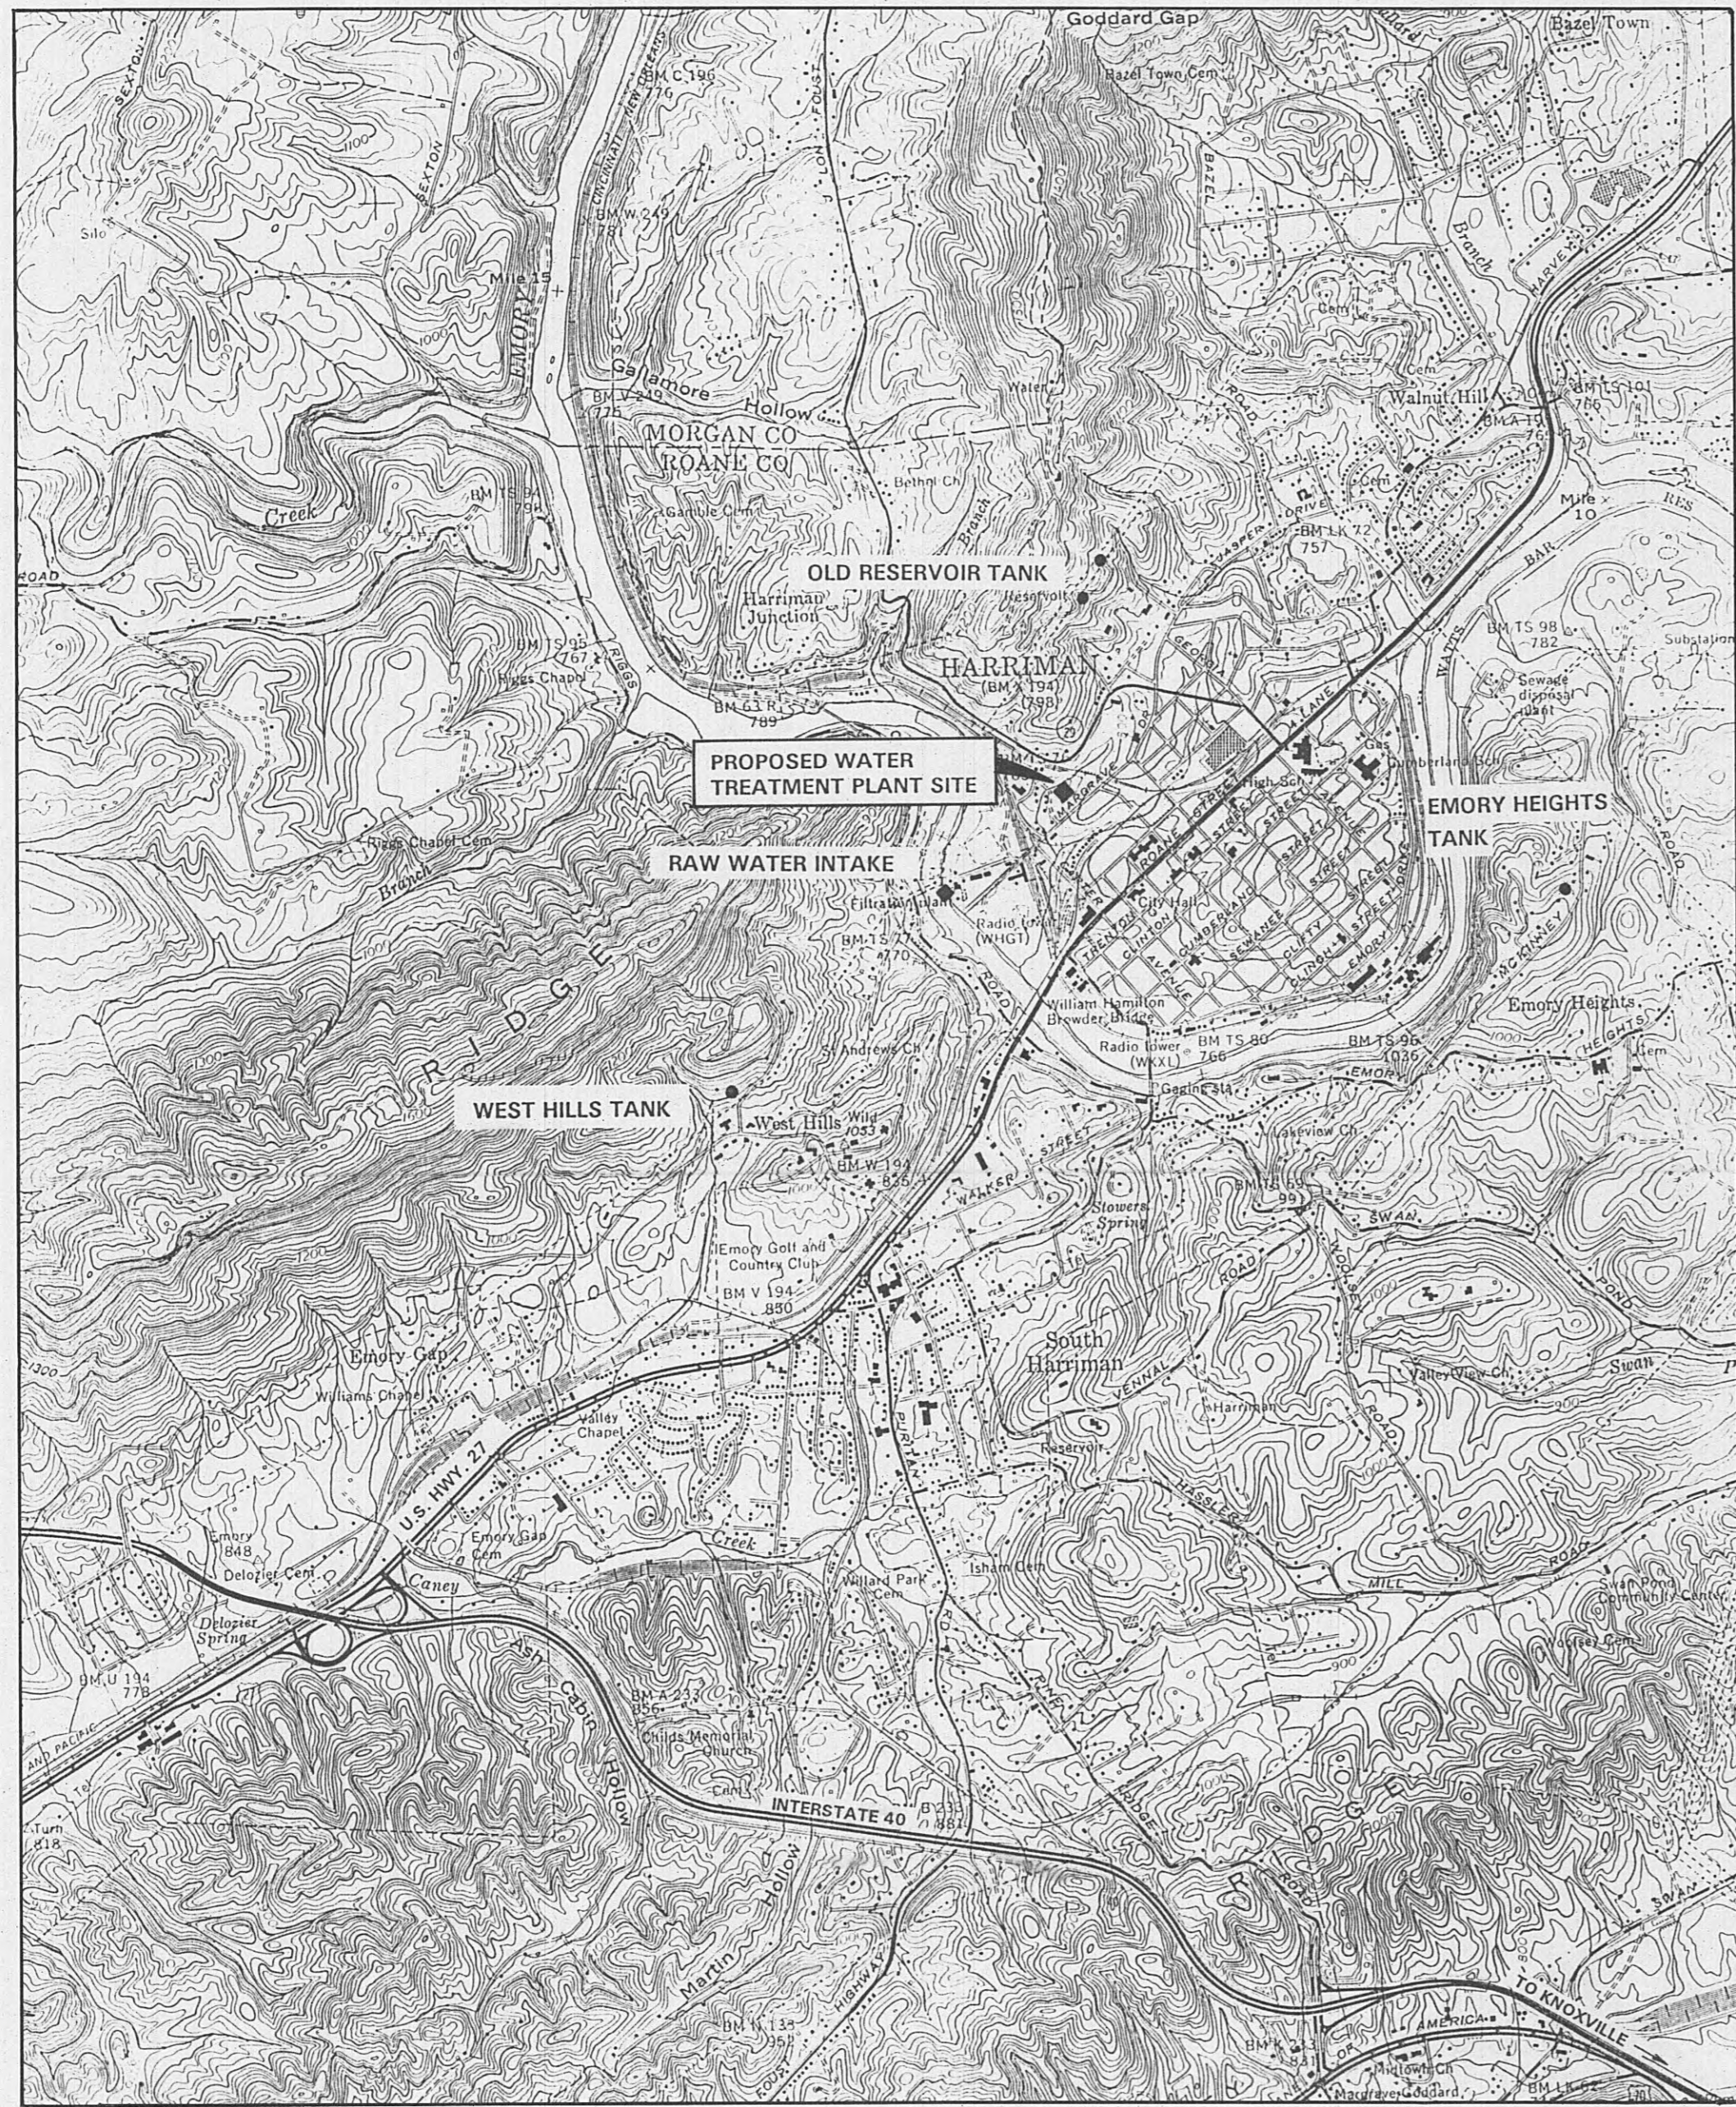


LOCATION PLAN
SCALE 1" = 2000'

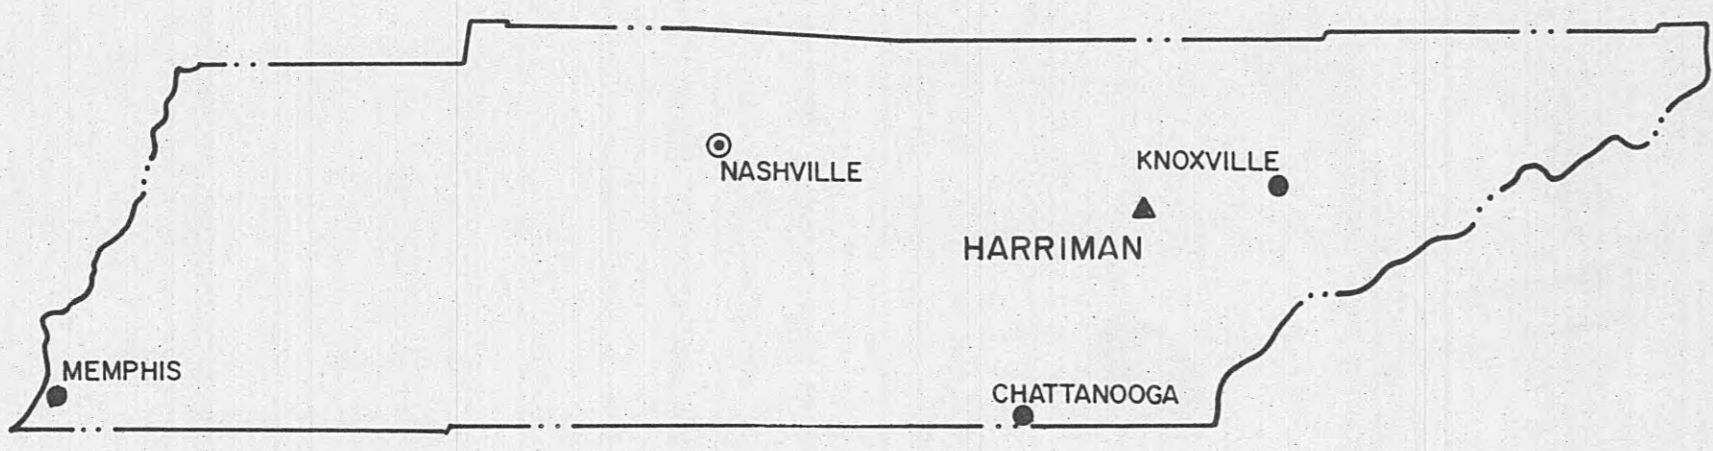

VICINITY MAP

INDEX OF SHEETS


SHT.NO.	DESCRIPTION
	COVER SHEET
1.	VICINITY, LOCATION PLAN, INDEX OF SHEETS
2.	SITE GRADING PLAN
3.	YARD PIPING PLAN
4.	FILTER/OPERATIONS BUILDING - PLAN VIEW
5.	OPERATIONS BUILDING - FLOOR PLAN AND INTERIOR DETAILS
6.	FILTER BUILDING SECTIONS, LABORATORY CONTROL PANEL
7.	FILTER BUILDING SECTIONS
8.	FILTER BUILDING SECTIONS AND DETAILS
9.	TOP PLAN-FILTER BUILDING, ROOF PLAN-FILTER/OPERATIONS BUILDING, TYPICAL WALL SECTIONS AND MAIN ENTRANCE SECTION
10.	FILTER/OPERATIONS BUILDING EXTERIOR ELEVATIONS AND MISCELLANEOUS DETAILS
11.	DOOR & WINDOW SCHEDULES AND DETAILS
12.	STRUCTURAL - FLOOR SLAB ELEVATION 767.0 - FILTER/OPERATIONS BUILDING
13.	STRUCTURAL - FLOOR SLAB ELEVATION 782.0 - FILTER/OPERATIONS BUILDING
14.	FLOW DIAGRAM - FILTER PLANT
15.	CHLORINATION AND CHEMICAL FEED SCHEMATICS
16.	SURFACE WASH/CHEMICAL FEED WATER, LABORATORY WATER AND PLUMBING SCHEMATICS
17.	PROCESS WASTE BASIN - PLAN, SECTIONS, AND DETAILS
18.	SLUDGE DRYING BEDS - PLAN, SECTIONS, AND DETAILS
19.	FILTRATE PUMP STATION, FINISHED WATER FLOW METER, AND RETAINING WALL PLAN AND SECTIONS
20.	STORAGE BUILDING/POLYMER ROOM, PLAN AND SECTIONS
21.	MODIFICATIONS TO RAW WATER INTAKE STRUCTURE
22.	RAW WATER PUMP BUILDING - PLAN & DETAILS
23.	RAW WATER PUMP BUILDING SECTIONS
24.	RAW WATER LINE, FINISHED WATER LINE - PLAN AND PROFILE
25.	RAW WATER LINE, FINISHED WATER LINE - PLAN AND PROFILE
26.	MISCELLANEOUS CONSTRUCTION DETAILS
27.	ELECTRICAL SITE PLAN
28.	FILTER BUILDING LIGHTING PLAN
29.	FILTER BUILDING POWER FLOOR PLAN
30.	FILTER BUILDING PROCESS POWER PLAN
31.	FILTER BUILDING ONE LINE DIAGRAM
32.	POLYMER BUILDING ELECTRICAL PLAN
33.	WATER INTAKE BUILDING ELECTRICAL PLAN
34.	WATER INTAKE-FILTER BUILDING CONNECTOR
35.	FILTER BUILDING MECHANICAL PLAN
36.	POLYMER/INTAKE BUILDING MECHANICAL-SCHEDULES

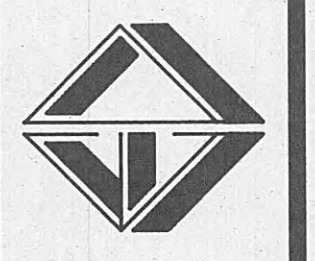


REVISIONS

DESIGNED: L. E. R.
DRAWN: D. G. R.
CHECKED: L. E. R.
DATE: MARCH, 1993
SCALE: AS NOTED
PROJ. NO. 0592


AS BUILT
DATE: 3-20-95
APPROVED: D.M.

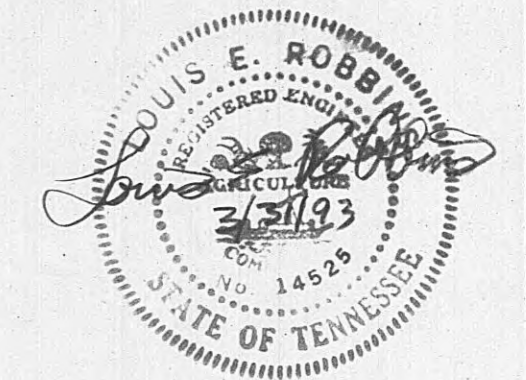


NOTE:
PICKET RAIL TO EXTEND 135' FROM NEW CHAIN LINK FENCE

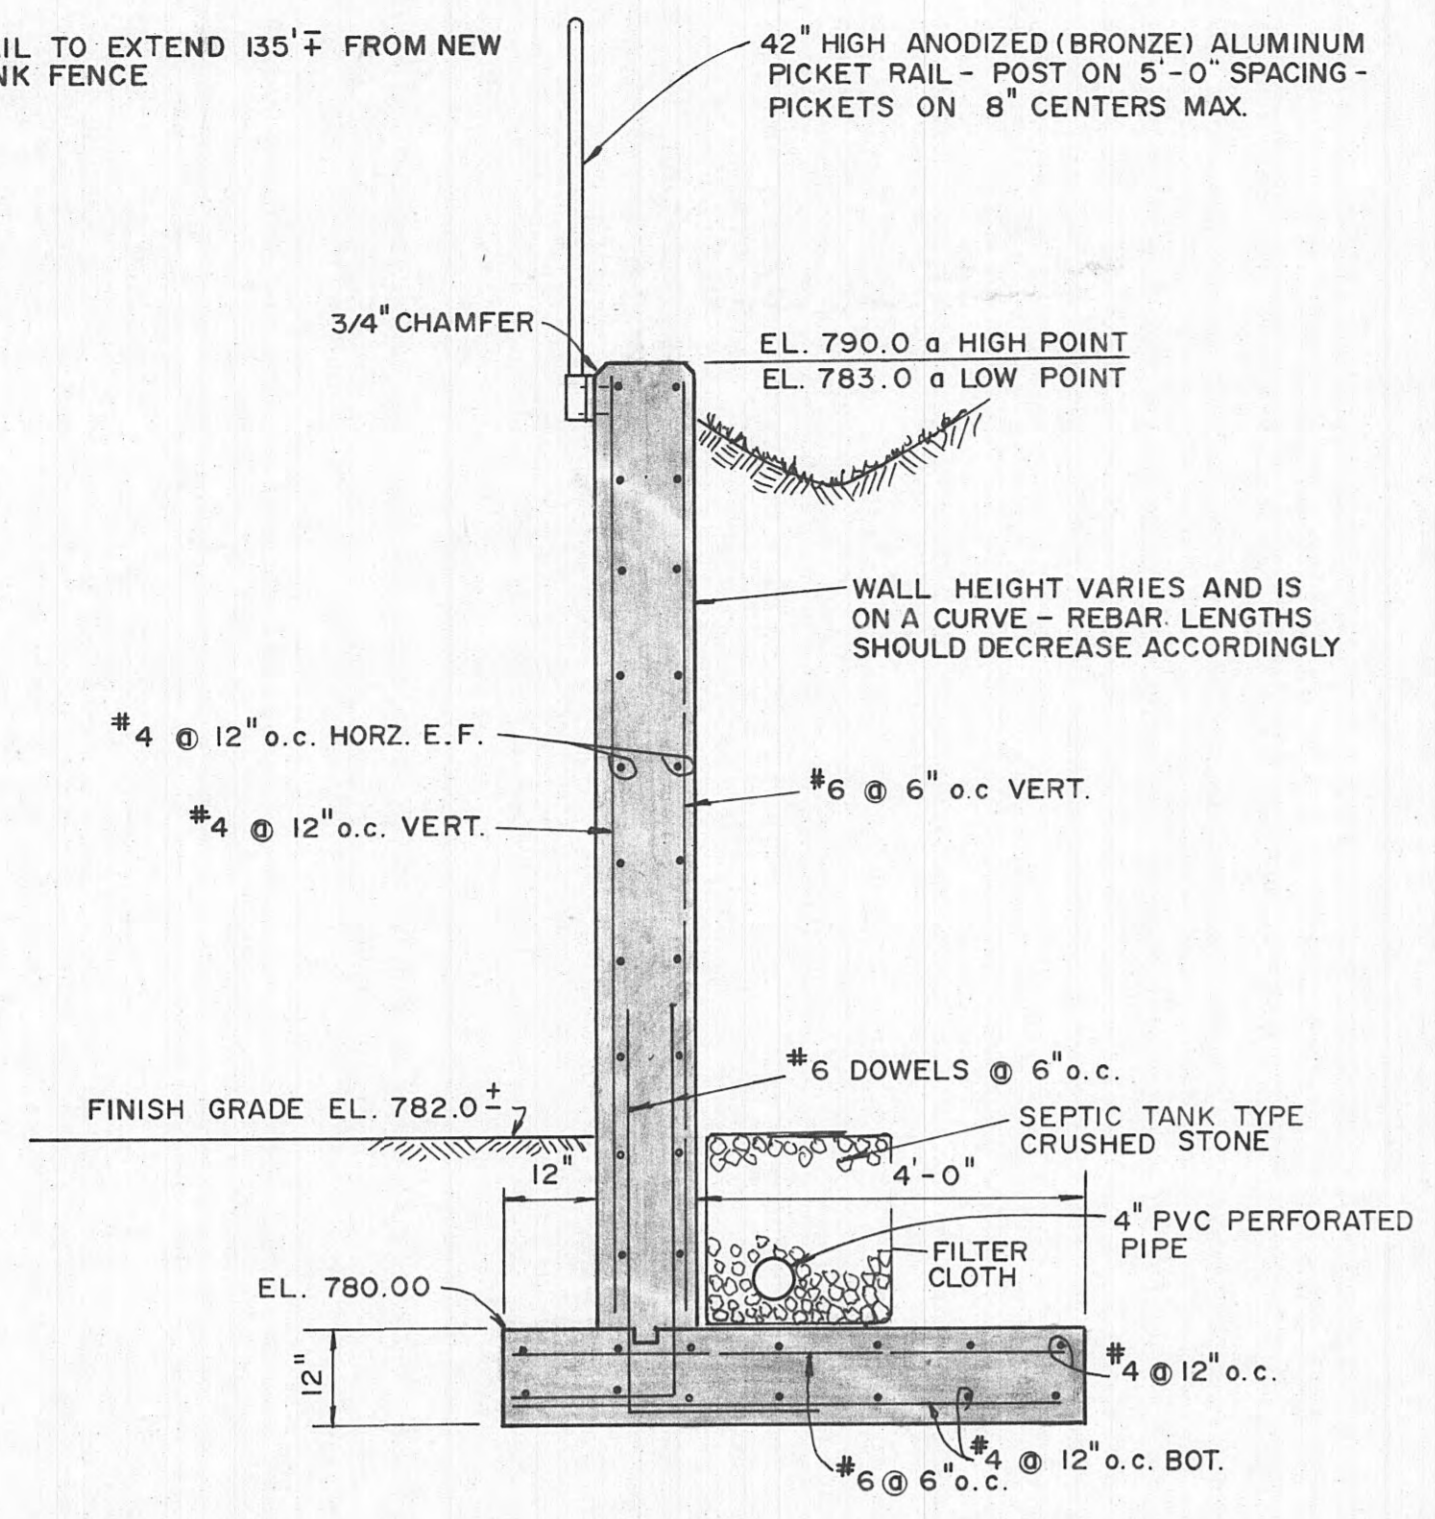


TYPICAL SECTION - RETAINING WALL
SCALE: 1/2" = 1'-0"
SEE GRADING PLAN FOR WALL LOCATION

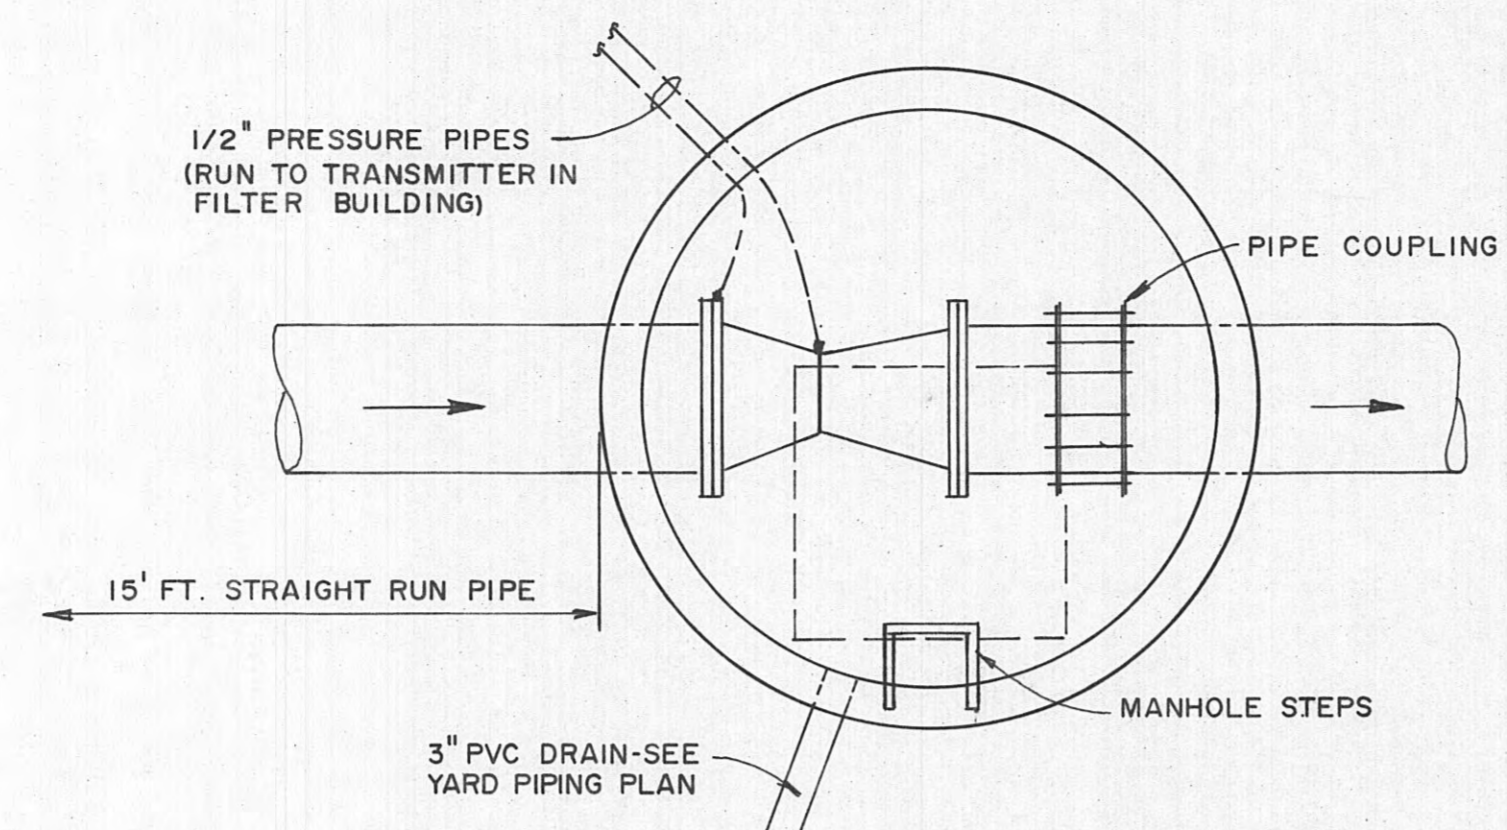


PLAN - FINISHED WATER FLOW METER
SCALE: 1/2" = 1'-0"

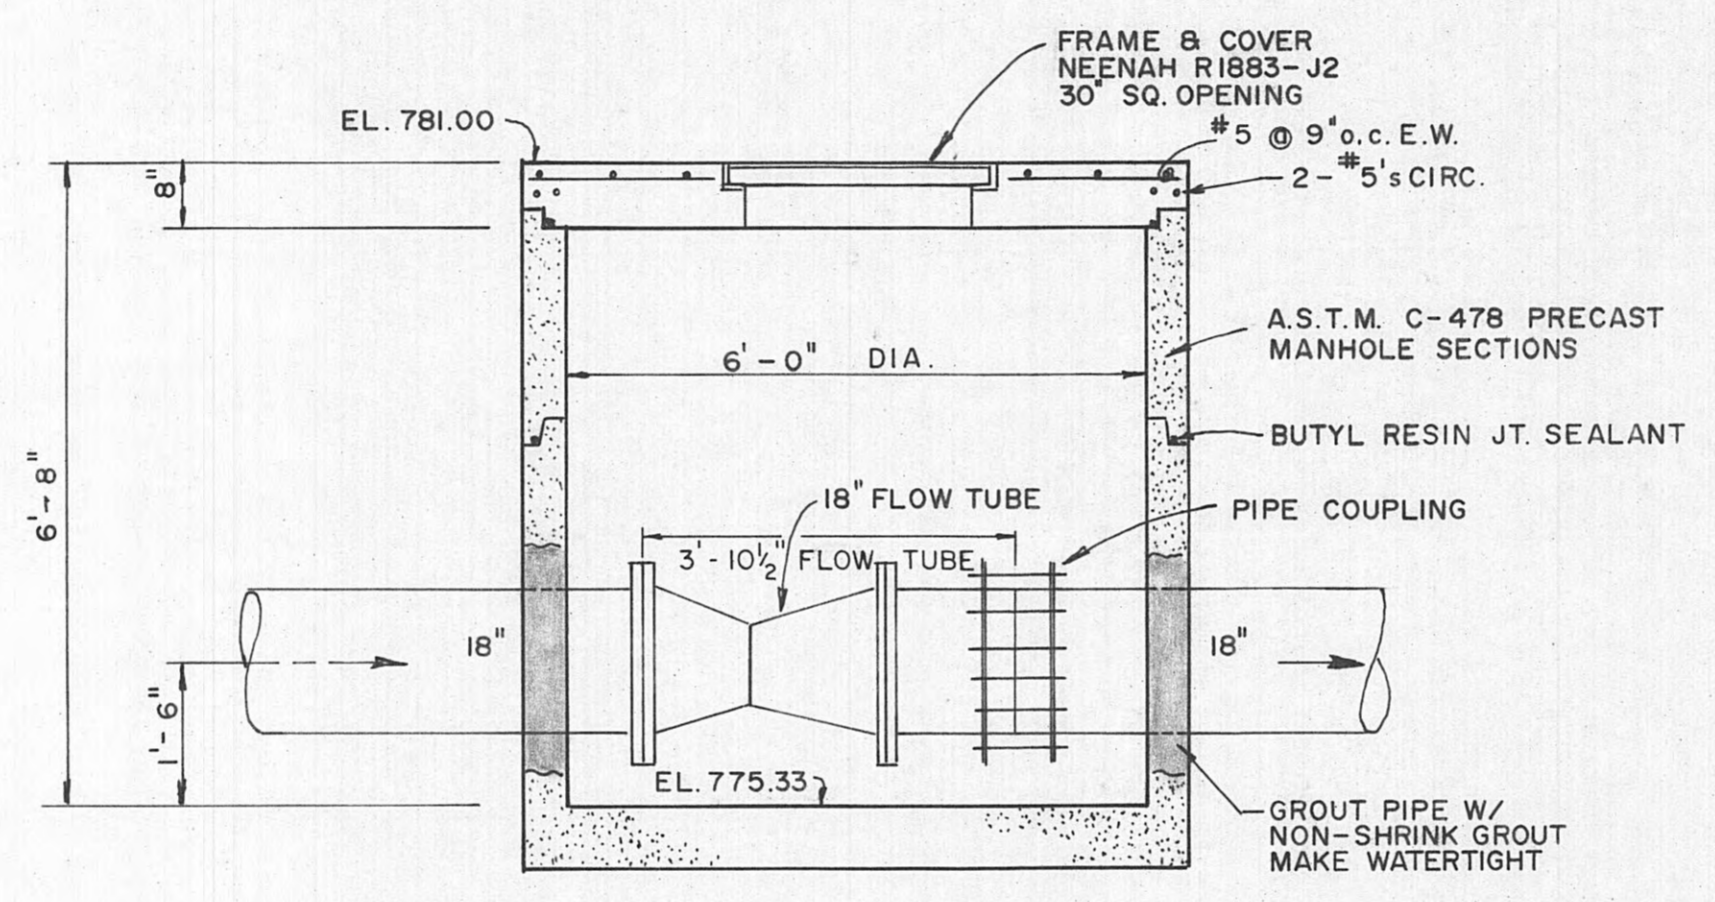


TYPICAL SECTION - FINISHED WATER METER
SCALE: 1/2" = 1'-0"

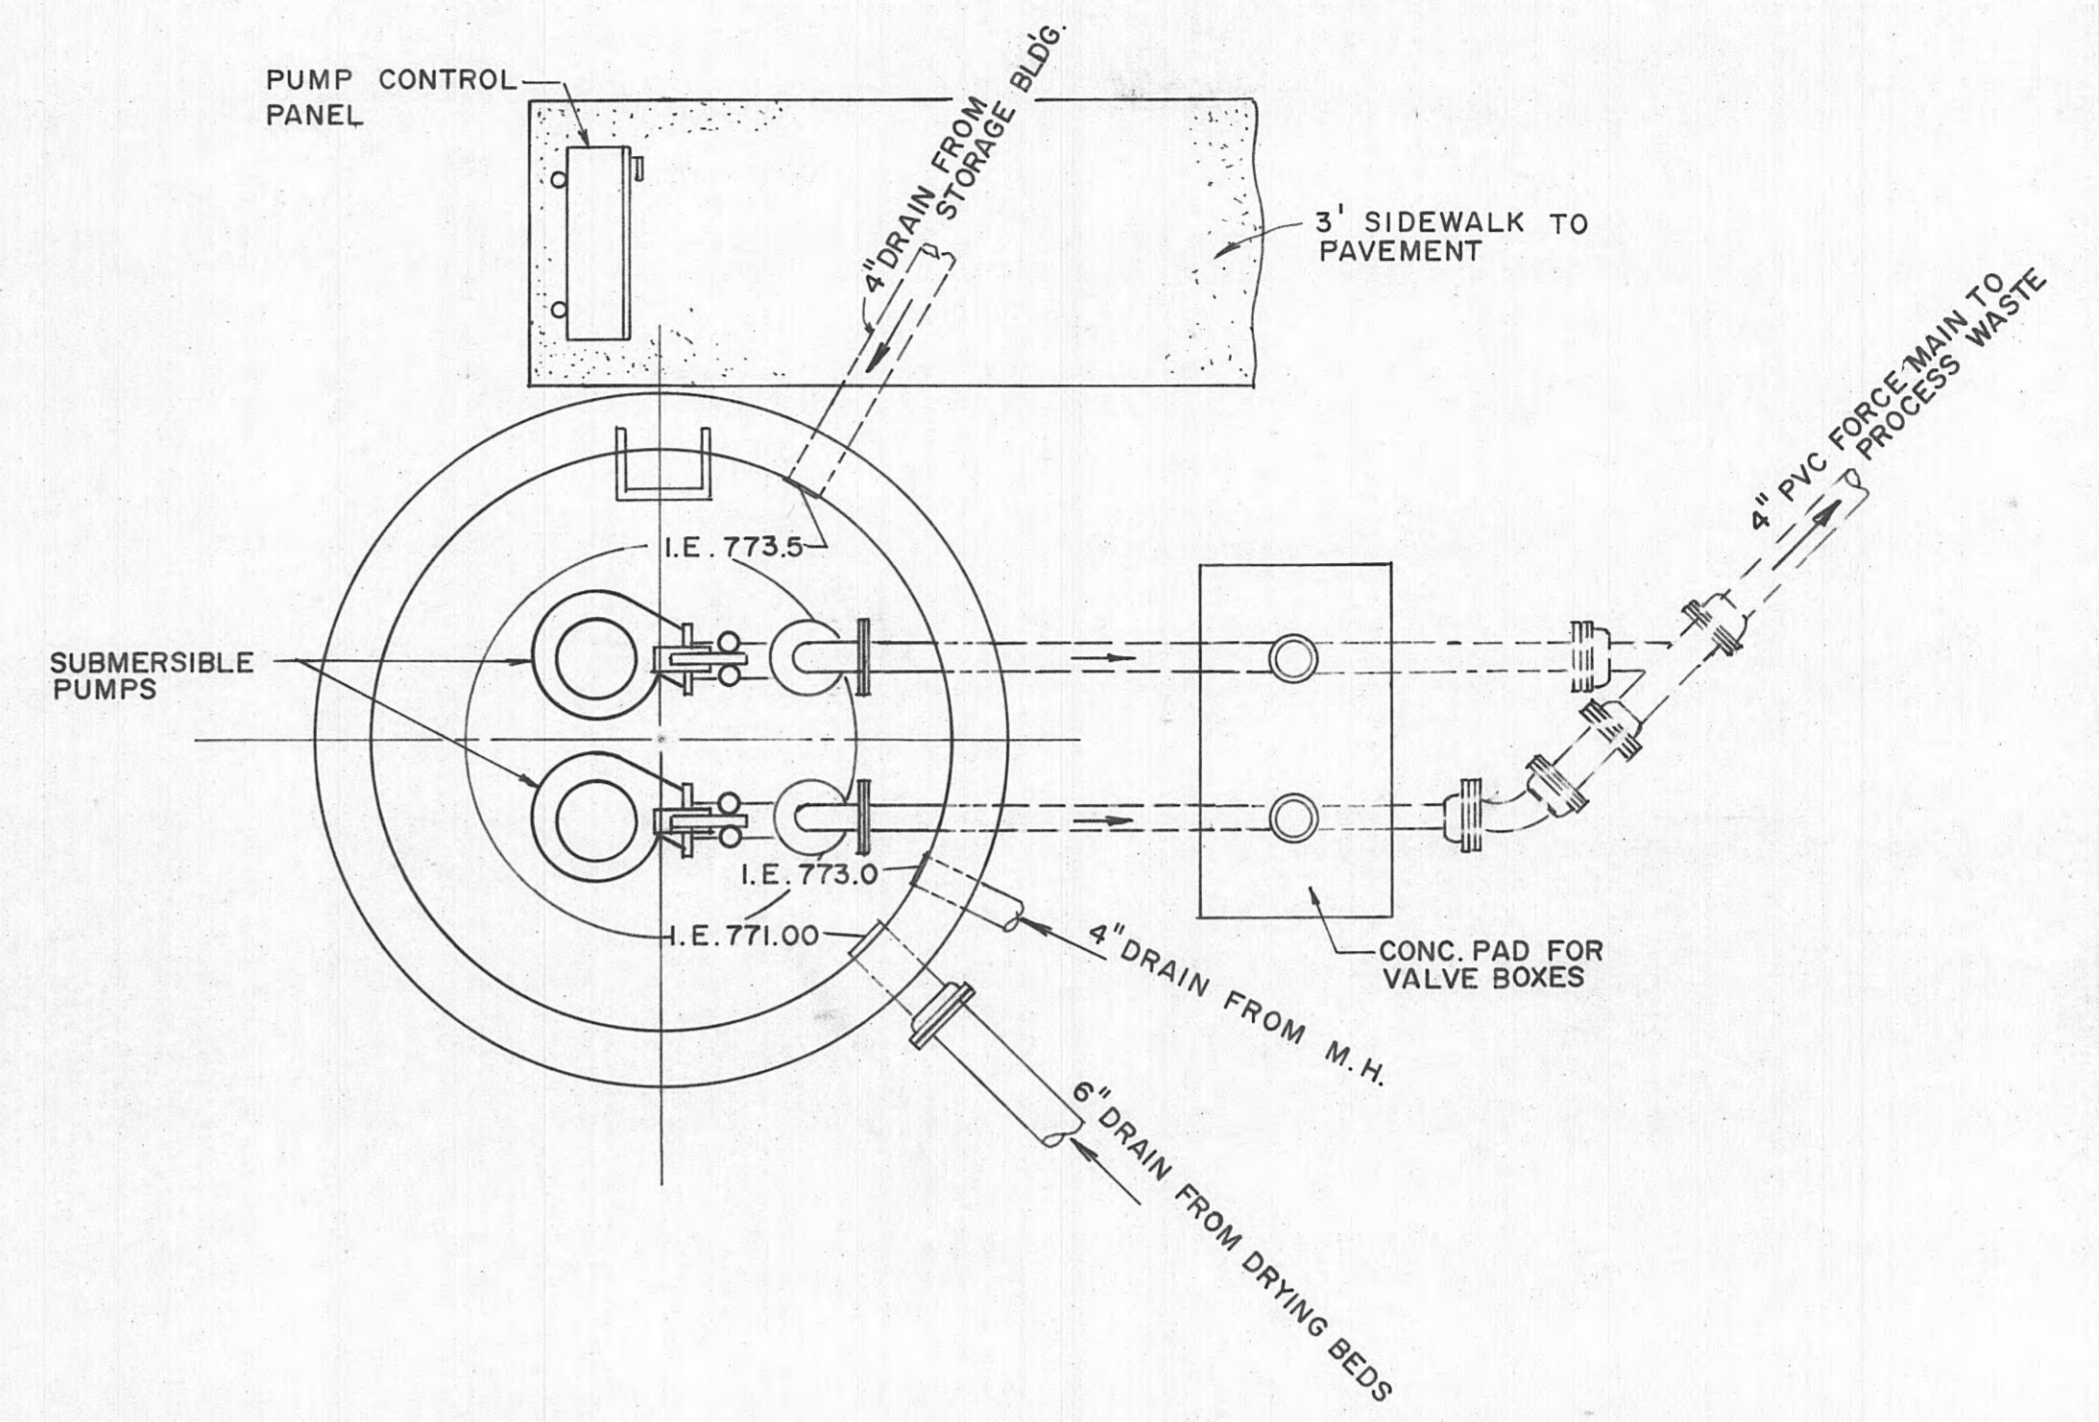

PLAN - FILTRATE PUMP STATION
SCALE: 1/2" = 1'-0"

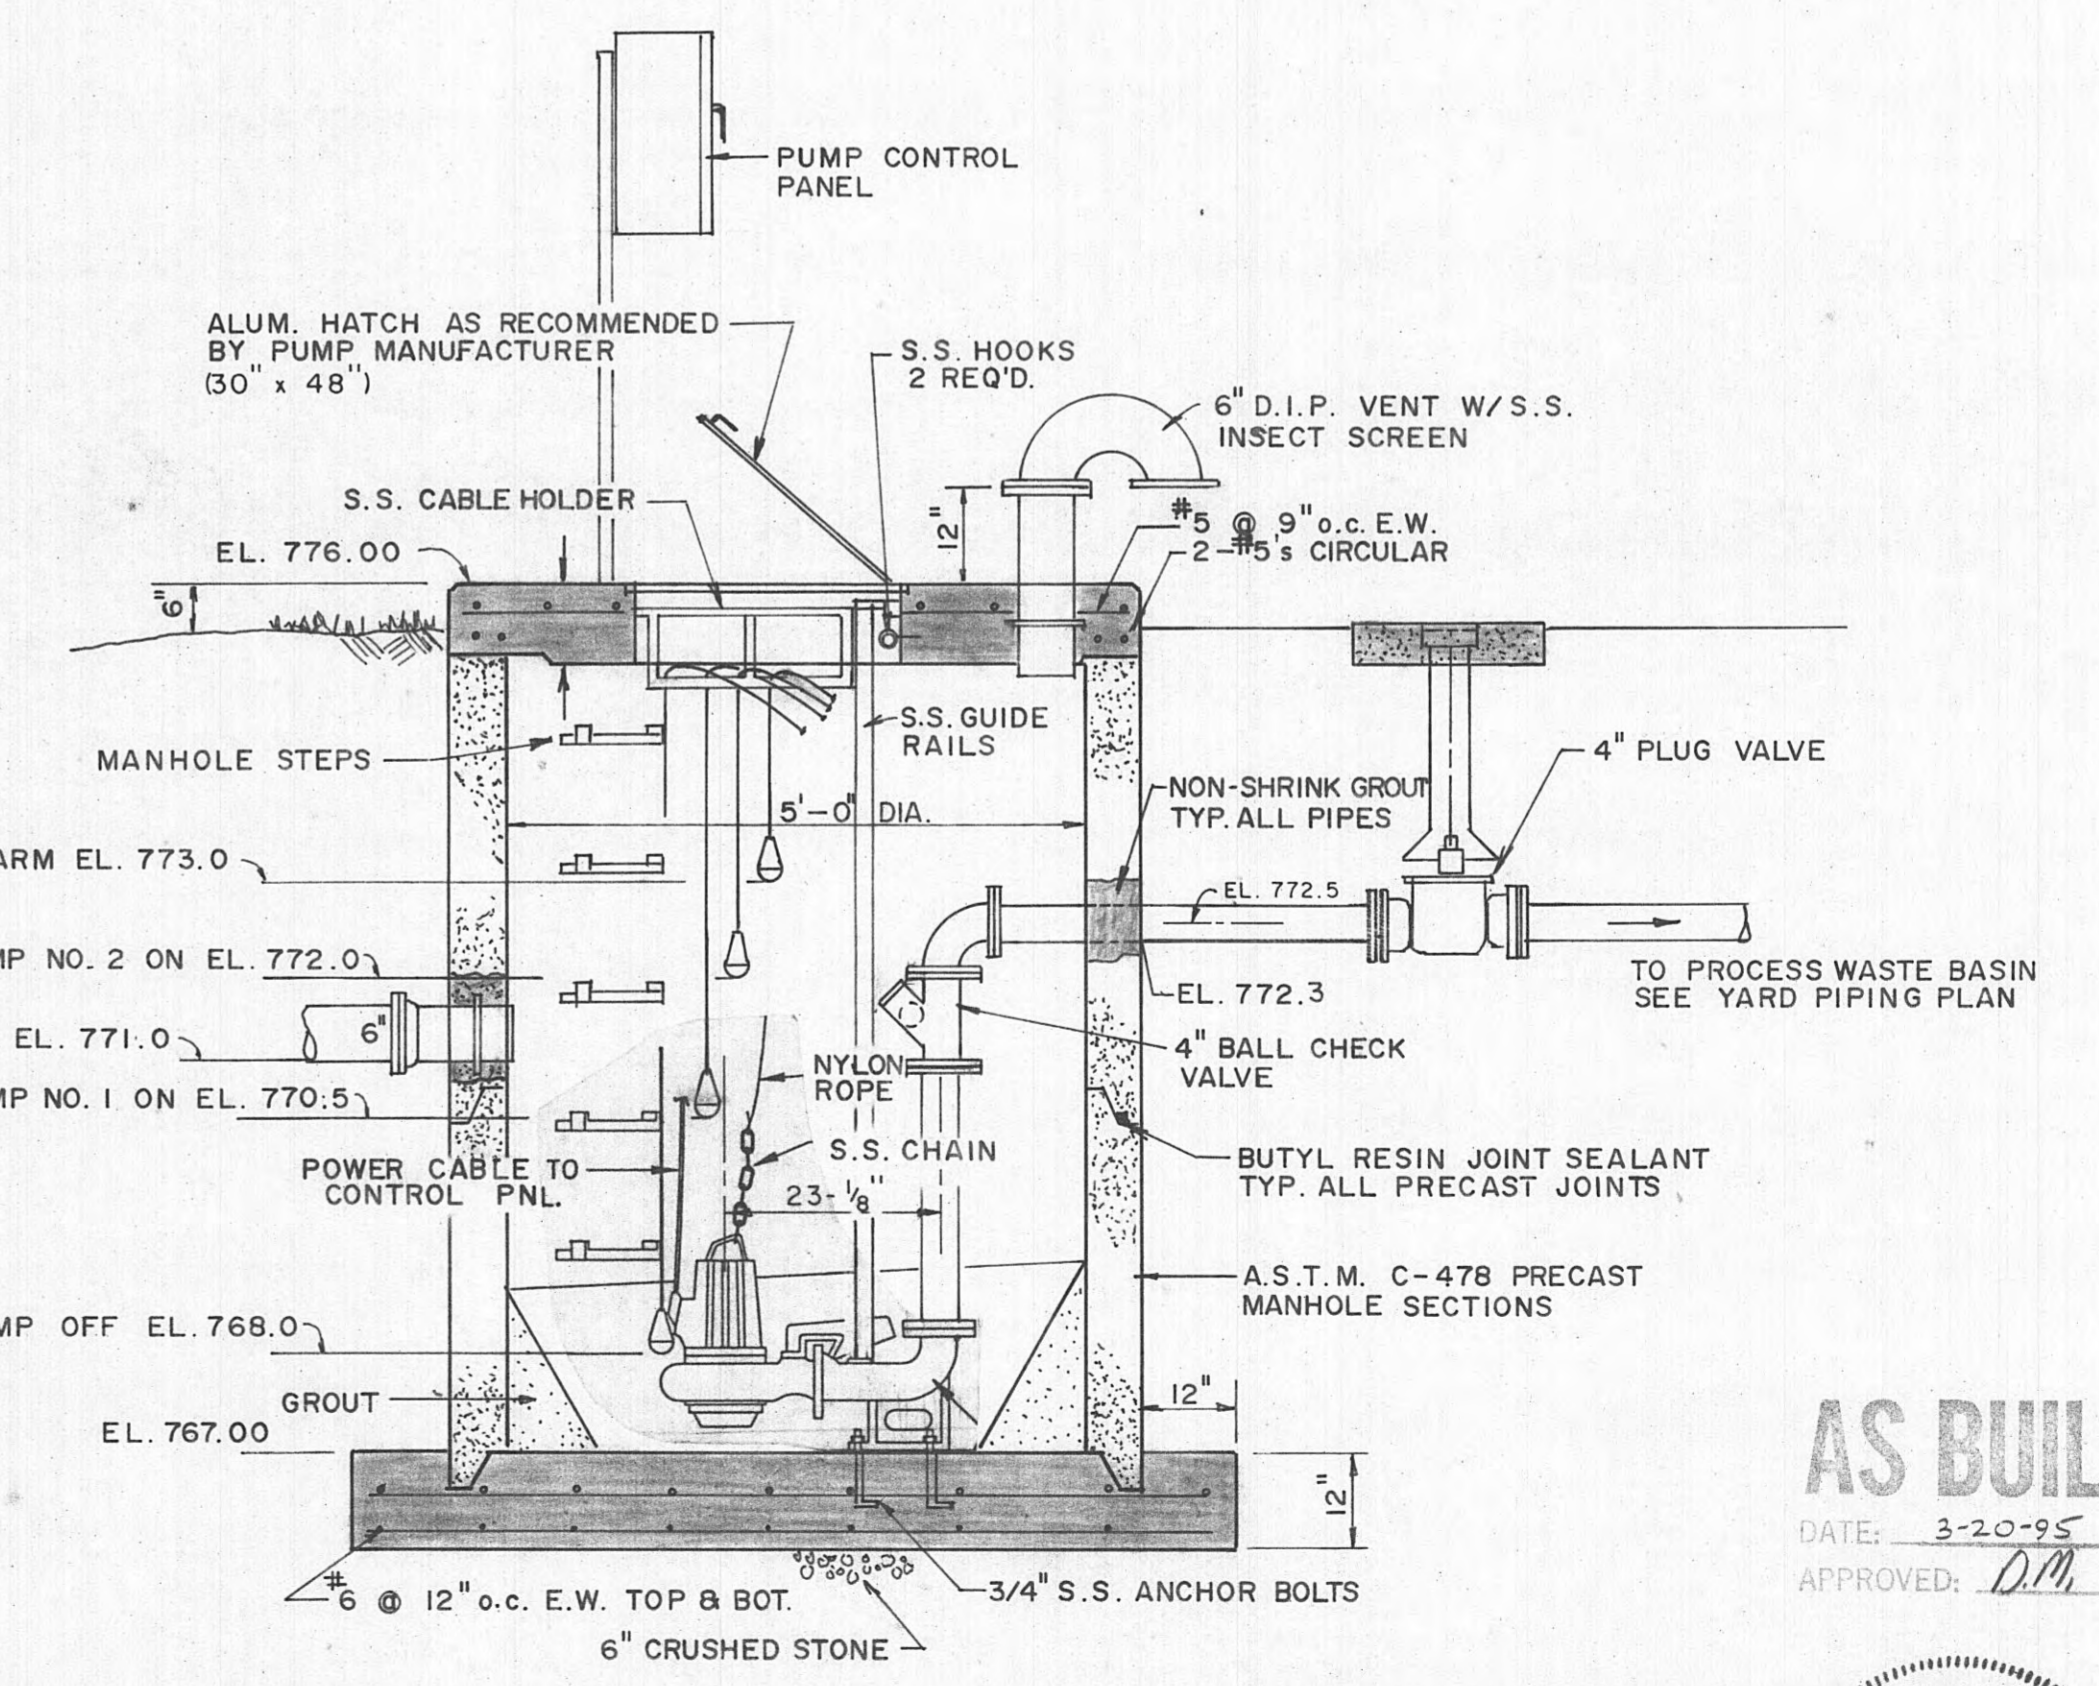

TYPICAL SECTION - FILTRATE PUMP STATION
SCALE: 1/2" = 1'-0"

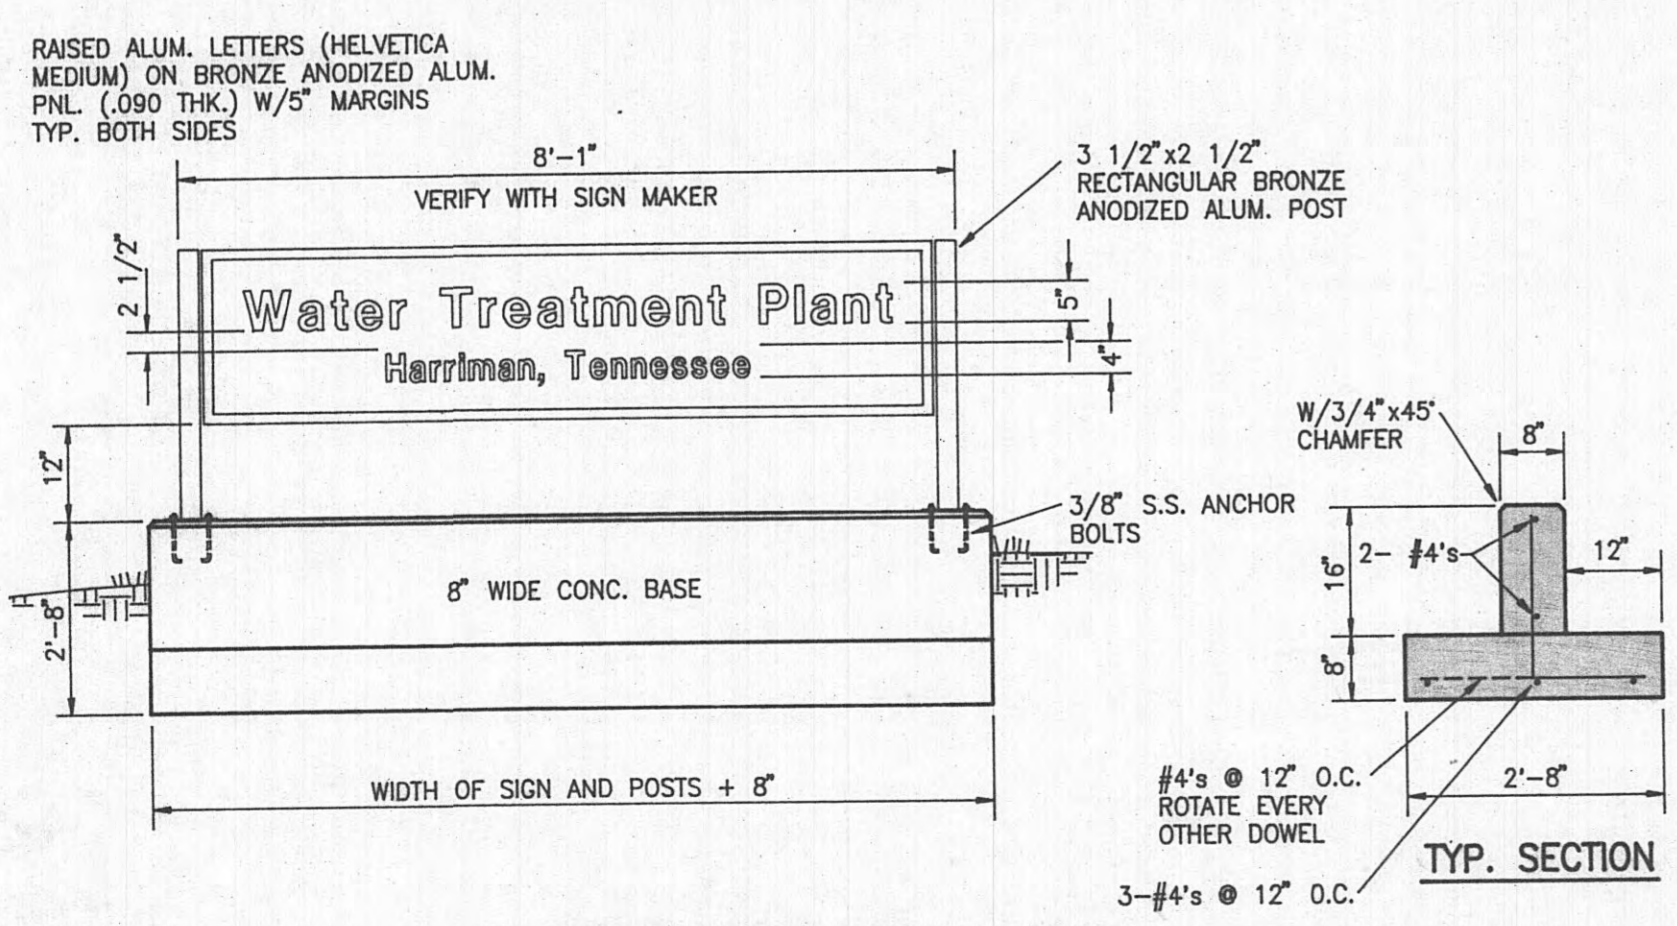


ENTRANCE SIGN DETAIL
SCALE: 1/2" = 1'-0"

AS BUILT
DATE: 3-20-95
APPROVED: DM



ELROD · DUNSON, INC.
CONSULTING ENGINEERS
NASHVILLE · KNOXVILLE
LEXINGTON, KY

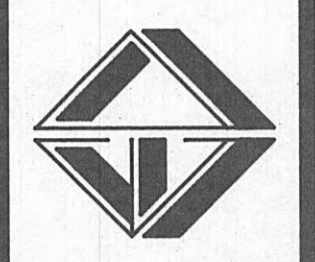


CONTRACT W 93-04
HARRIMAN, TENNESSEE
FILTRATE PUMP STATION, FINISHED WATER METER PIT,
RETAINING WALL PLAN AND SECTIONS

REVISIONS
5/3/93-Add Entrance Sign-Delete Exposed Aggregate on wall

DESIGNED: L. E. R.
DRAWN: D. G. R.
CHECKED: L. E. R.
DATE: MARCH, 1993
SCALE: AS NOTED
PROJ. NO. 0592


SHEET 19

OF 36

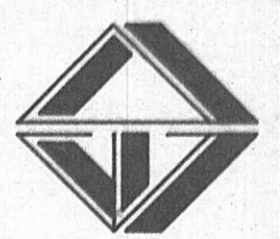


REVISIONS


DESIGNED: L. E. R.
DRAWN: D. G. R.
CHECKED: L. E. R.
DATE: MARCH, 1993
SCALE: AS NOTED
PROJ. NO. 0592

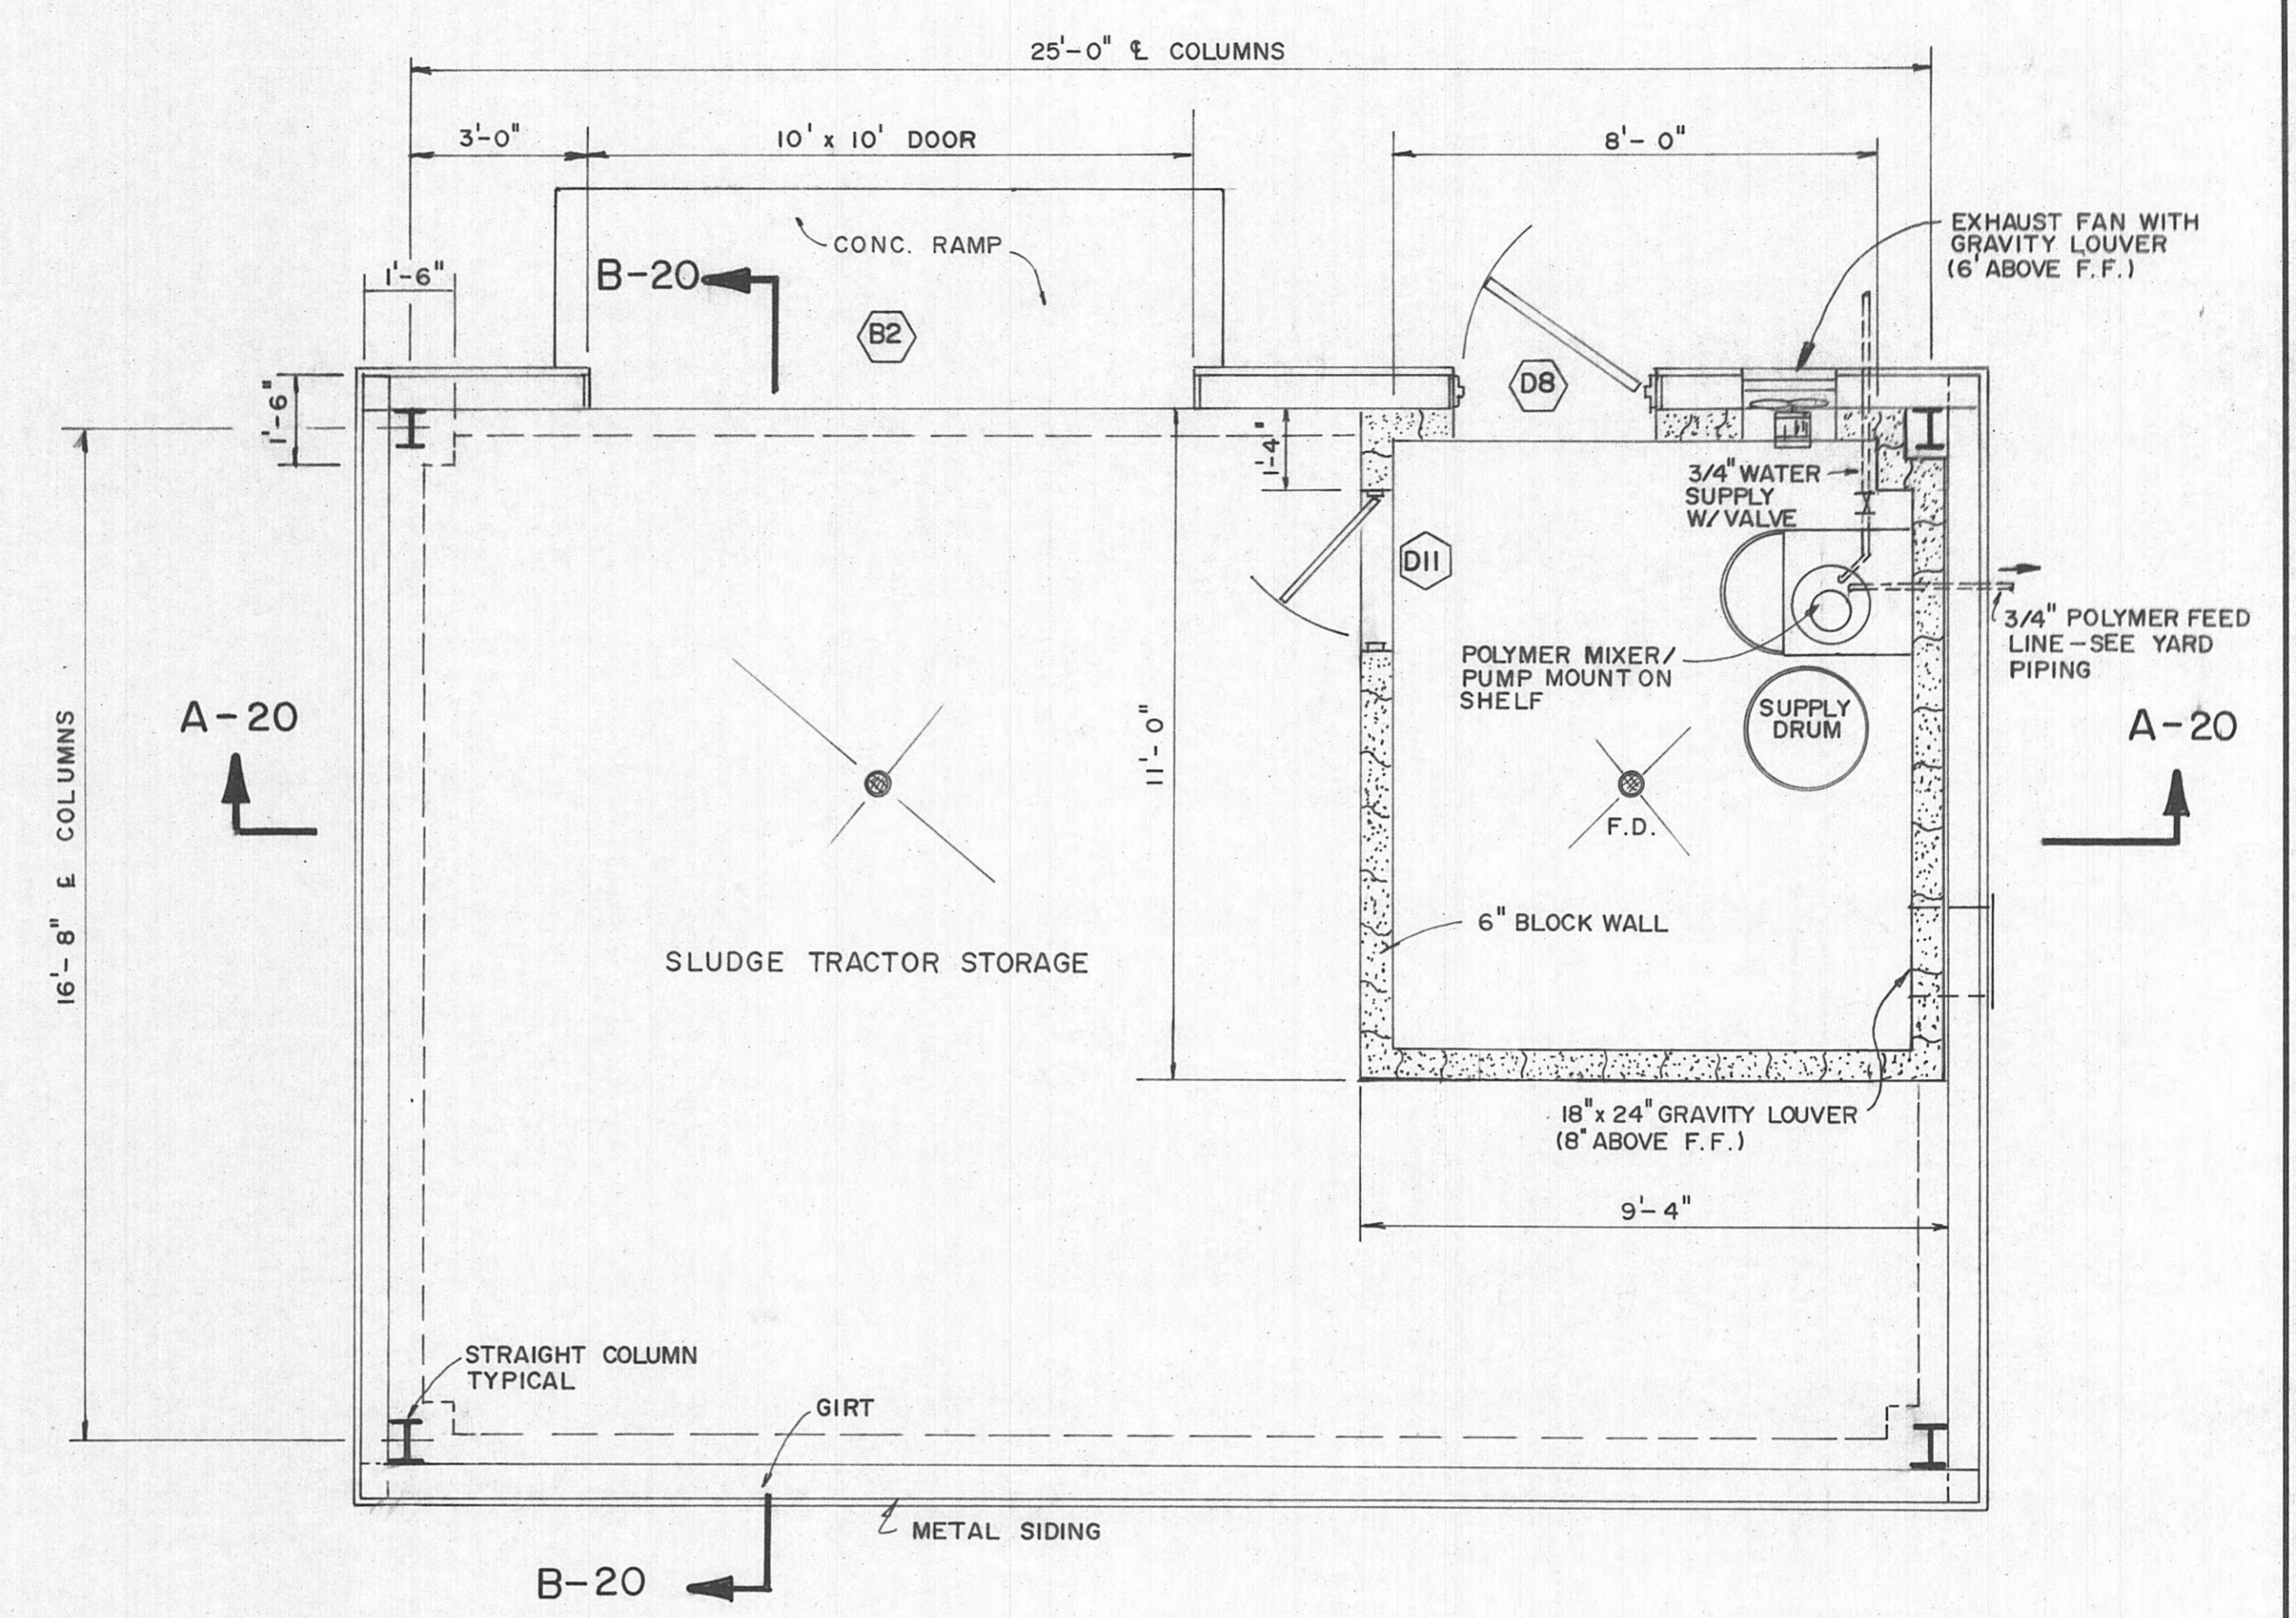


PLAN - STORAGE BUILDING/POLYMER FEED ROOM
SCALE: 3/8" = 1'-0"

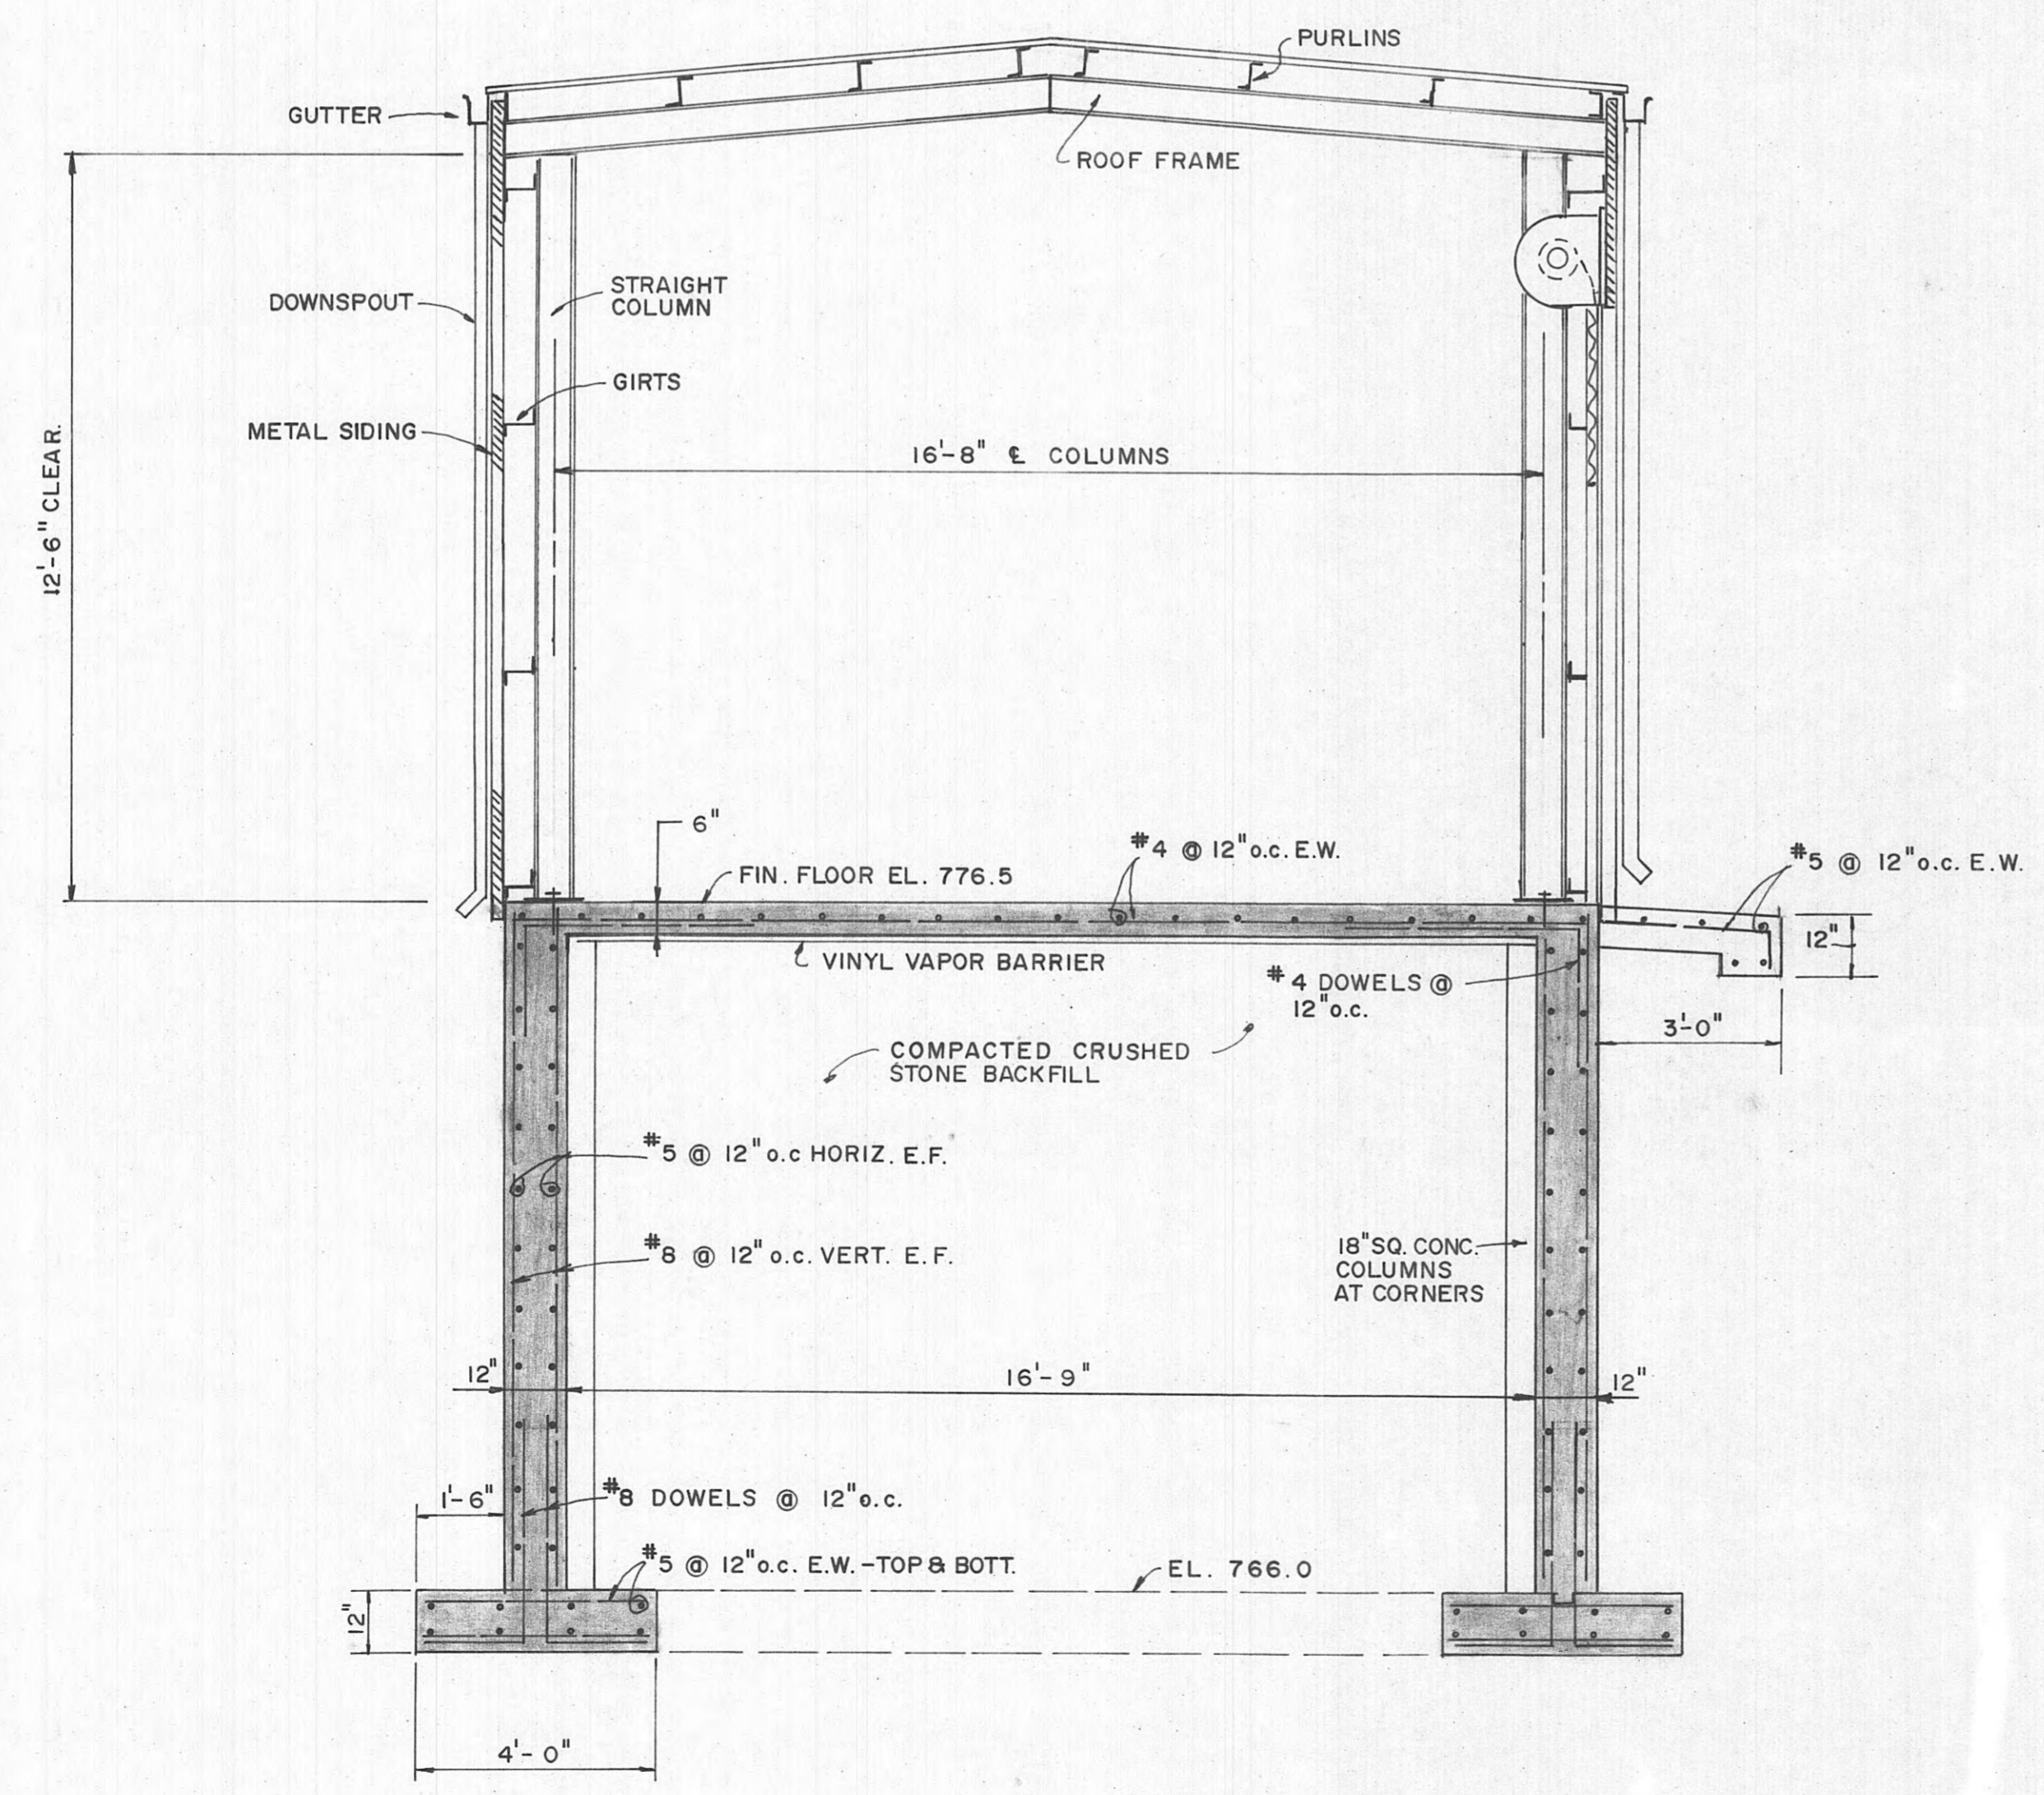

SECTION B-20
SCALE: 3/8" = 1'-0"

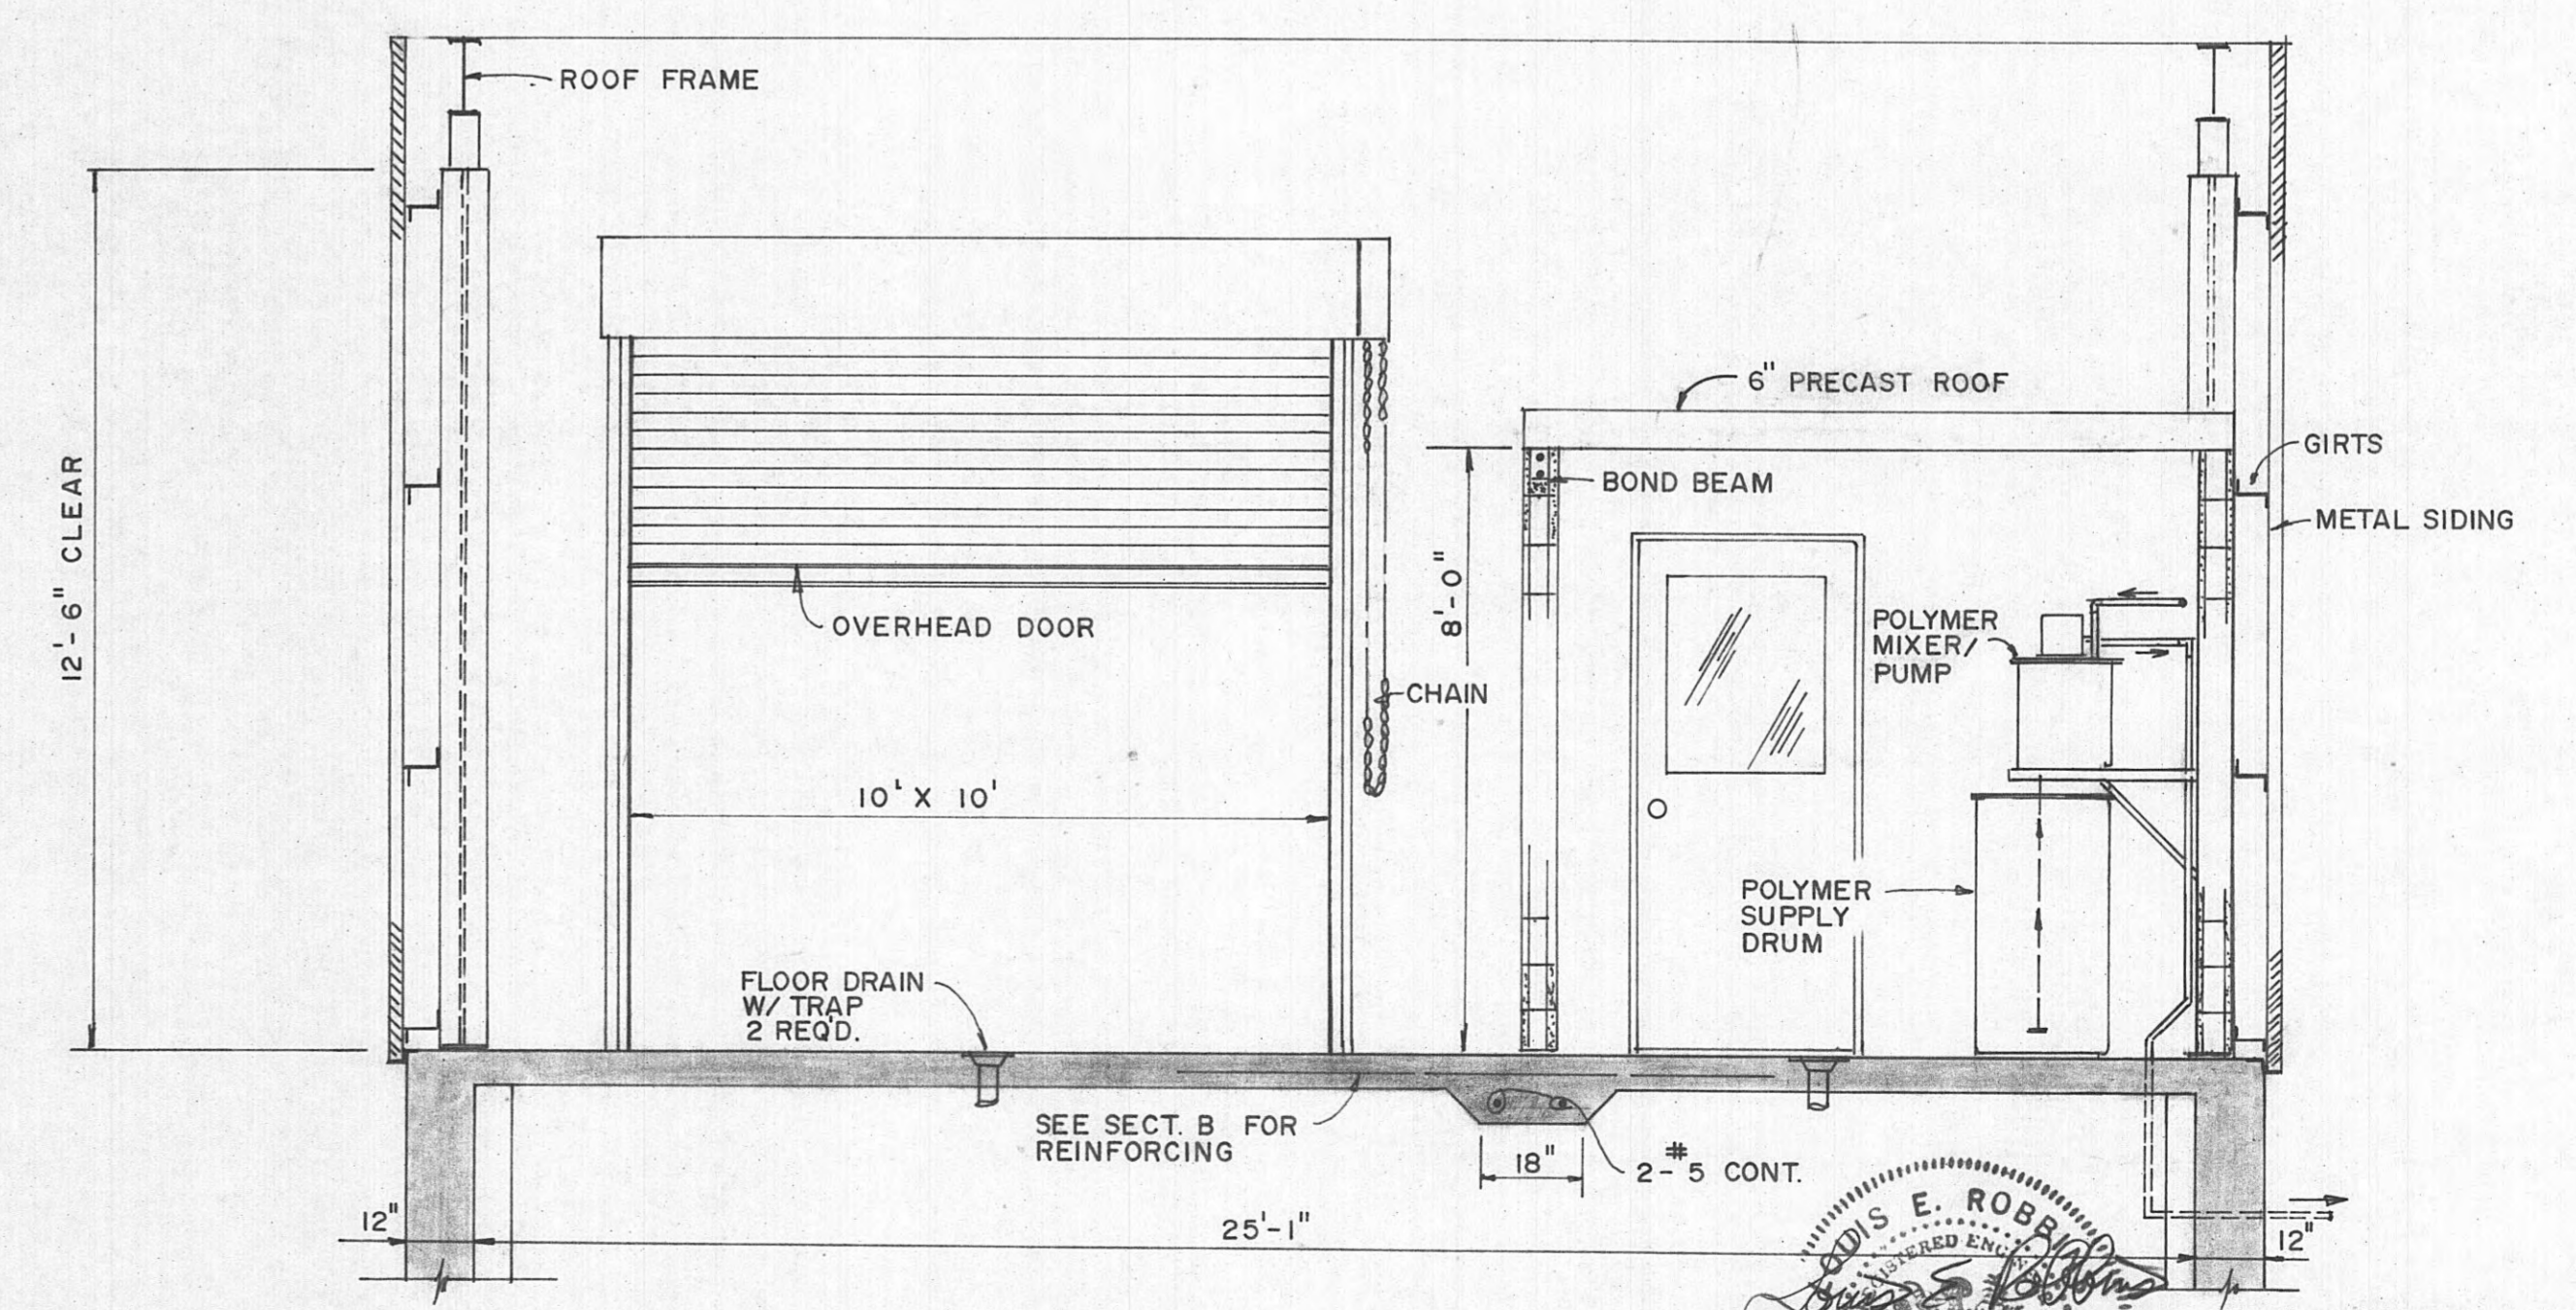


SECTION A-20
SCALE: 3/8" = 1'-0"

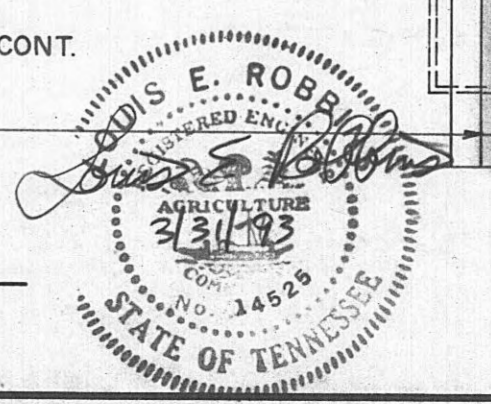


AS BUILT
DATE: 3-20-95
APPROVED: D.M.


CONTRACTOR SHALL CUT AND REMOVE DETERIORATED CONC. SLAB IN AREA SHOWN. A NEW SLAB SHALL BE POURED WITH NEW REBARS DOWELLED INTO EXIST. SLAB. SEE DETAIL THIS SHEET.

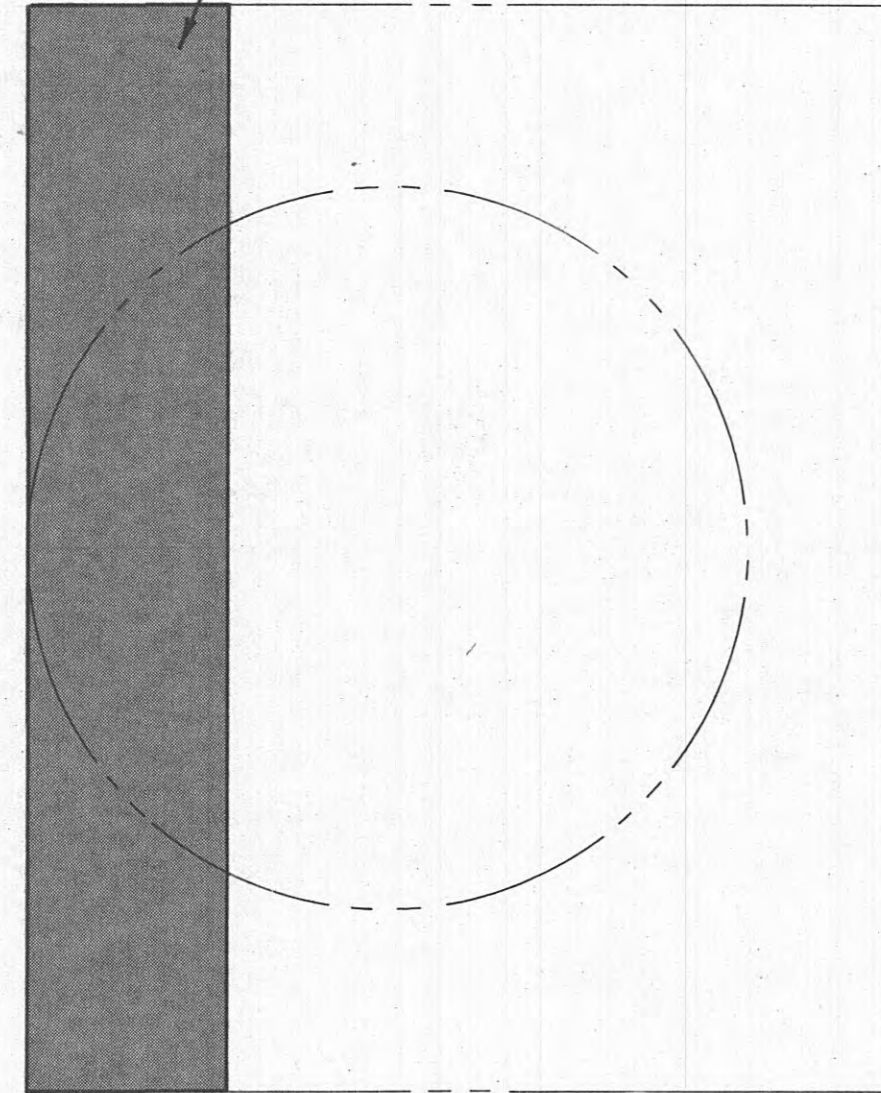


DETAIL - SLAB REPAIR
SCALE: 3/8" = 1'-0"

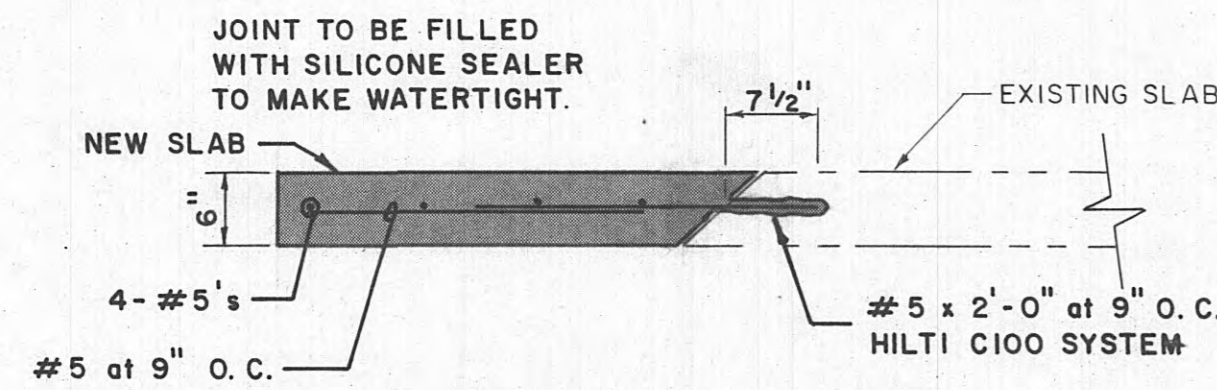


DETAIL - SLAB REPAIR JOINT
SCALE: 3/4" = 1'-0"

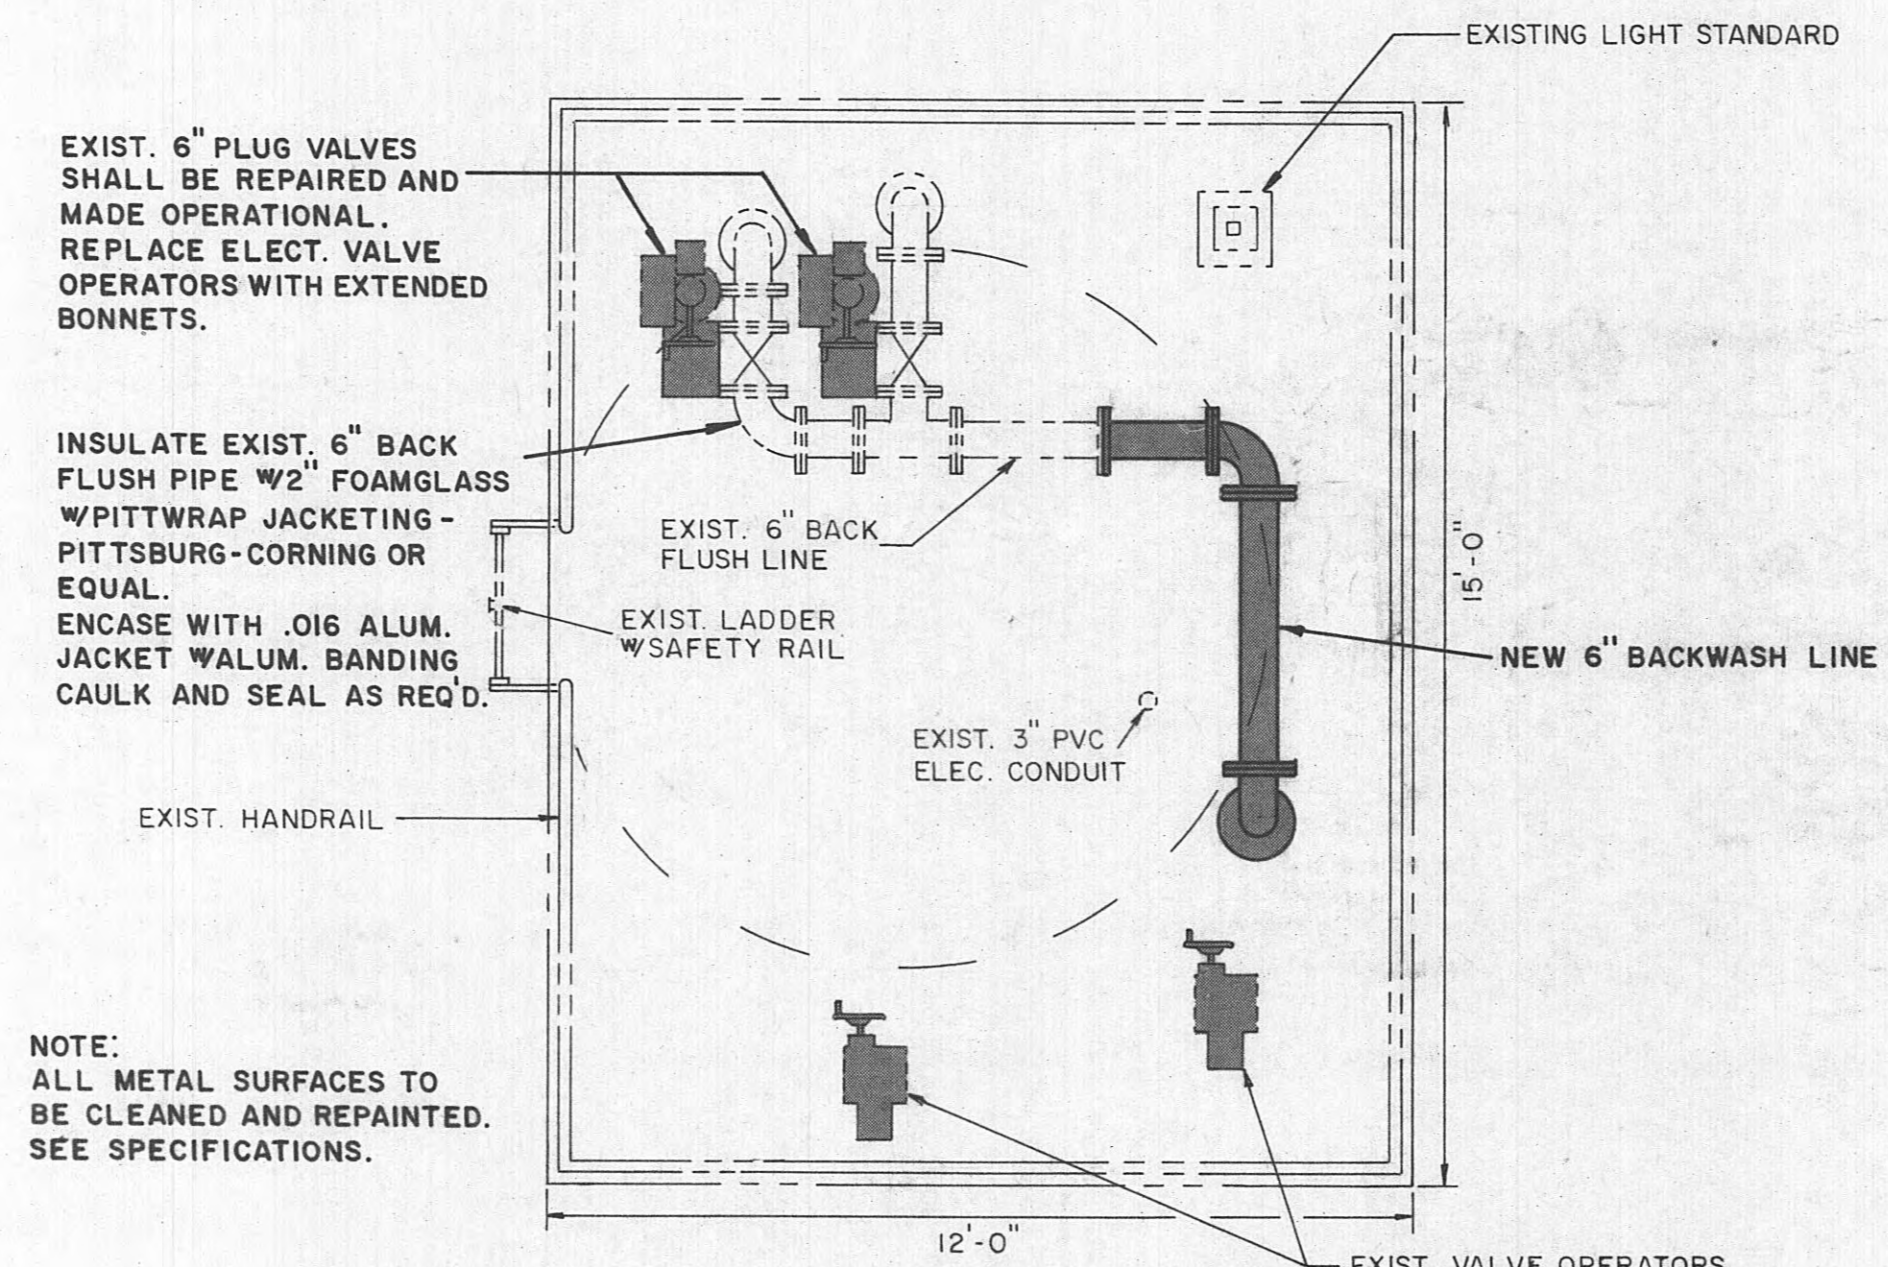

PLAN - INTAKE STRUCTURE
SCALE: 3/8" = 1'-0"

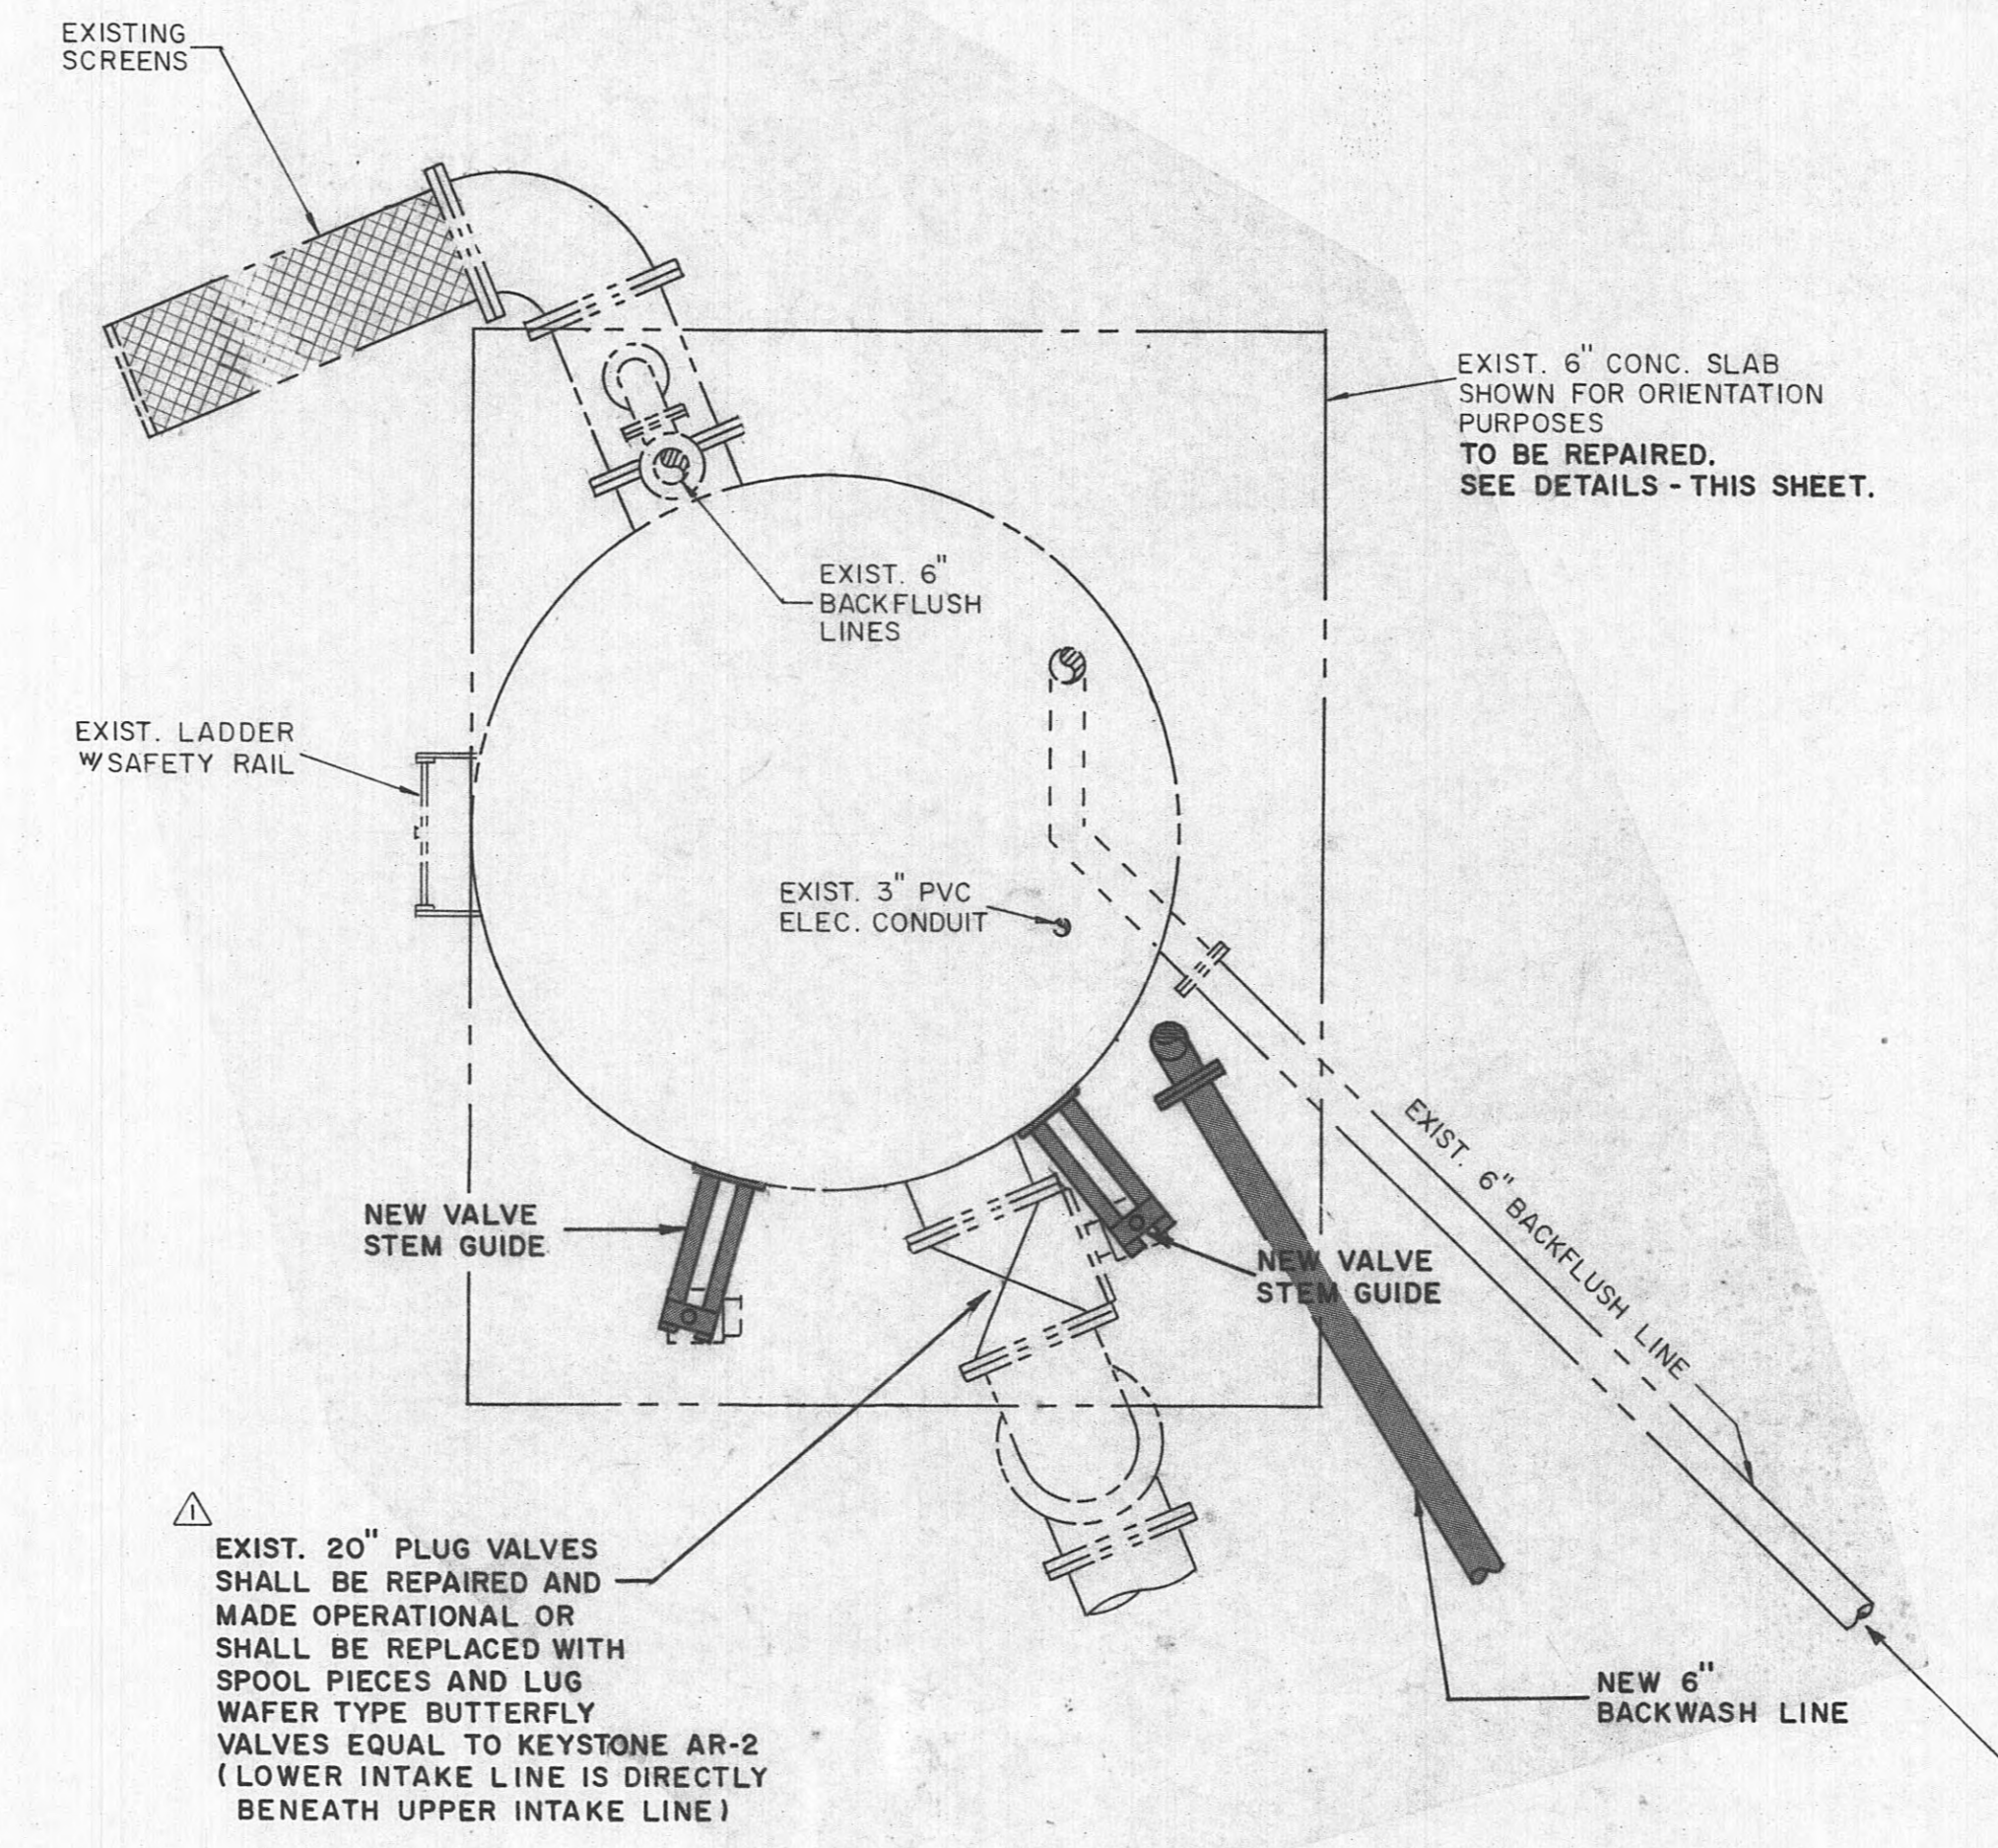

PARTIAL PLAN - INTAKE STRUCTURE
SCALE: 3/8" = 1'-0"

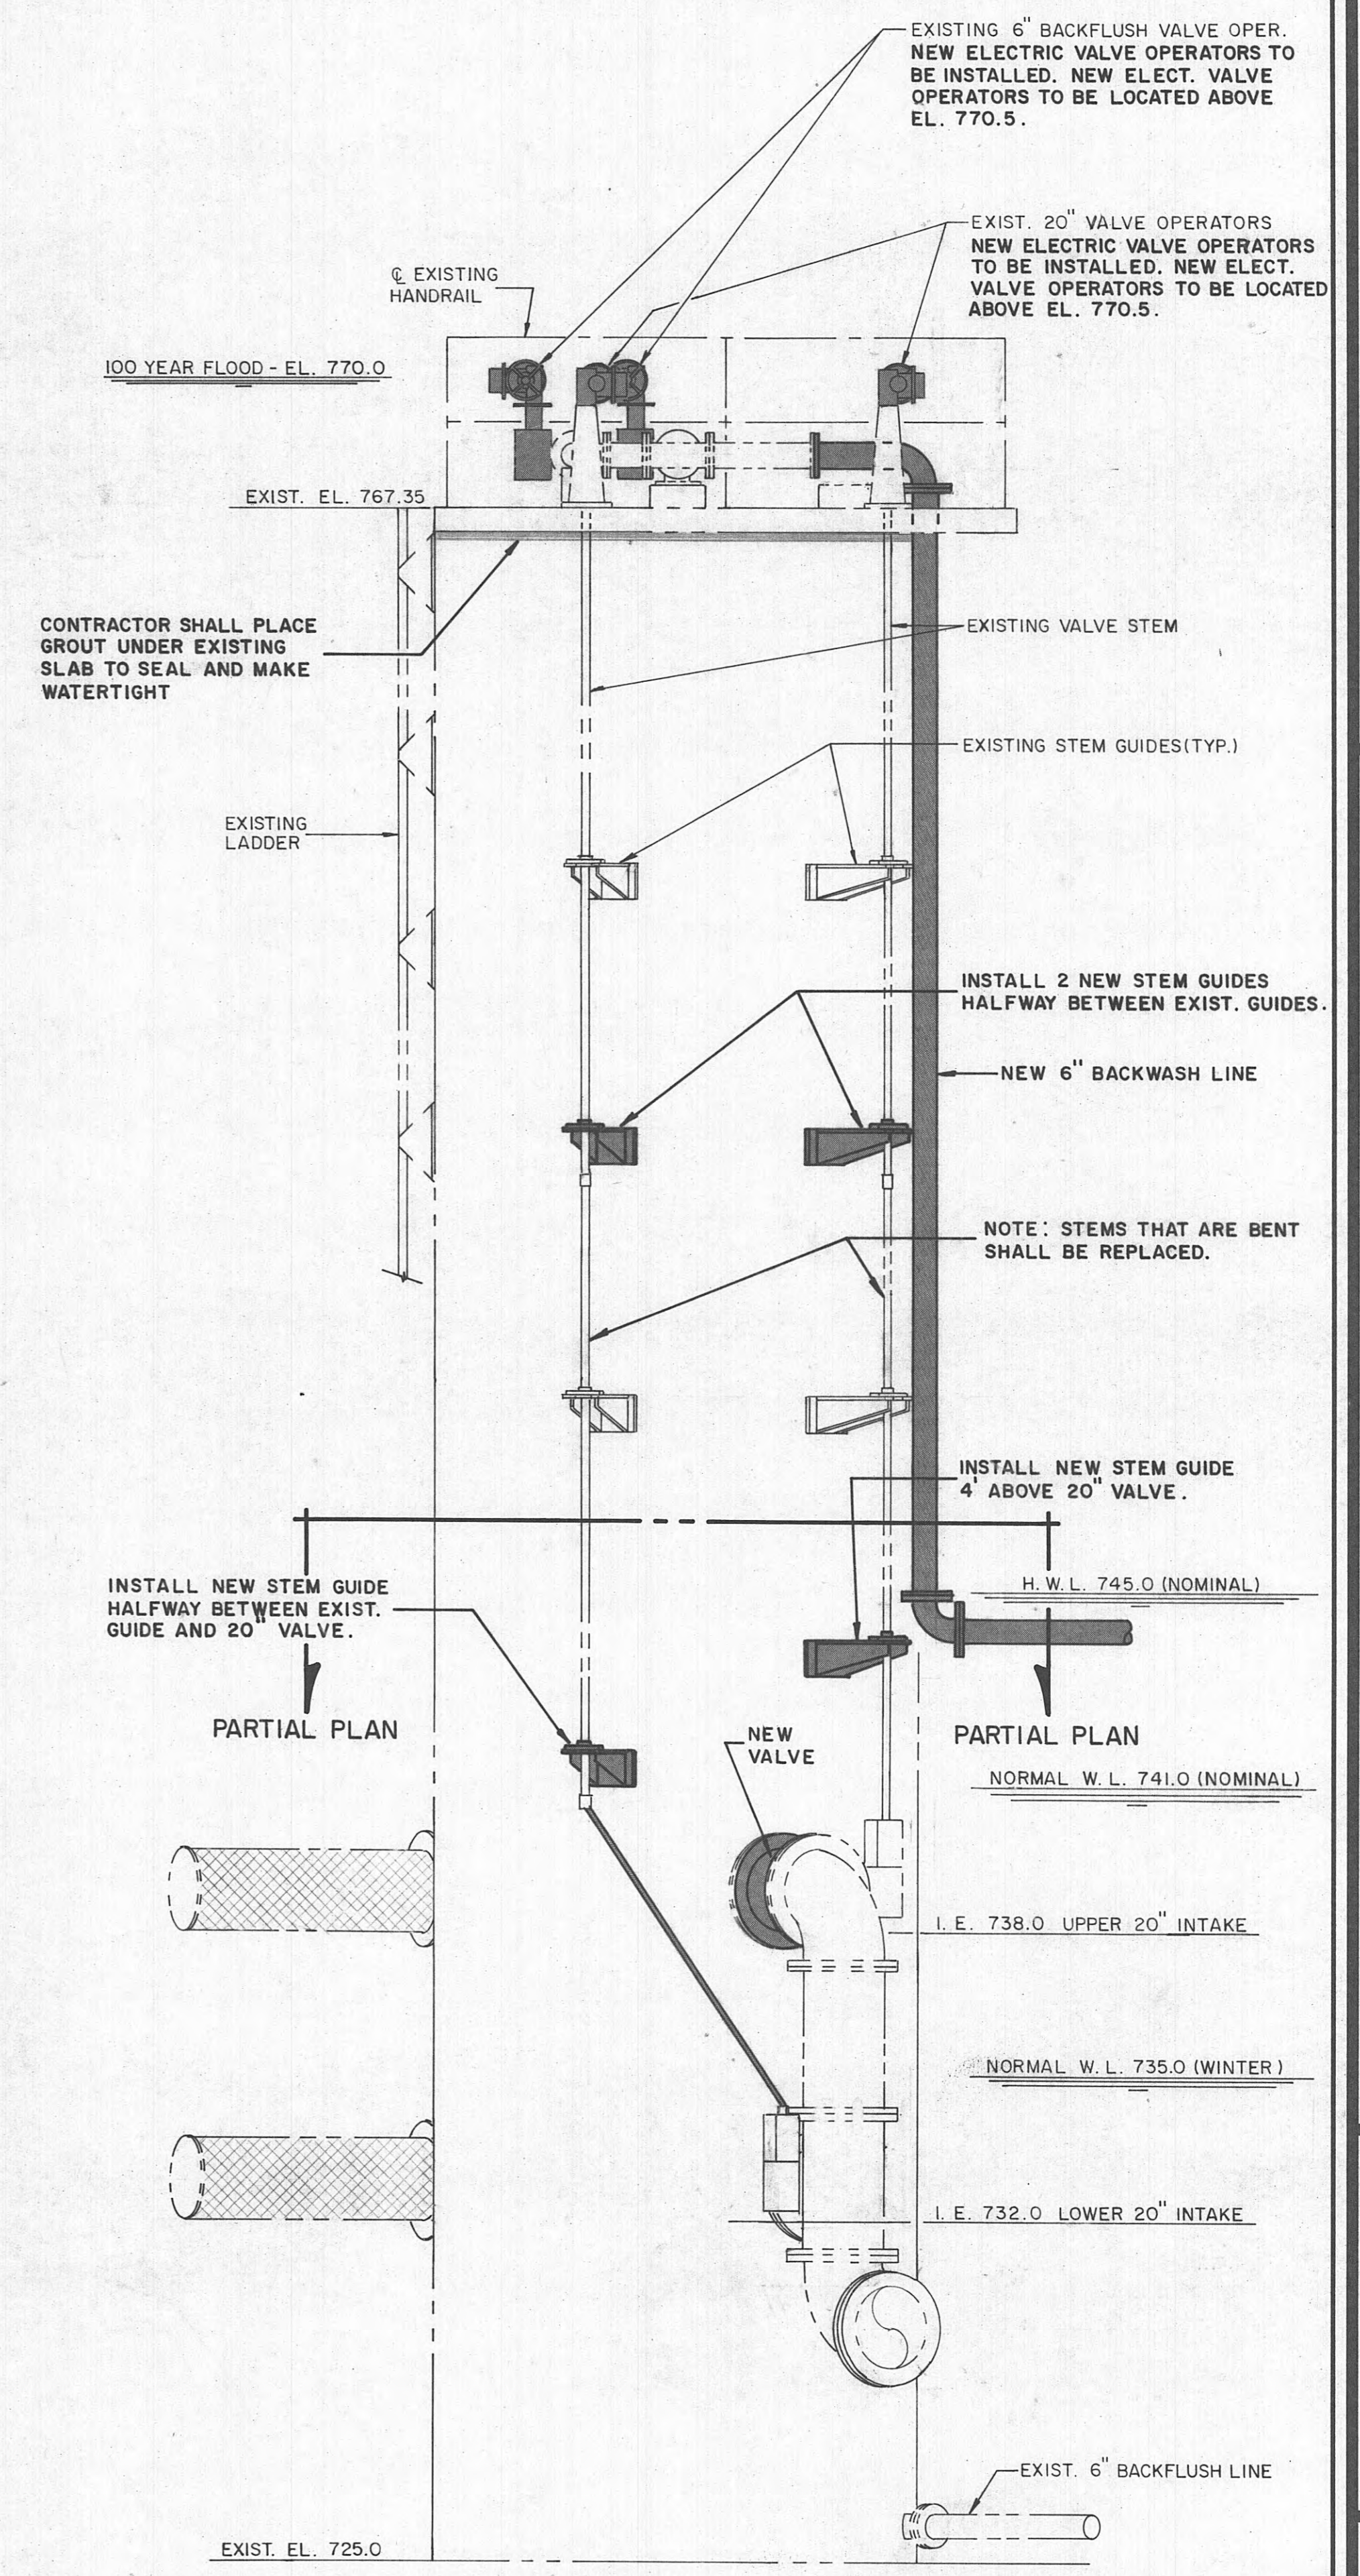


ELEVATION - INTAKE STRUCTURE
SCALE: 3/8" = 1'-0"

AS BUILT
DATE: 3-20-95
APPROVED: *D.M.*



ELROD · DUNSON, INC.
CONSULTING ENGINEERS
NASHVILLE · KNOXVILLE
LEXINGTON, KY

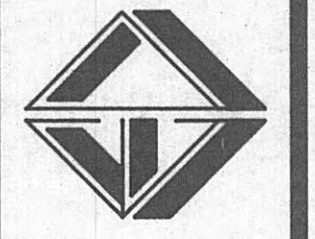


CONTRACT W93-04
HARRIMAN, TENNESSEE
MODIFICATIONS TO RAW WATER INTAKE STRUCTURE



REVISIONS
7-7-93
REVISION 1 -
ADDENDUM NO. 1

DESIGNED: L. E. R.
DRAWN: D. M.
CHECKED: L. E. R.
DATE: MARCH, 1993
SCALE: AS NOTED
PROJ. NO. 0592

SHEET 21
OF 36

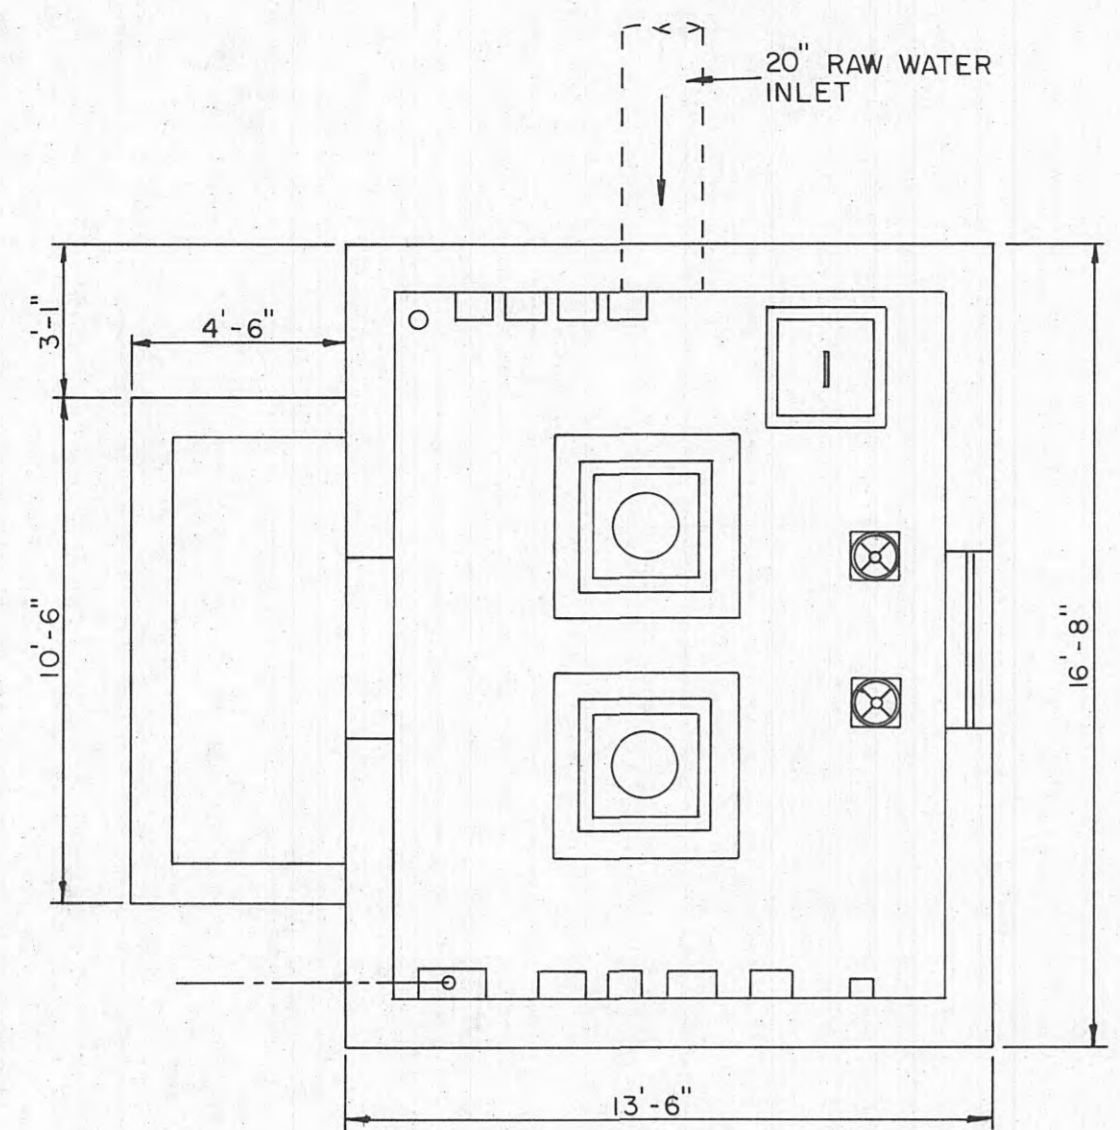

PLAN - EXISTING INTAKE PUMP BUILDING
SCALE: 1/4" = 1'-0"

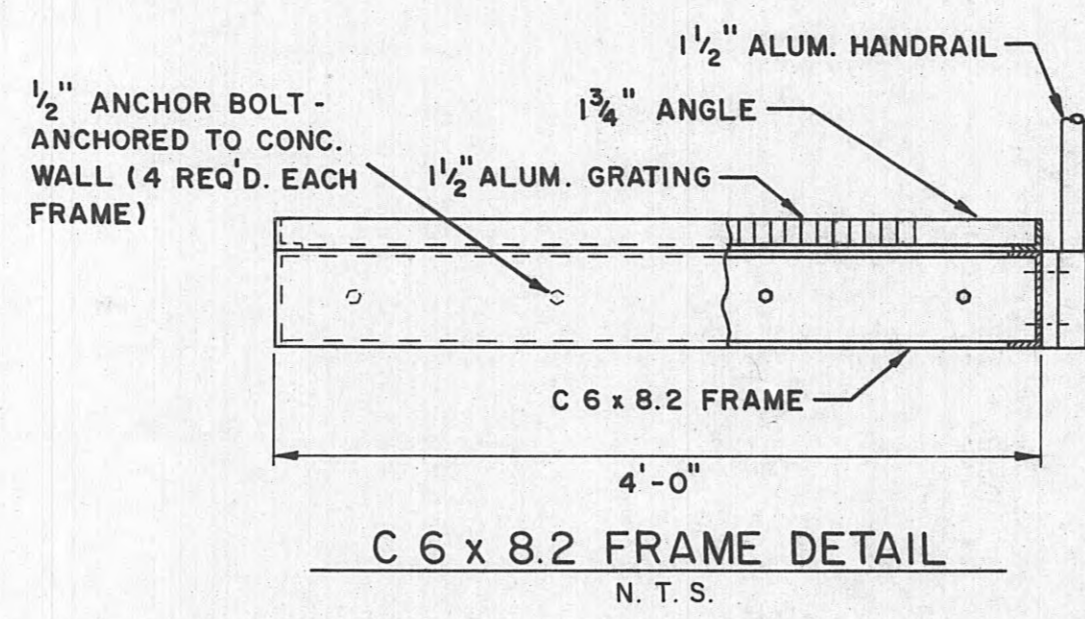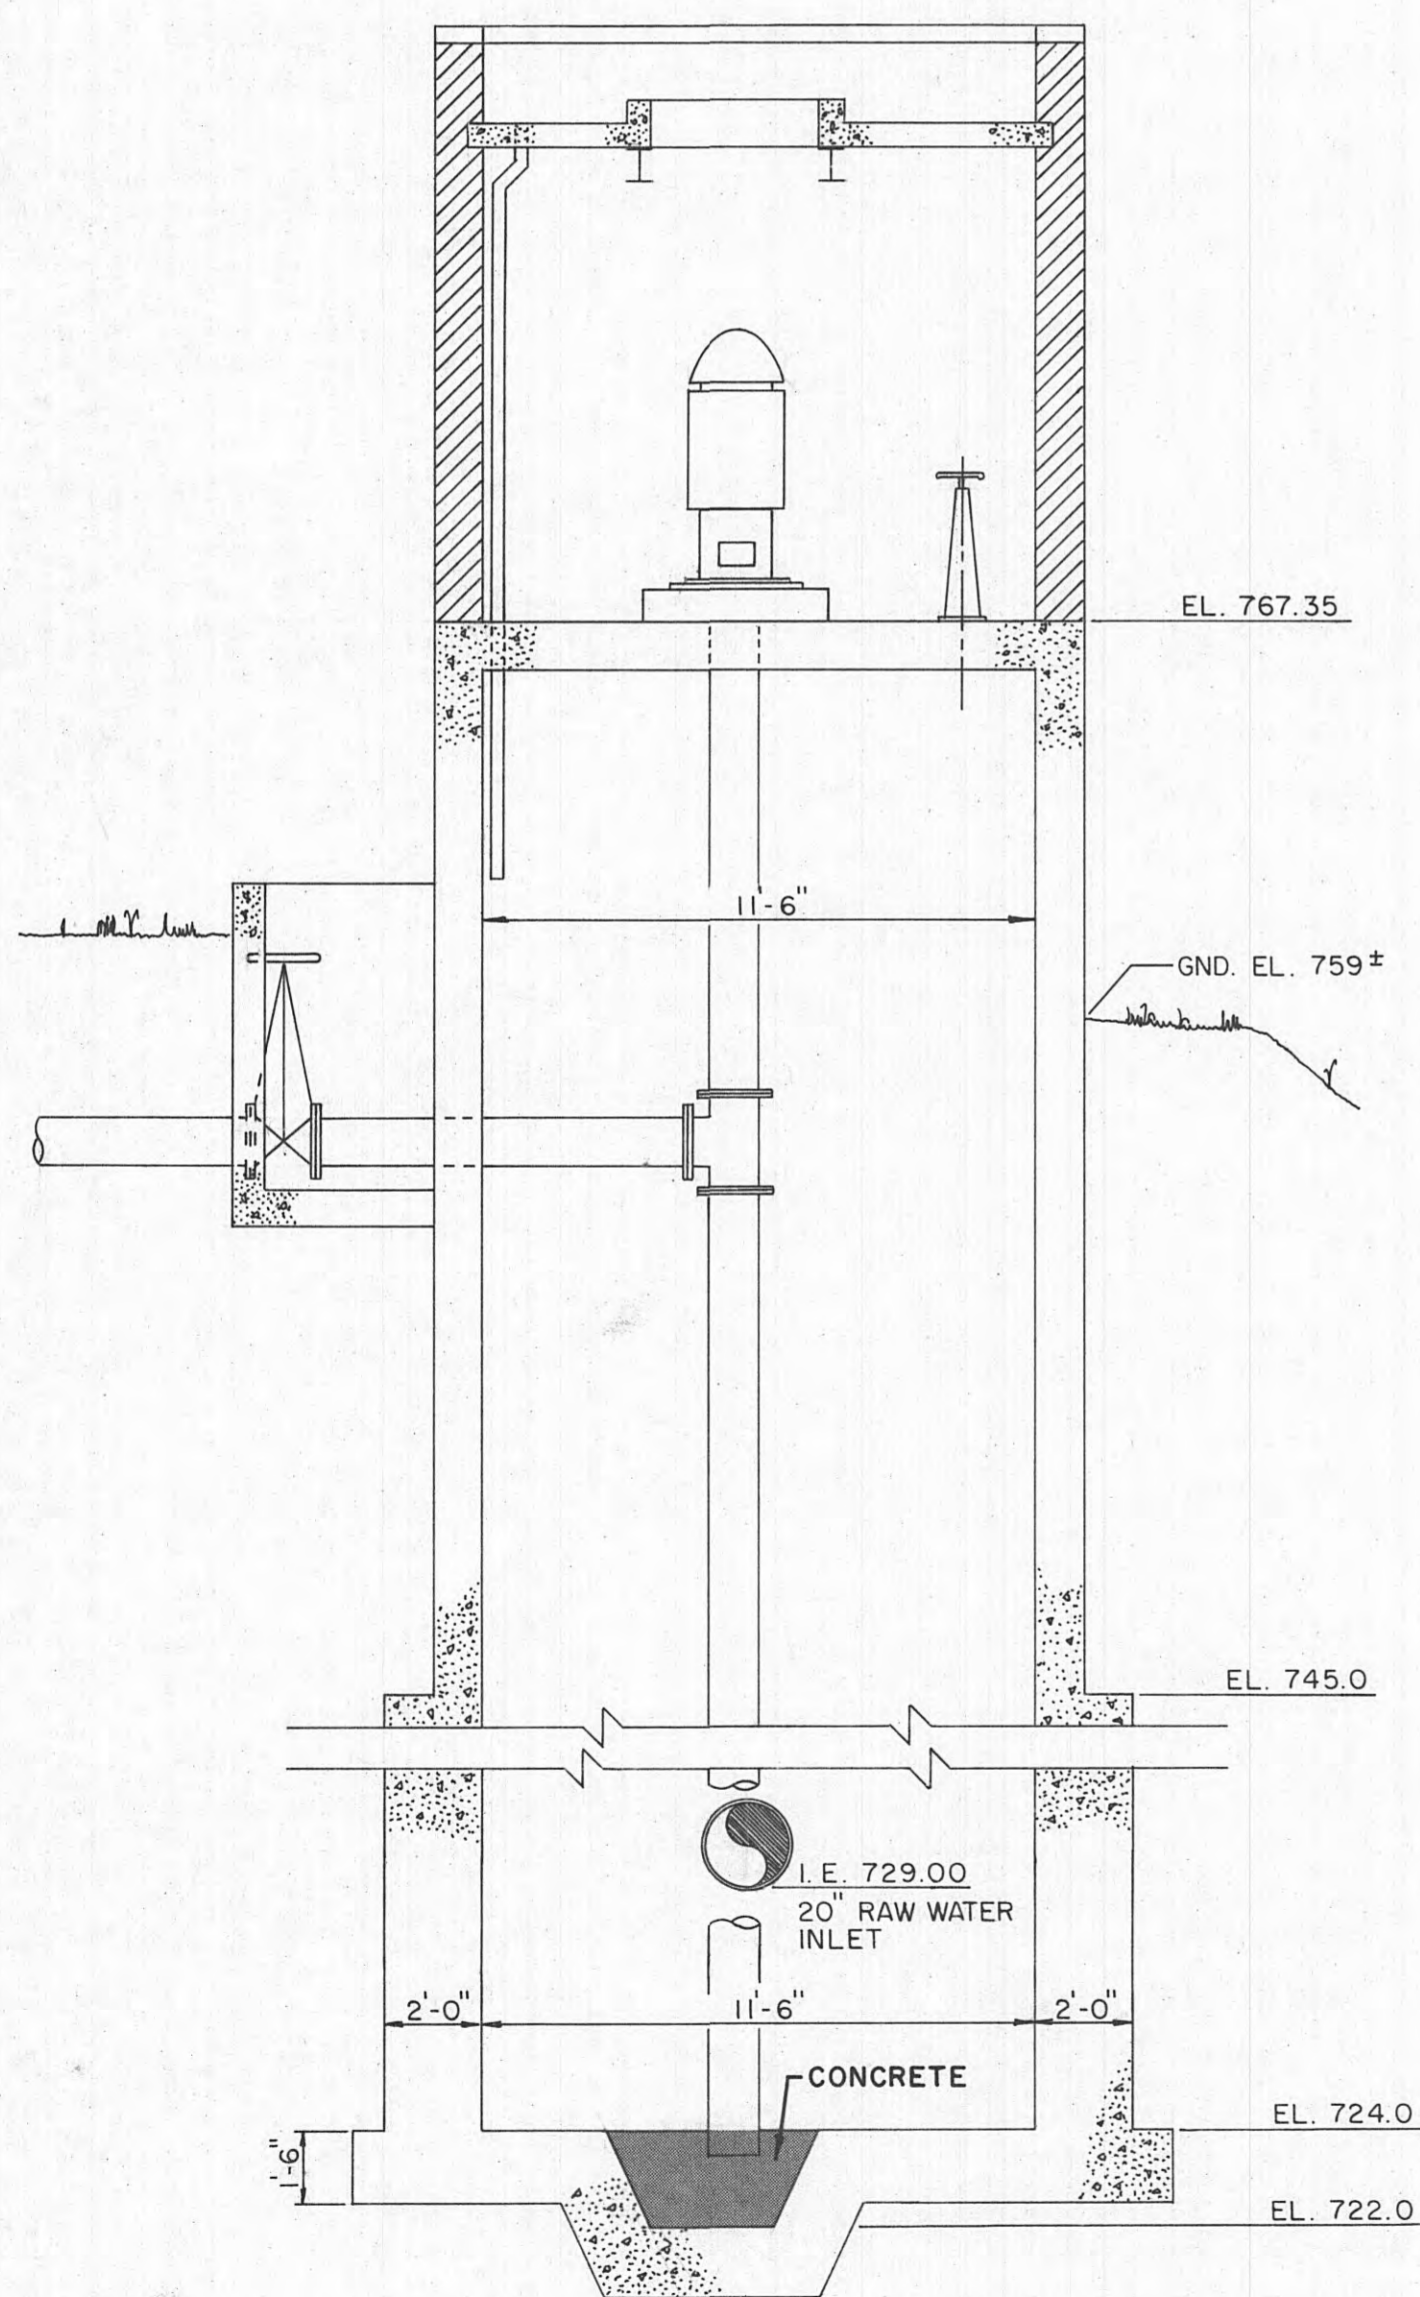


INTAKE PUMP BUILDING
FOUNDATION CONSTRUCTION


NOTE: Refer to Subsurface Investigation Report developed by Foundation Systems Engineering located at end of Detailed Specifications.

- Grout Injection:
- The Contractor shall prepare 16 each, 3-inch diameter (maximum) injection ports for low pressure grouting at the spacing shown below.
 - Grout shall be Type 1 Portland with Type F Flyash with a compressive strength of 1000 psi. The Contractor shall submit the design mix for approval by the Engineer.
 - Grout injection shall be initiated at the surface of the bedrock and retracted to the top of the relative injection port. Total injection pressures shall not exceed 100 psi.
 - All grouting procedures shall be performed to eliminate all voids beneath the existing foundation and shall extend to a minimum 2-4 feet horizontal distance beyond the exterior dimensions of the existing concrete foundation as shown on Section B-23 on Sheet 23.
 - It is the intention of this procedure to cement the underlying alluvial material between the existing foundation and bedrock so that minimal settlement from increased loading would occur. Injection rates and pressures must be recorded to assess the influx of grout into the alluvial materials. The installation of rock anchors described hereafter will be an indication of the success of grouting operations. If, during drilling operations, it is apparent that the initial grouting procedure was unsuccessful, then the Contractor shall regrout the deficient area to the satisfaction of the Engineer.


- Rock Anchor Installation:
- After grouting is completed and the grout has reached a compressive strength of 1000 psi, the Contractor shall prepare 12 each, 1 1/2 inch diameter holes at the spacing shown below for the installation of 1" diameter rock anchors.
 - Rock anchors and complete installation procedures shall be by DYWIDAG SYSTEMS INTERNATIONAL or approved equal.
 - Rock anchors shall be 1-inch diameter, prestressing steel according to ASTM A722, and shall be installed to a minimum depth of 10 feet into the underlying bedrock. Resin anchoring material shall be selected for use in saturated/undated conditions, and shall fully encapsulate the steel anchor from bottom to top prior to prestressing.
 - A 6" x 6" x 1 1/4" steel plate and associated washer and nut specifically designed for this procedure must be installed as required by the manufacturer and pressed to 40% of the ultimate strength of the steel anchor after the resin has fully set.
 - The steel anchor, plate, washer, and nut shall be fusion bonded epoxy coated according to ASTM 775 prior to shipment. Epoxy patch kits which will allow final coating of exposed steel surfaces must also be provided.
 - Any deviation of the manufacturer's recommended installation procedure must be brought to the immediate attention of the Engineer for approval.

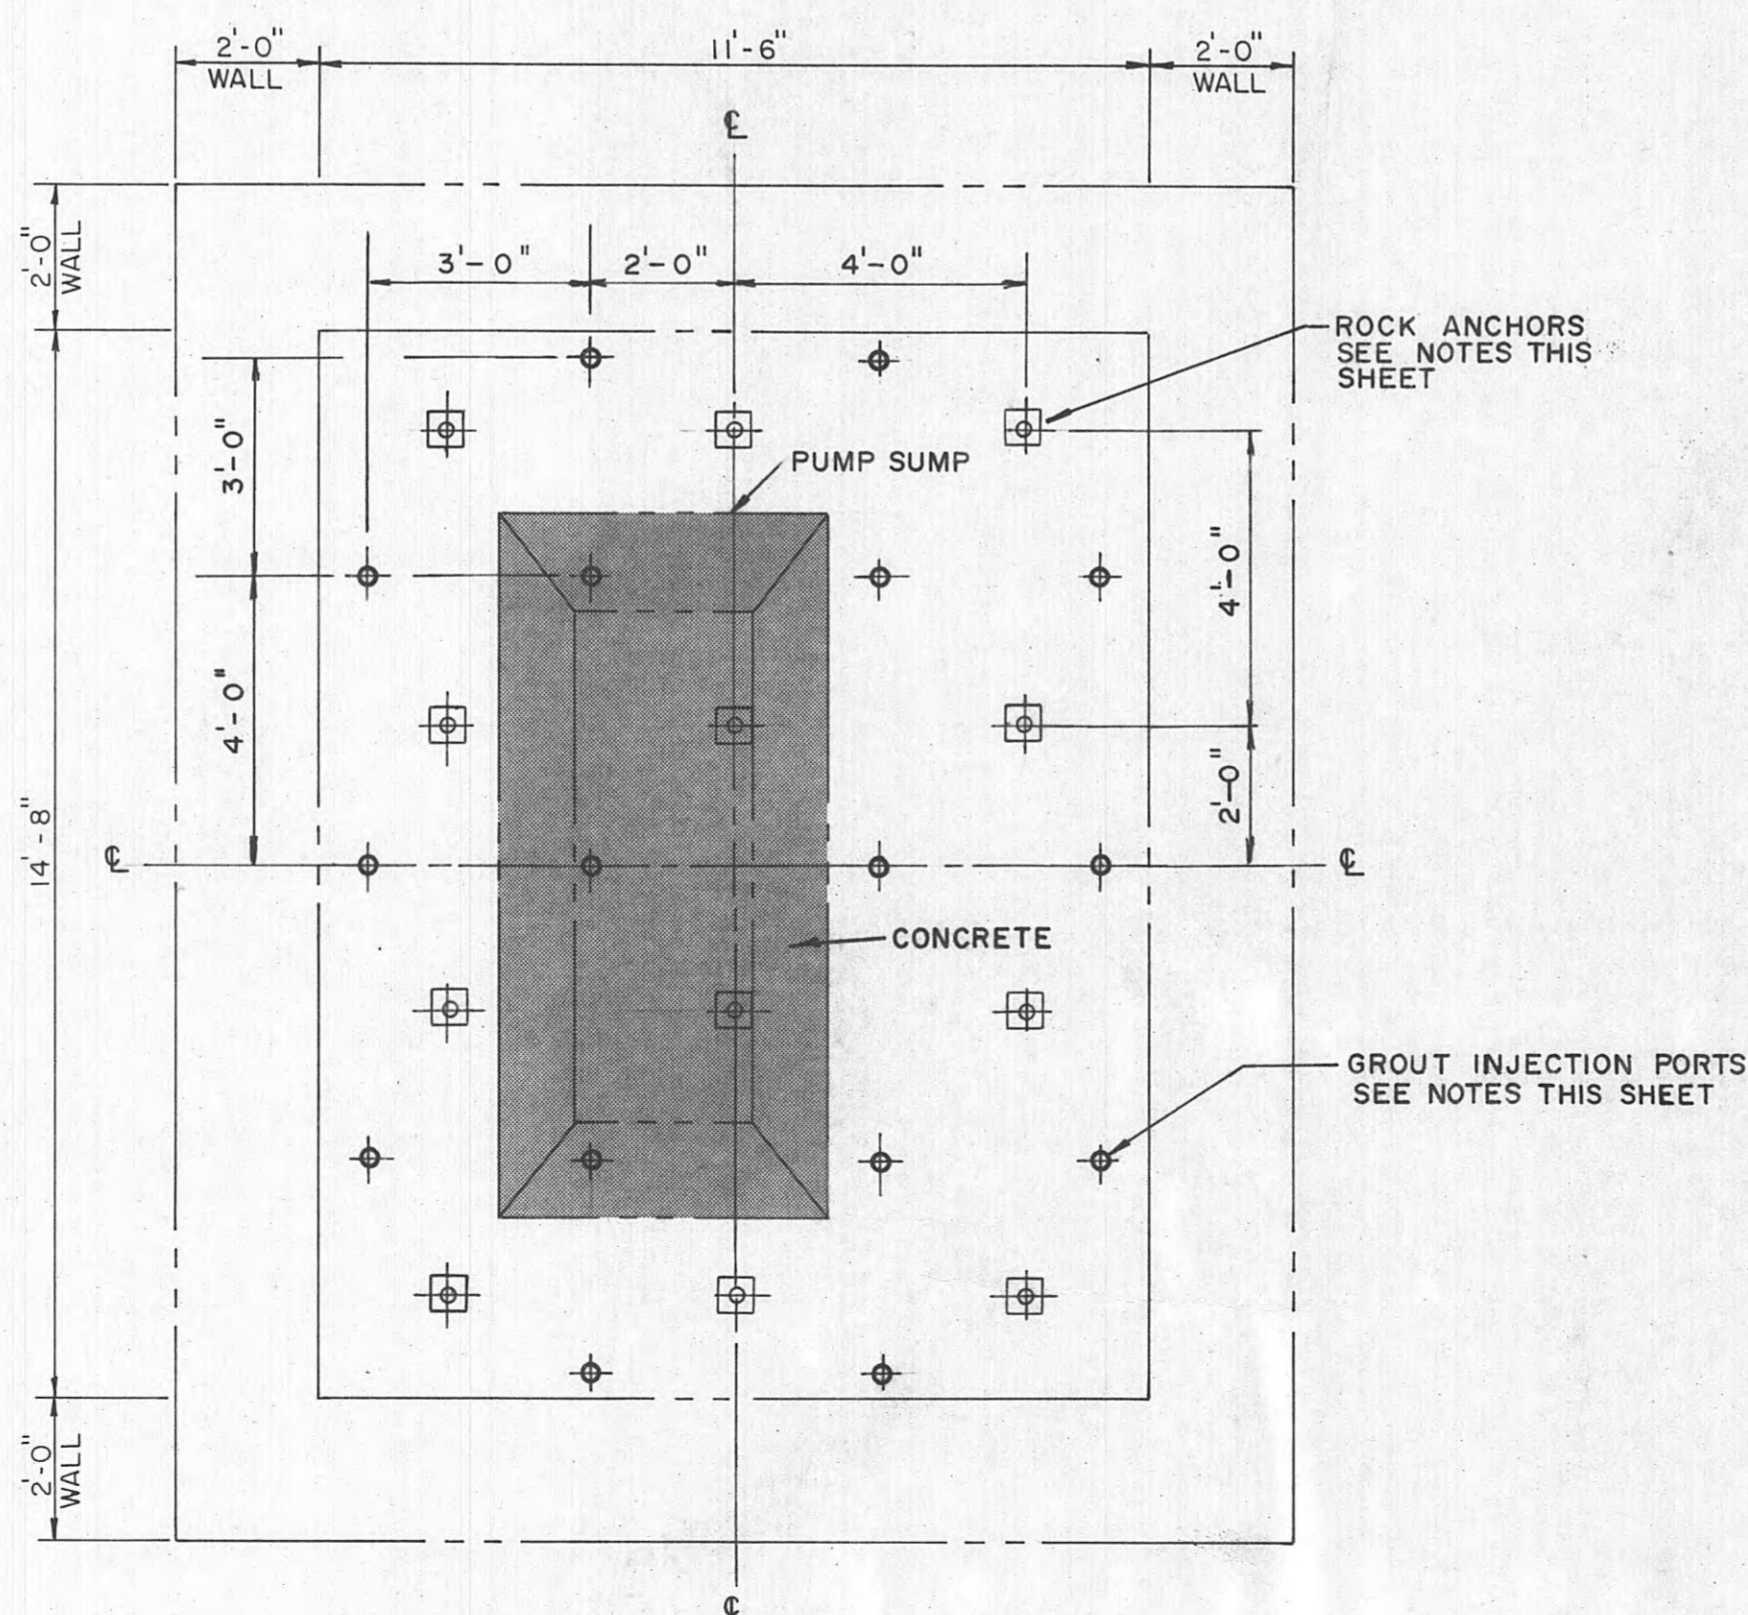

PLAN - BOTTOM ELEVATION 724.0
SCALE: 3/8" = 1'-0"

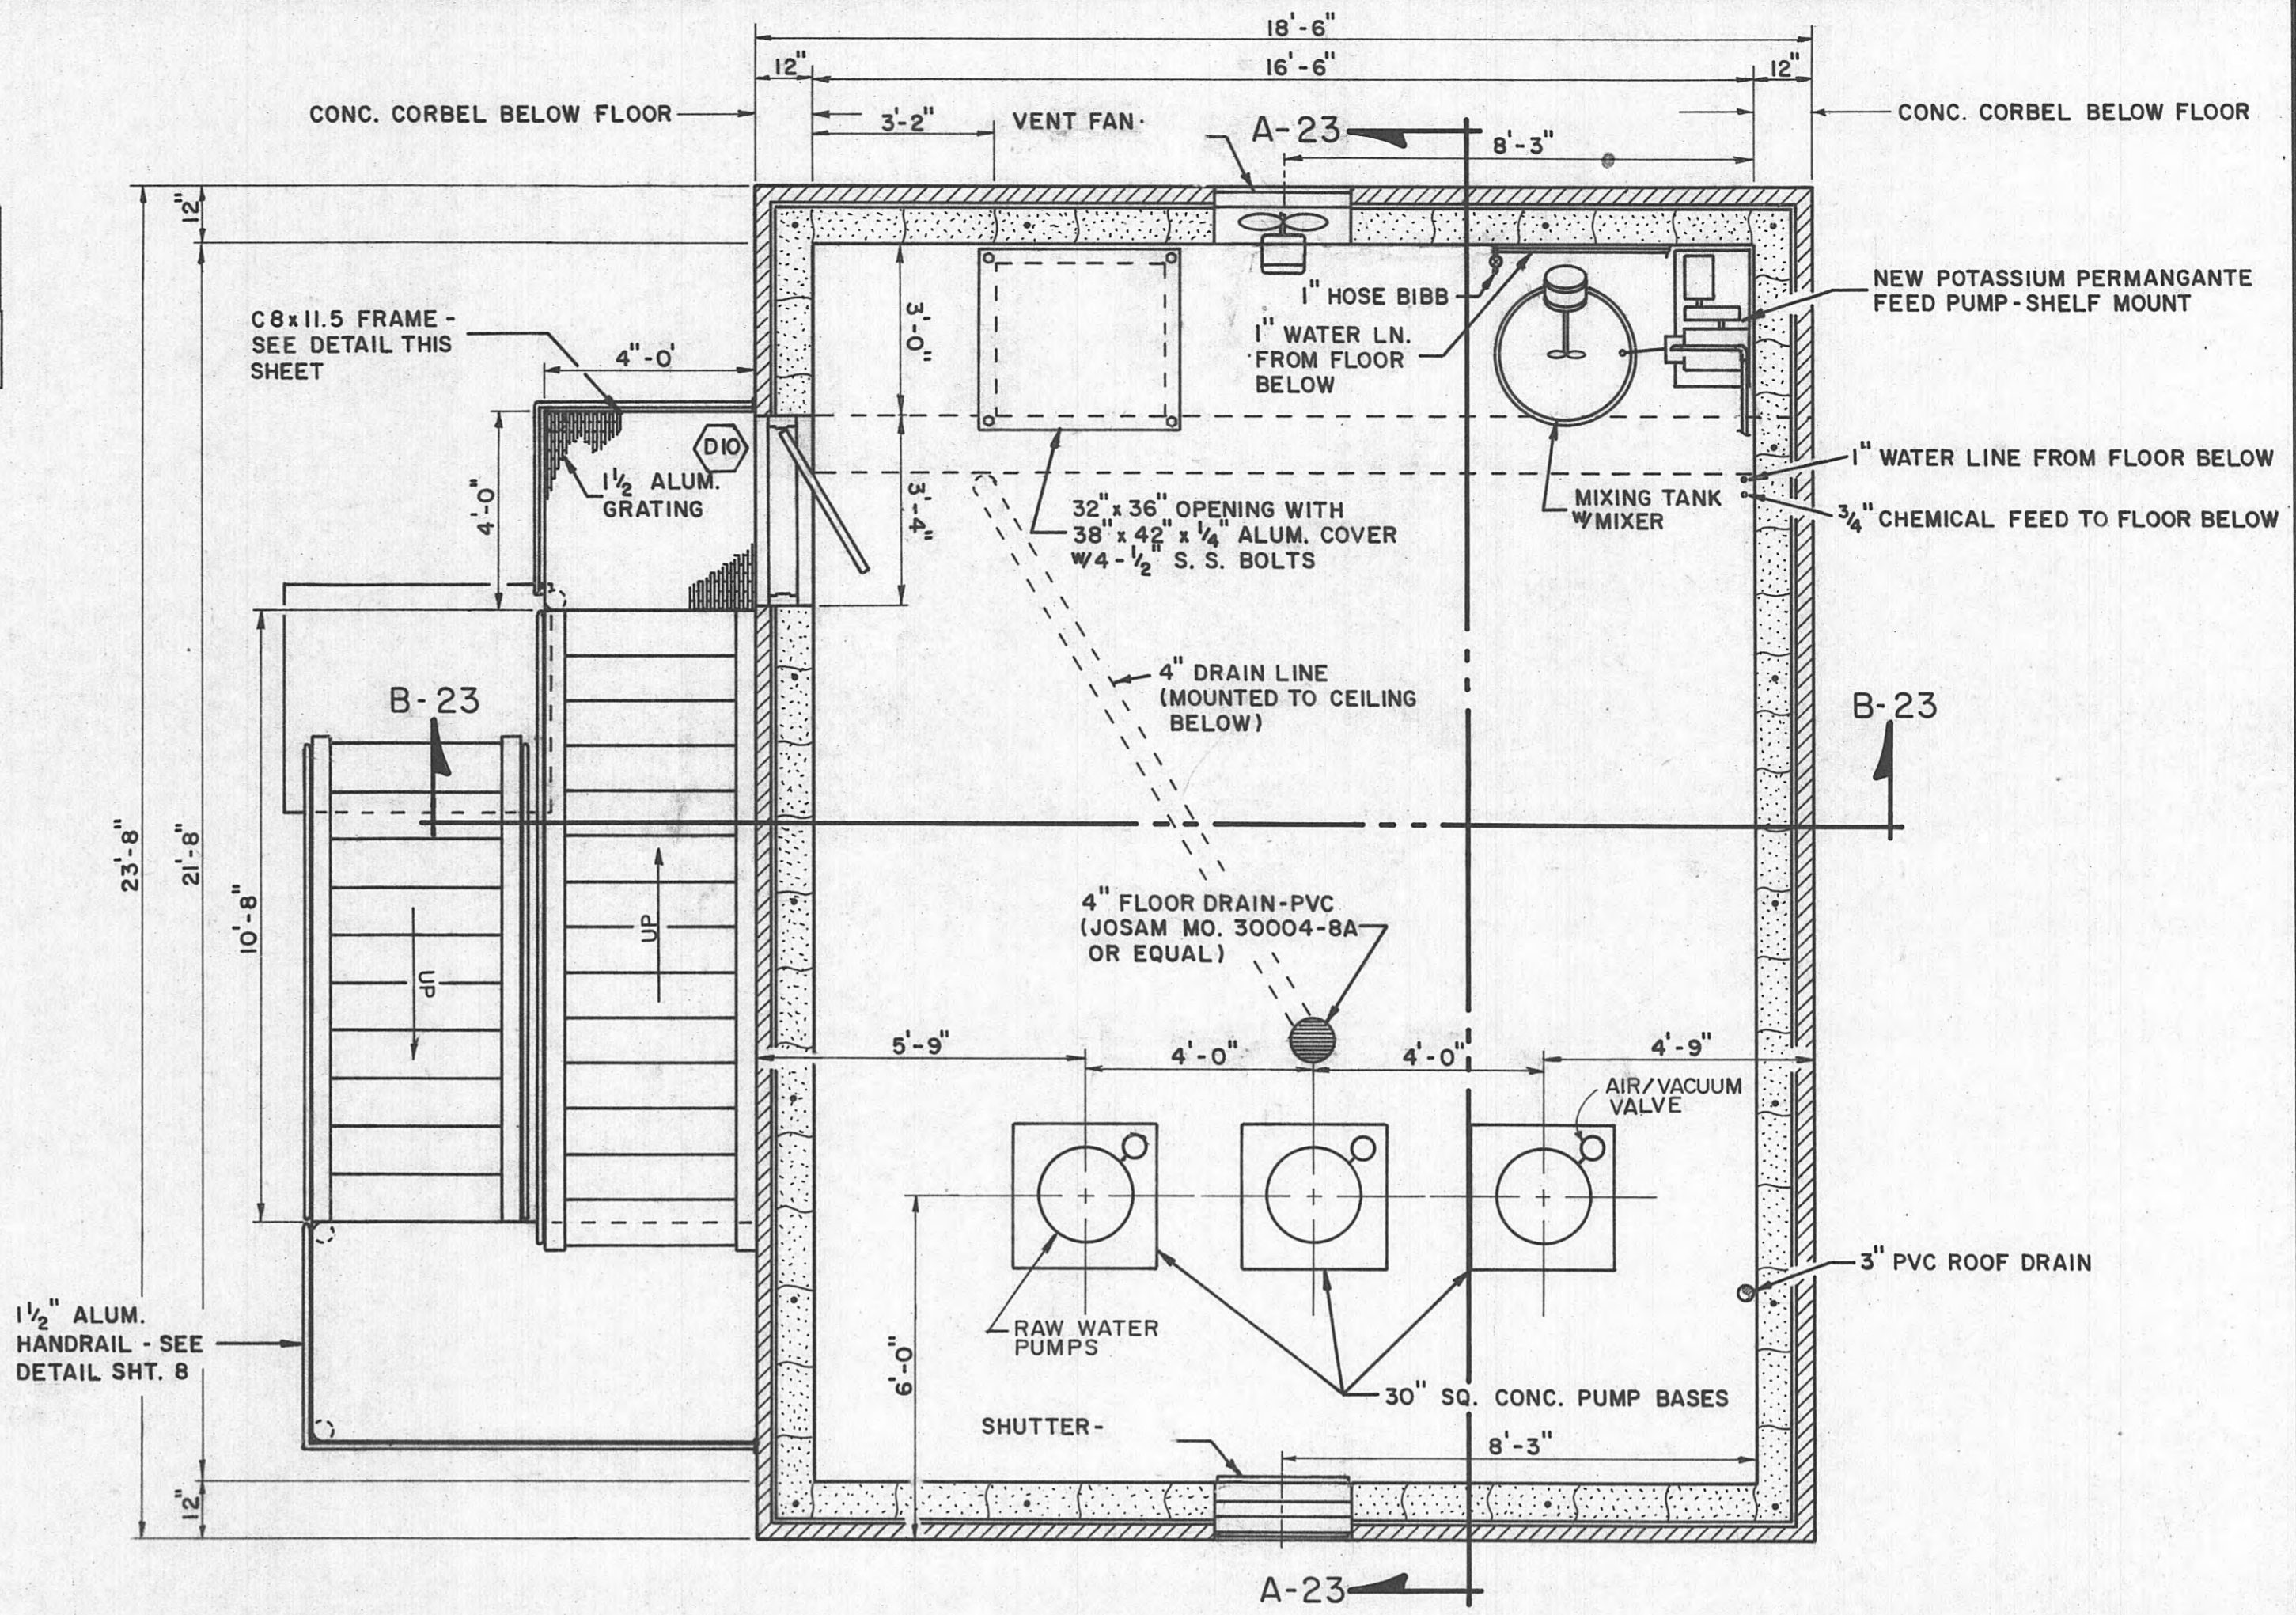

PLAN - FLOOR ELEVATION 778.06
SCALE: 3/8" = 1'-0"

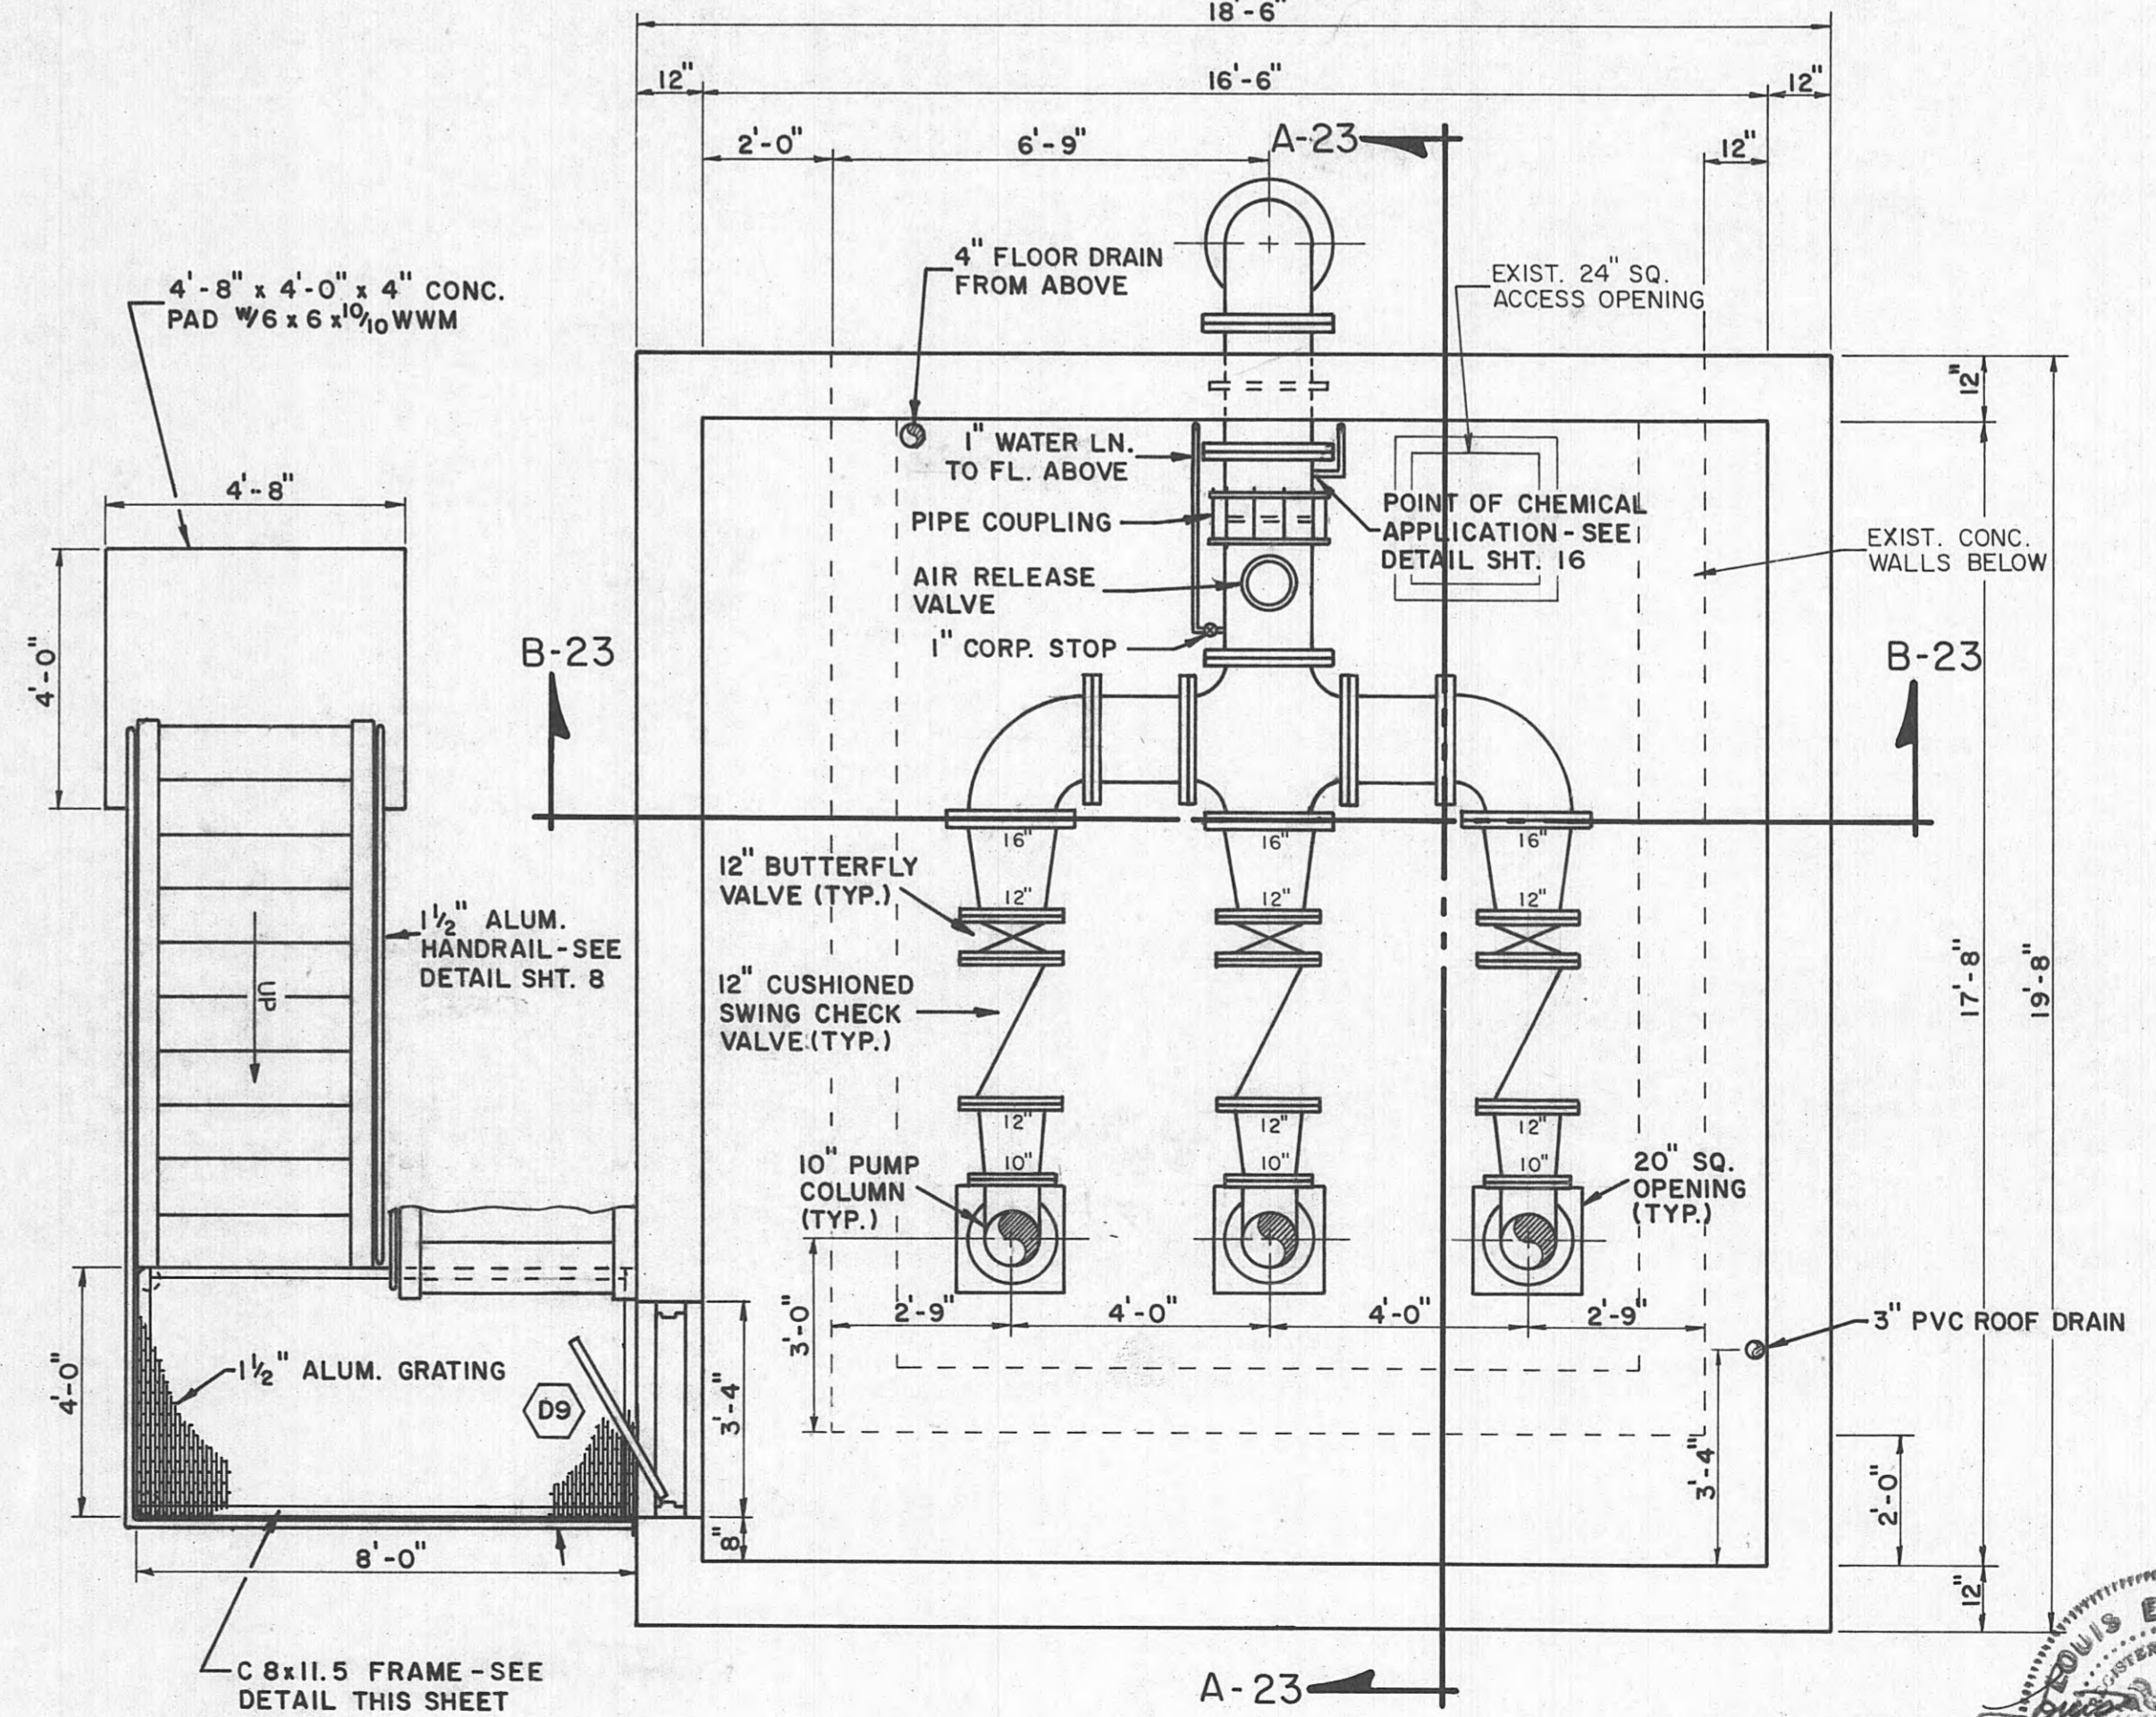


PLAN - FLOOR ELEVATION 768.35
SCALE: 3/8" = 1'-0"

AS BUILT
DATE: 3-20-95
APPROVED: DM



ELROD · DUNSON, INC.
CONSULTING ENGINEERS
NASHVILLE · KNOXVILLE
LEXINGTON, KY

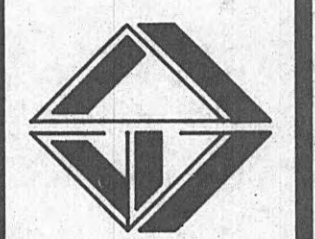

CONTRACT W93-04
HARRIMAN, TENNESSEE
RAW WATER PUMP BUILDING - PLAN AND DETAILS


REVISIONS

DESIGNED: L. E. R.
DRAWN: D. G. R., D. M.
CHECKED: L. E. R.
DATE: MARCH, 1993
SCALE: AS NOTED
PROJ. NO. 0592

SHEET 22
OF 36


PLAN	SURVEYED	DATE
	PLOTTED	
	ALIGNMENT CHECKED	
	STRUCTURE NOTATIONS CHECKED	
NOTE BOOK NO.		

PROFILE	SURVEYED	DATE
	PLOTTED	
	GRADES CHECKED	
	STRUCTURE NOTATIONS CHECKED	
NOTE BOOK NO.		

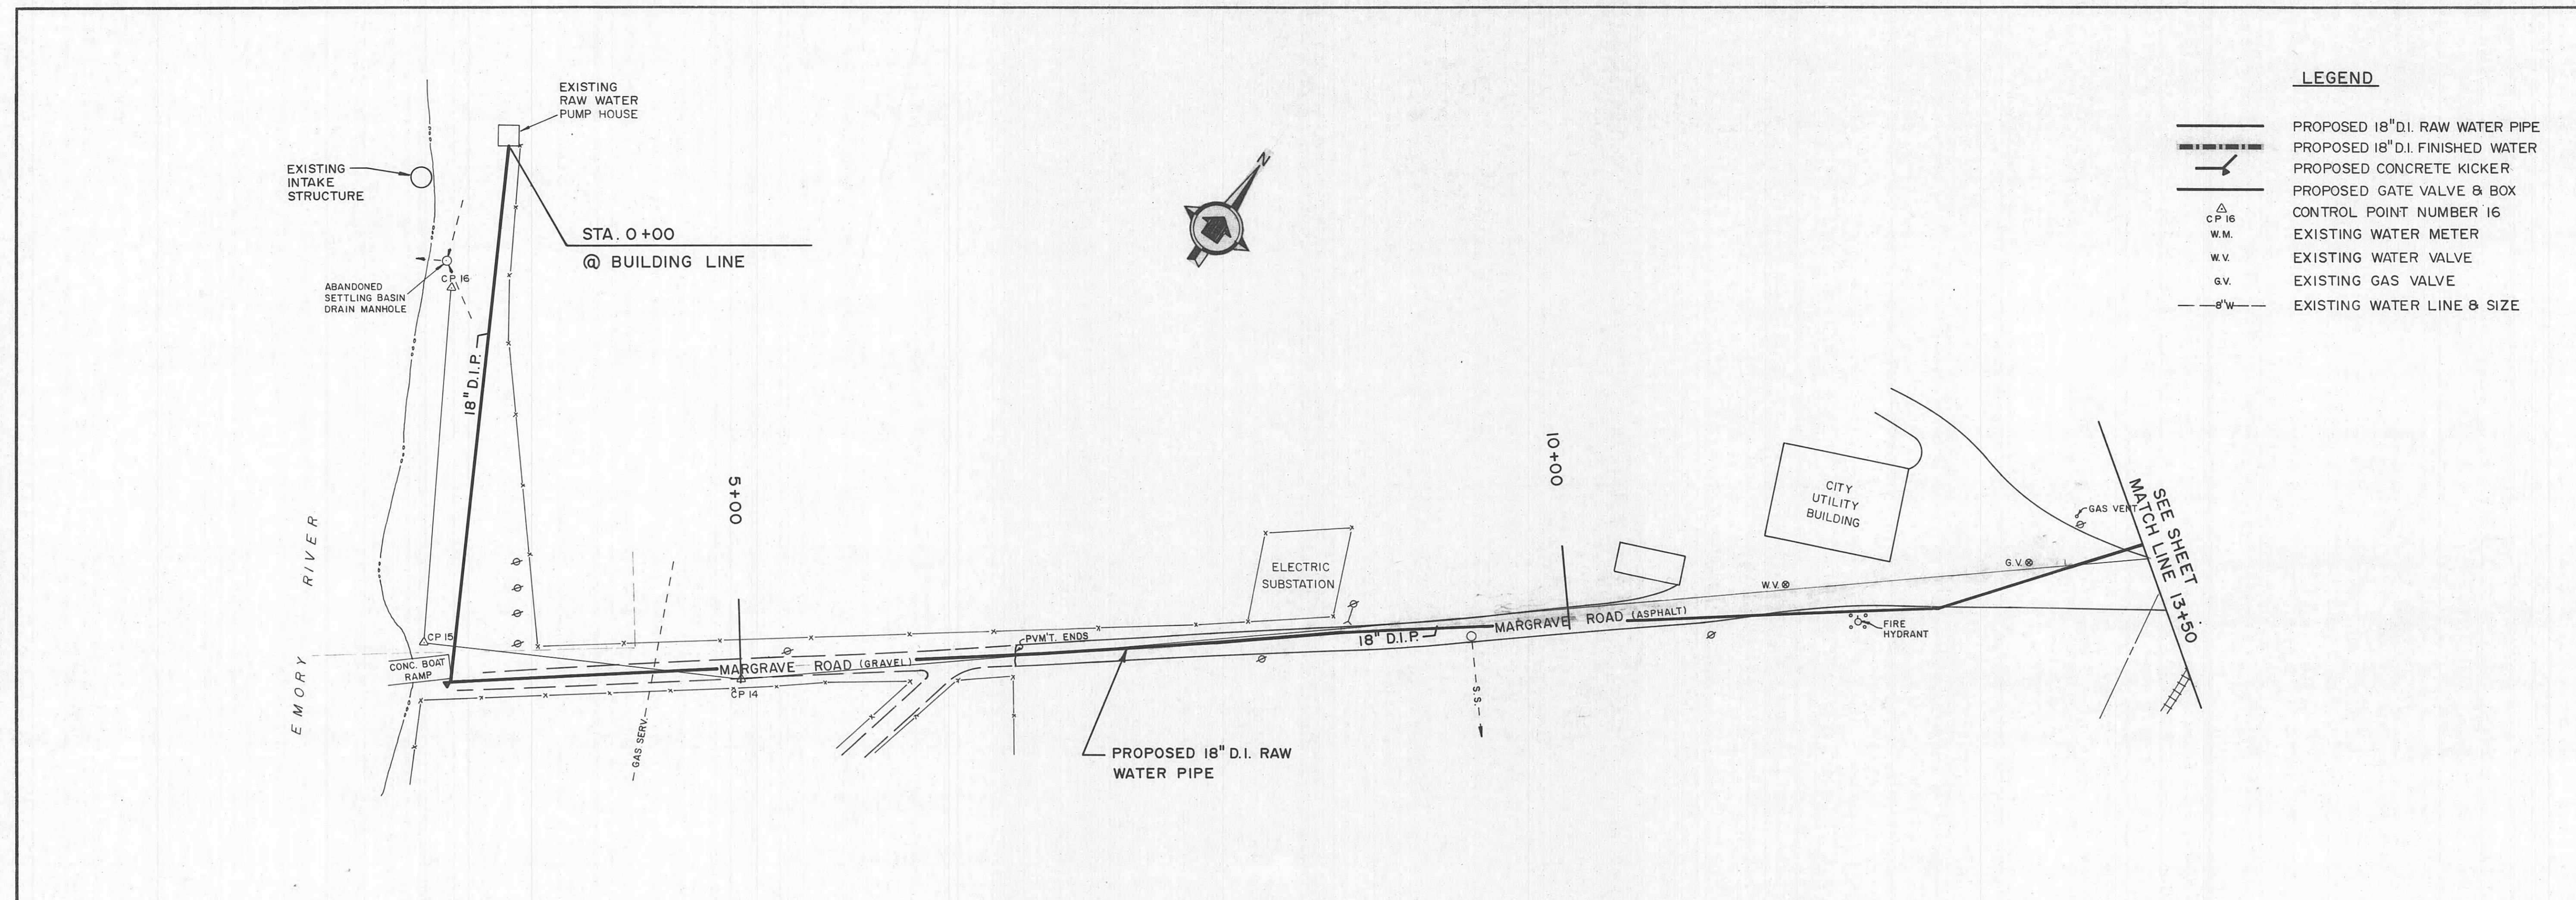


LEGEND


	PROPOSED 18" D.I. RAW WATER PIPE
	PROPOSED 18" D.I. FINISHED WATER PIPE
	PROPOSED CONCRETE KICKER
	PROPOSED GATE VALVE & BOX
	CONTROL POINT NUMBER 16
	EXISTING WATER METER
	EXISTING WATER VALVE
	EXISTING GAS VALVE
	EXISTING WATER LINE & SIZE

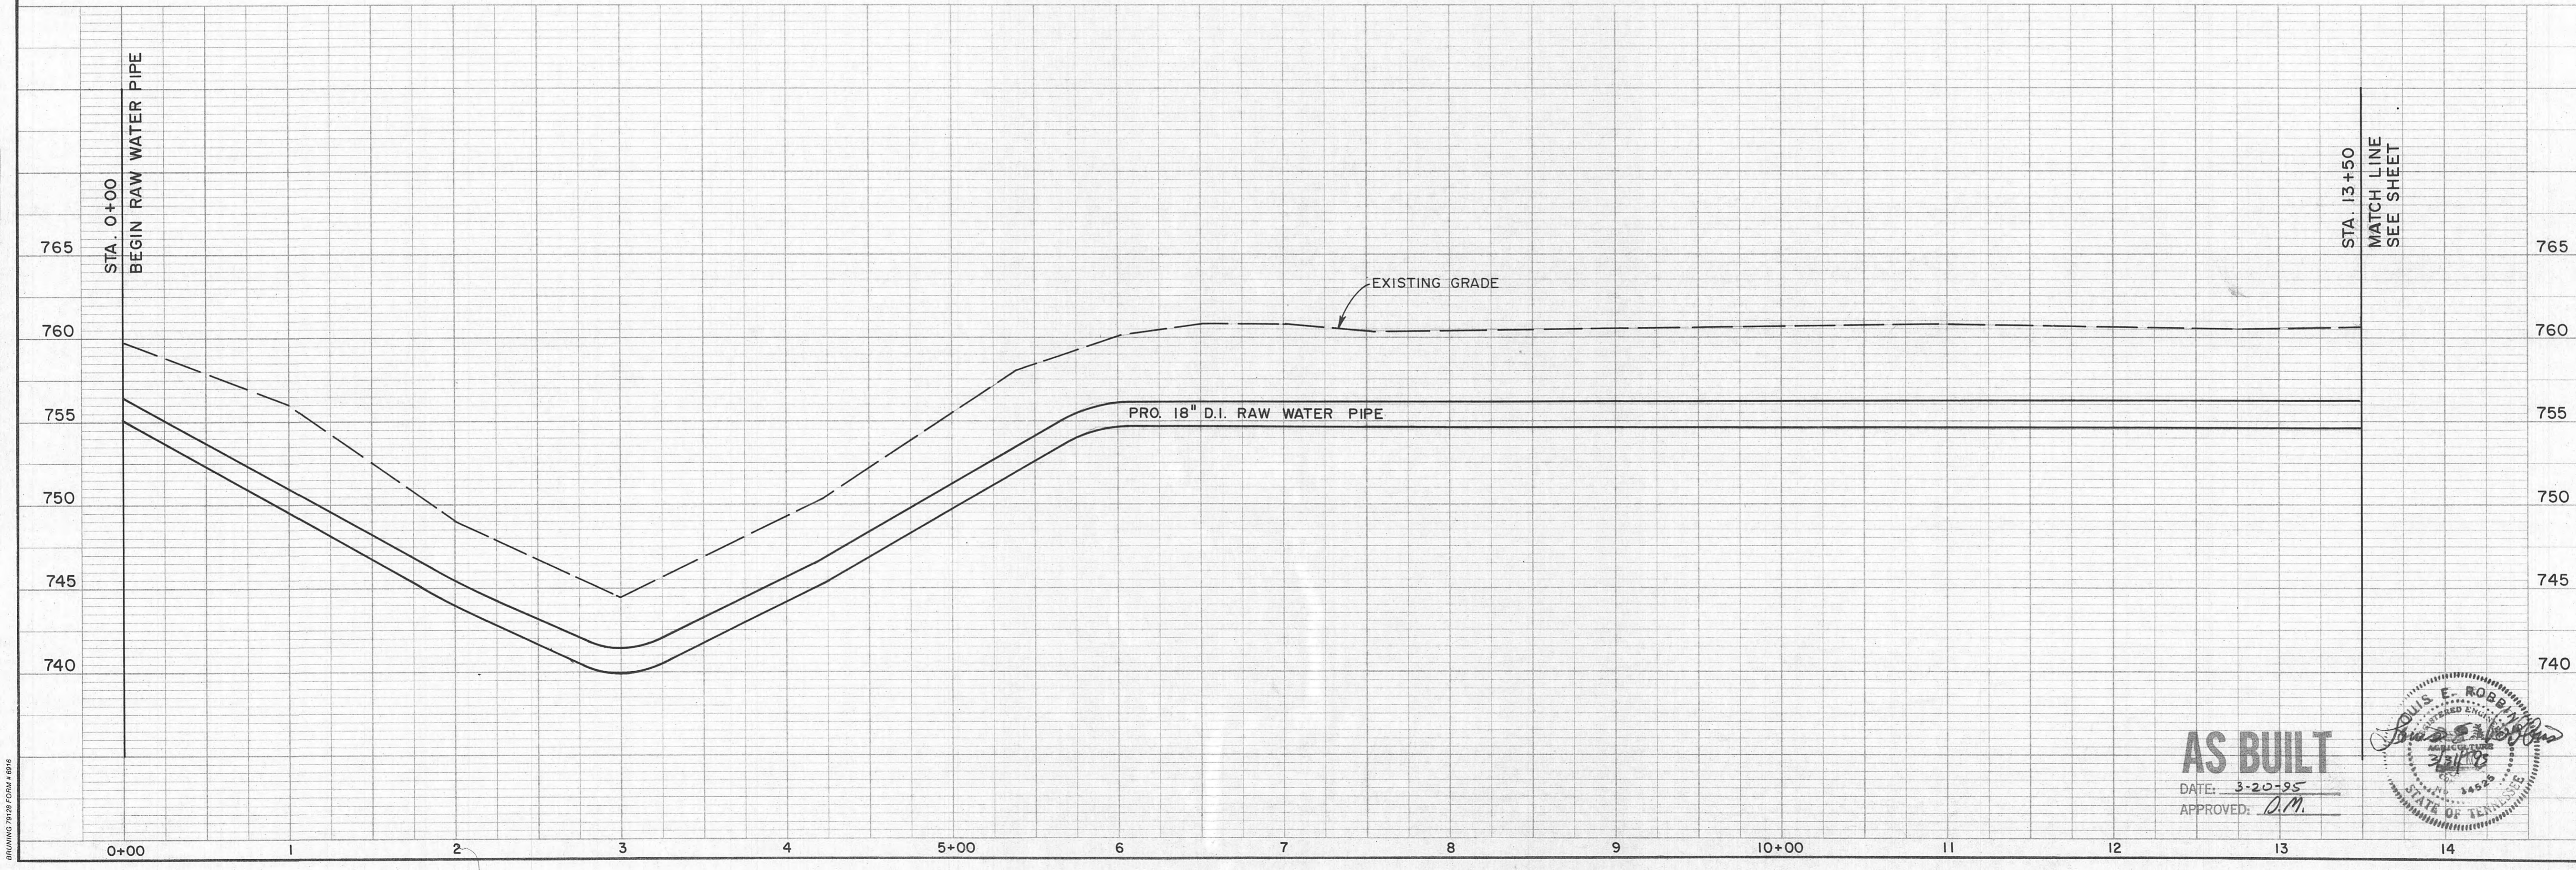

AS BUILT
 DATE: 3-20-95
 APPROVED: *D.M.*

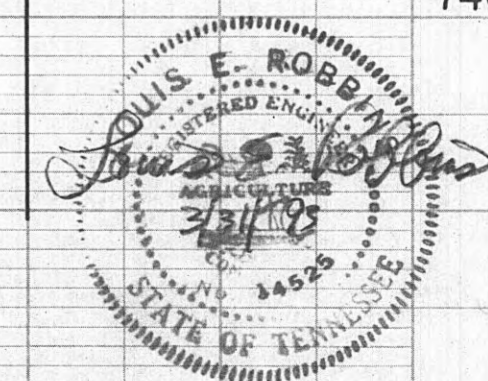

ELROD · DUNSON, INC.
 CONSULTING ENGINEERS
 NASHVILLE · KNOXVILLE
 LEXINGTON, KY

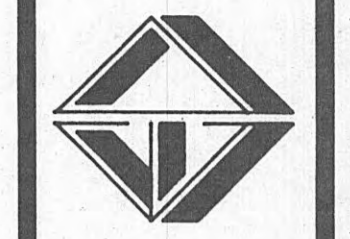

HARRIMAN, TENNESSEE
 CONTRACT W93-04
18" RAW WATER PIPE - STA. 0+00 TO 13+50

REVISIONS


DESIGNED: L. E. R.
 DRAWN: D. M.
 CHECKED: L. E. R.
 DATE: MARCH, 1993
 SCALE: HORZ. 1" = 50'
 VERT. 1" = 5'
 PROJ. NO.

SHEET 24

OF 36


DATE	
BY	
PLAN	
SURVEYED	ALIGNED
PLOTTED	CHECKED
NOTE BOOK	ST. OF WAY CHECKED
NO.	STRUCTURE NOTATIONS CHKD.

DATE	
BY	
PROFILE	
SURVEYED	GRADES CHECKED
PLOTTED	CHECKED
NOTE BOOK	STRUCTURE NOTATIONS CHKD.
NO.	

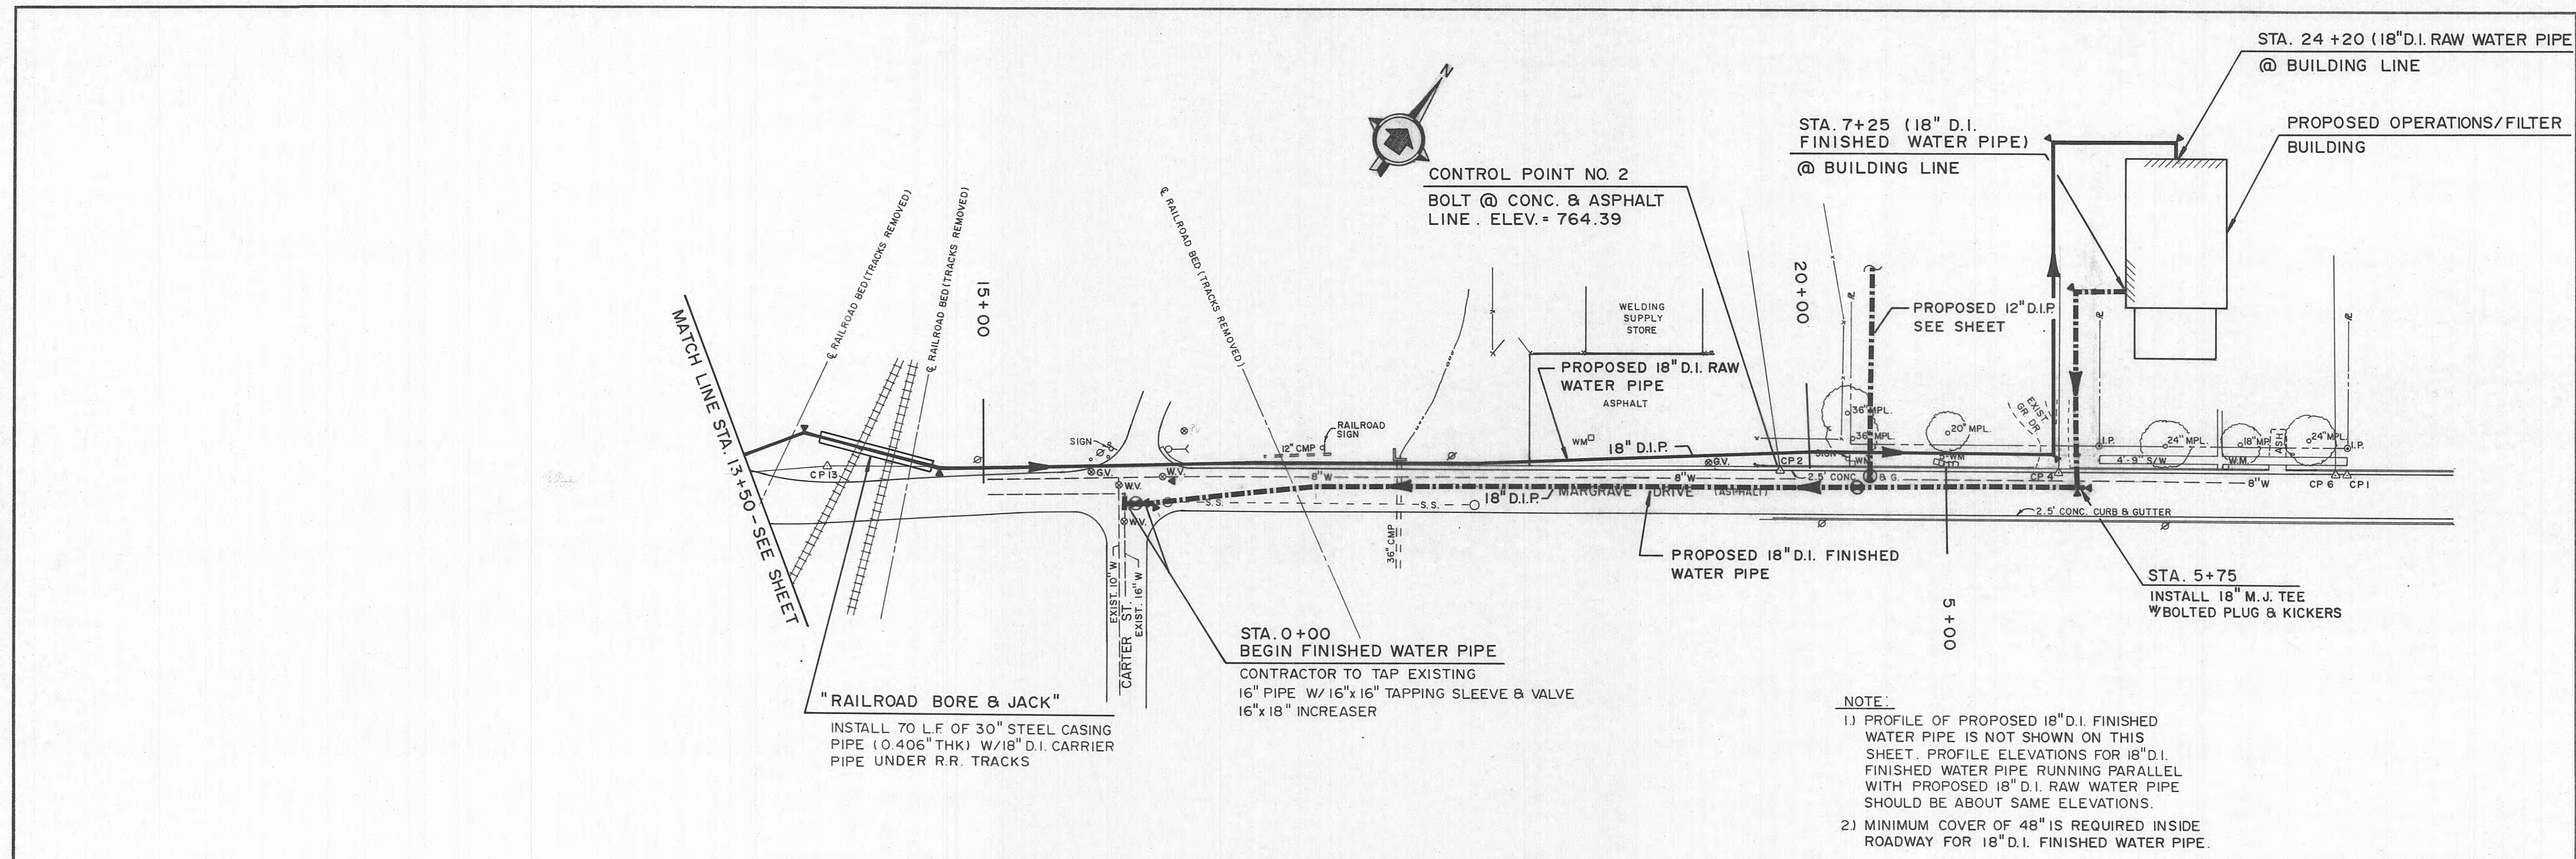


NOTE:


- 1) PROFILE OF PROPOSED 18" D.I. FINISHED WATER PIPE IS NOT SHOWN ON THIS SHEET. PROFILE ELEVATIONS FOR 18" D.I. FINISHED WATER PIPE RUNNING PARALLEL WITH PROPOSED 18" D.I. RAW WATER PIPE SHOULD BE ABOUT SAME ELEVATIONS.
- 2) MINIMUM COVER OF 48" IS REQUIRED INSIDE ROADWAY FOR 18" D.I. FINISHED WATER PIPE.

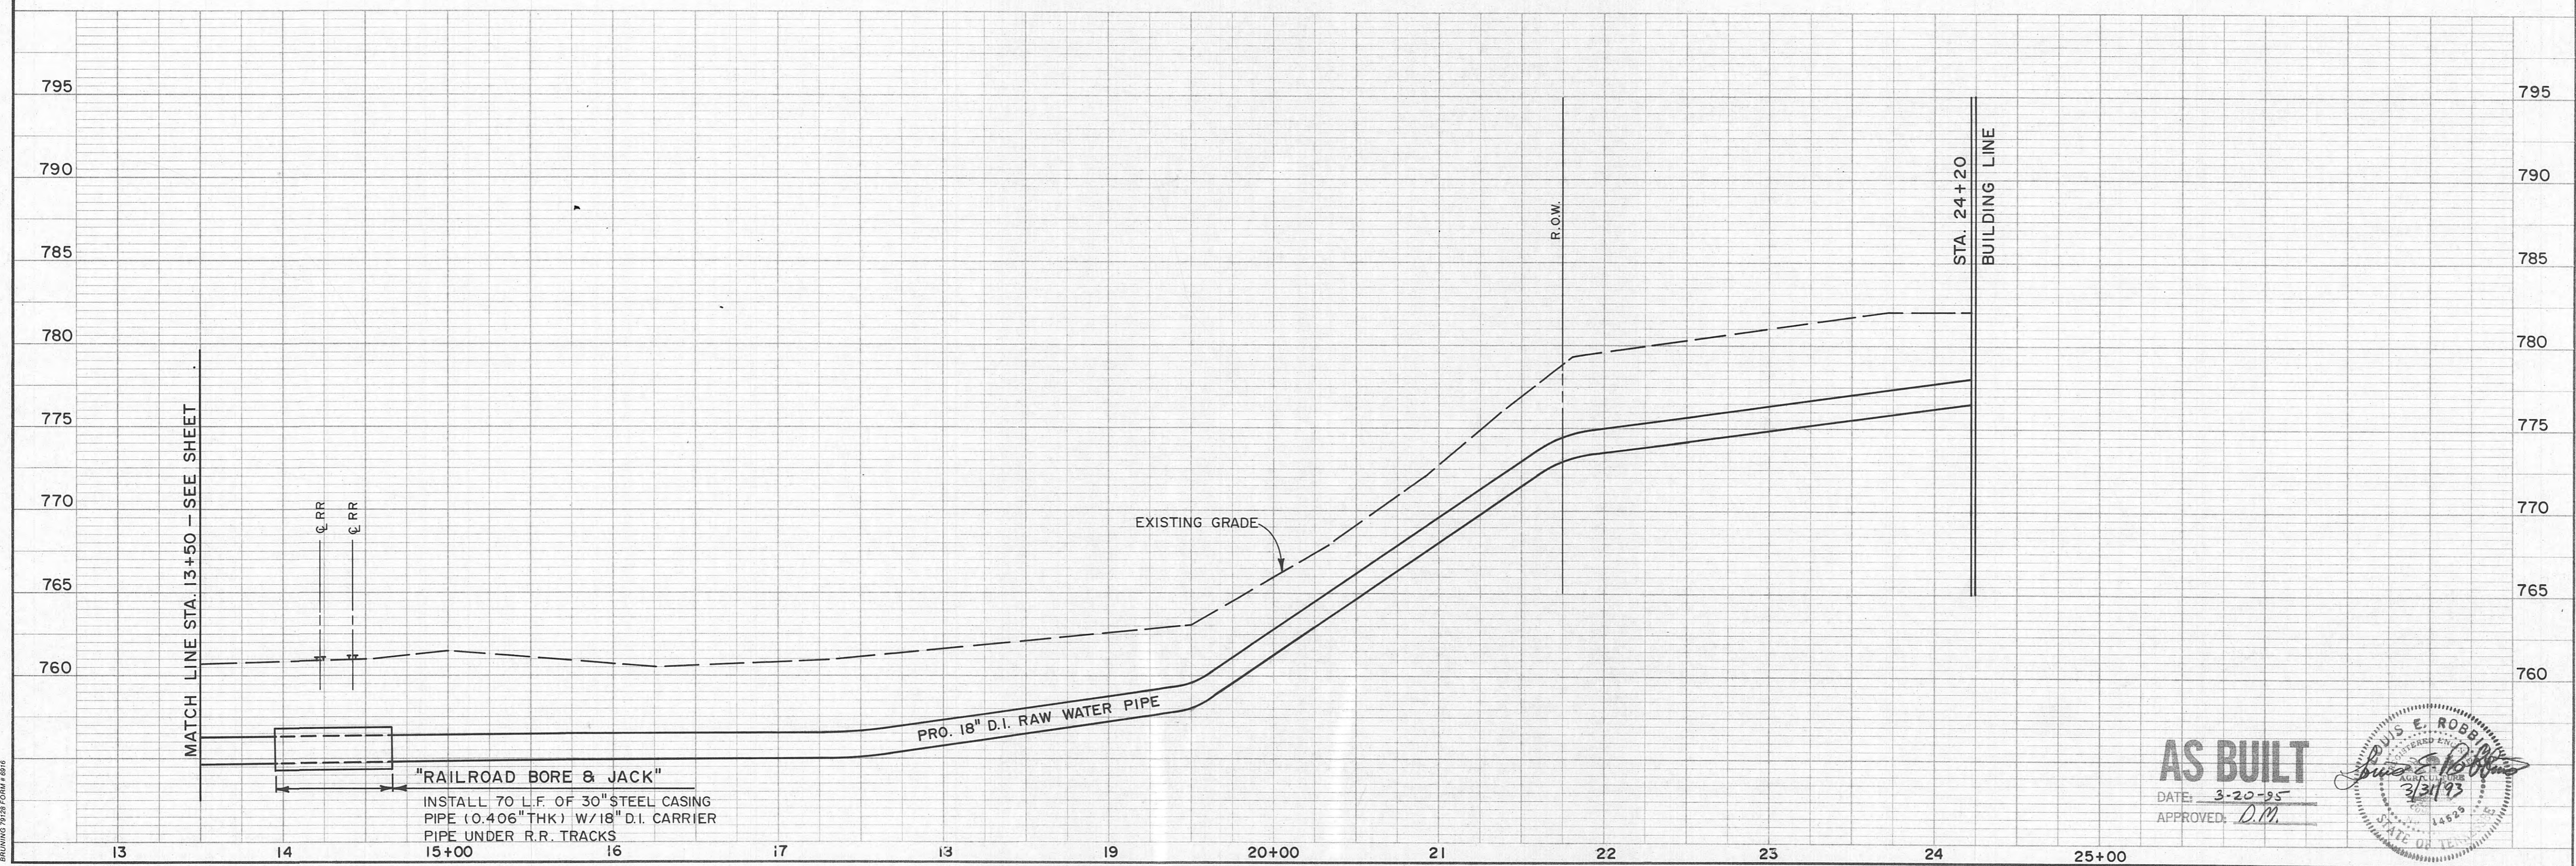

AS BUILT
 DATE: 3-20-95
 APPROVED: D.M.

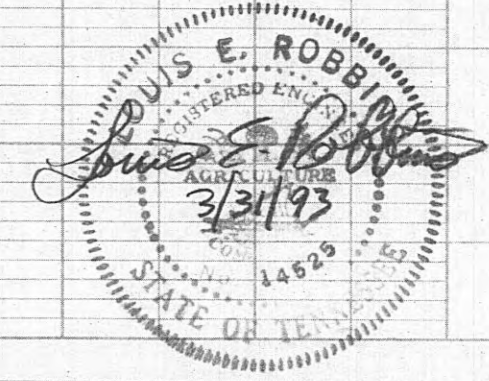

ELROD · DUNSON, INC.
 CONSULTING ENGINEERS
 NASHVILLE · KNOXVILLE
 LEXINGTON, KY

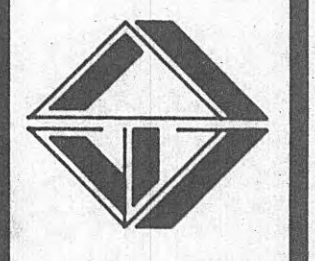

CONTRACT W93-04
 HARRIMAN, TENNESSEE
 18" RAW WATER PIPE - STA. 13+50 TO 24+20
 18" FINISHED WATER PIPE - STA. 0+00 TO 7+25

REVISIONS



DESIGNED: L. E. R.
 DRAWN: D. M.
 CHECKED: L. E. R.
 DATE: MARCH, 1993
 SCALE: HORZ. 1" = 50'
 VERT. 1" = 5'
 PROJ. NO. 0592

SHEET 25

OF 36

LIGHTING FIXTURE SCHEDULE						
TYPE	MANUFACTURER & CATALOGUE NO.	MTG	LAMPS QTY/TYP	TOTAL WATTS	REMARKS	
A	LITHONIA TXL 250M A20 0 LC5P	PENDANT	250W MH COATED	290	LOW BAY	
B	LITHONIA TWH 250S 120V PE	WALL	250W HPS	290	FLOOD LIGHT	
C	LITHONIA TWH 150S 120V PE	WALL	150W HPS	190	FLOOD LIGHT	
D	LITHONIA C240 120V	SURFACE	2 - F40	85	STRIP	
E	LITHONIA 6ELM2 120V	WALL	-	15	EGRESS LIGHT W/BATTERY PACK	
E1	LITHONIA ELU2P 120V	WALL	-	16	EGRESS LIGHT W/BATTERY PACK	
F	LITHONIA 2GT 440A 120V	RECESSED	4 - F40	175	2' X 4'	
G	LITHONIA 2GT 240A 120V	RECESSED	2 - F40	85	2' X 4'	
H	LITHONIA 8TC 240 120V	SURFACE	4 - F40	175	TANDEM WIRED STRIP	
I	LITHONIA DMW 240 A 120V WLF	SURFACE	2 - F40	85	DUST/WET LOCATION	
J	HAZLITE XIM 15 12G C2	SURFACE	150W 1P	150	CLASS I DIVISION I	
K	LITHONIA C 240 120V 0°	SURFACE	2 - F40	85	STRIP WITH 0° BALLAST	
L	LITHONIA TWH 150S 120V PE	WALL	150W HPS	190	FLOOD LIGHT W/PHOTOELECTRIC	
X	LITHONIA QMSWR 120V EL	SURFACE	-	30	EXIT W/BATTERY PACK	
X1	LITHONIA XSWIREL 120V	SURFACE	-	30	EXIT W/BATTERY PACK	

LEGEND	
ALL SYMBOLS MAY NOT BE USED	
□	2' X 4' - 4L OR 3L-RECESSED FLUOR.
□	2' X 4' - 2L-RECESSED FLUORESCENT
□	2L, 3L OR 4L SURFACE FLUORESCENT
—	FLUORESCENT STRIP FIXTURE
○	RECESSED FIXTURE
○	SURFACE MOUNTED FIXTURE
○	WALL BRACKET FIXTURE
○	EXIT SIGN WITH 1 FACE
○	EXIT SIGN WITH 2 FACES
○	FLOOD OR SPOT LIGHT
○	TRACK LIGHTS WITH FITTINGS: NUMBER OF HEADS AS SHOWN
○	EGRESS LIGHTING
○	ISOLATED GROUND TYPE DUPLEX OUTLET 15A MTD. AT 15" AFF UON
○	DUPLEX OUTLET 15A AT 15" AFF UON
○	DUPLEX OUTLET - 1/2 SWITCHED AT 15" AFF UON
○	DUPLEX OUTLET - 20A MTD AT 15" AFF UON
○	QFI DUPLEX OUTLET - 15A AT 4" ABOVE COUNTER OR BACKSPASH UON
○	DUPLEX OUTLET - 15A AT 4" ABOVE COUNTER OR BACKSPASH
○	250V, SINGLE PHASE OUTLET - SIZE AS NOTED
○	DOUBLE DUPLEX - 15A AT 15" AFF UON
○	FLUSH FLOOR OUTLET - 15A
○	CLOCK OUTLET MTD. AT 7'-0" AFF UON
○	THERMOSTAT - 1/2" C.O. TO UNIT NOTED
○	EXHAUST FAN
○	MOTOR OUTLET
○	SPEAKER OUTLET
○	TV OUTLET
○	TELEPHONE OUTLET - WALL MTD., 3/4" C.O. INTO ACCESSIBLE CEILING SPACE UON
○	TELEPHONE FLOOR OUTLET
○	CRT OR COMPUTER OUTLET - 3/4" C.O. INTO ACCESSIBLE CEILING SPACE UON
○	PUSH BUTTON
○	SWITCH - SINGLE POLE 120V OR 277V 48" MAXIMUM AFF - PLUS MTD
○	S2 - TWO POLE
○	S3 - THREE WAY
○	S4 - FOUR WAY
○	SP - PILOT LIGHT
○	ST - TIMER
○	SK - KEY OPERATED
○	SM - MANUAL MOTOR STARTER W/THERMAL
○	SD - DIMMER
○	DISCONNECT SWITCH
○	MAGNETIC MOTOR STARTER
○	COMBINATION STARTER
○	FIRE ALARM HORN/LIGHT COMBO
○	FIRE ALARM PULL STATION
○	BELL
○	SMOKE DETECTOR
○	DUCT TYPE SMOKE DETECTOR
○	FIRE ALARM FLASHING LIGHT
○	MAGNETIC DOOR HOLDER
○	TAMPER SWITCH
○	FLOW SWITCH
○	JUNCTION BOX - SIZE AS REQUIRED
○	TELEPHONE SKED - 3/4" PLYWOOD
○	DISTRIBUTION BOARD
○	SURFACE MTD PANEL
○	RECESSED PANEL
○	DEMOTES DETAIL "A", SHEET E-1
○	CONDUIT CONCEALED ABOVE CLG OR IN WALL
○	CONDUIT UNDER SLAB OR BELOW GRADE
○	CONDUIT RUN EXPOSED
○	FLEX CONDUIT
○	STUB UP
○	STUB DOWN
○	HORNER, NO. OF HASH MARKS INDICATE NO. OF CONDUCTORS IF MORE THAN TWO
○	AFB - ABOVE FINISHED GRADE
○	APF - ABOVE FINISHED FLOOR
○	NL - NIGHT LIGHT
○	EWC - ELECTRIC WATER COOLER
○	WP - WEATHERPROOF - NEMA 3R
○	CO - CONDUIT ONLY - WITH PULL WIRE
○	GFI - GROUND FAULT INTERRUPTOR
○	IG - ISOLATED GROUND
○	UON - UNLESS OTHERWISE NOTED
○	F.A.P. - FIRE ALARM PANEL
○	N.O. - NORMALLY OPEN
○	N.C. - NORMALLY CLOSED
○	① - REFERENCE TO ELECTRICAL NOTES SAME SHEET

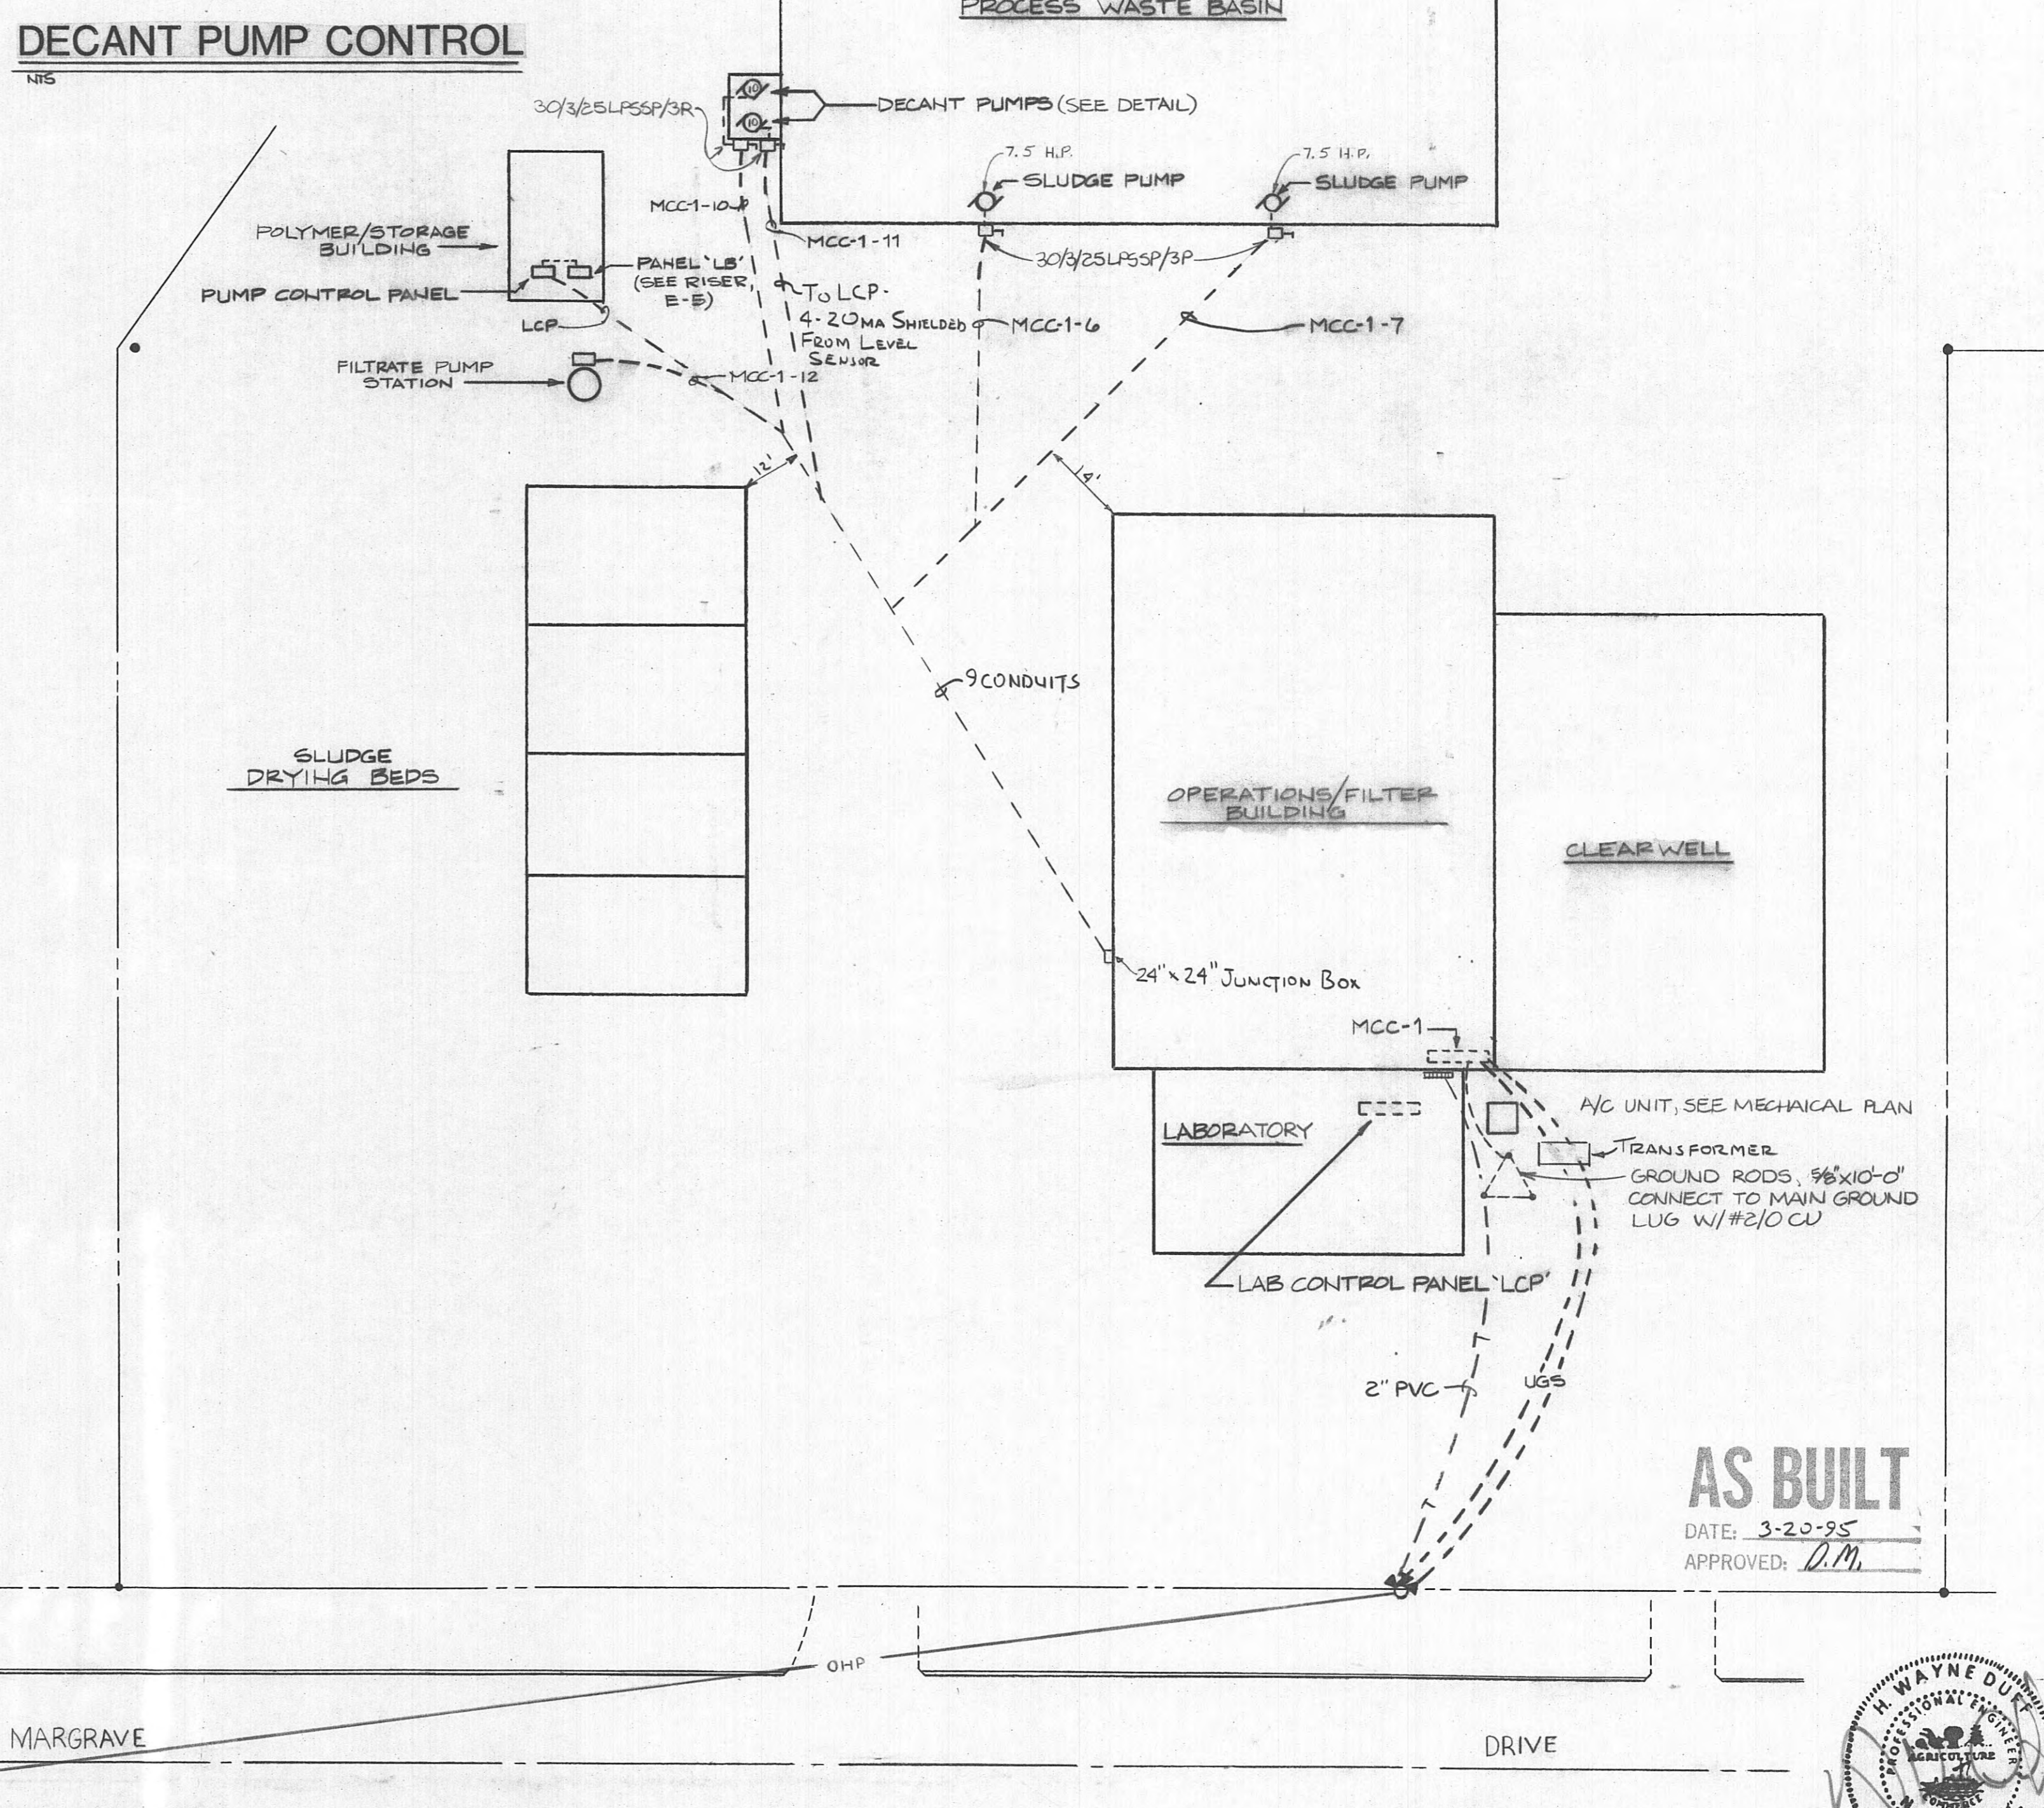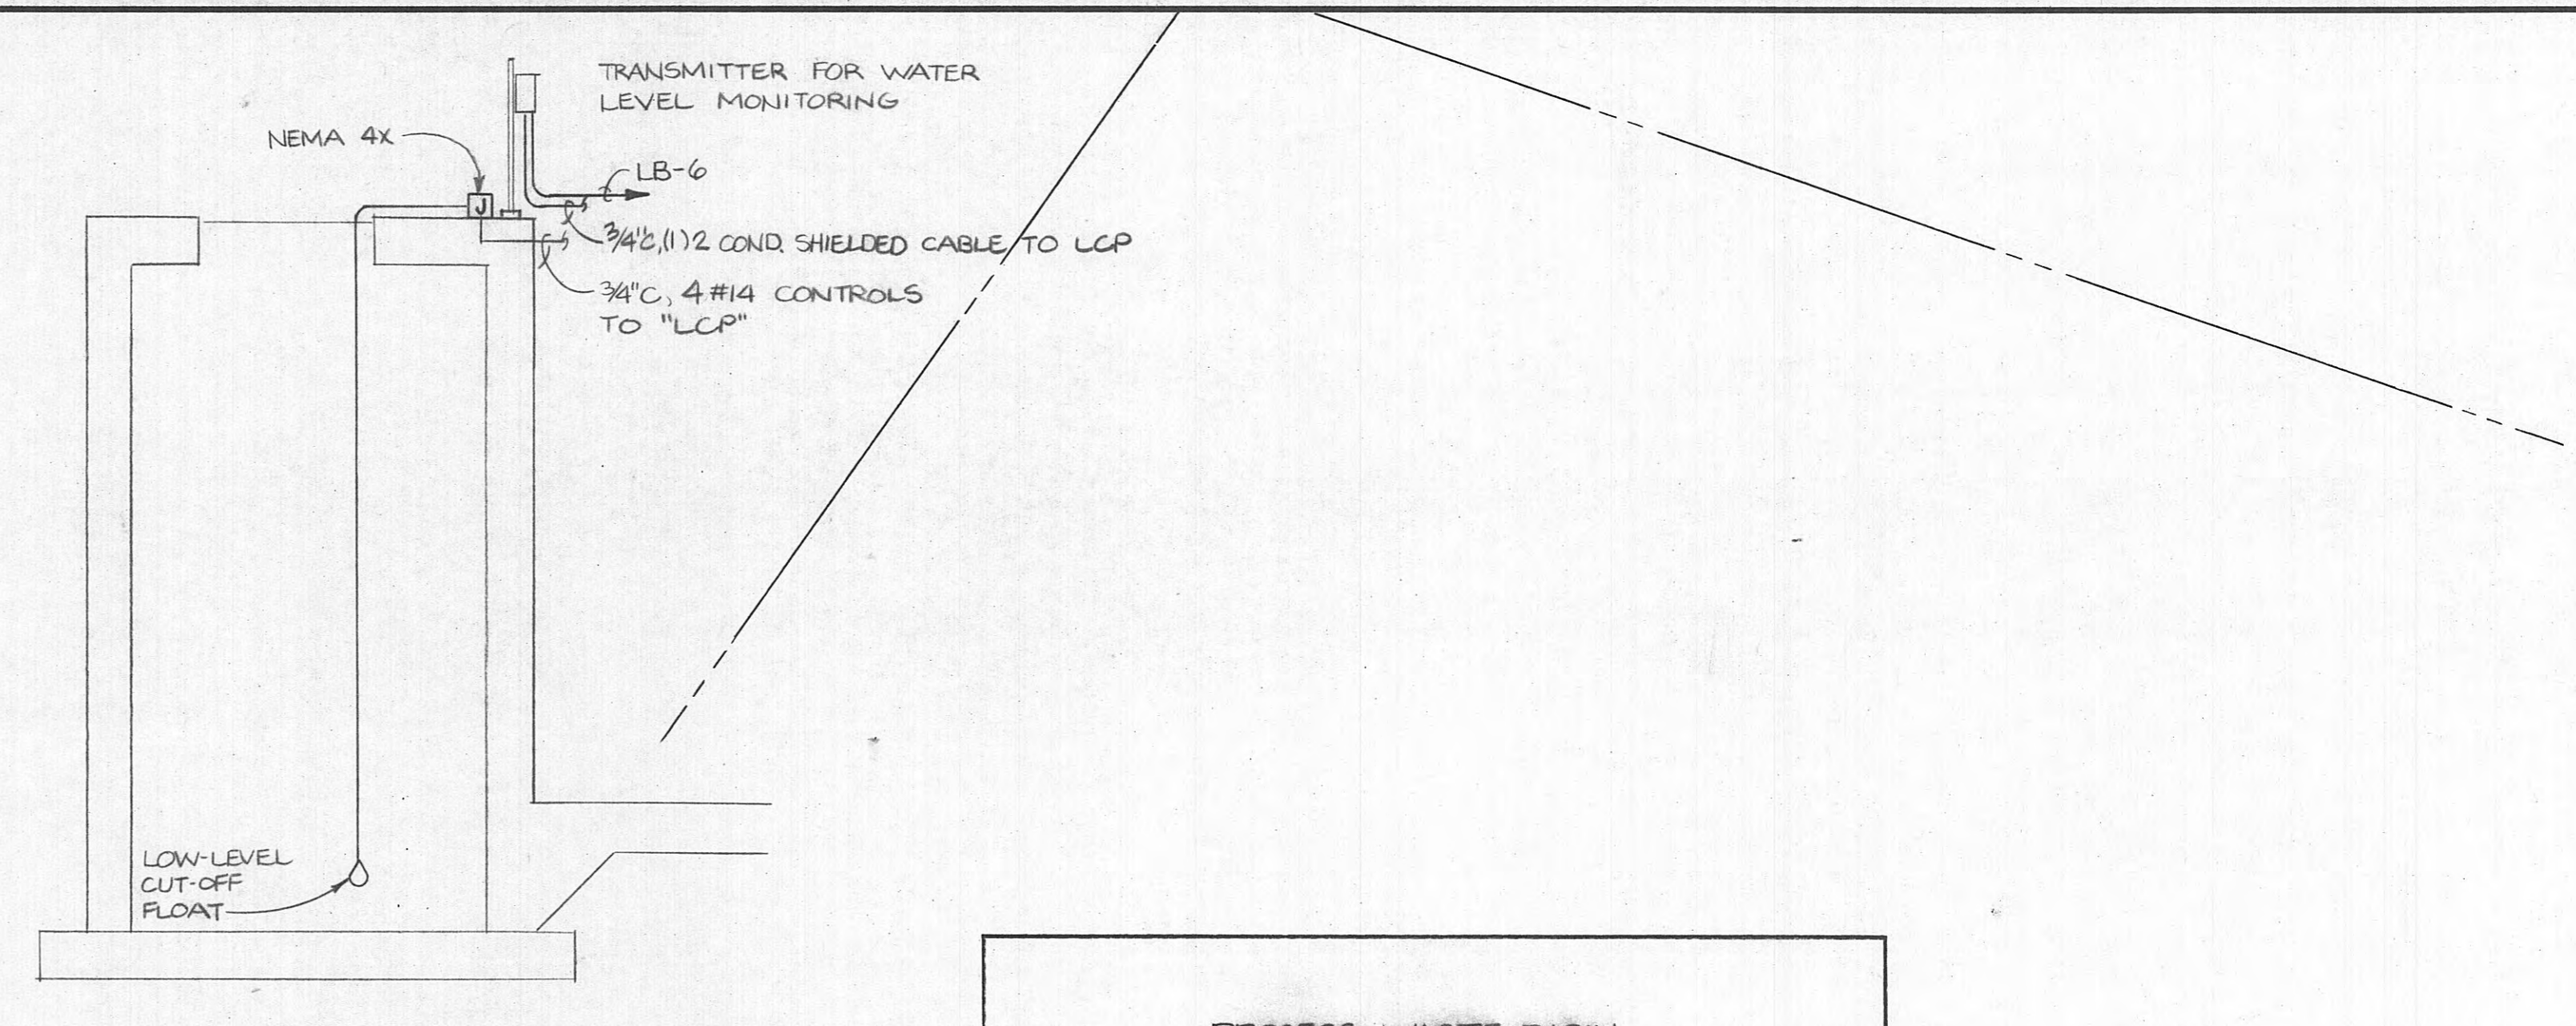


AS BUILT
 DATE: 3-20-95
 APPROVED: *D.M.*

MARGRAVE DRIVE
 EXISTING POWER POLE

ELECTRICAL SITE PLAN
 SCALE: 1" = 20'-0"

93072
DUFF BROWN
 ENGINEERING INC.
 783 OLD HICKORY BLVD. BRENTWOOD, TN. 37027 (615) 377-3757
 93072

ELROD · DUNSON, INC.
 CONSULTING ENGINEERS
 NASHVILLE · KNOXVILLE
 LEXINGTON, KY

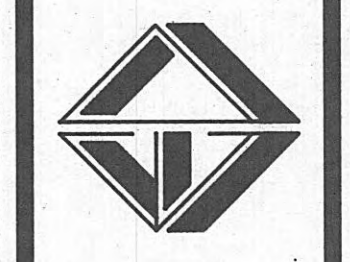


CONTRACT W63-04


HARRIMAN, TENNESSEE
ELECTRICAL SITE PLAN

REVISIONS

DESIGNED: D.L.S.
 DRAWN: M.E.A.
 CHECKED: H.W.C.
 DATE: MARCH 21, 1993
 SCALE: 1" = 20'-0"
 PROJ. NO. 0592

SHEET 27
E-1
 OF 36

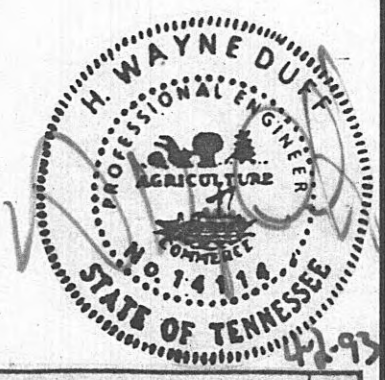

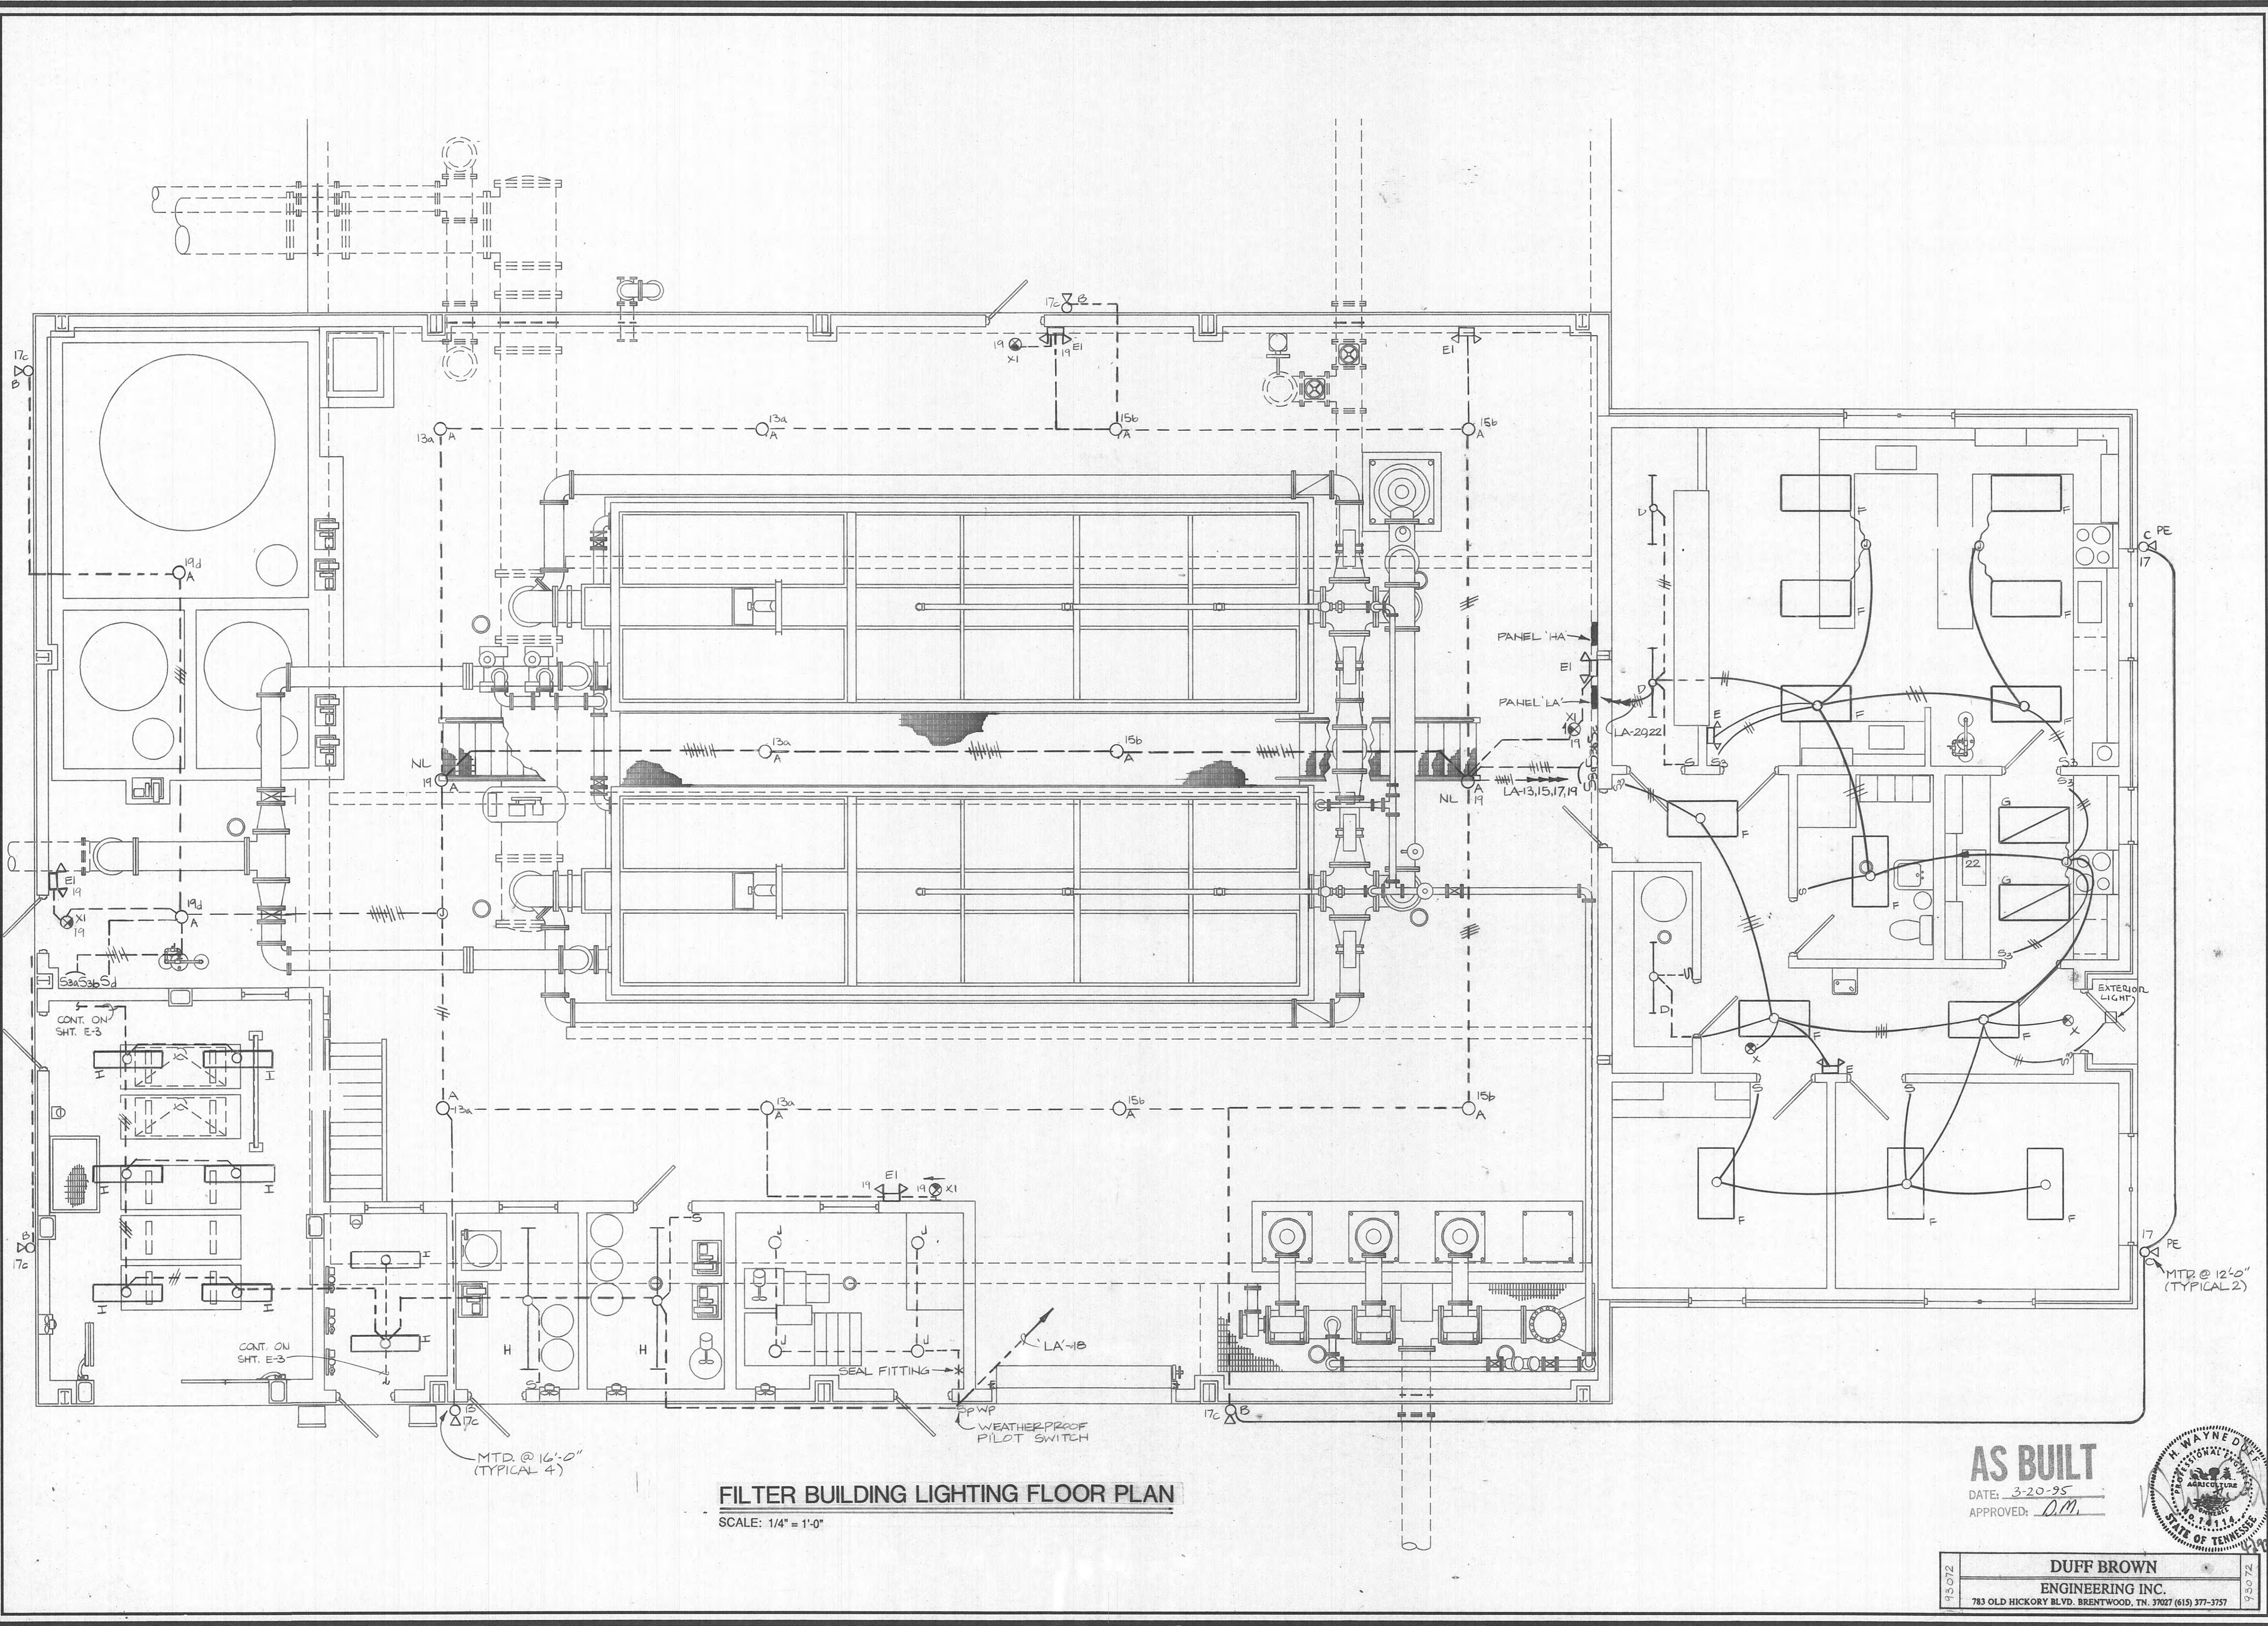


FILTER BUILDING LIGHTING FLOOR PLAN
 SCALE: 1/4" = 1'-0"

AS BUILT
 DATE: 3-20-95
 APPROVED: D.M.



DUFF BROWN
 ENGINEERING INC.
 783 OLD HICKORY BLVD. BRENTWOOD, TN. 37027 (615) 377-3757

ELROD · DUNSON, INC.
 CONSULTING ENGINEERS
 NASHVILLE · KNOXVILLE
 LEXINGTON, KY

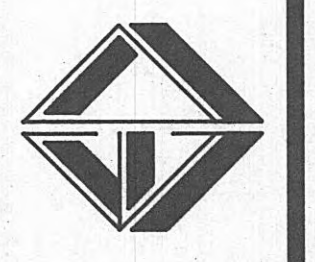


CONTRACT W03-04

HARRIMAN, TENNESSEE
 FILTER BUILDING LIGHTING PLAN

REVISIONS

DESIGNED: D.L.S.
 DRAWN: M.Z.A.
 CHECKED: H.W.D.
 DATE: MARCH 21, 1995
 SCALE: 1/4" = 1'-0"
 PROJ. NO. 0592

SHEET 28
E-2
 OF 36

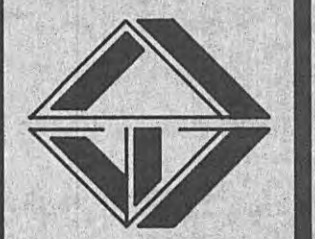

CONTRACT W93-04

**HARRIMAN, TENNESSEE
SITE GRADING PLAN**

REVISIONS
5/3/93 - Add Entrance Sign

DESIGNED: L.E.R.
DRAWN: S.C.G.
CHECKED: L.E.R.
DATE: MARCH, 1993
SCALE: 1" = 20'-0"
PROJ. NO. 0952



SHEET 2
OF 36

LEGEND

- PROPOSED STRUCTURES
- EXISTING CONTOURS
- PROPOSED CONTOURS
- PROPOSED ASPHALT PAVING
- PROPOSED CONC. SIDEWALK
- PROPOSED FENCE


NOTE

SLOPE PAVEMENT TO DRAIN AWAY FROM BUILDING.

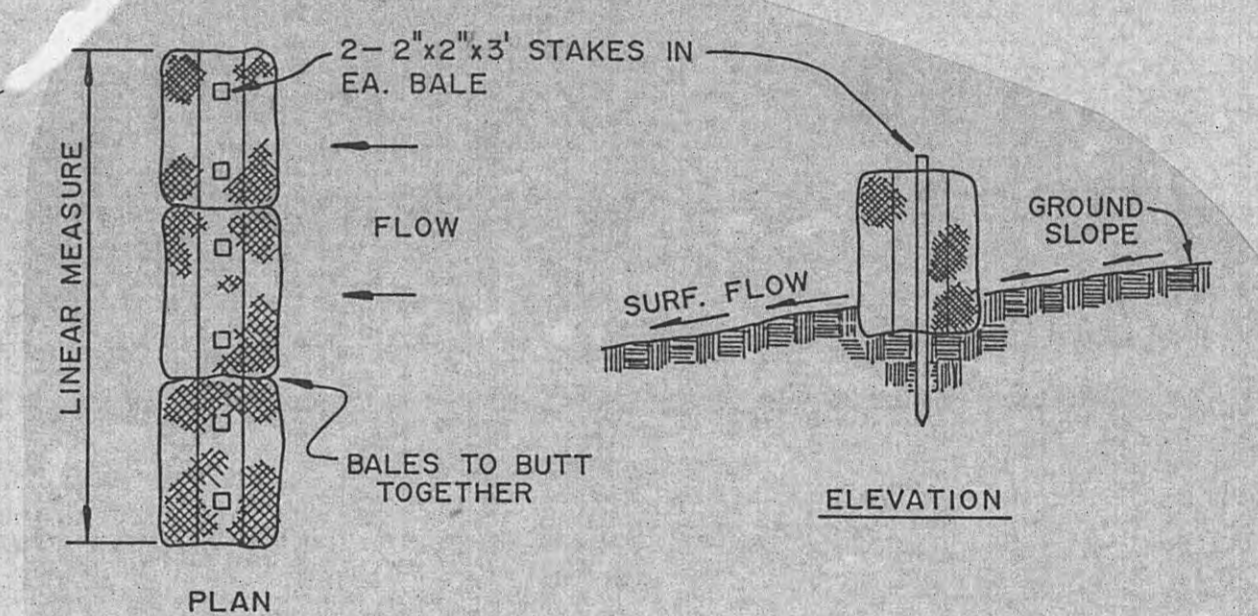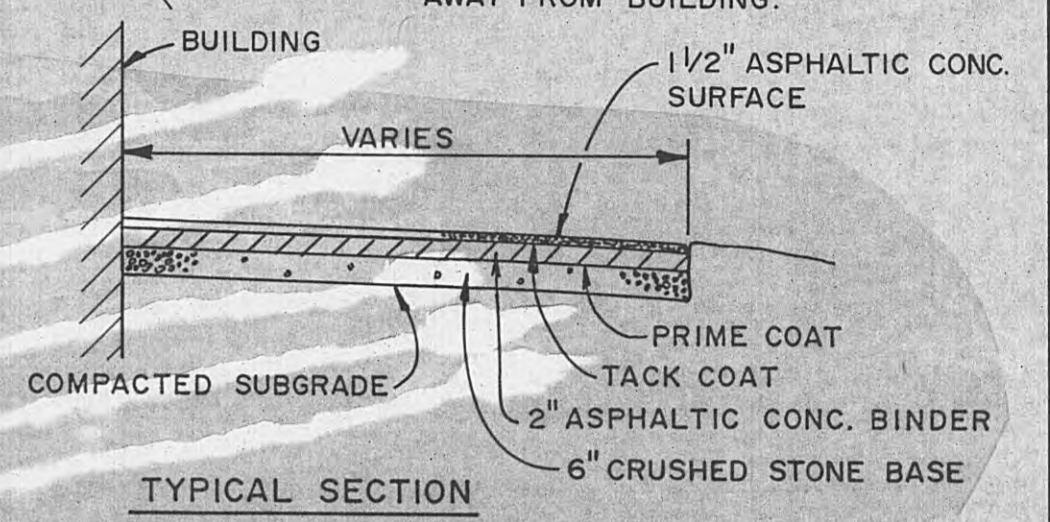


TO BE INSTALLED AS NOTED ON PLAN BEFORE COMMENCING GRADING OPERATION AND LEFT IN PLACE UNTIL A GOOD STAND OF GRASS IS ESTABLISHED OVER ALL DISTURBED AREAS. BARRIER SHOWN IS MINIMUM REQUIREMENT; CONTRACTOR RESPONSIBLE FOR EROSION CONTROL MEASURES.

EROSION - SILTATION BARRIER DETAIL

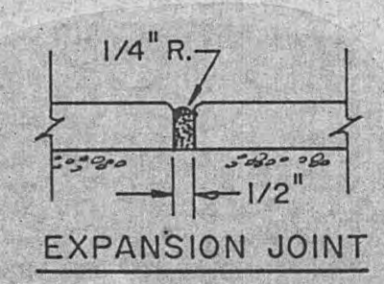


EXPANSION JOINT

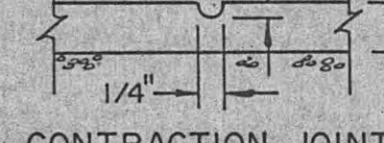


CONTRACTION JOINT

NOTE: PREFORMED 1/2" EXPANSION JOINTS SHALL BE EQUALLY SPACED AT 25' MAX. CENTERS, WITH 1/4" CONTRACTION JOINTS EQUALLY SPACED AT 5' MAX. CENTERS BETWEEN EXPANSION JOINTS FOR ALL SIDEWALKS SHOWN.

SIDEWALK JOINT DETAIL
NOT TO SCALE

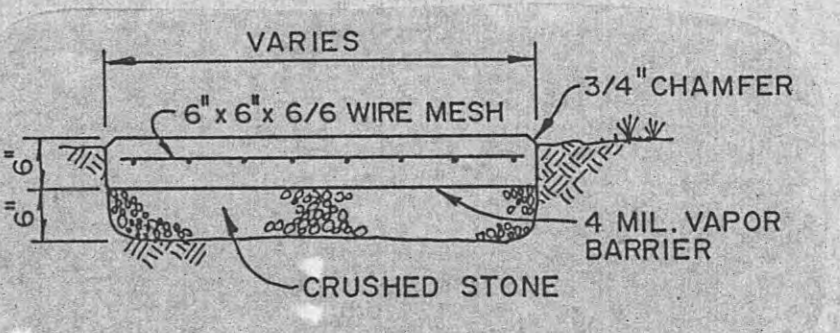



TYPICAL SIDEWALK DETAIL
NOT TO SCALE

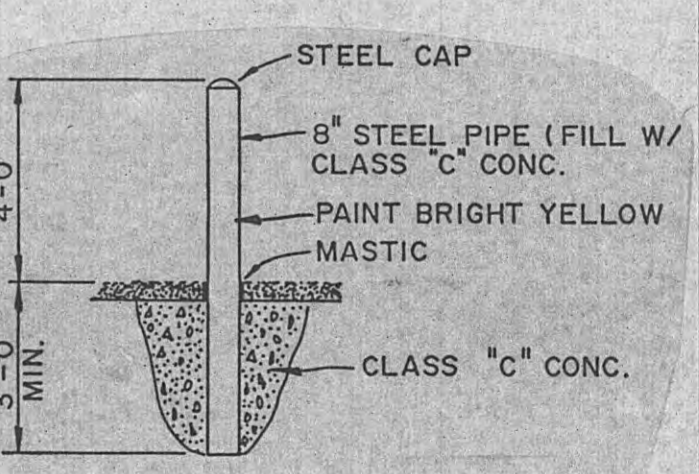

BUMPER DETAIL
NOT TO SCALE

AS BUILT

DATE: 3-20-95
APPROVED: *D.M.*

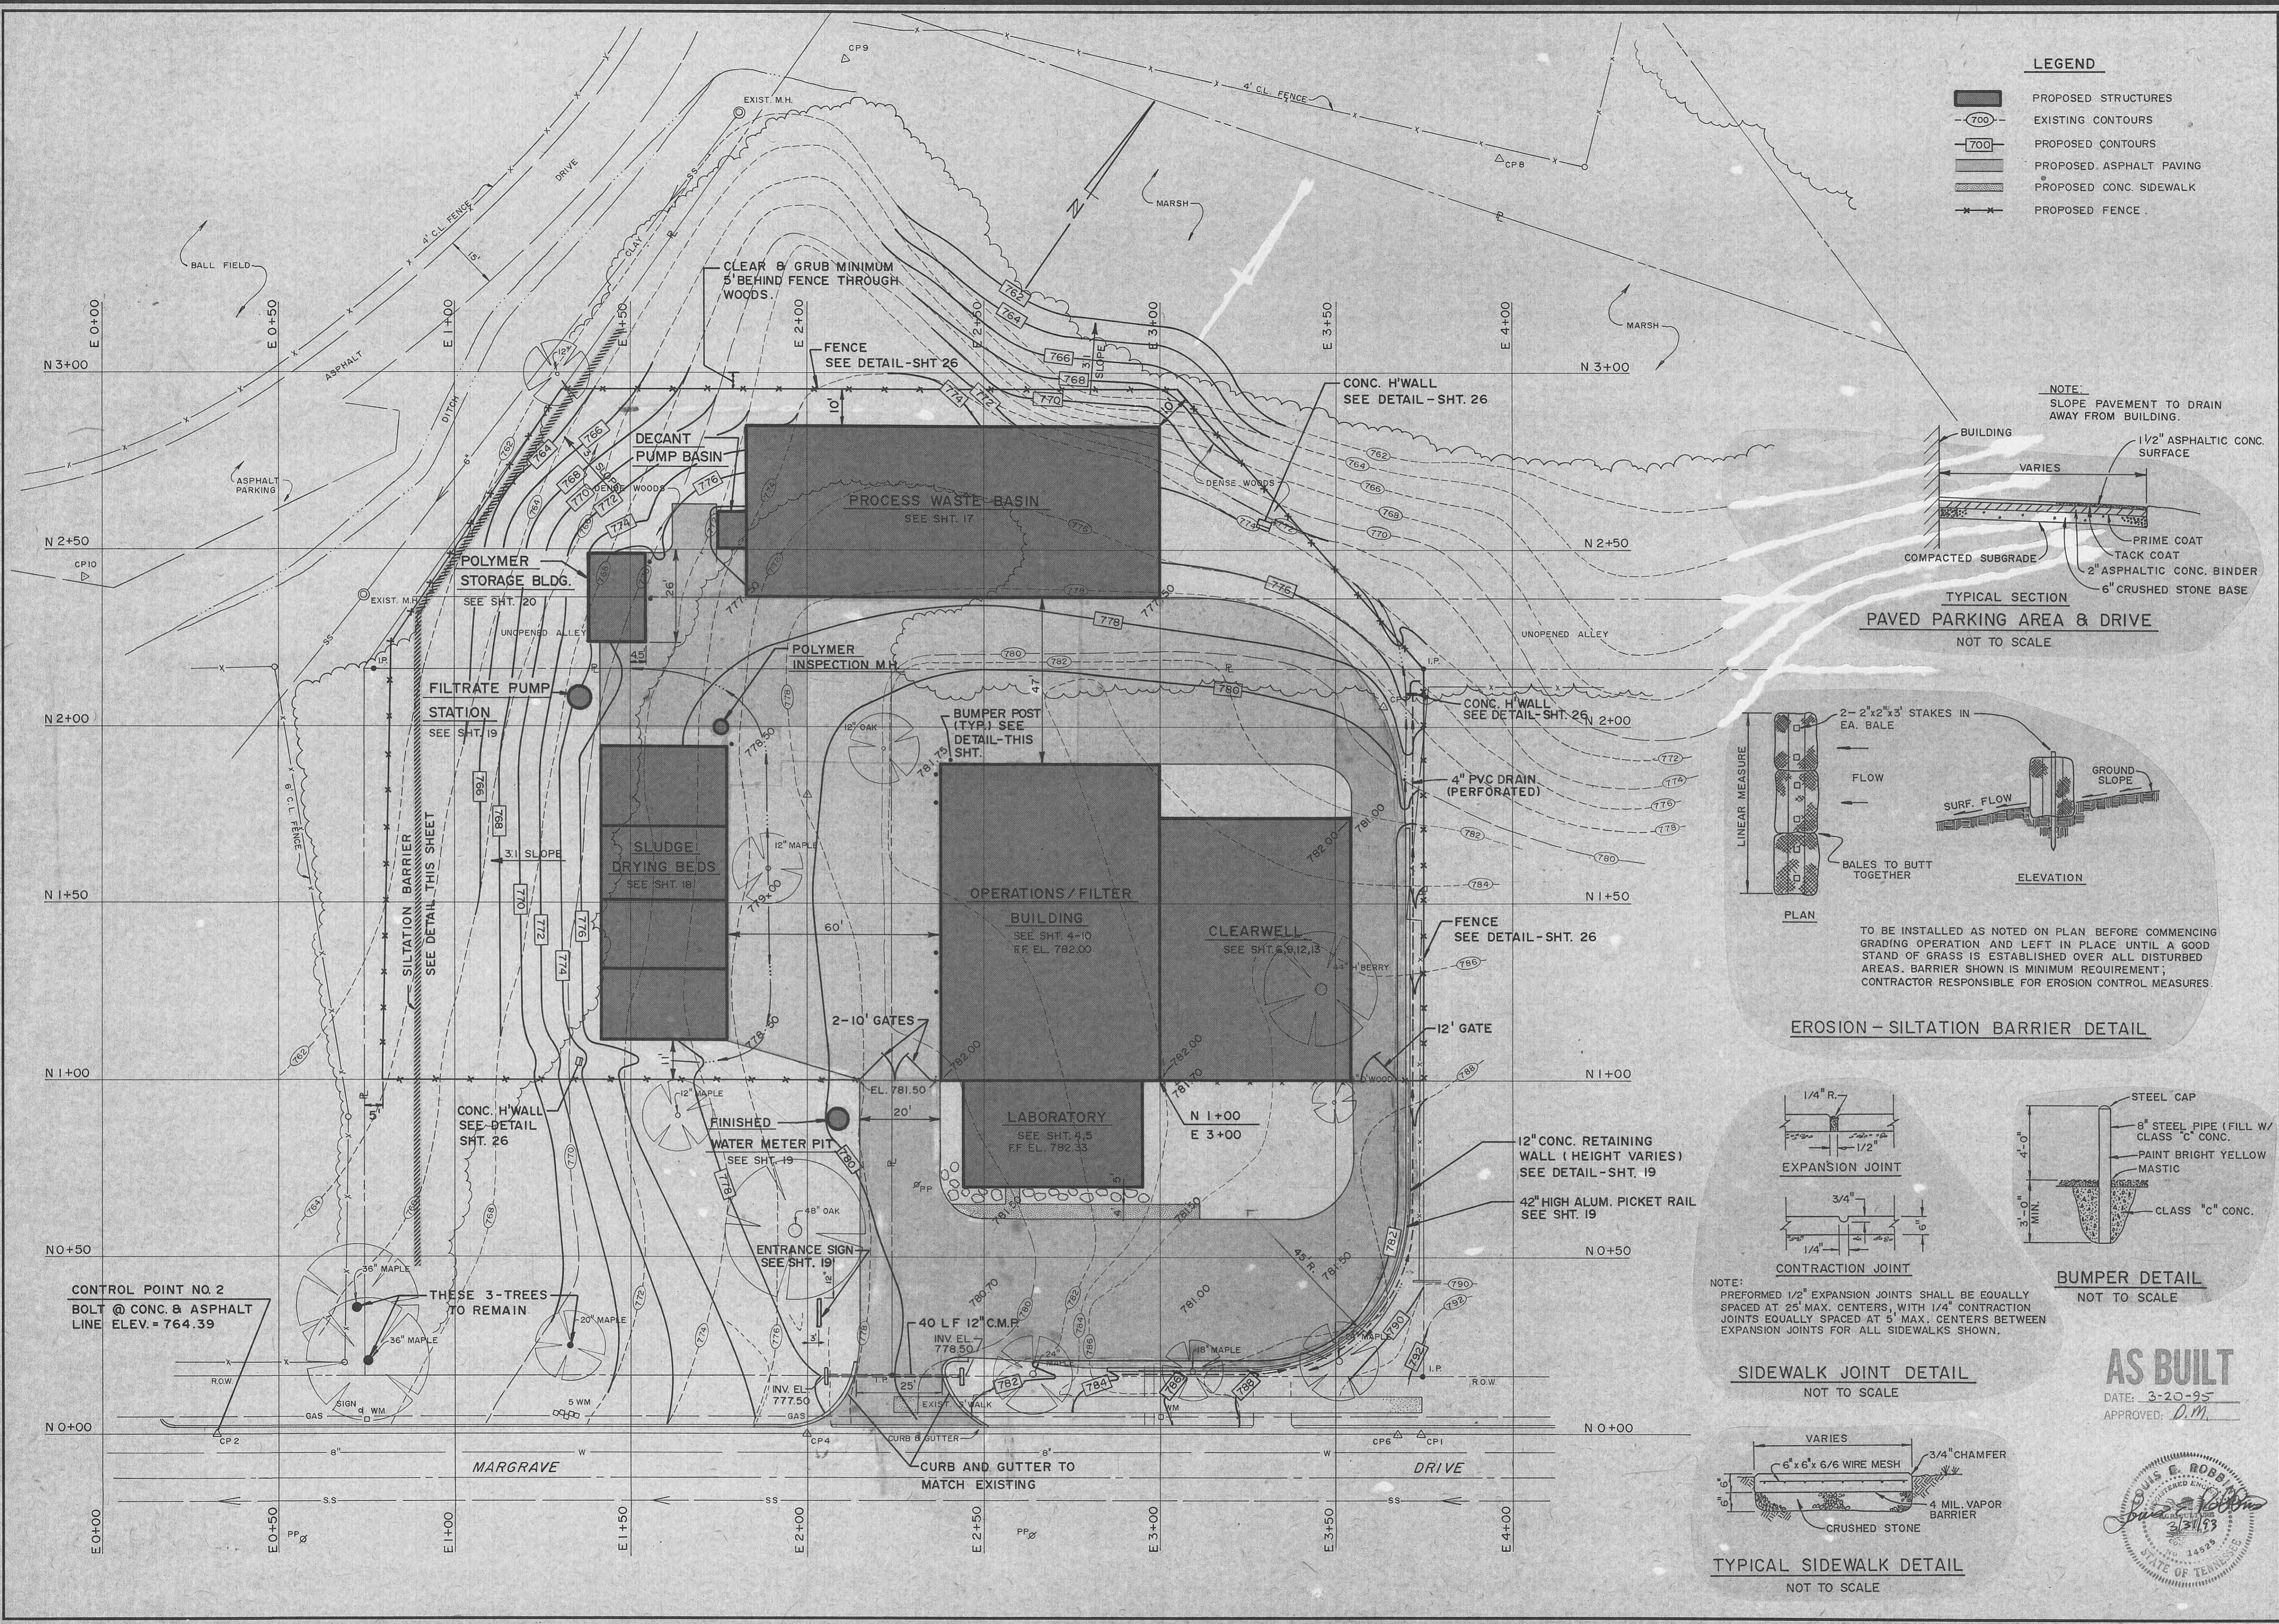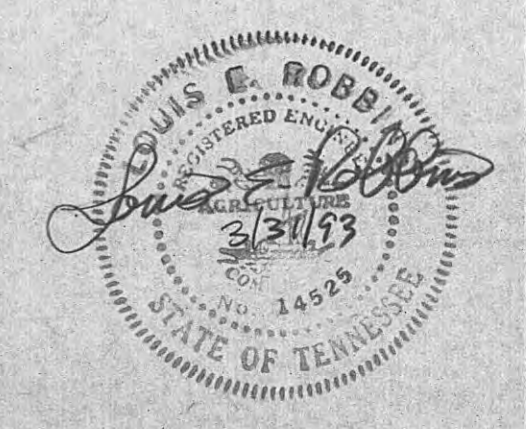

CONTROL POINT NO. 2
BOLT @ CONC. & ASPHALT
LINE ELEV. = 764.39

THESE 3-TREES
TO REMAIN.

ENTRANCE SIGN
SEE SHT. 19

40 LF 12" C.M.F.
INV. EL. 778.50

CURB & GUTTER TO
MATCH EXISTING

12" CONC. RETAINING
WALL (HEIGHT VARIES)
SEE DETAIL - SHT. 19

42" HIGH ALUM. PICKET RAIL
SEE SHT. 19

12' GATE

CONC. H'WALL
SEE DETAIL - SHT. 26

CONC. H'WALL
SEE DETAIL - SHT. 26


FENCE
SEE DETAIL - SHT. 26

CLEAR & GRUB MINIMUM
5' BEHIND FENCE THROUGH
WOODS

MARGRAVE

DRIVE

TYPICAL SIDEWALK DETAIL
NOT TO SCALE

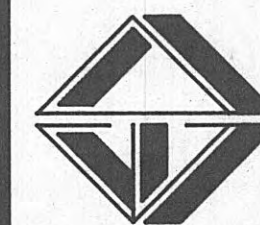



CONTRACT W03-04

HARRIMAN, TENNESSEE
FILTER BUILDING POWER FLOOR PLAN

REVISIONS

DESIGNED: P.L.S.
DRAWN: D.L.S.
CHECKED: H.W.D.
DATE: MARCH 25, 1993
SCALE: 1/4" = 1'-0"
PROJ. NO. Q532

SHEET 29
OF 36

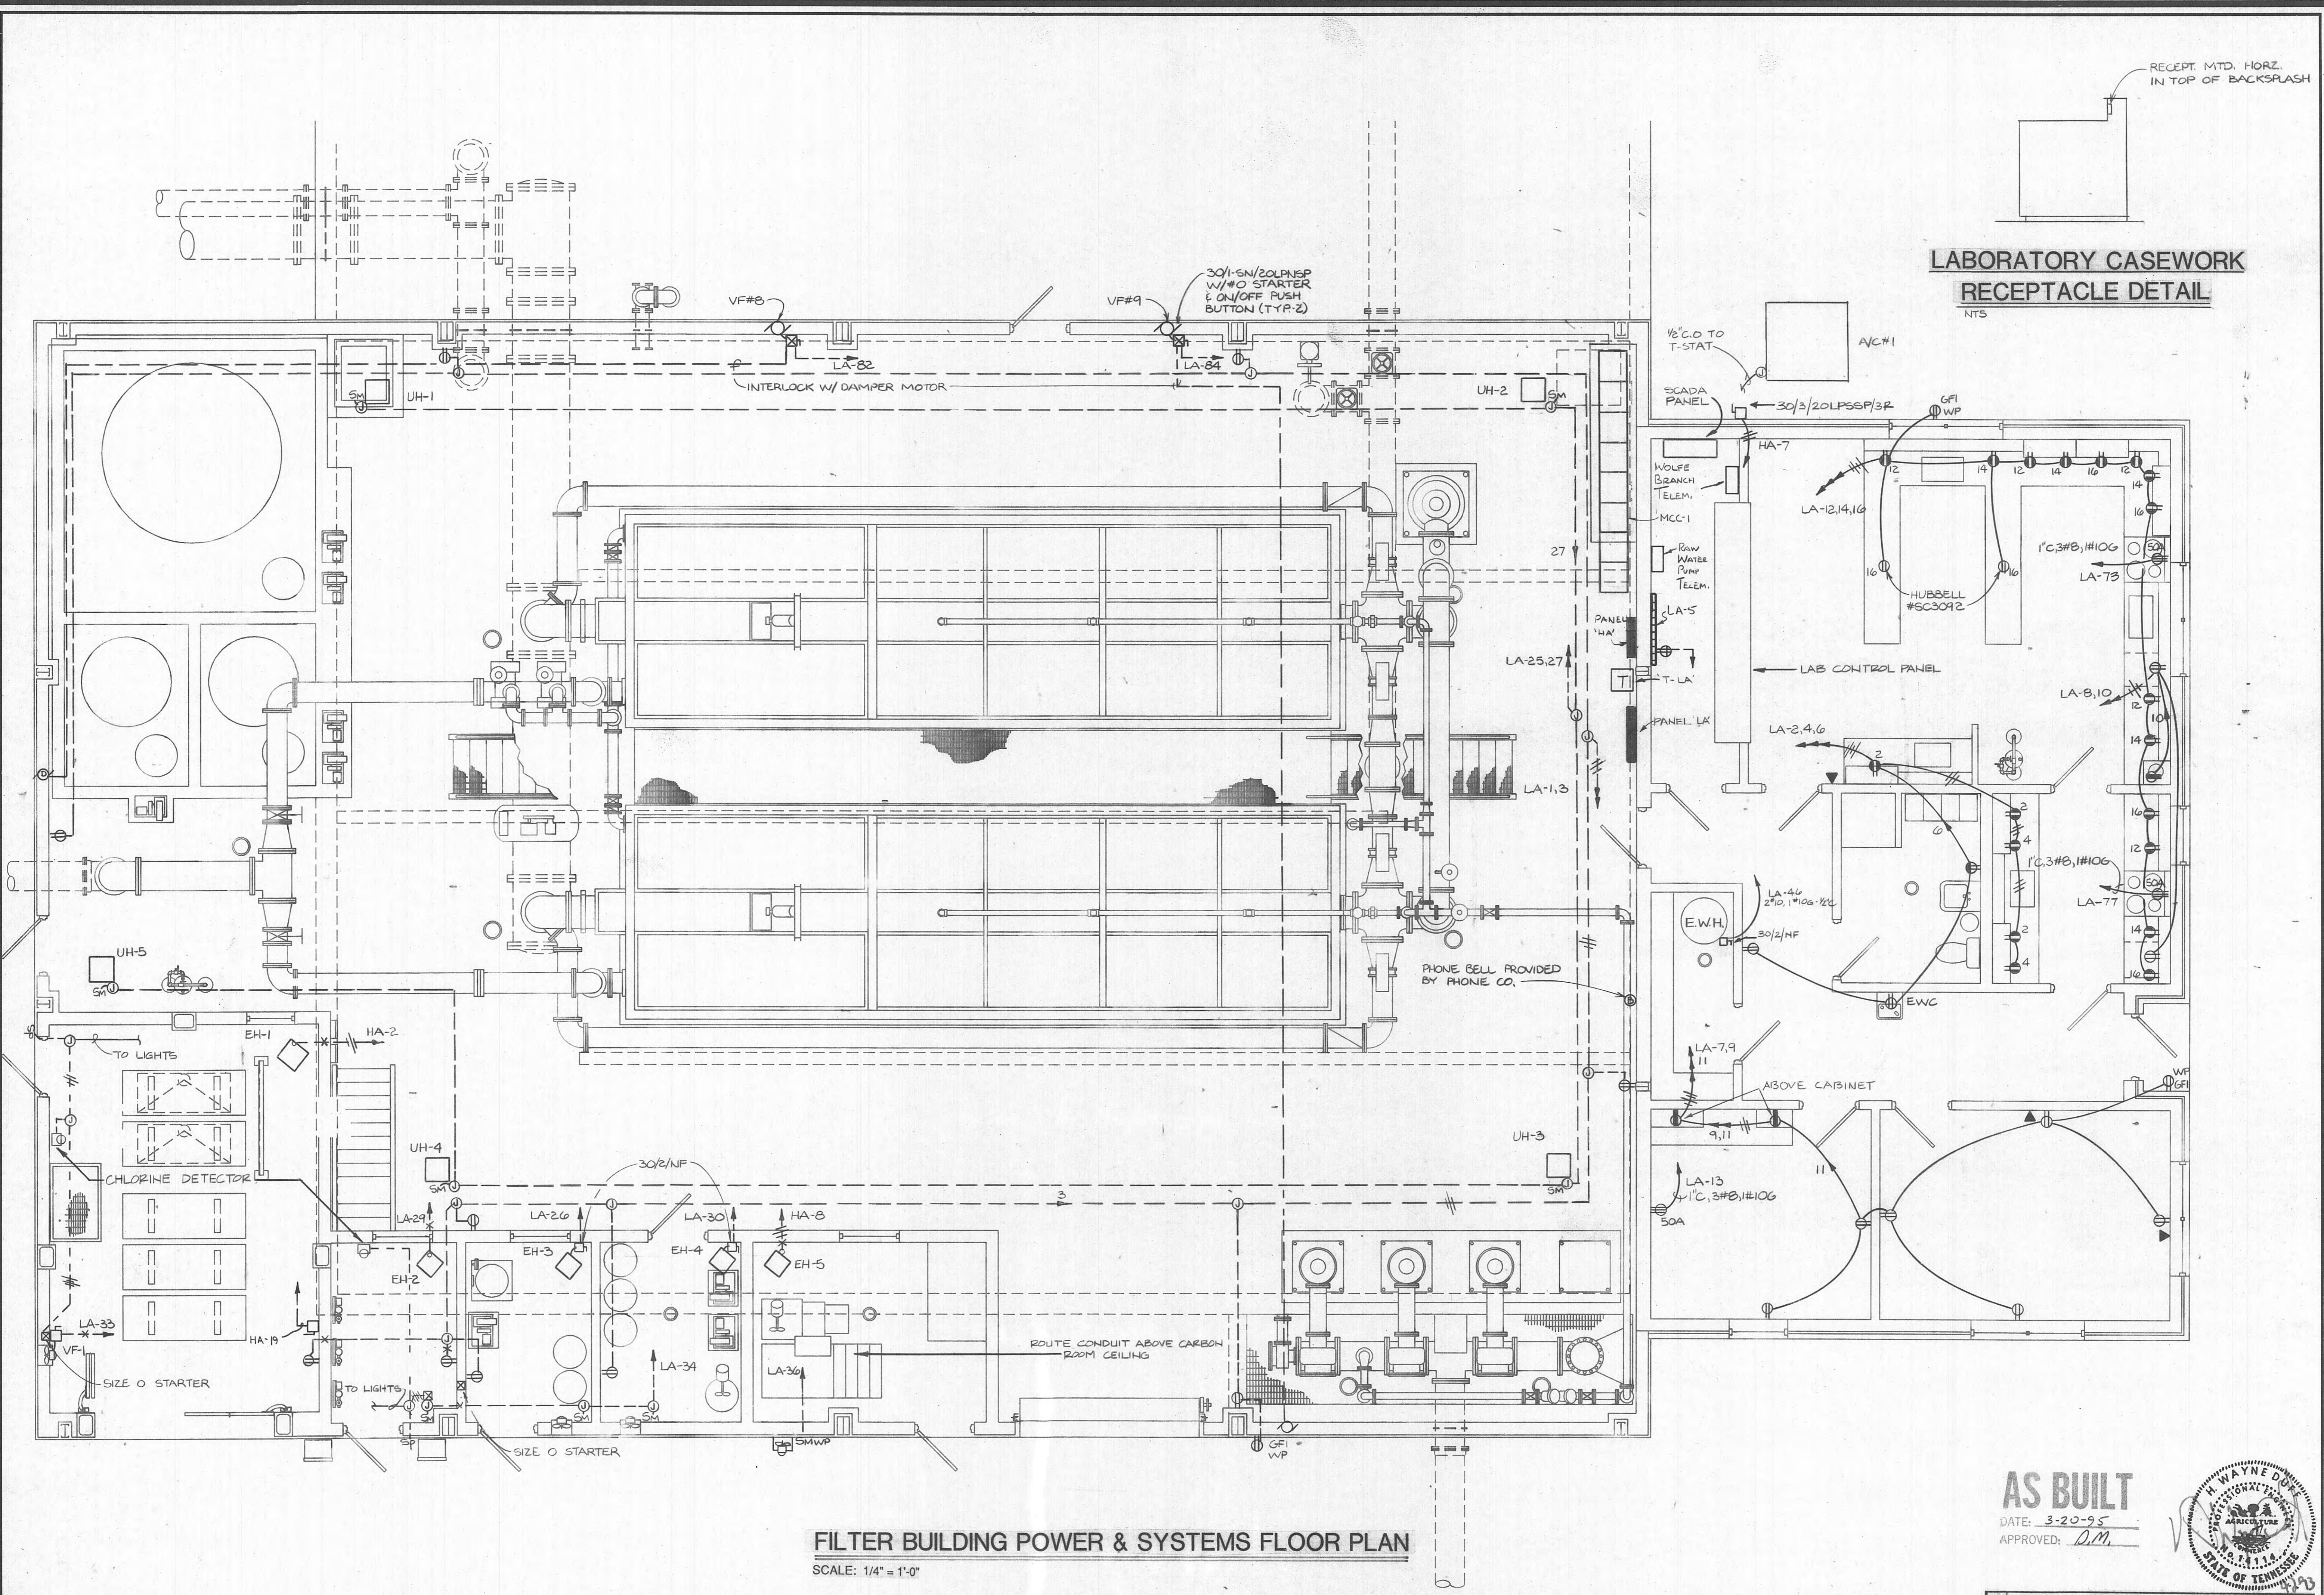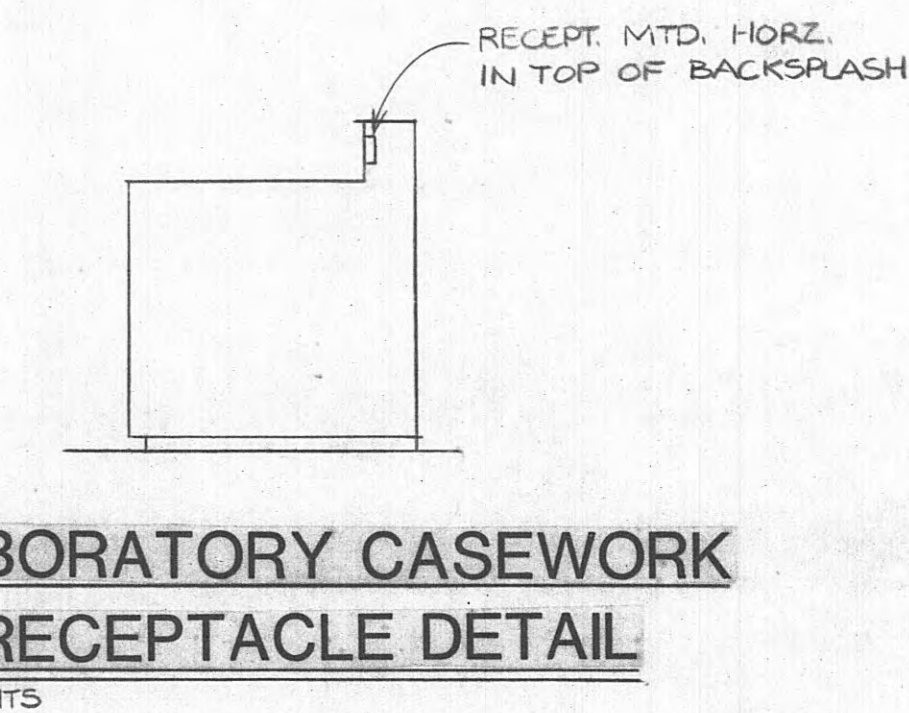

FILTER BUILDING POWER & SYSTEMS FLOOR PLAN
SCALE: 1/4" = 1'-0"

AS BUILT
DATE: 3-20-95
APPROVED: D.M.



DUFF BROWN
ENGINEERING INC.
783 OLD HICKORY BLVD. BRENTWOOD, TN. 37027 (615) 377-3757

BRUNNEN PAPER COMPANY 8/85

PROCESSING POWER PLAN NOTES: E-4


- PRESSURE SWITCH, UNIT SWITCH, NORMAL SOLENOID, & EMERGENCY SOLENOID ARE FURNISHED BY OTHERS. CONTRACTOR SHALL PROVIDE INTERLOCK WIRING FROM DEVICES TO "PUMP DIRECTOR CABINET". COORDINATE WITH VENDOR FOR LOCATIONS & EXACT REQUIREMENTS.
- PROVIDE A #18 TWISTED PAIR CONTROL WIRING IN 1/2" C. FROM "PUMP DIRECTOR CABINET" TO "MCC1" TO CONTROL STARTER COIL FOR HIGH SERVICE PUMP.
- PROVIDE A SECURITY CONTROL STATION TO OFFER LOCAL CONTROL OF RESPECTIVE PUMP. STATION SHALL BE SQUARE D CLASS 9001, #KY298 IN A CAST ALUMINUM SURFACE MOUNT ENCLOSURE. ALL STATIONS SHALL BE EQUIPPED W/CYLINDER LEGEND PLATE MARKED "OPEN-CLOSE", AND PUSHBUTTON MARKED "STOP". ALL STATIONS SHALL BE KEVED A LIKE, AND OWNER SHALL BE PROVIDED 6 (SIX) KEYS.
- VERIFY ALL PLANT PROCESS WIRING AND CONTROL REQUIREMENTS PRIOR TO ROUGH-IN.
- ALL INTERCONNECTING WIRING TO BE #14 THHN STRANDED COPPER WITH CRIMPED TERMINATIONS.

6"X6" WIREWAY W/ HINGED COVER. MOUNT AS HIGH AS STRUCTURE WILL ALLOW

SECTION-"MCC1" & "LCP"
NO SCALE

PROCESS DEVICE SCHEDULE

KEY	DESCRIPTION	KEY	DESCRIPTION
1	UNIT 1 BACKWASH INLET VALVE	13	UNIT 2 BACKWASH INLET VALVE
2	UNIT 1 OPTIONAL FILTER-TO-WASTE VALVE	14	UNIT 2 OPTIONAL FILTER-TO-WASTE VALVE
3	UNIT 1 LOW EFFLUENT PRESSURE SWITCH	15	UNIT 2 LOW EFFLUENT PRESSURE SWITCH
4	UNIT 1 SURFACE WASH VALVE	16	UNIT 2 SURFACE WASH VALVE
5	UNIT 1 LOW LEVEL SWITCH	17	UNIT 2 LOW LEVEL SWITCH
6	UNIT 1 EFFLUENT LEVEL VALVE	18	UNIT 2 EFFLUENT LEVEL VALVE
7	UNIT 1 FILTER EFFLUENT VALVE	19	UNIT 2 FILTER EFFLUENT VALVE
8	UNIT 1 AIR INLET VALVE	20	UNIT 2 AIR INLET VALVE
9	UNIT 1 INFLUENT HIGH PRESSURE SWITCH	21	UNIT 2 INFLUENT HIGH PRESSURE SWITCH
10	UNIT 1 INFLUENT LOW PRESSURE SWITCH	22	UNIT 2 INFLUENT LOW PRESSURE SWITCH
11	UNIT 1 INFLUENT VALVE	23	UNIT 2 INFLUENT VALVE
12	UNIT 1 WASTE GATE VALVE	24	UNIT 2 WASTE GATE VALVE
		25	BLOWER PRESSURE SWITCH

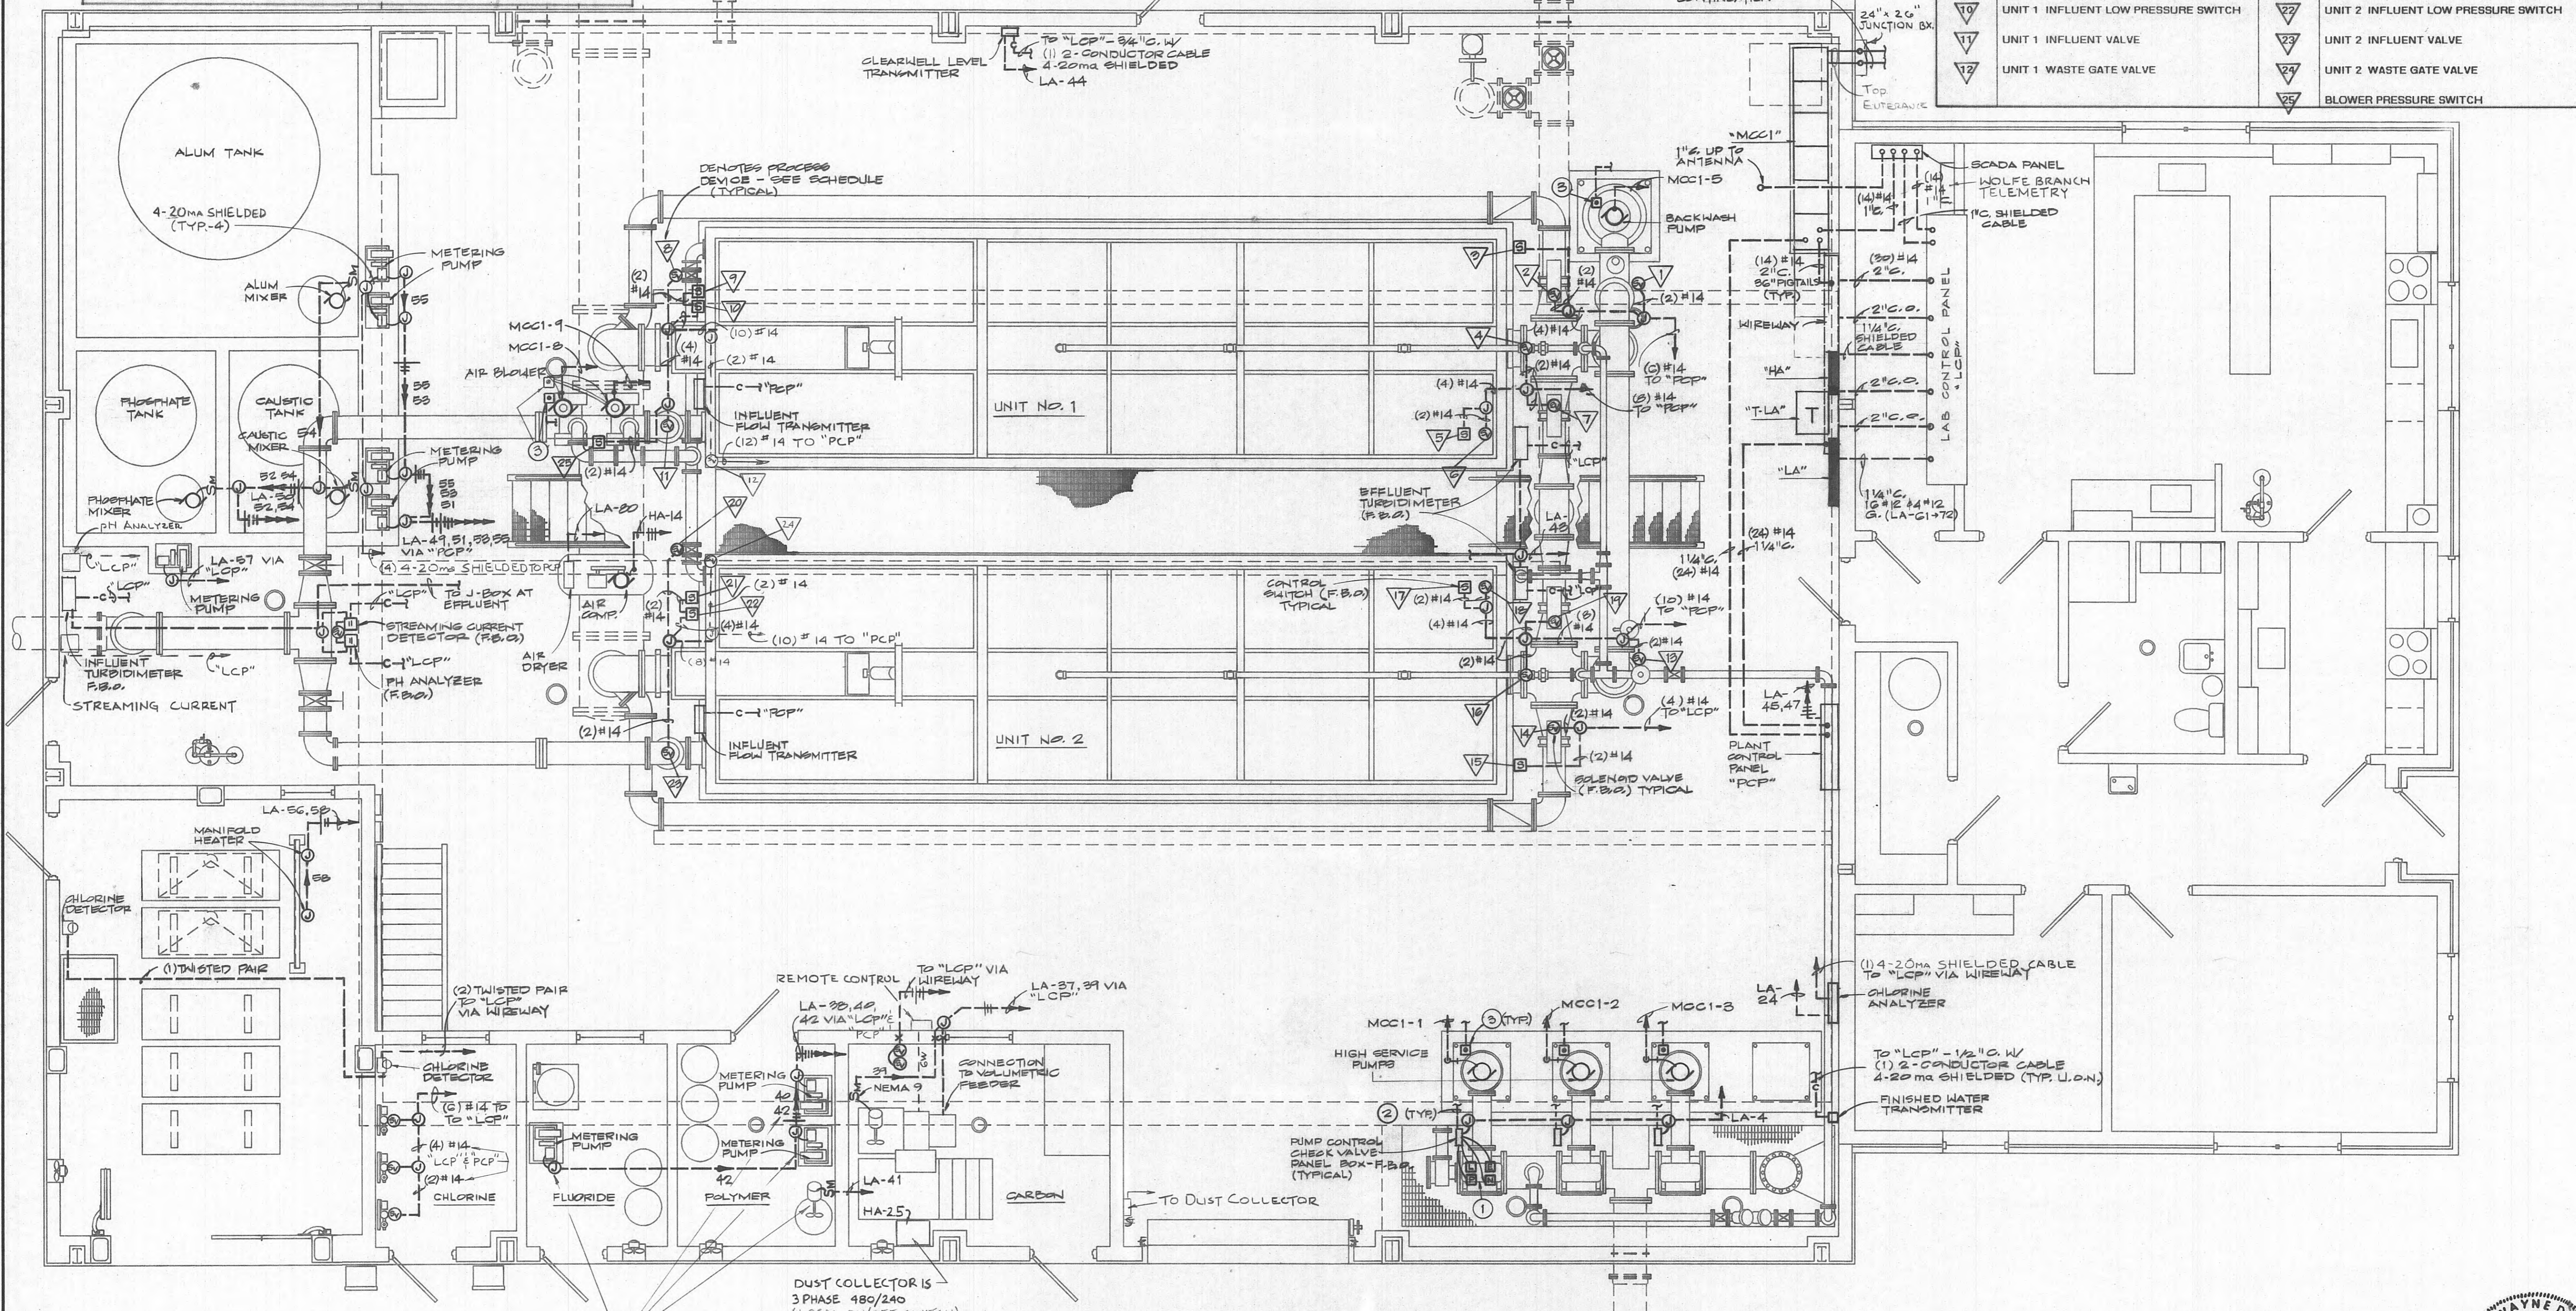

LOCAL CONTROL SWITCHES
FILTER BUILDING - PROCESS POWER PLAN


SCALE: 1/4" = 1'-0"

AS BUILT
DATE: 3-20-95
APPROVED: D.M.



DUFF BROWN
ENGINEERING INC.
783 OLD HICKORY BLVD. BRENTWOOD, TN. 37027 (615) 377-3757

ELROD-DUNSON, INC.
CONSULTING ENGINEERS
NASHVILLE • KNOXVILLE
LEXINGTON, KY

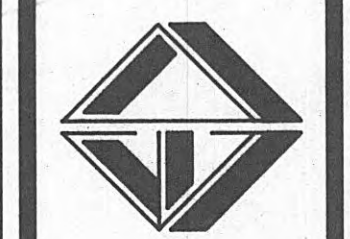

CONTRACT W93-04

FILTER BUILDING PROCESS POWER PLAN

REVISIONS


DESIGNED: JFS
DRAWN: JFS
CHECKED: HWD
DATE: 04-02-93
SCALE: NOTED
PROJ. NO. 0592

SHEET 30
E-4
OF 36

"MCC1"

MOTOR CONTROL CENTER SCHEDULE									
VOLTS, AMPS & A.S.I.C.	BRANCH CIRCUIT BREAKER	STARTER	CONTROL ITEM ON STARTER	LOAD	CONDUIT & WIRE	FEEDS			
# A.S.I.C.	CIR. NO.	AMPS	POLES	KVA	H.P.	2" - 3#3/0	2" - 3#3/0	2" - 3#3/0	2" - 3#3/0
480, 3PH 3 WIRE 800 A 25,000A	1	225	3						
				AUTOTRANSFORMER NEMA SIZE 5	S-P-ETM A-H	129.6	125	2" - 3#3/0 1#6G	HIGH SERVICE PUMP
	2	225	3						
				AUTOTRANSFORMER NEMA SIZE 5	S-P-ETM A-H	129.6	125	2" - 3#3/0 1#6G	HIGH SERVICE PUMP
	3	225	3						
				AUTOTRANSFORMER NEMA SIZE 5	S-P-ETM A-H	129.6	125	2" - 3#3/0 1#6G	HIGH SERVICE PUMP
800A MAIN FUSED SWITCH	4	225	3						
				(CIRCUIT BREAKER)	-	107.1	-	2" - 4#4/0 1#4G	PANEL HA
	5	100	3						
				AUTOTRANSFORMER NEMA SIZE 3	S-P-ETM A-H	54.0	50	1" - 3#4 1#8G	BACKWASH PUMP
	6	25	3						
				X-LINE NEMA SIZE 1	S-P-H	11.6	7.5	3/4" - 3#10 1#10G	SLUDGE PUMP
	7	25	3						
				X-LINE NEMA SIZE 1	S-P-H	11.6	7.5	3/4" - 3#10 1#10G	SLUDGE PUMP
	8	60	3						
				X-LINE NEMA SIZE 2	S-P-H ETM-A	22.4	20	3/4" - 3#8 1#10G	BLOWER MOTOR
	9	60	3						
				X-LINE NEMA SIZE 2	S-P-H ETM-A	22.4	20	3/4" - 3#8 1#10G	BLOWER MOTOR
	10	25	3						
				X-LINE NEMA SIZE 1	S-P-H	11.6	10	3/4" - 3#10 1#10G	DECANT PUMP
	11	25	3						
				X-LINE NEMA SIZE 1	S-P-H	11.6	10	3/4" - 3#10 1#10G	DECANT PUMP
	12	30	3						
				(CIRCUIT BREAKER)	-	7.89	3(X2)	3/4" - 3#10 1#10G	FILTRATE PUMPS
	13	-	3						
				SPACE W/PROVISIONS	-	-	-	-	-
	14	-	3						
				SPACE W/PROVISIONS	-	-	-	-	-
	15	-	3						
				SPACE W/PROVISIONS	-	-	-	-	-
	16	-	3						
				SPACE W/PROVISIONS	-	-	-	-	-

STARTER CONTROL ITEM LEGEND
 S - START/STOP PUSHBUTTONS A - AMMETER
 P - PILOT LIGHT (GREEN) ETM - ELAPSED TIME METER
 H - HAND-OFF AUTO SEL. SWITCH
 PF - PHASE FAILURES RELAY W/ADJUSTABLE TIME DELAY

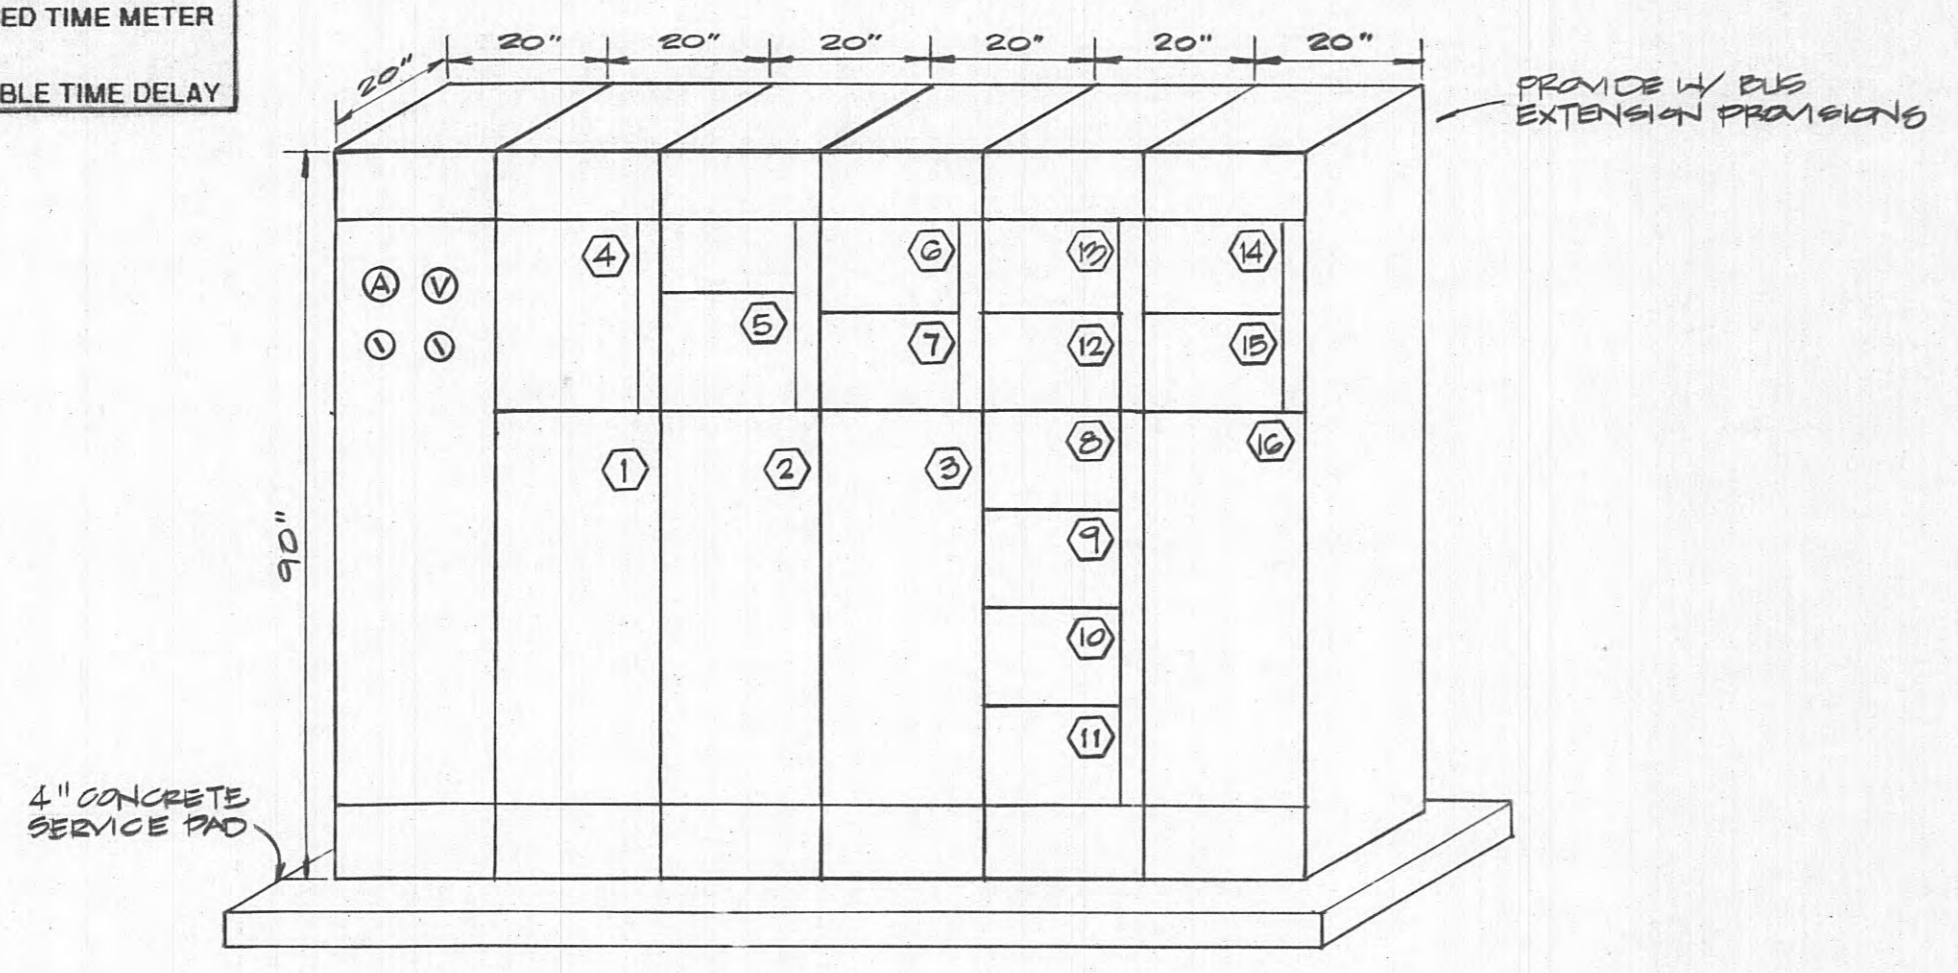

ELEVATION - MOTOR CONTROL CENTER "MCC1"
NO SCALE

MOUNTING: SURFACE C/B AIC RATING: 14,000A PANEL SIZE: 225 AMP

VOLTAGE: 480 DELTA, 3PH 3W

PANEL HA

MAIN TYPE: M.L.O.

LOCATION	WATTS/PHASE			C/B SIZE	CKT. NO.	C/B SIZE	WATTS/PHASE			LOCATION
	A	B	C				A	B	C	
SPACE	-	-	-	-	1	2	2500	-	-	BH - 2
SPACE	-	-	-	-	3	4	2500	2500	2500	BH - 2
SPACE	-	-	-	-	5	6	1000	1000	1000	BH - 5
A/C - 1	3879	3879	-	20/3	7	8	15/3	-	-	BH - 5
					9	10				
					11	12				
TRANSFORMER "T-LA"	26265	26265	3879	100/3	13	14	15/3	720	720	AIR COMPRESSOR
					15	16				
					17	18				
TROLLEY	1274	-	-	15/3	19	20	-	-	-	SPACE
					21	22	-	-	-	SPACE
					23	24	-	-	-	SPACE
SPACE	-	-	-	-	25	26	-	-	-	SPACE
SPACE	-	-	-	-	27	28	-	-	-	SPACE
SPACE	-	-	-	-	29	30	-	-	-	SPACE
SPACE	-	-	-	-	31	32	-	-	-	SPACE
SPACE	-	-	-	-	33	34	-	-	-	SPACE
SPACE	-	-	-	-	35	36	-	-	-	SPACE
SPACE	-	-	-	-	37	38	-	-	-	SPACE
SPACE	-	-	-	-	39	40	-	-	-	SPACE
SPACE	-	-	-	-	41	42	-	-	-	SPACE
TOTAL	31418	31418	31418				4220	4220	4220	TOTAL
LCL	W X 1.25 =						35638	35638	35638	PHASE TOTAL
AC = 11637 W; HEAT = 10500 W; AC@125% HT @100% =				14546	W					106914
MISC. LOAD =				96414	W					
TOTAL LOAD =				110460	W =					133.4 AMPS

LARGEST LOAD OF AC OR HEAT IS USED IN CALCS EXCEPT IN THE CASE OF HEAT PUMPS IN WHICH BOTH LOADS ARE USED.

MOUNTING: SURFACE C/B AIC RATING: 10,000 PANEL SIZE: 225 AMP


VOLTAGE: 208Y/120V 3PH 4W

PANEL LA

MAIN TYPE: 225A M.C.B.

LOCATION	WATTS/PHASE			C/B SIZE	CKT. NO.	C/B SIZE	WATTS/PHASE			LOCATION
	A	B	C				A	B	C	
RECEPT - FILTER BLDG	1080	-	-	20/1	1	2	20/1	-	-	RECEPT - LAB
RECEPT - FILTER BLDG	-	-	-	20/1	3	4	20/1	-	-	RECEPT - LAB
RECEPT - TELEPHONE	-	-	-	20/1	5	6	20/1	540	360	870
COFFEE MAKER	1500	-	-	20/1	7	8	20/1	-	-	REPRICATOR
MICROWAVE	-	1200	-	20/1	9	10	20/1	-	-	DISTILLERY
RECEPT - OFFICE	-	-	1080	20/1	11	12	20/1*	1200	1500	900
LTS - OPERATIONS	1450	-	-	20/1	13	14	20/1*	900	-	RECEPT - LAB
LTS - OPERATIONS	-	1450	-	20/1	15	16	20/1*	-	1080	RECEPT - LAB
LTS - OUTSIDE	-	-	1830	20/1	17	18	20/1	-	1630	LTG - CARBON, FLU, CHC
LTS - OPERATIONS	1160	-	-	20/1	19	20	20/1	1395	-	LTG - LAB
SPACE	-	-	-	20/1	21	22	20/1	-	1305	LTG - OFFICE
SPACE	-	-	-	20/1	23	24	20/1	-	500	CHLORINE ANALYZER
VF - 3,4,5	1188	-	-	20/1	25	26	20/2	1100	-	BH - 3
VH - 1,2	-	960	-	20/1	27	28		1100	1100	BH - 4
BH - 2	-	-	1000	20/2	29	30	20/2	-	-	BH - 4
VF - 1	1000	-	-		31	32		1100	-	VF - 2,3,4
				15/2	33	34	20/1	984	510	VF - 5
					35	36	20/1	-	-	-
CARBON FEED	696	-	-	15/1	37	38	15/1	696	696	POLYMER METERING PP
CARBON MIXER	-	696	-		39	40	15/1	-	-	POLYMER METERING PP
POLYMER MIXER	-	-	696		41	42	15/1	-	-	FLUORIDE METERING PP
TURBIDIMETERS	540	-	-	20/1	43	44	20/1	180	-	CLEARWELL TRANSMITTER
PLANT CONTROL PANEL	600	-	-	20/1	45	46	30/2	2250	-	BWH
PLANT CONTROL PANEL	-	600	-	20/1	47	48		-	2250	
METERING PUMP	696	-	-	15/1	49	50	15/1	696	696	PHOSPHATE MIXER
METERING PUMP	-	696	-	15/1	51	52	15/1	-	696	CAUSTIC MIXER
METERING PUMP	696	-	-	15/1	53	54	15/1	500	500	ALUM MIXER
METERING PUMP	696	-	-	15/1	55	56	15/1	500	500	MANIFOLD HEATER
METERING PUMP	696	-	-	15/1	57	58	15/1	500	500	MANIFOLD HEATER
SPACE	-	-	-	-	59	60	-	-	-	SPACE
LAB CONTROL	600	-	-	20/1	61	62	20/1	600	600	LAB CONTROL
LAB CONTROL	-	600	-	20/1	63	64	20/1	600	600	LAB CONTROL
LAB CONTROL	600	-	-	20/1	65	66	20/1	600	600	LAB CONTROL
LAB CONTROL	-	600	-	20/1	67	68	20/1	600	600	LAB CONTROL
LAB CONTROL	600	-	-	20/1	69	70	20/1	600	600	LAB CONTROL
LAB CONTROL	-	600	-	20/1	71	72	20/1	600	600	LAB CONTROL
LAB CONTROL	600	-	-	20/1	73	74	100/3	3000	3000	PANEL "LB"
RANGE	3500	-	-	50/2	75	76		3000	3000	
					77	78		-	-	
					79	80	20/1	180	1130	AIR DRYER
FUTURE RANGE	3500	-	-	50/2	81	82	20/1	-	-	VF #B
					83	84	20/1	-	-	VF #9
TOTAL	10132	10192	9496				12775	30713	30864	28249
LCL	10220	W X 1.25 =					8548			7146
AC = 3084 W; HEAT = 8548 W; AC@125% HT @100% =				8548	W					89826
MISC. LOAD =				57474	W					
TOTAL LOAD =				78797	W =					218 AMPS

LARGEST LOAD OF AC OR HEAT IS USED IN CALCS EXCEPT IN THE CASE OF HEAT PUMPS IN WHICH BOTH LOADS ARE USED.

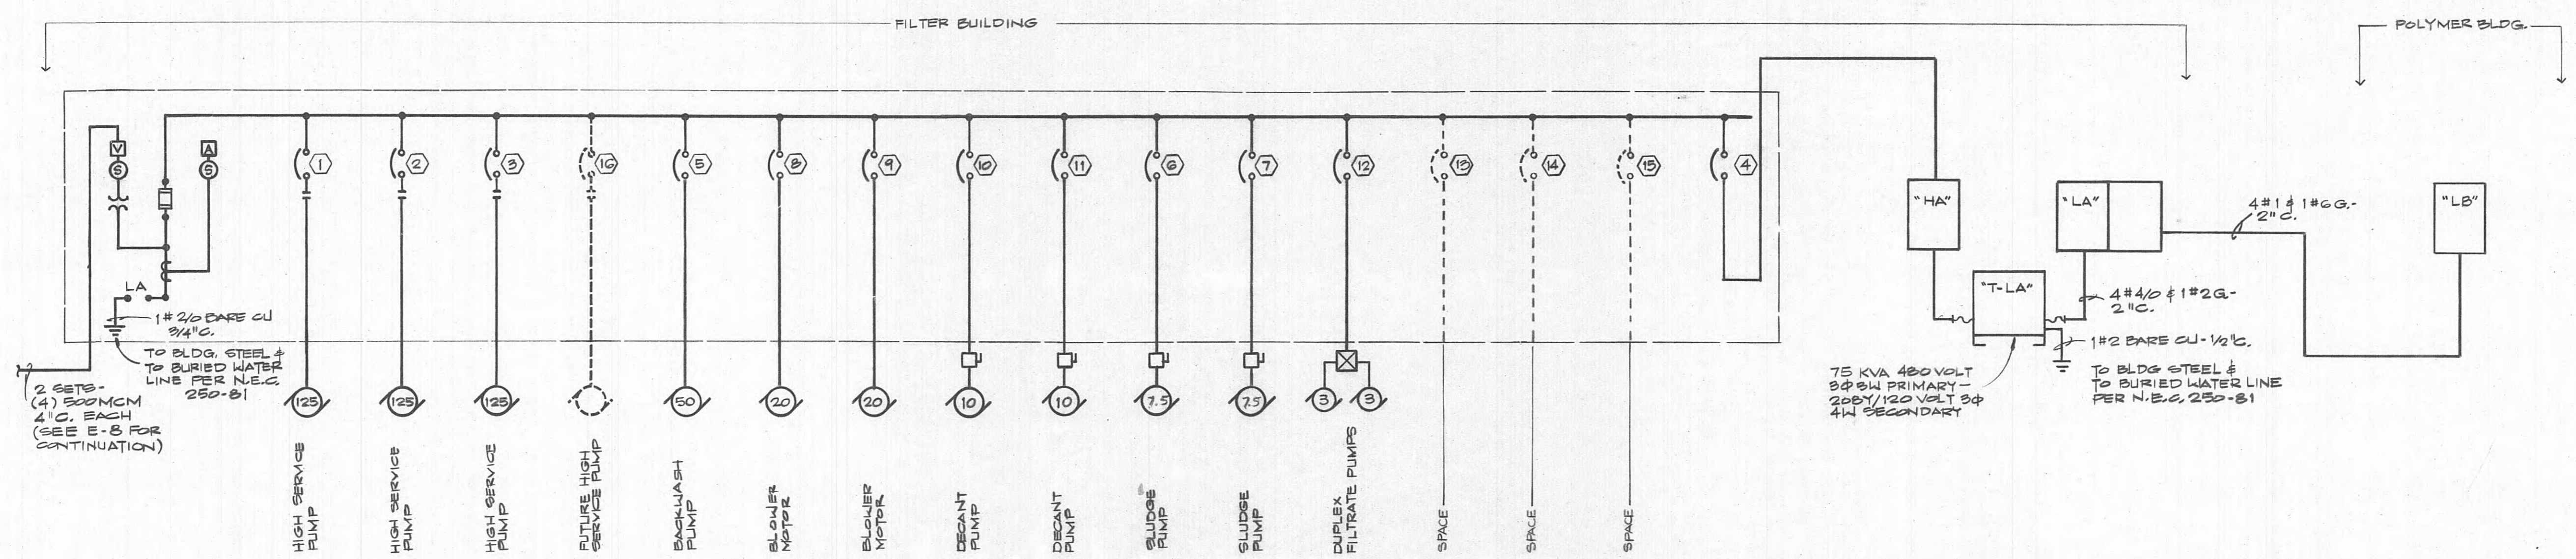


ONE LINE DIAGRAM & RISER - "MCC1"
NO SCALE

AS BUILT
 DATE: 3-20-95
 APPROVED: D.M.



DUFF BROWN
 ENGINEERING INC.
 783 OLD HICKORY BLVD. BRENTWOOD, TN. 37027 (615) 371-3757

ELROD · DUNSON, INC.
 CONSULTING ENGINEERS
 NASHVILLE · KNOXVILLE
 LEXINGTON, KY

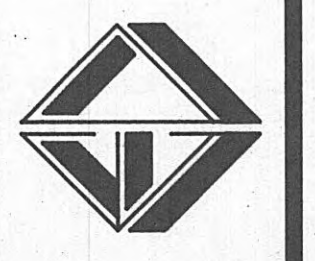

CONTRACT W03-04

HARRIMAN, TENNESSEE
 FILTER BUILDING ONE LINE DIAGRAM



REVISIONS

DESIGNED: JFS
 DRAWN: JFS
 CHECKED: HWD
 DATE: 04-02-93
 SCALE: NOTED
 PROJ. NO. 0592


SHEET 31
E-5
 OF 36

MOUNTING: SURFACE		C/B AIC RATING: 10,000		PANEL SIZE: 100 AMP						
VOLTAGE: 208Y/120V 3PH 4W										
PANEL LB										
MAIN TYPE: MAIN C.B.										
LOCATION	WATTS/PHASE			C/B SIZE	CKT. NO.	C/B SIZE	WATTS/PHASE			LOCATION
	A	B	C				A	B	C	
LTS	980			20/1	1	20/2	1100			EH - 6
RRCPT		900		20/1	3	1		1100		1
RRCPT - POLYMER			1000	20/1	5	20/1			500	LEVEL TRANSMITTER
					7	8				
					9	10				
					11	12				
					13	14				
					15	16				
					17	18				
					19	20				
					21	22				
					23	24				
					25	26				
					27	28				
					29	30				
					31	32				
					33	34				
					35	36				
					37	38				
					39	40				
					41	42				
TOTAL	980	900	1000				1100	1100	500	TOTAL
	LCL	980 W X 1.25 =		1225 W			2080	2000	1000	PHASE TOTAL
AC=	W; HEAT=	2200 W / AC @ 125% HT @ 100% =		2200 W					5580	TOTAL WATTS
	MISC. LOAD	=		2400 W						
	TOTAL LOAD	=		5825 W =						
										14.7 AMPS

LARGEST LOAD OF AC OR HEAT IS USED IN CALCS EXCEPT IN THE CASE OF HEAT PUMPS IN WHICH BOTH LOADS ARE USED.

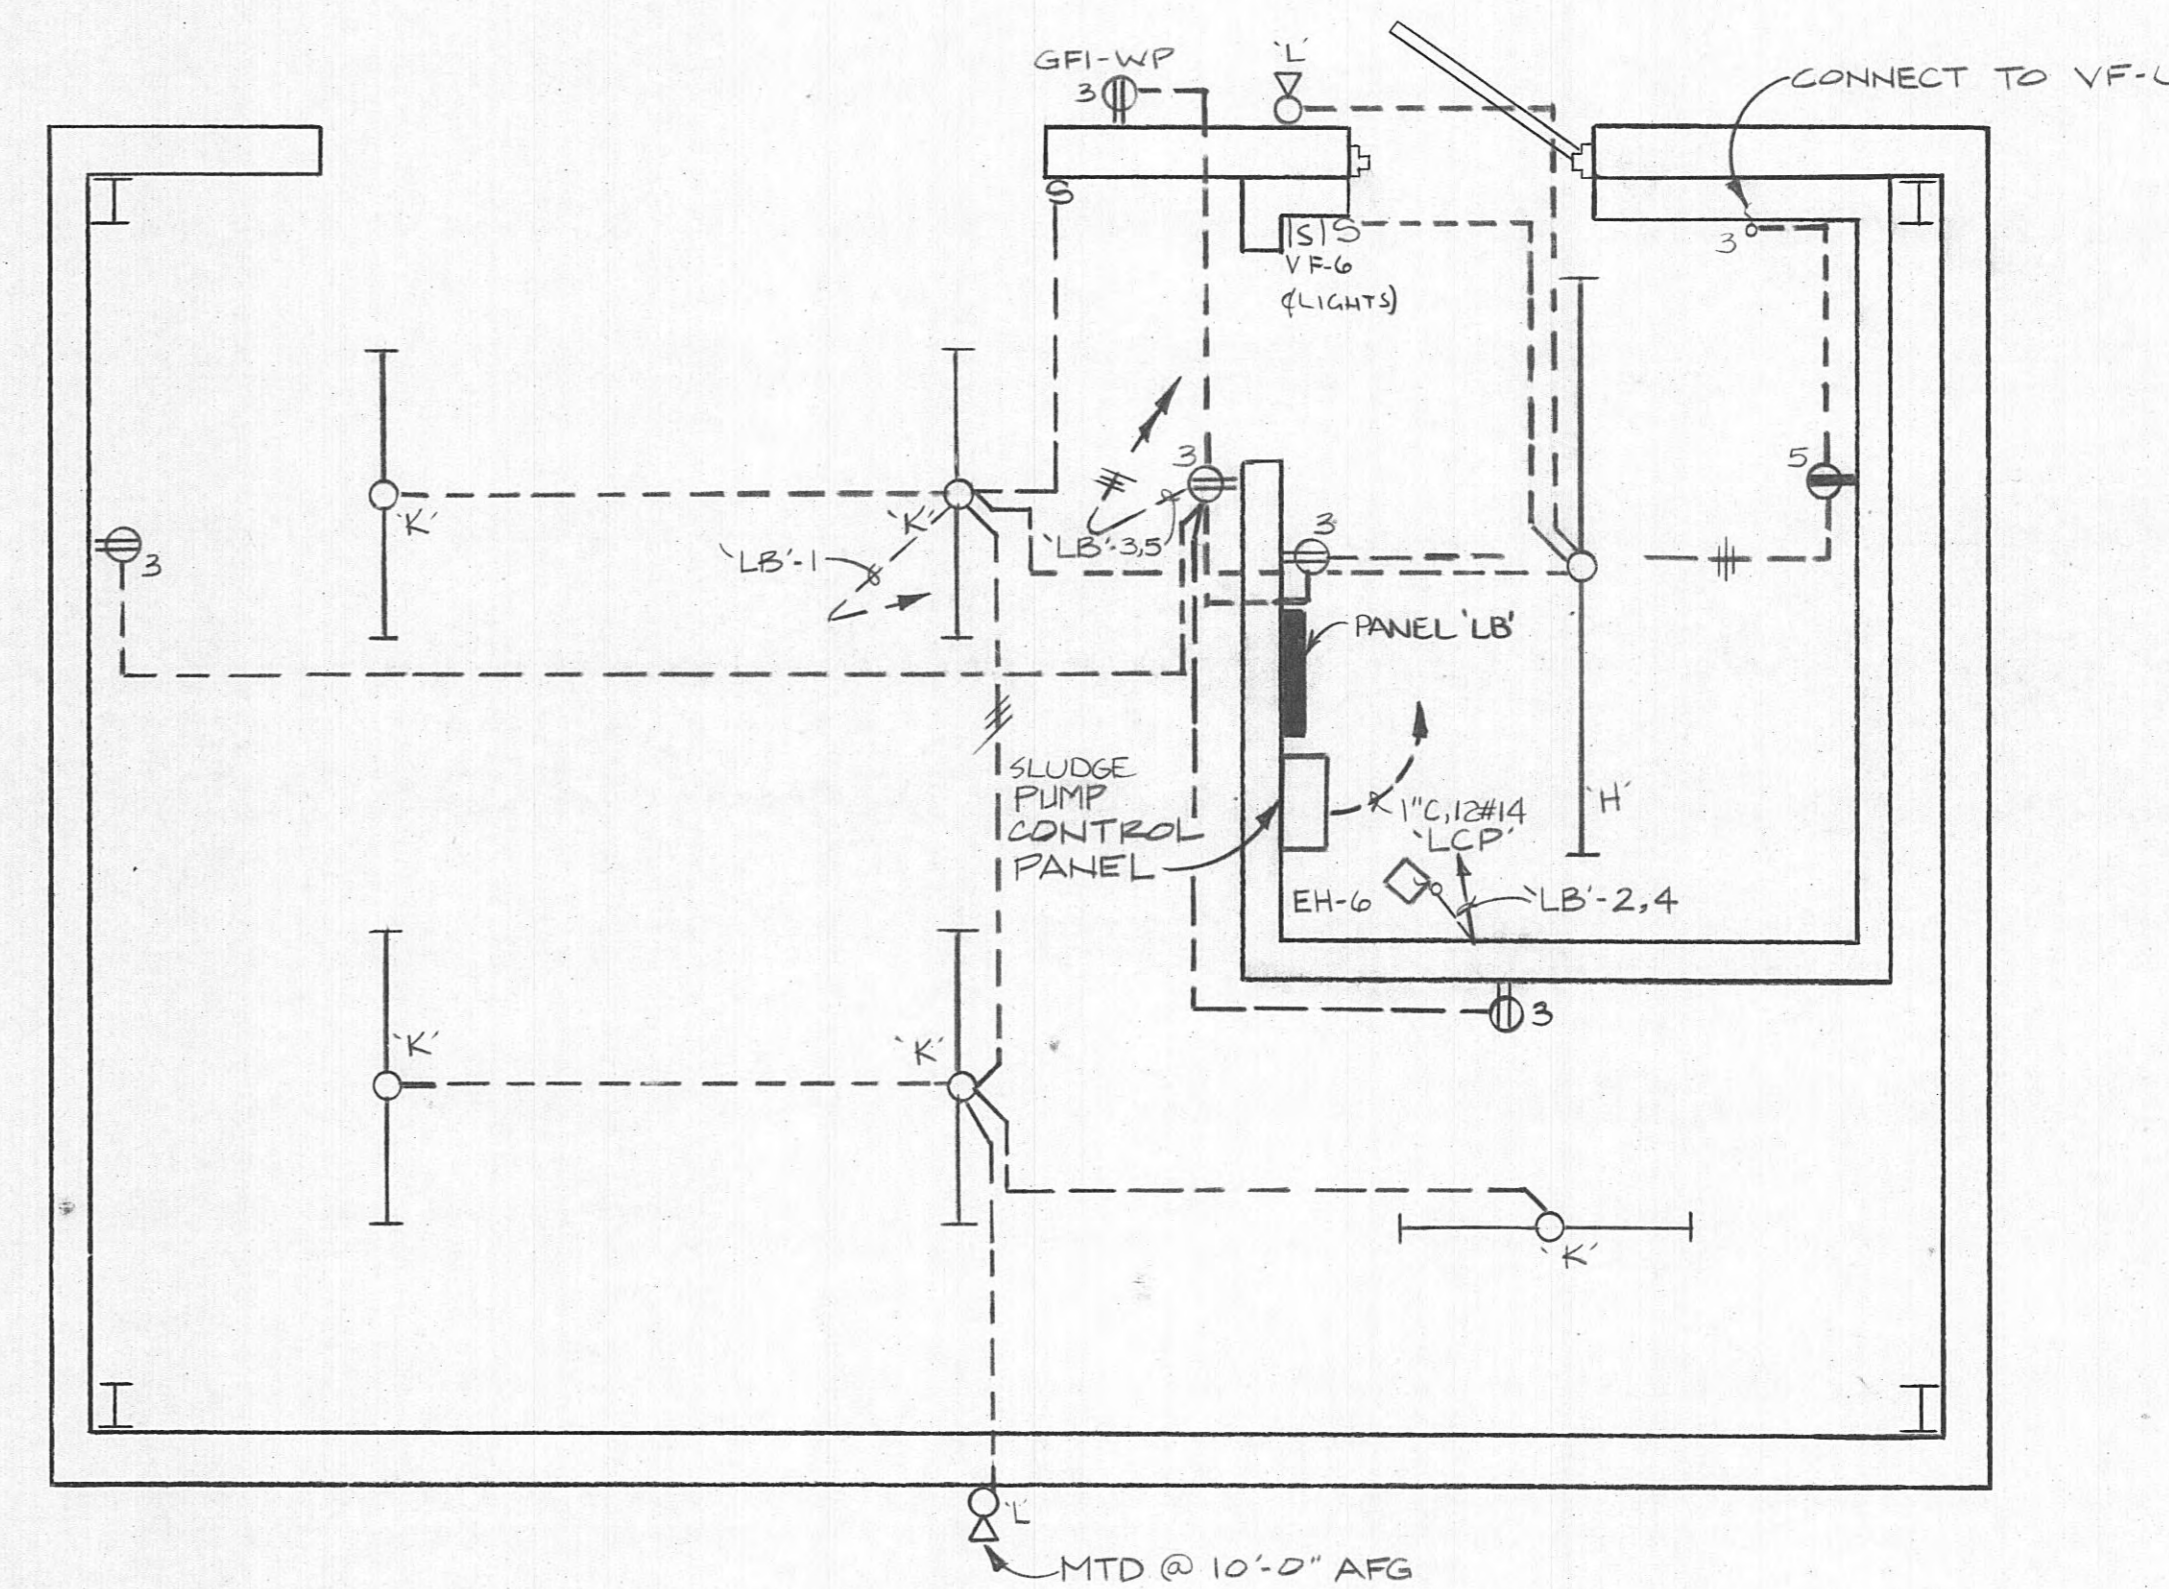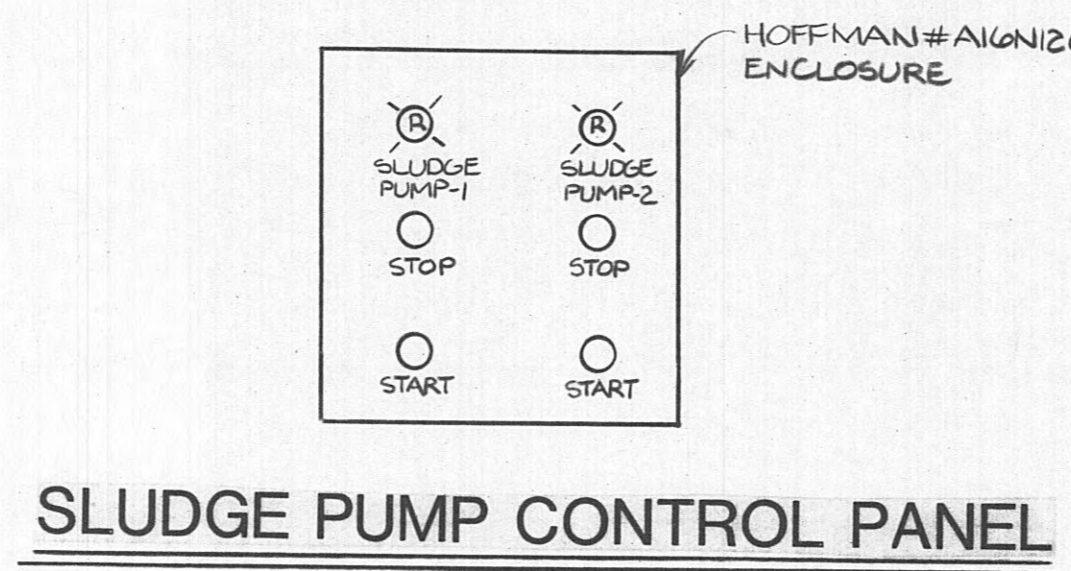


AS BUILT
 DATE: 3-20-95
 APPROVED: *D.M.*

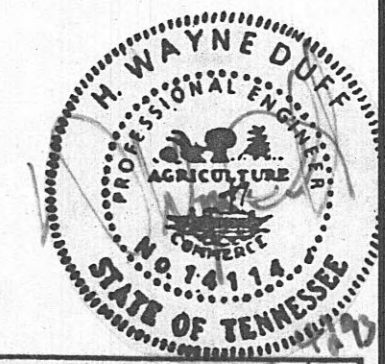

DUFF BROWN
 ENGINEERING INC.
 783 OLD HICKORY BLVD. BRENTWOOD, TN. 37027 (615) 377-3757

ELROD · DUNSON, INC.
 CONSULTING ENGINEERS
 NASHVILLE · KNOXVILLE
 LEXINGTON, KY

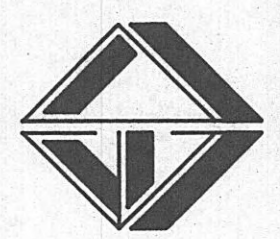



CONTRACT W93-04

HARRIMAN, TENNESSEE
 POLYMER BUILDING ELECTRICAL PLAN

REVISIONS


DESIGNED: D.L.S.
 DRAWN: M.E.A.
 CHECKED: H.W.D.
 DATE: MARCH 21, 1993
 SCALE: 3/8" = 1'-0"
 PROJ. NO. 0592

SHEET 32
E-6
 OF 36

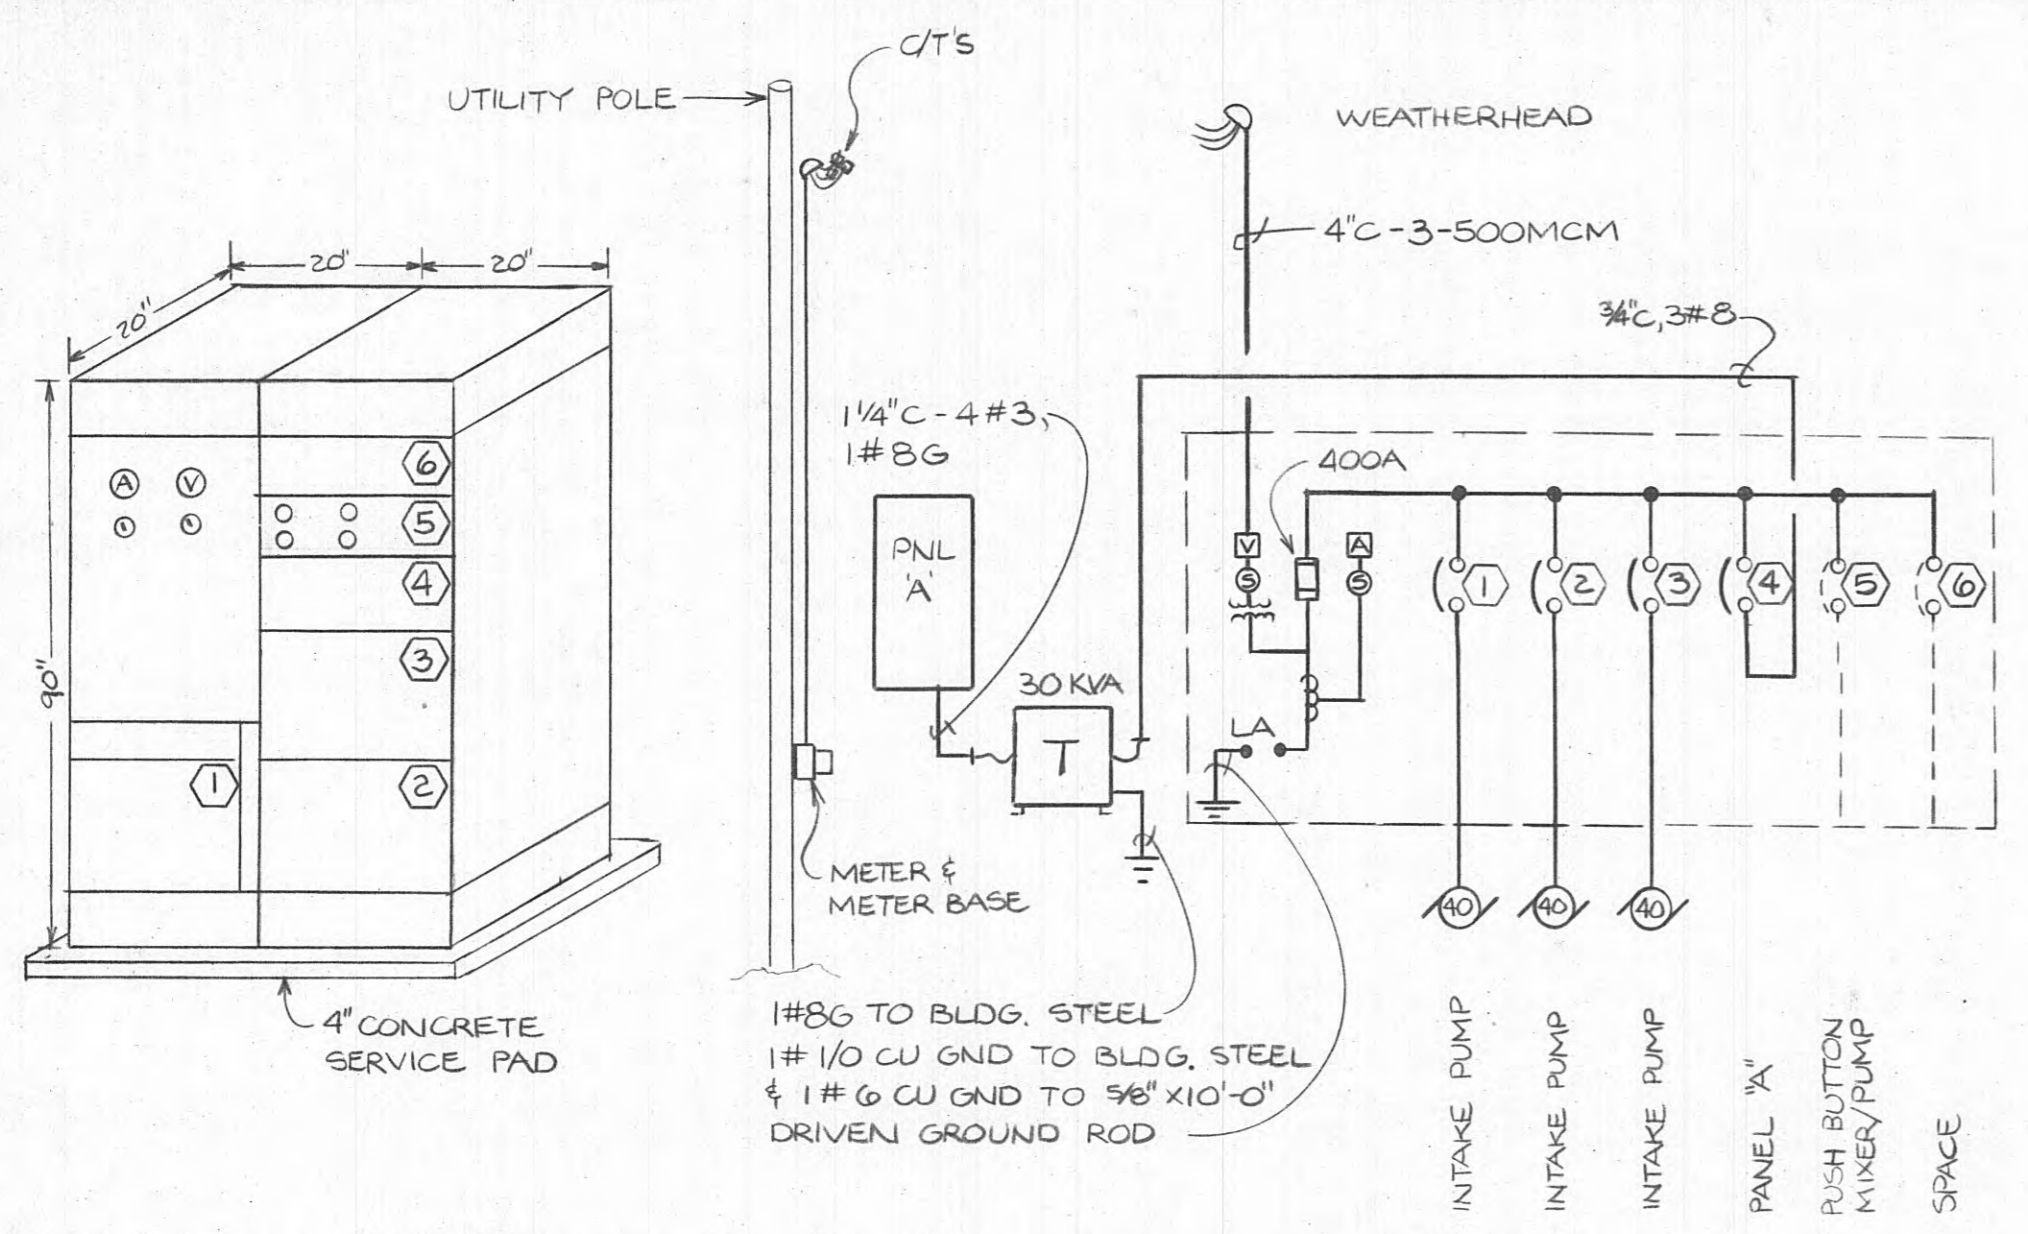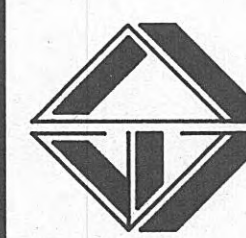

ELEVATION - MOTOR CONTROL CENTER "MCC2"

ONE LINE DIAGRAM & RISER - "MCC2"

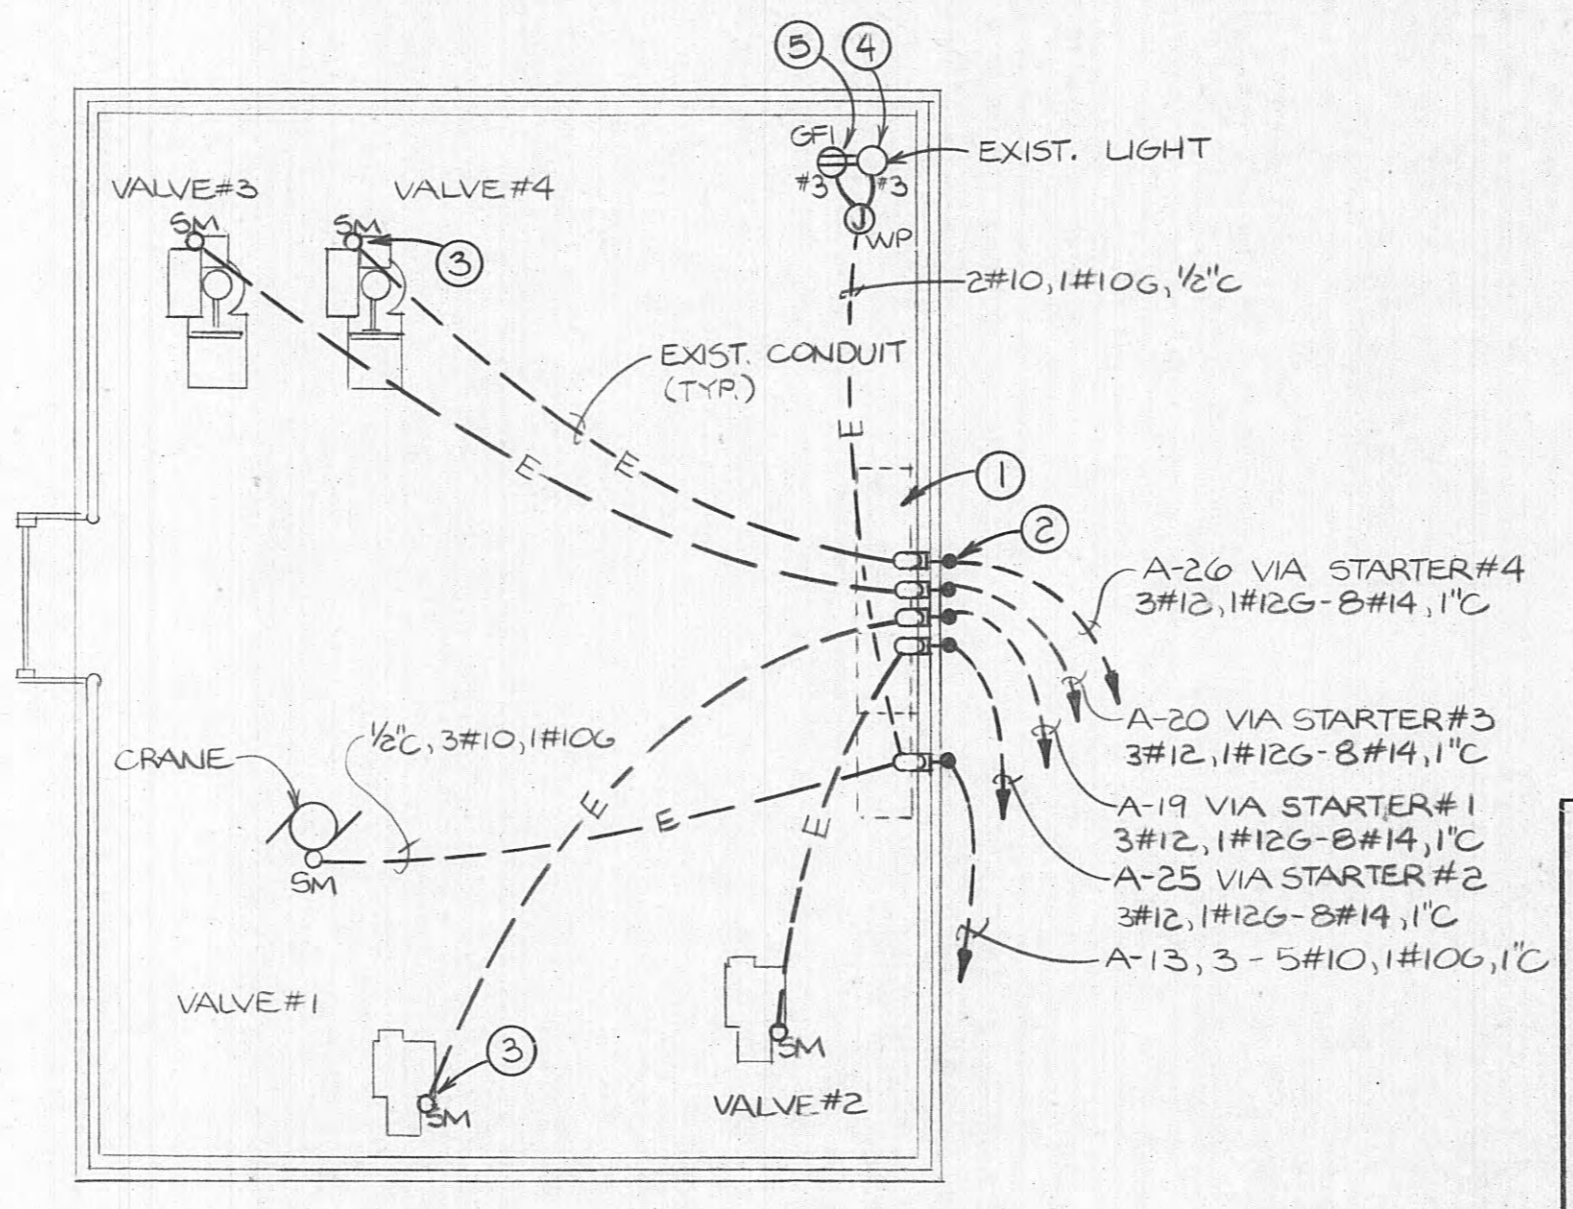

INTAKE STRUCTURE ELECTRICAL PLAN
SCALE 3/8" = 1'-0"


"MCC2"

MOTOR CONTROL CENTER SCHEDULE							
VOLTS, AMPS, & A.S.I.C.	BRANCH CIRCUIT BREAKER	STARTER	CONTROL ITEM ON STARTER	LOAD	CONDUIT & WIRE	FEEDS	
	CIR. NO.	AMPS	POLES	KVA	H.P.		
400A 480, 3PH 3 WIRE 25,000A	1	90	3	X-LINE NEMA SIZE 3	S-P-ETM-A	43.2 40 1-1/4" C 3#3 1#8G	INTAKE PUMP
	2	90	3	X-LINE NEMA SIZE 3	S-P-ETM-A	43.2 40 1-1/4" C 3#3 1#8G	INTAKE PUMP
	3	90	3	X-LINE NEMA SIZE 3	S-P-ETM-A	43.2 40 1-1/4" C 3#3 1#8G	INTAKE PUMP
	4	45	3	CIRCUIT BREAKER	-	23.6 - 3/4" C 3#8 1#10G	TRANSF "A"
	5	-	3	SPACE W/PROVISIONS	-	-	-
	6	-	3	SPACE W/PROVISIONS	-	-	-

STARTER CONTROL ITEM LEGEND
S - START/STOP PUSHBUTTONS A - AMMETER
P - PILOT LIGHT (GREEN) ETM - ELAPSED TIME METER
H - HAND-OFF AUTO SEL. SWITCH
PF - PHASE FAILURES RELAY W/ADJUSTABLE TIME DELAY

PANEL 'A'


LOCATION	WATTS/PHASE			C/B SIZE	CKT. NO.	C/B SIZE	WATTS/PHASE			LOCATION
	A	B	C				A	B	C	
LTS - PUMP BLDG	850			20/1	1 2	20/1	900			RECEPT - PUMP BLDG.
LT/RECEPT-INTAKE STRUCTURE		210		20/1	3 4	20/1				SPARE
					5 6	20/1				SPARE
EH - 7	1667			20/3	7 8	30/3	2500			EH - 8
		1667			9 10			2500		
			1667		11 12				2500	
CRANE	1707			20/3	13 14	20/1	670			MIXER
		1707			15 16	20/1		670		PERMANGANATE PUMP
			1707		17 18					
VALVE #1	200			15/3	19 20	15/3	200			VALVE #3
		200			21 22			200		
			200		23 24				200	VALVE #4
VALVE #2	200			15/3	25 26	15/3	200			
		200			27 28			200		
			200		29 30				200	
					31 32					VF-7
					33 34					
					35 36					
					37 38					
					39 40					
					41 42					
TOTAL	4624	3984	3774				4470	3570	2900	TOTAL
	LCL 1060 W X 1.25 =			1325	W		9094	7554	6674	PHASE TOTAL
AC =	W; HEAT = 12500 W AC @ 125% HT @ 100% =			12500	W		23322			TOTAL WATTS
	MISC. LOAD =			9762	W		LARGEST LOAD OF AC OR HEAT IS USED IN CALCS EXCEPT IN THE CASE OF HEAT PUMPS IN WHICH BOTH LOADS ARE USED.			
	TOTAL LOAD =			23587	W =		65.5 AMPS			

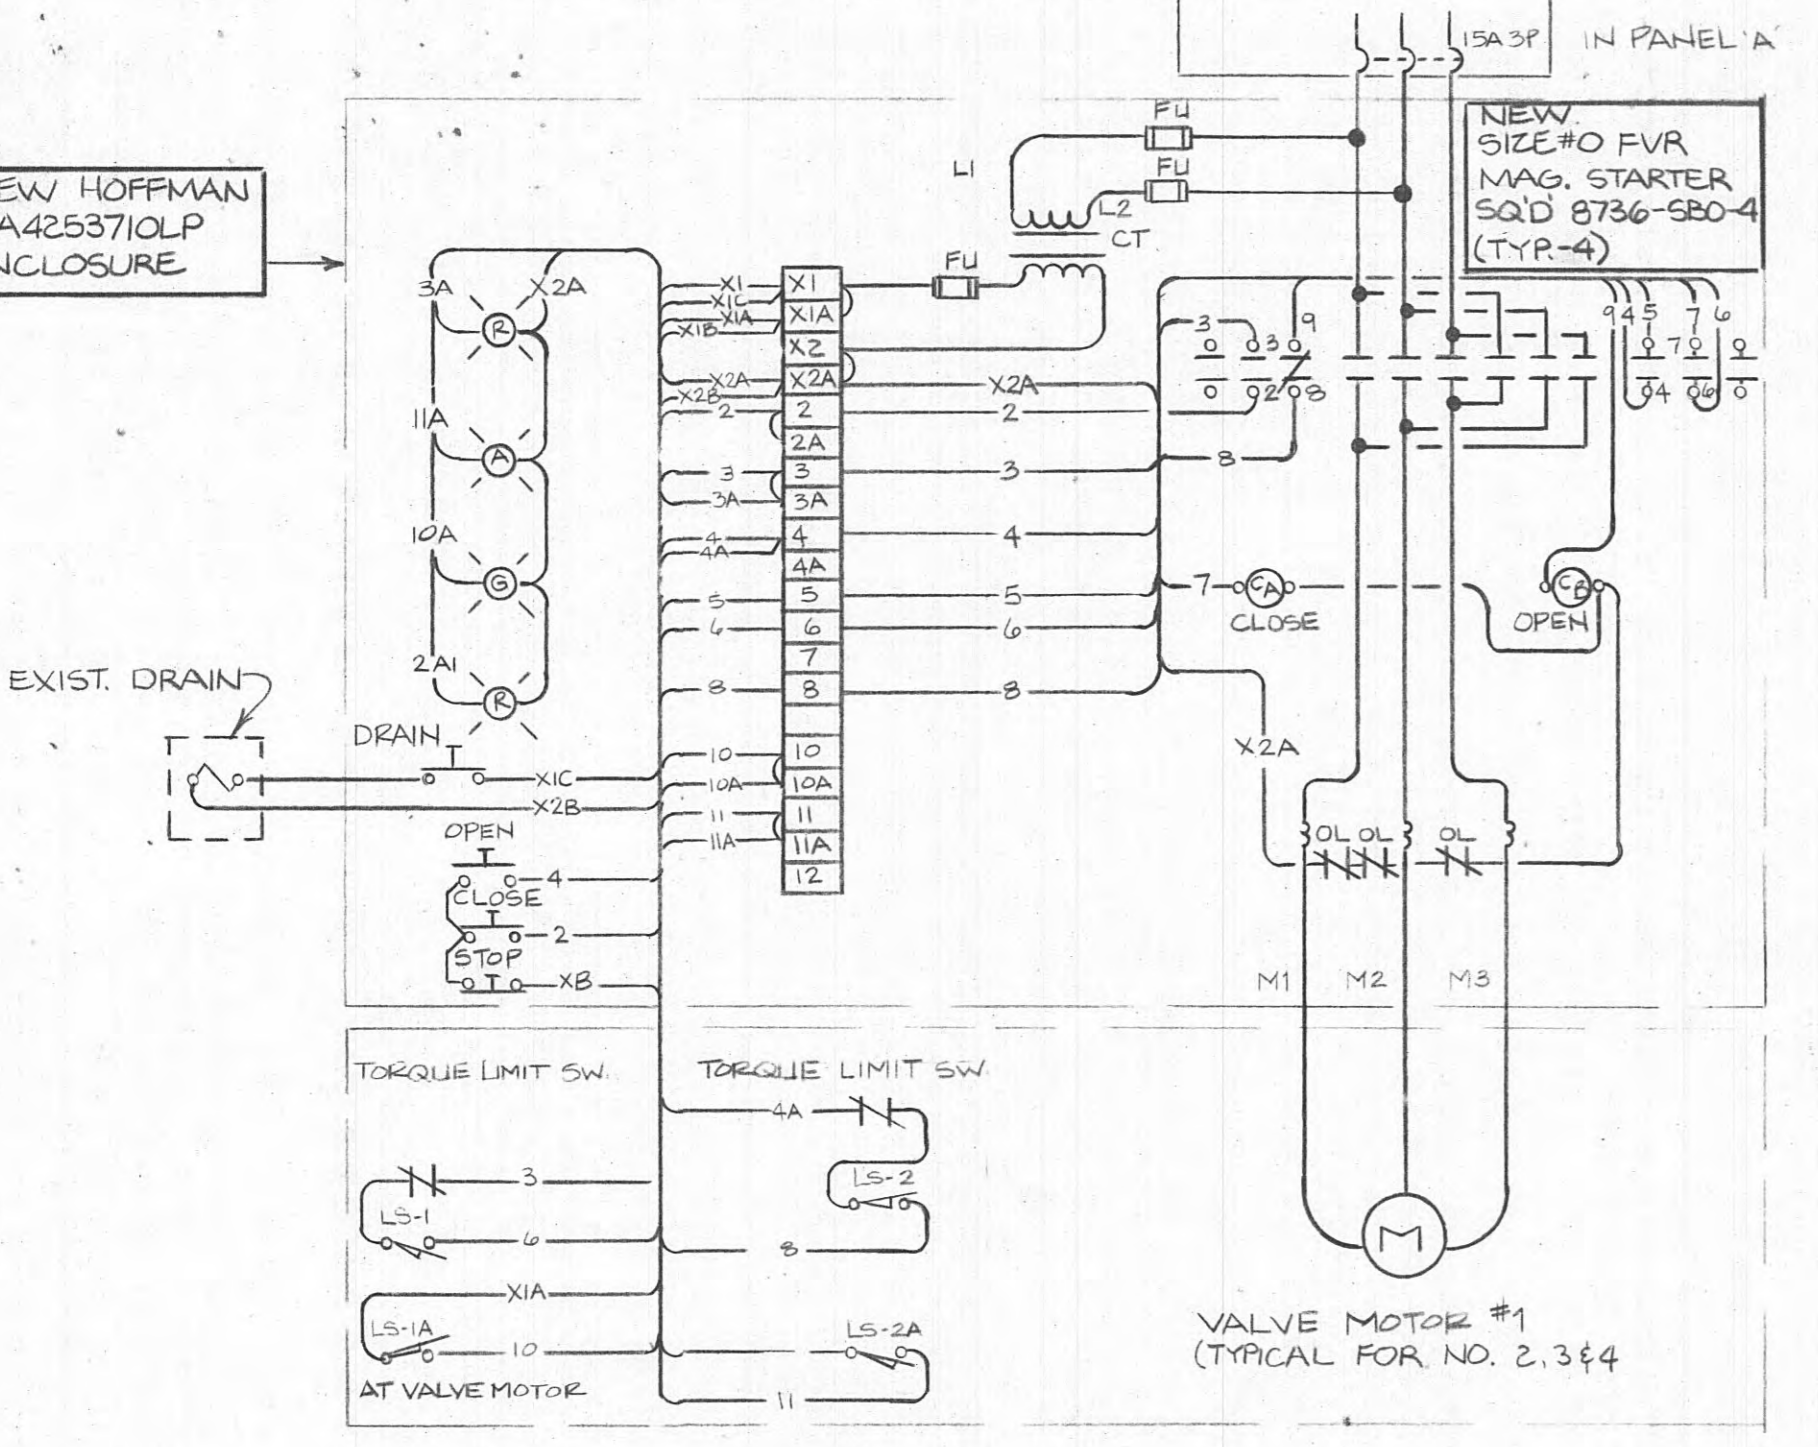


TYPICAL VALVE MOTOR SCHEMATIC DIAGRAM
NO SCALE

NOTE: PROVIDE NEW ENCLOSURE & MAG STARTERS. RELOCATE ALL OTHER WIRING DEVICES FROM OLD ENCLOSURE TO NEW ENCLOSURE (SEE WATER INTAKE BLDG. FOR NEW LOCATION)

- ELECTRICAL NOTES: E-7
- REMOVE EXISTING PUMP CONTROL PANEL AND EXISTING PANEL "A".
 - INTERCEPT EXISTING 1" CONDUITS STUBBED UP WITH NEW PULL, 90 ELBOW. ROUTE NEW 1" CONDUITS DOWN EXISTING STRUCTURE TO NEW PUSH BUTTON STATION LOCATION.
 - REMOVE EXISTING FLEXIBLE CONNECTION AND INSTALL NEW RIGID CONDUIT UP ABOVE 770.5' FLOOD ELEVATION. INSTALL NEW 3-POLE MANUAL SWITCH EQUAL TO SQUARE D CLASS 2510 NEMA 4 ENCLOSURE. TYPICAL FIVE LOCATIONS.
 - CLEAN AND RELAMP EXISTING LIGHT FIXTURE.
 - INSTALL NEW GFI RECEPTACLE ON EXISTING LIGHT ABOVE 770.5' FLOOD ELEVATION.
 - REMOVE EXISTING TELEMETRY EQUIPMENT AT THE EXISTING WATER PLANT FOR REMOTE TANK LEVEL INDICATORS AND RELOCATE TO THE ELECTRICAL CLOSET IN THE FILTER BUILDING NEXT TO THE SCADA PANEL. FINAL CONNECTION OF TELEMETRY EQUIPMENT SHALL BE BY OTHERS.
 - MAINTAIN POWER TO ONE OF THE RAW WATER PUMPS AT ALL TIMES DURING CONSTRUCTION. RELOCATE EXISTING EQUIPMENT OR PROVIDE TEMPORARY SERVICE FOR MAINTAINING PUMP POWER AS NECESSARY. COORDINATE WITH ENGINEER AS TO WHICH PUMP IS REQUIRED TO MAINTAIN SERVICE.

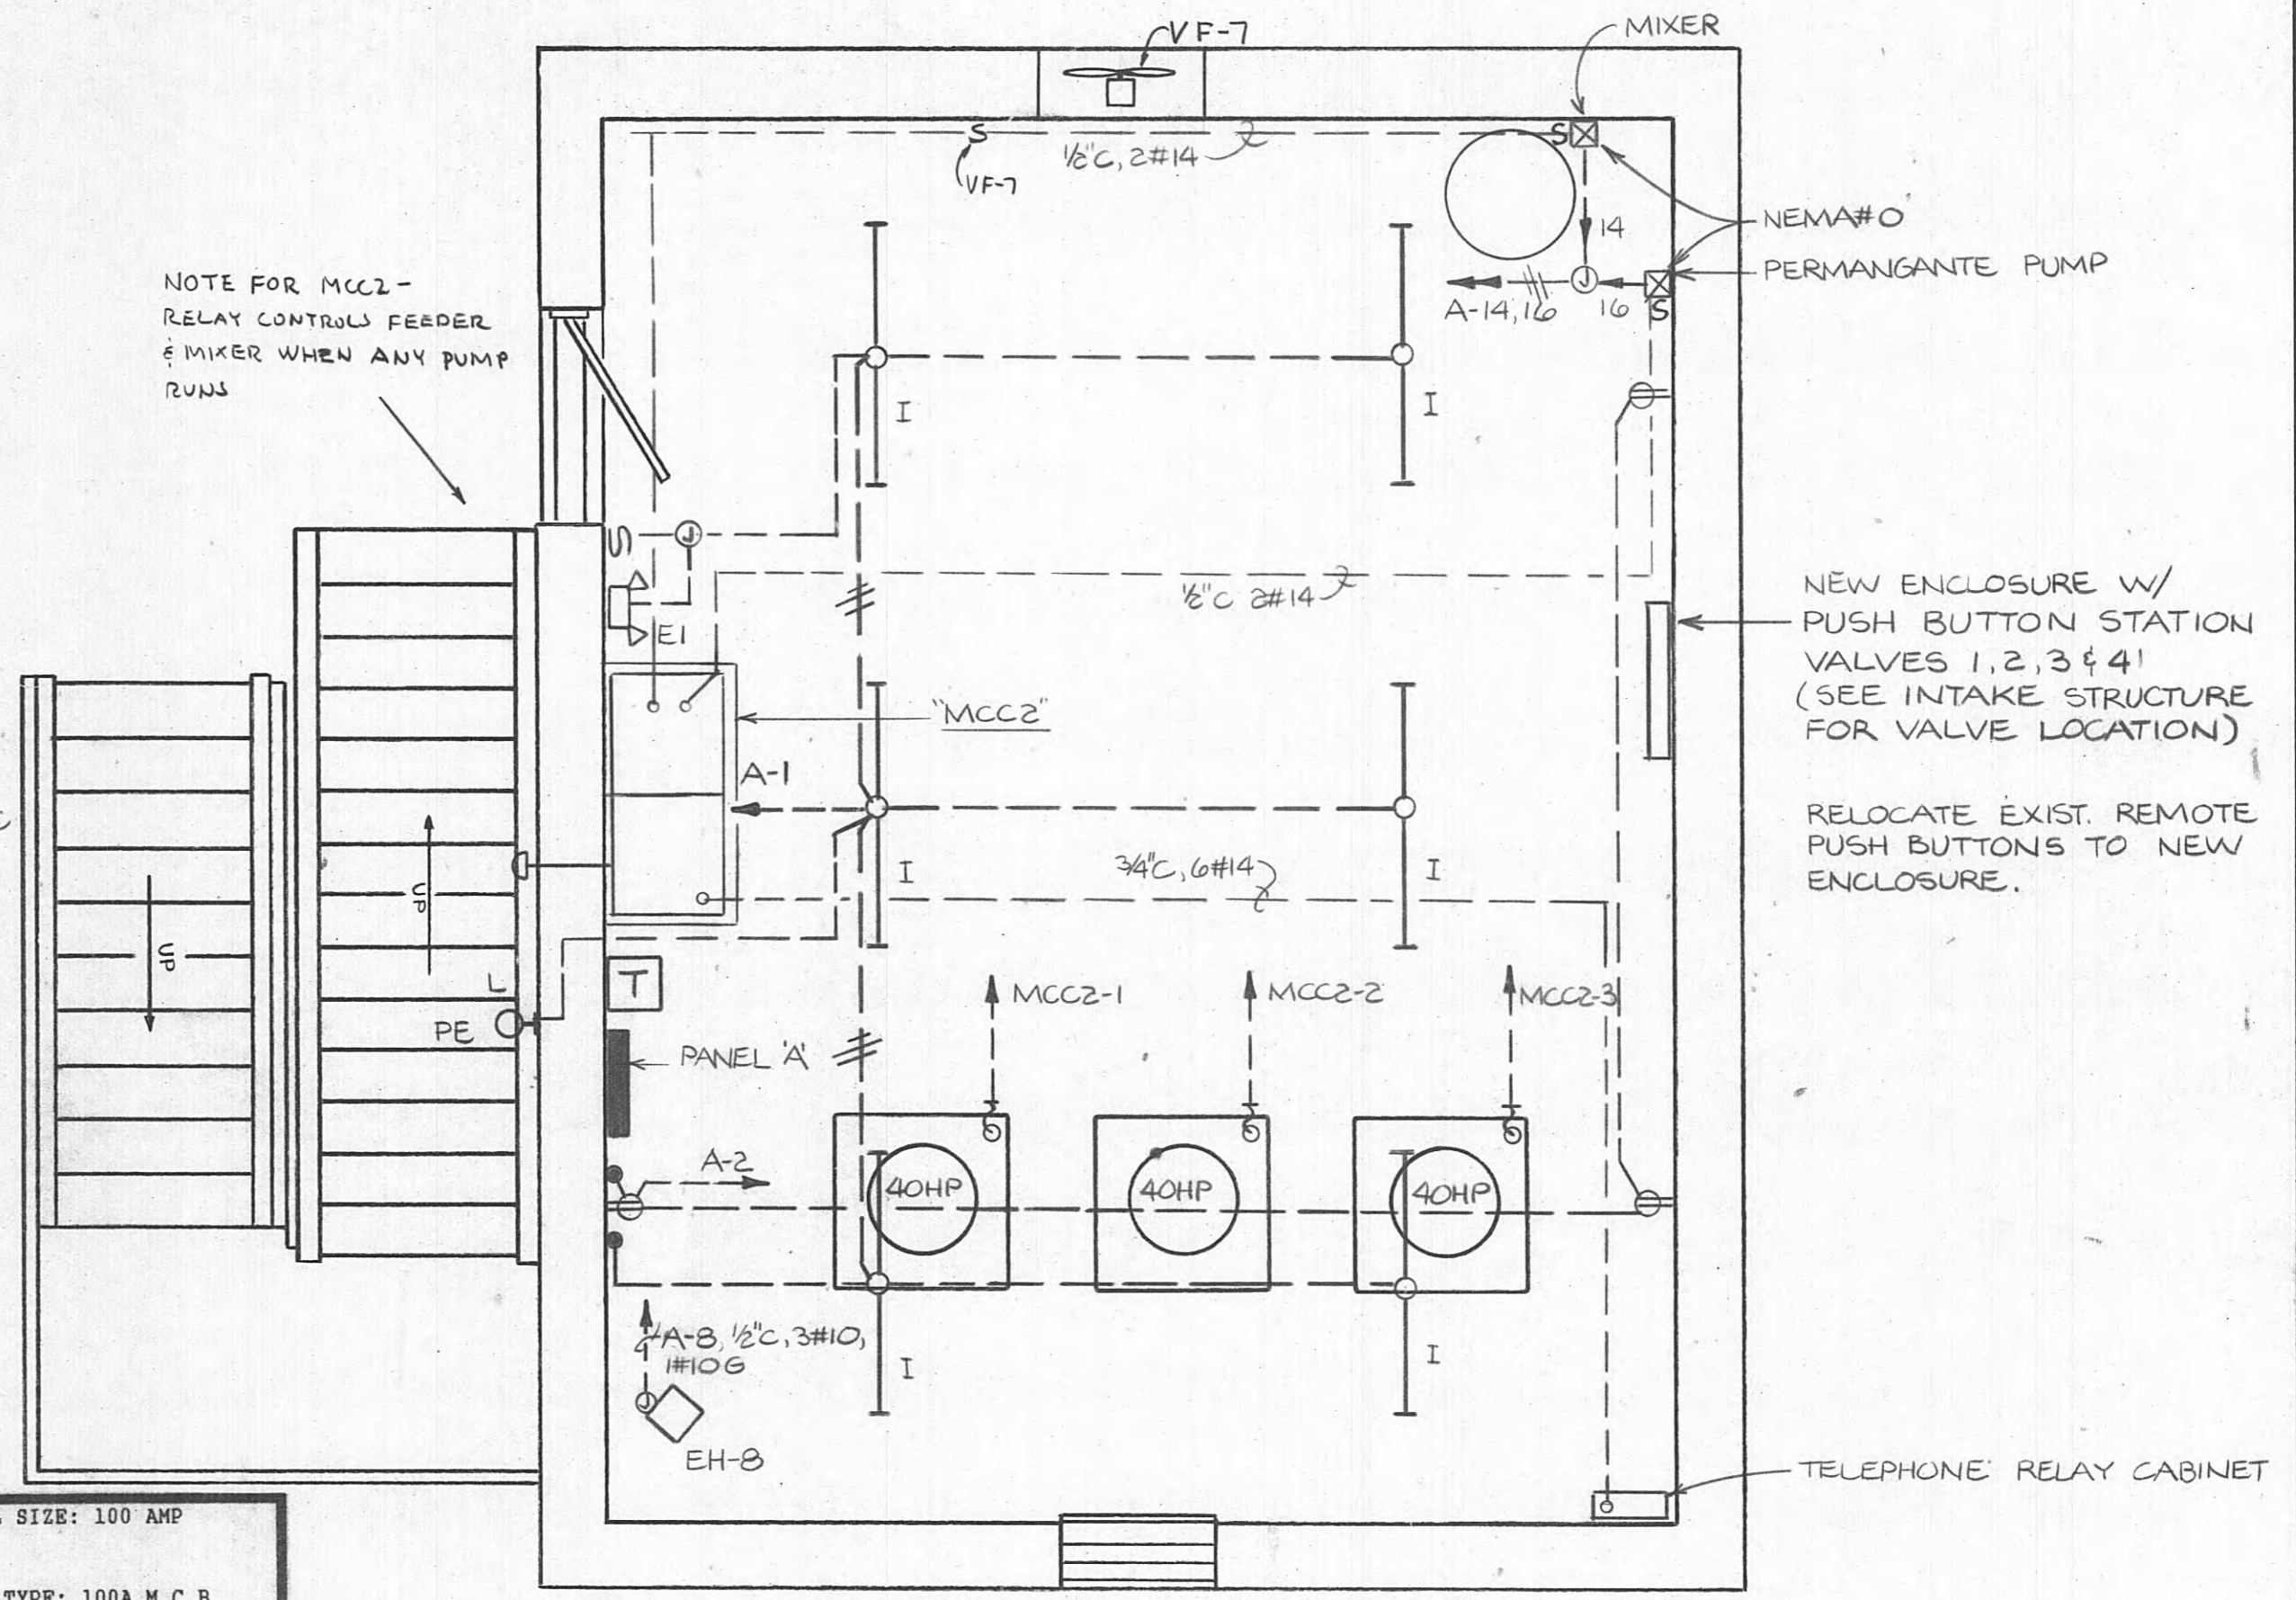

ELEVATION 778.06

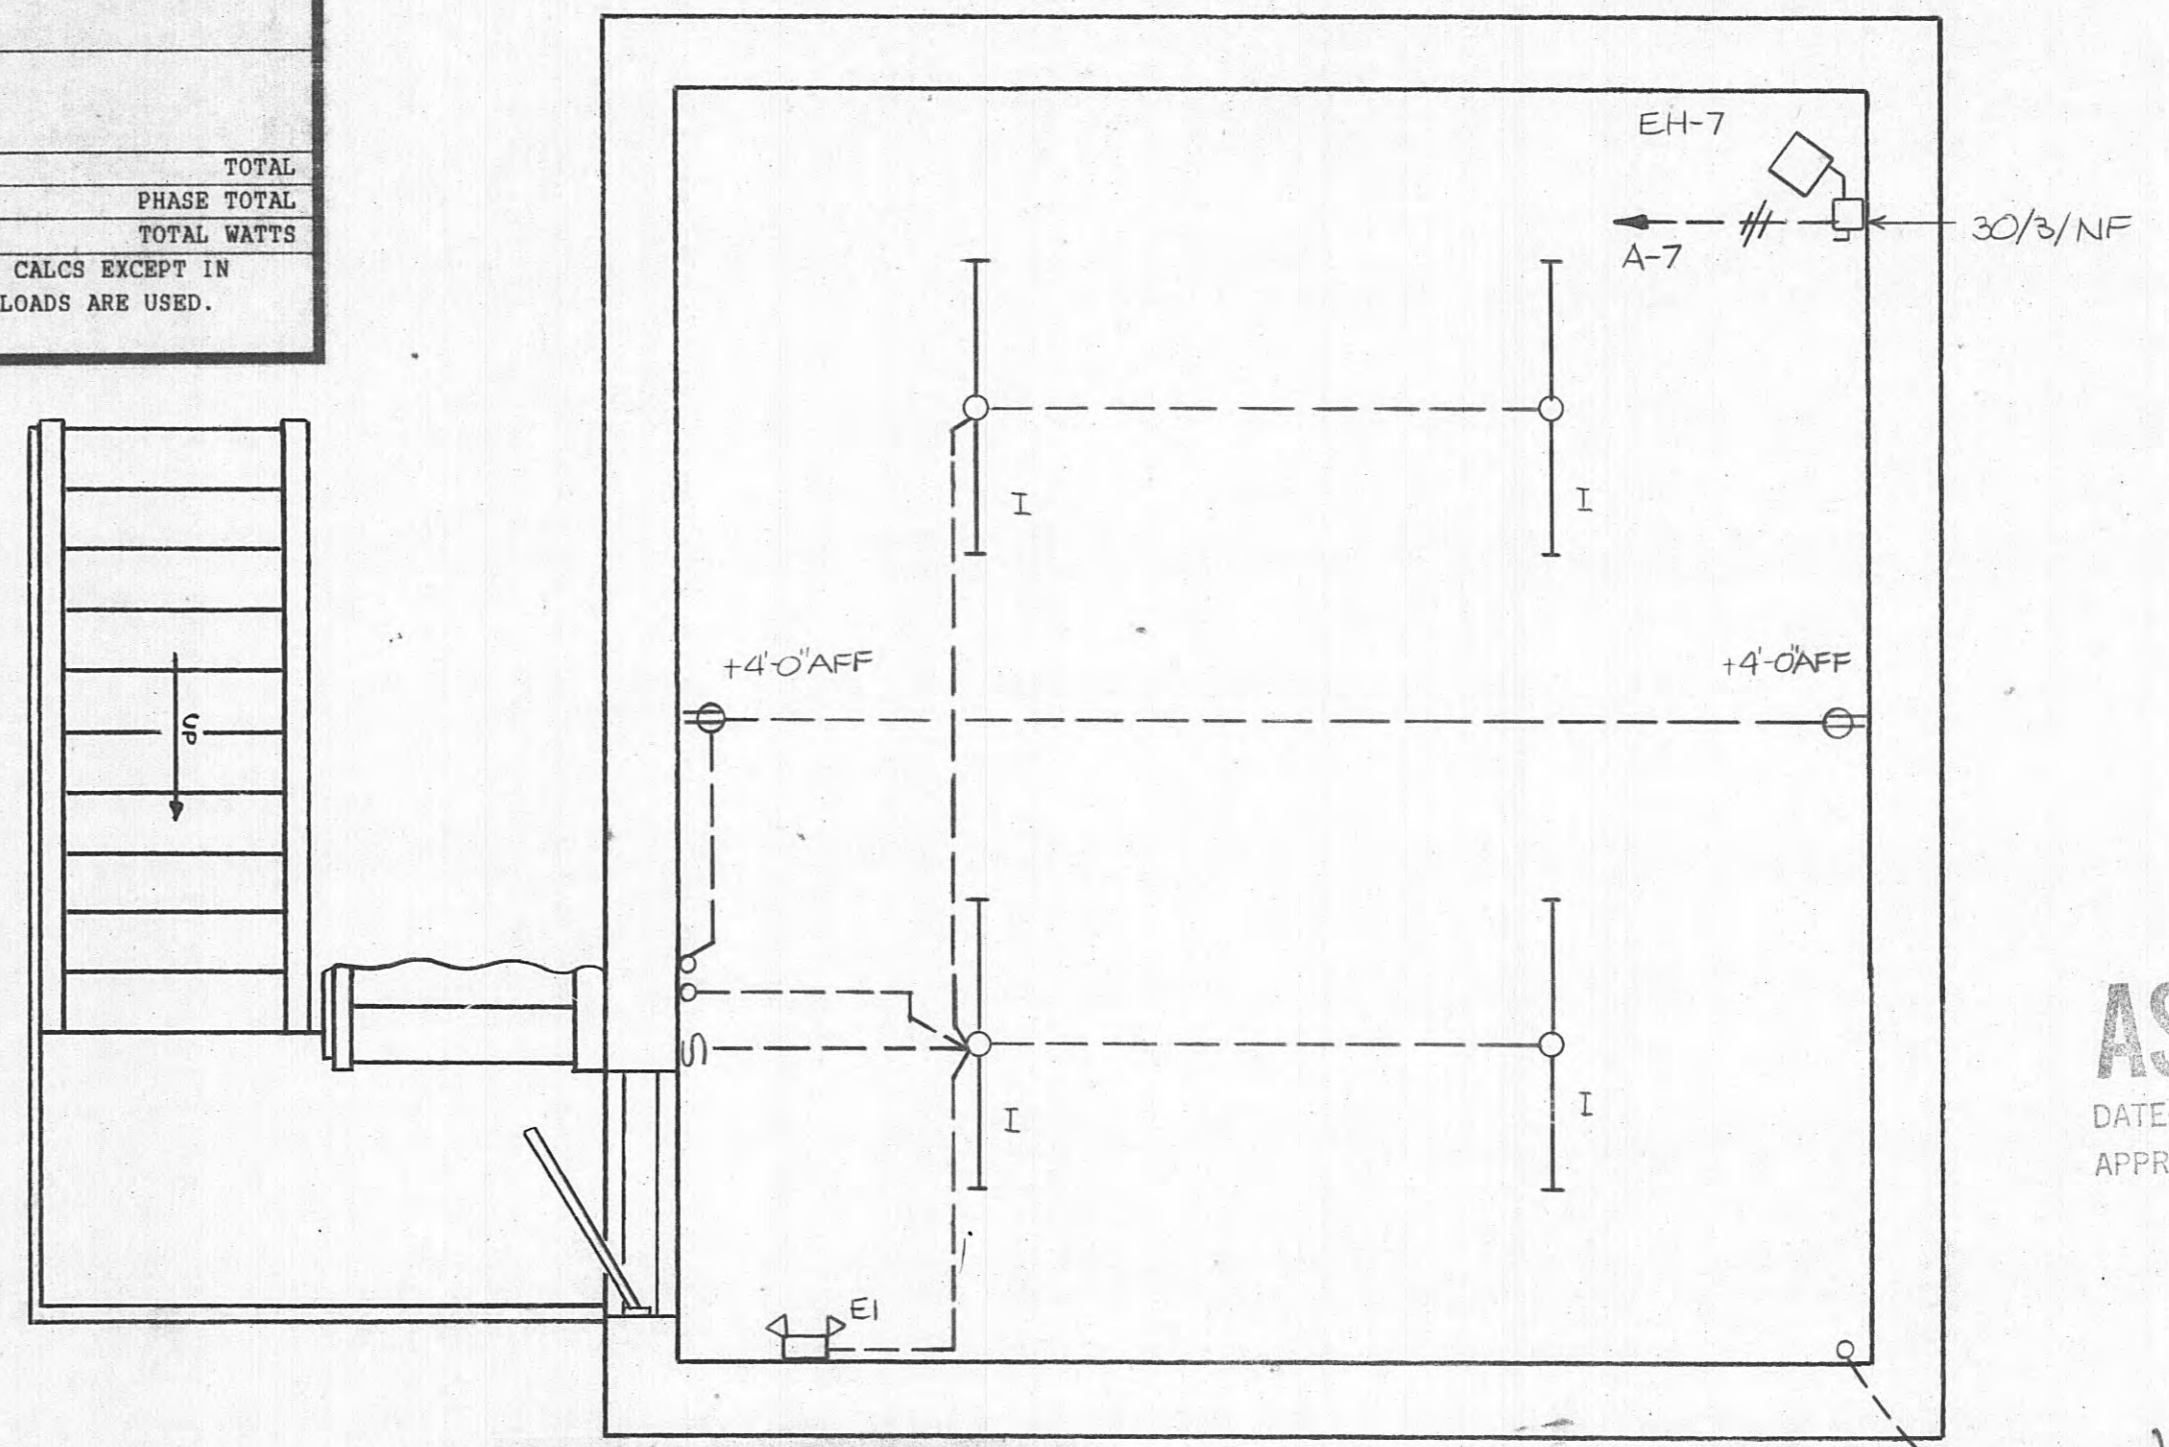

ELEVATION 768.35


WATER INTAKE BUILDING ELECTRICAL PLAN
SCALE: 3/8" = 1'-0"

AS BUILT
DATE: 3-20-95
APPROVED: [Signature]




1" PVC, 4 PAIR SHIELDED TELEPHONE CABLE TO FILTER BUILDING SEE SH. E-8

DUFF BROWN ENGINEERING INC.
783 OLD HICKORY BLVD. BRENTWOOD, TN. 37027 (615) 377-3757


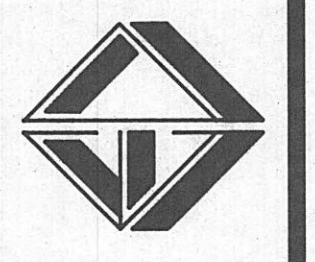


REVISIONS


DESIGNED: D.L.S.
 DRAWN: M.Z.A.
 CHECKED: H.H.D.
 DATE: MARCH 31, 1993
 SCALE: 1" = 50'
 PROJ. NO. 0592

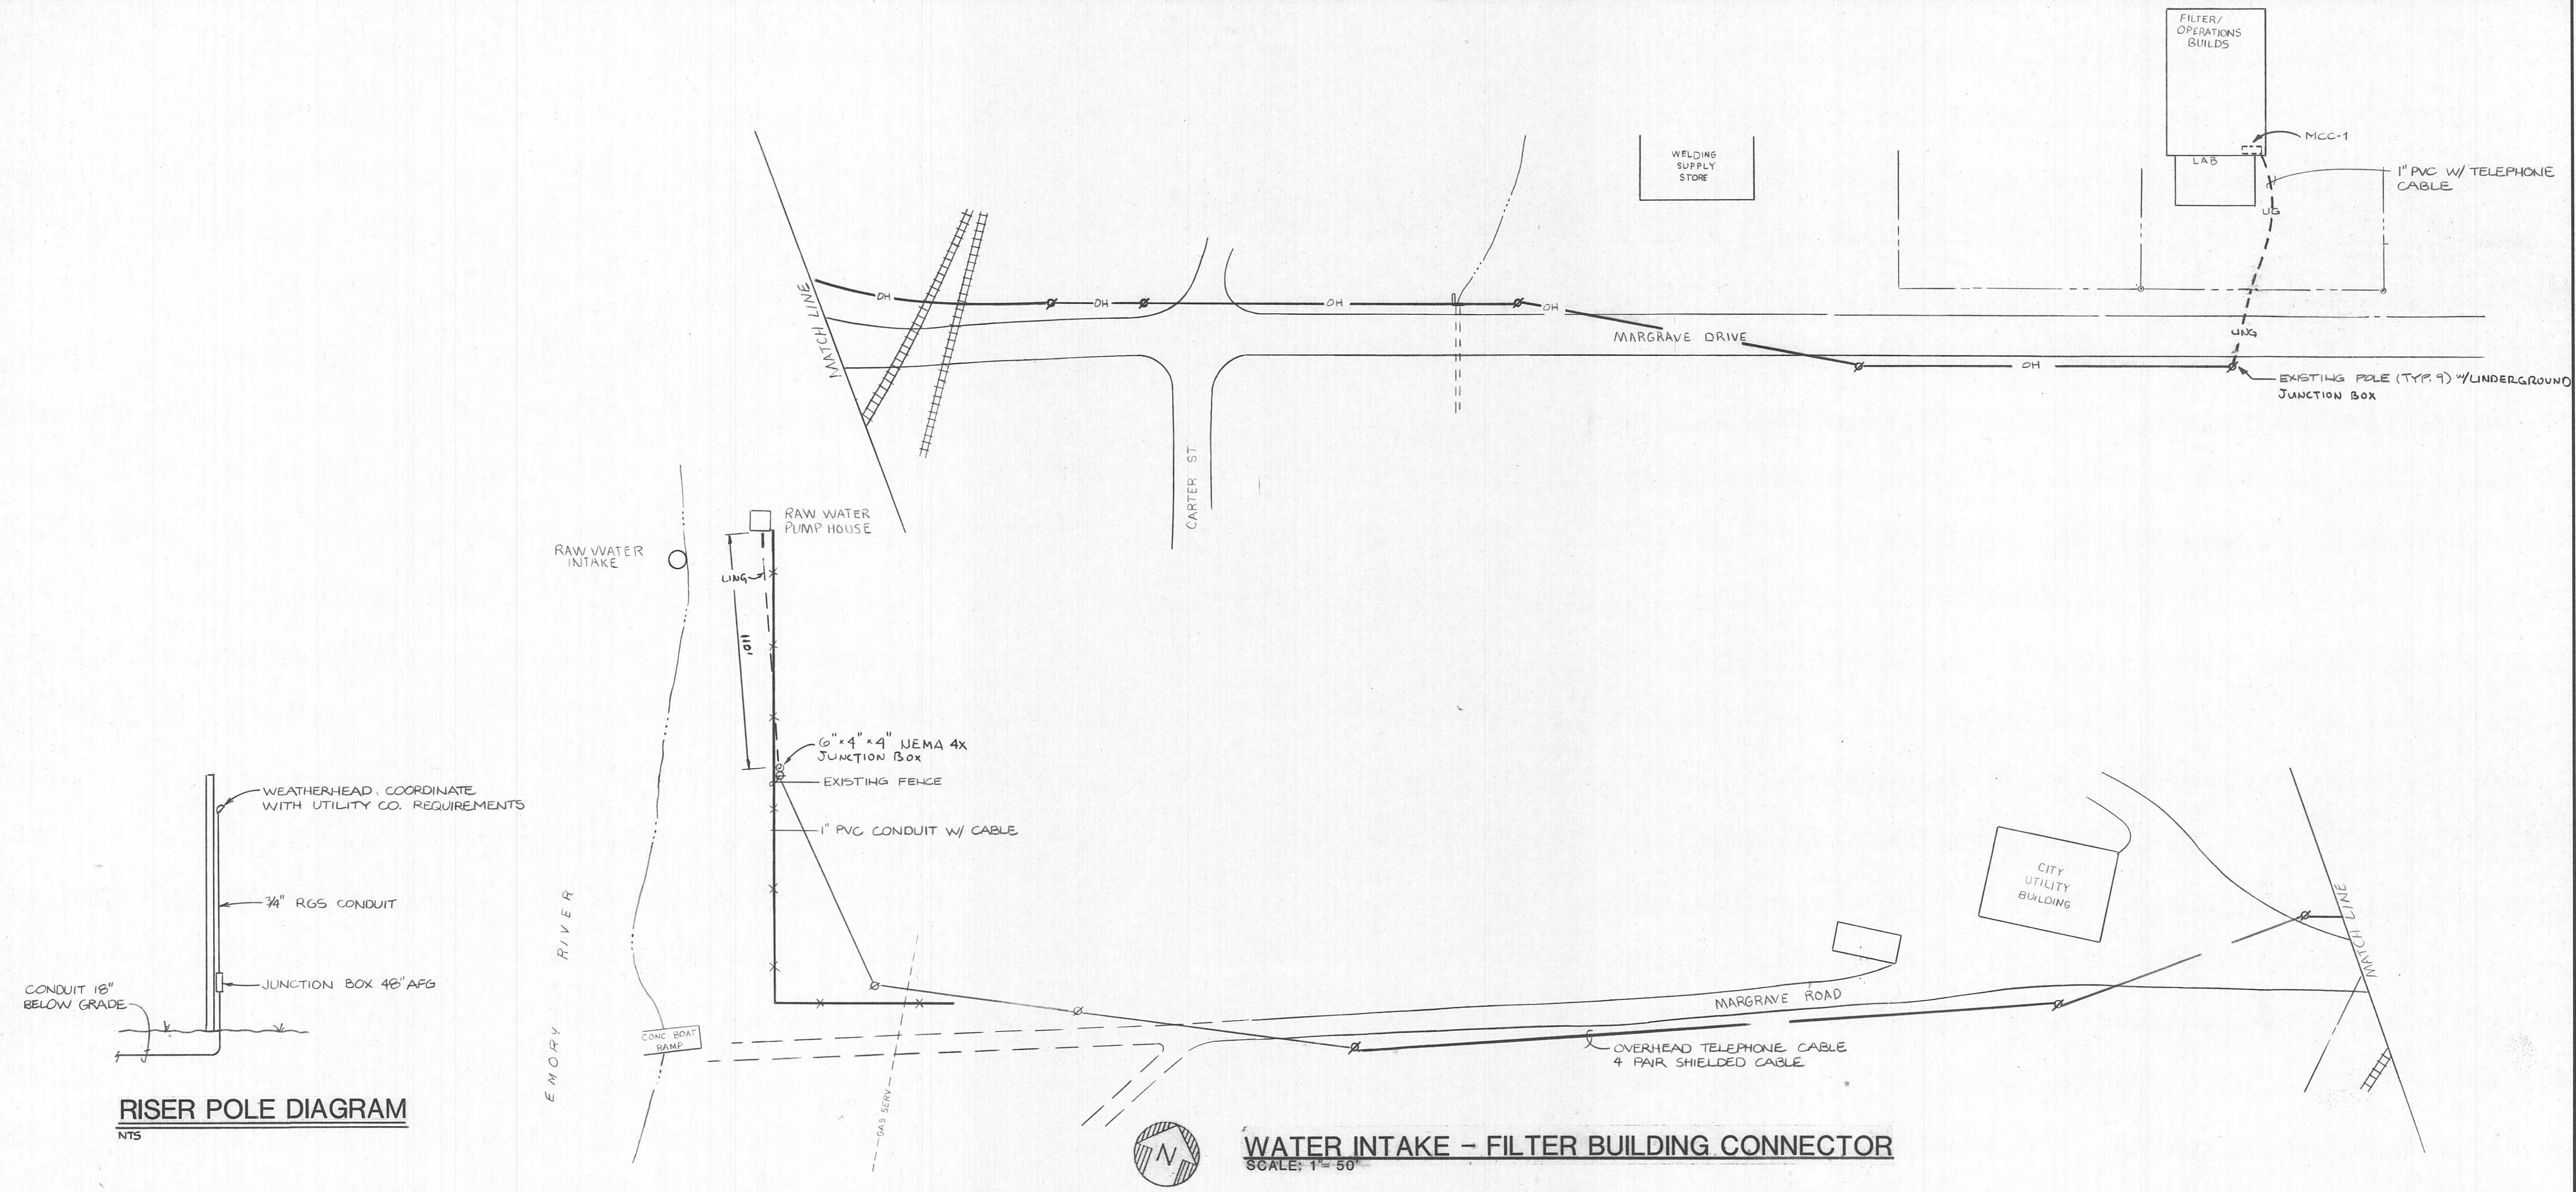

WATER INTAKE - FILTER BUILDING CONNECTOR
 SCALE: 1" = 50'

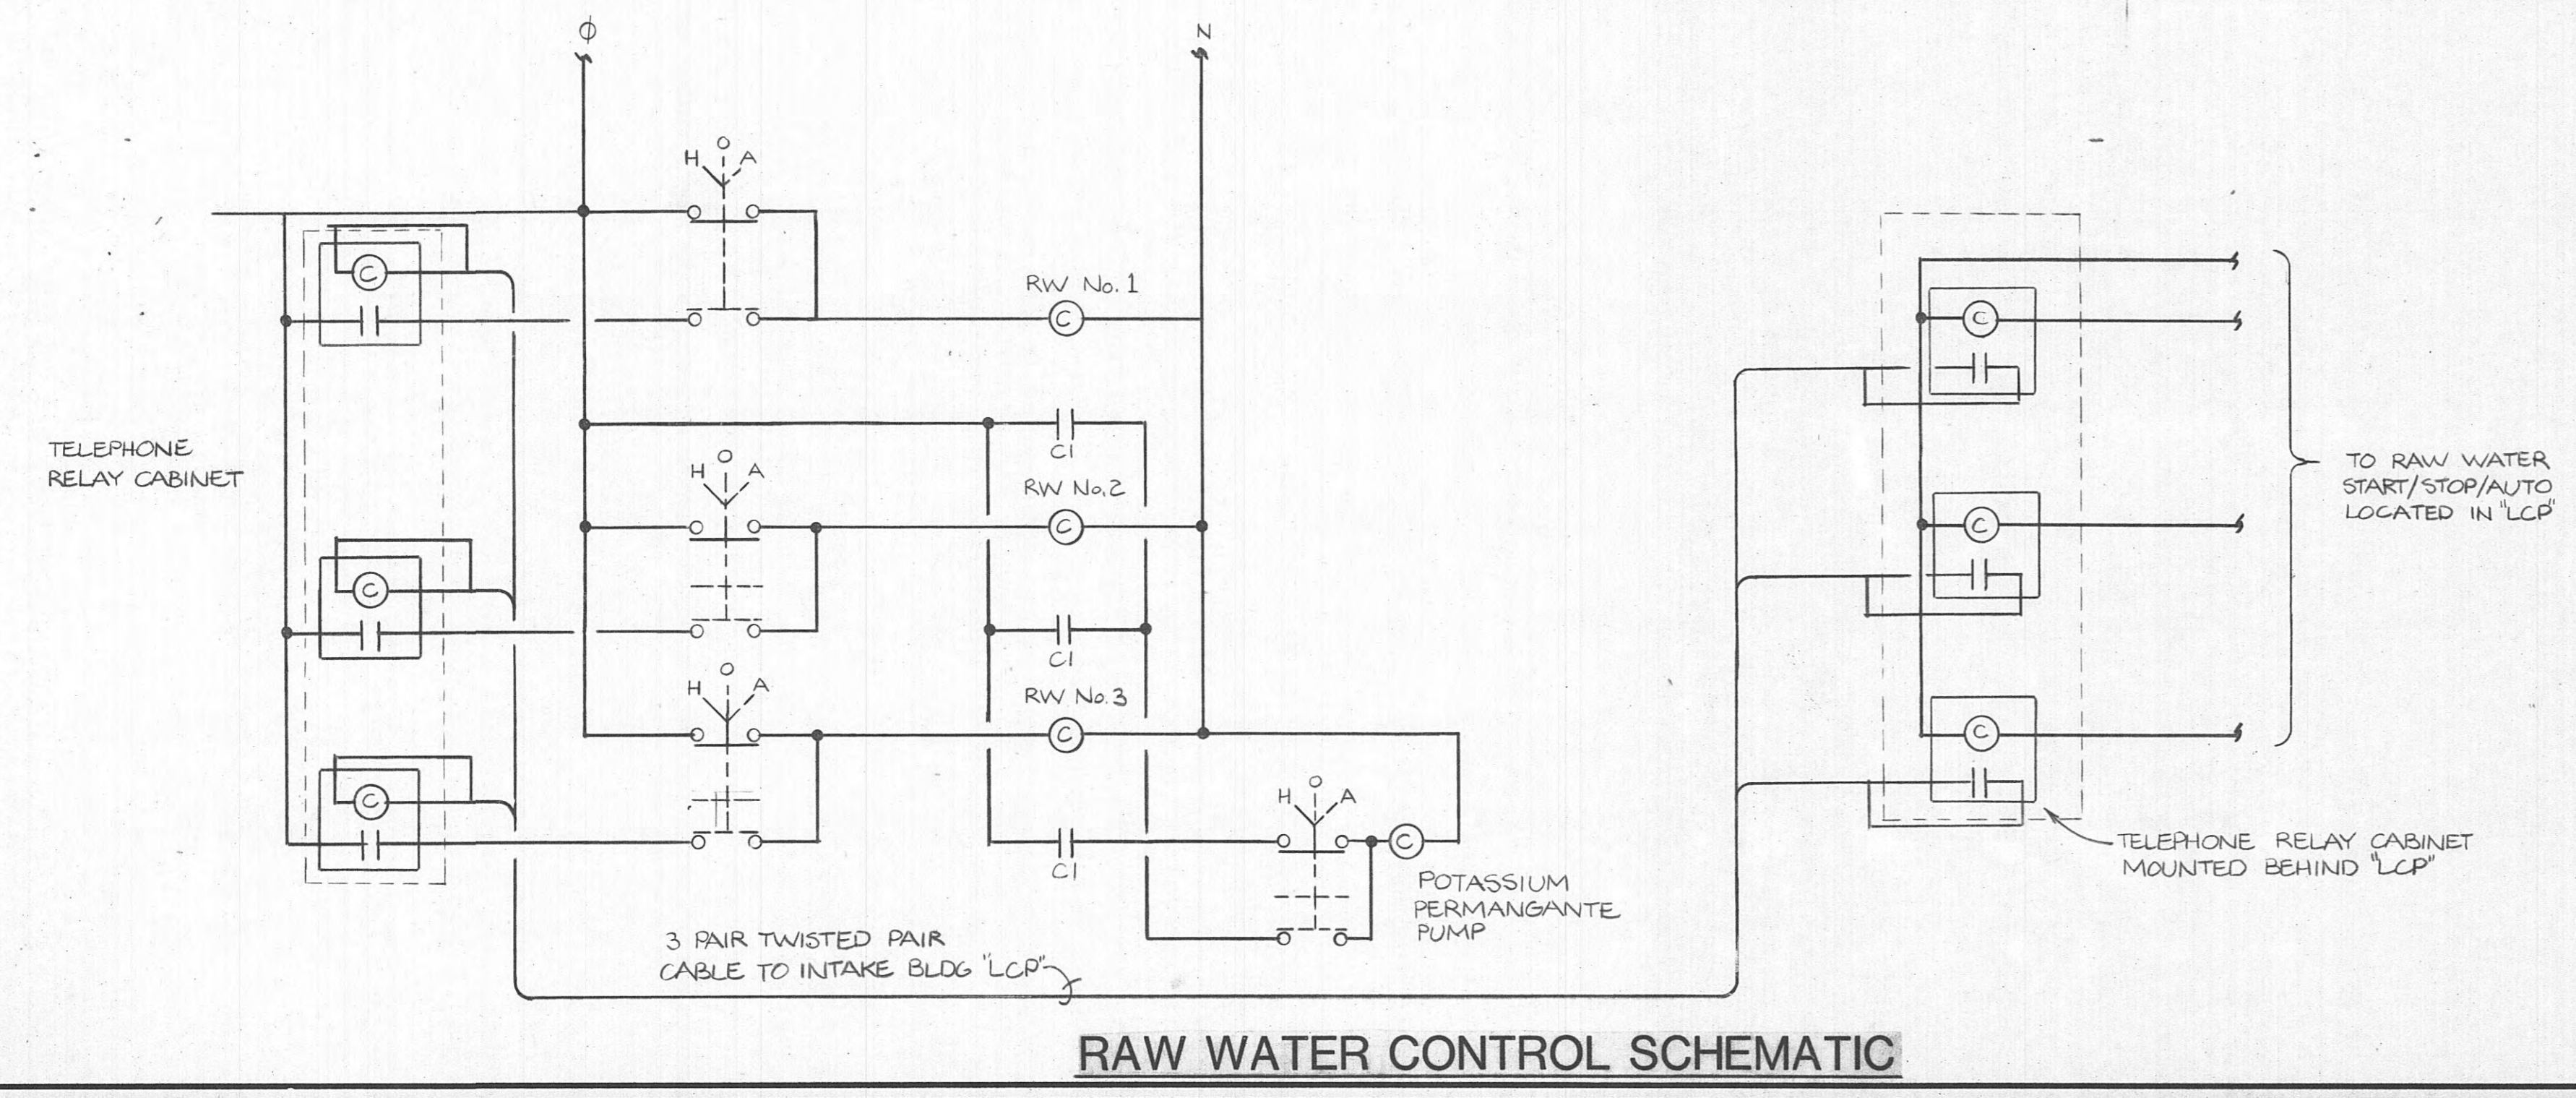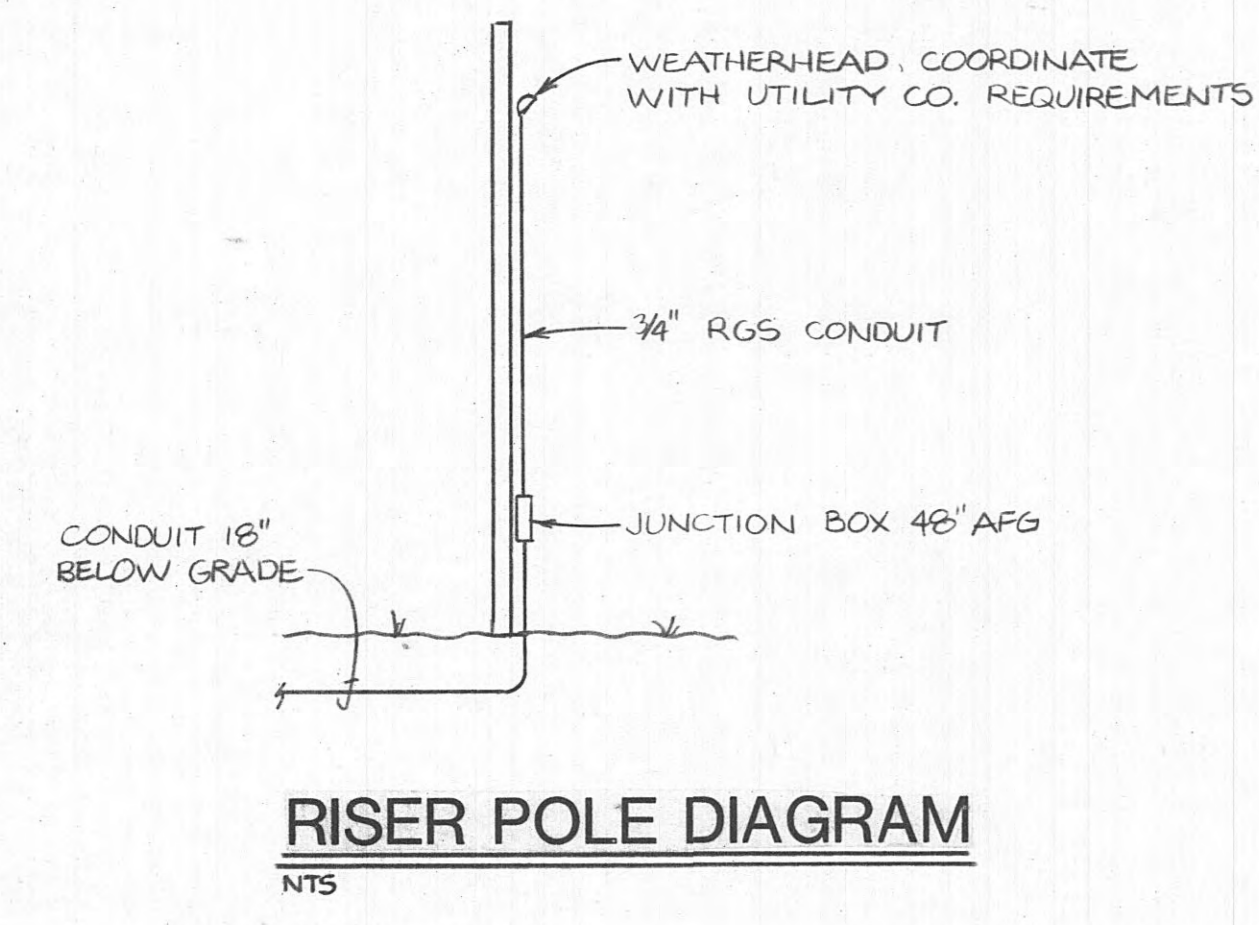

AS BUILT
 DATE: 3-20-95
 APPROVED: D.M.

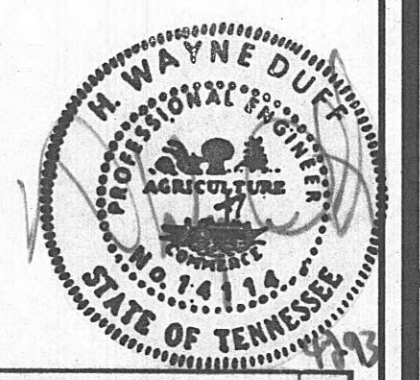


DUFF BROWN
 ENGINEERING INC.
 783 OLD HICKORY BLVD. BRENTWOOD, TN. 37027 (615) 377-3757

KEY NOTES

- 1 AIR HANDLING UNIT #1 NOMINAL 6 TON.
- 2 4" CONCRETE PAD.
- 3 FLEX CONNECTOR.
- 4 WEATHER PROOF DUCTWORK.
- 5 SHEET METAL SHROUD.
- 6 CHASE BY GENERAL CONTRACTOR.
- 7 MANUAL VOLUME DAMPER (TYPICAL).
- 8 SIDEWALL RETURN GRILLE MOUNTED 6" ABOVE FINISHED FLOOR.
- 9 8" ROUND TOILET EXHAUST UP TO ROOFJACK.
- 10 THERMOSTAT MOUNTED 48" ABOVE FINISHED FLOOR.
- 11 NOT USED


- 12 SEE AIR DEVICE SCHEDULE FOR RUNOUT SIZE (TYPICAL).
- 13 UNIT HEATER SHALL BE MOUNTED 12'-0" ABOVE FINISHED FLOOR (TYPICAL).
- 14 7" ROUND FLUE UP TO APPROVED CAP.
- 15 5" ROUND FLUE UP TO APPROVED CAP.
- 16 ELECTRIC UNIT HEATER MOUNTED 7'-6" ABOVE FINISHED FLOOR.
- 17 EXPLOSION PROOF ELECTRIC UNIT HEATER MOUNTED 10'-0" ABOVE FINISHED FLOOR.
- 18 VENTILATION FAN MOUNTED 10'-0" ABOVE FINISHED FLOOR.
- 19 VENTILATION FAN MOUNTED 7'-0" ABOVE FINISHED FLOOR.
- 20 VENTILATION FAN MOUNTED 1'-6" ABOVE FINISHED FLOOR.
- 21 NEW GAS METER LOCATED BY GAS COMPANY. ALL FEES SHALL BE PAID BY MECHANICAL CONTRACTOR. TOTAL CONNECTED LOAD 669 MBH AT 7" W.C.
- 22 72" X 48" OUTSIDE AIR INTAKE LOUVER WITH BIRDSCREEN (AS HIGH AS POSSIBLE).

- 23 30" X 24" INTAKE DUCT DOWN TO WITHIN 18" ABOVE FINISHED FLOOR. PROVIDE CORROSION RESISTANT DUCTWORK.
- 24 6" DIAMETER (SCREENED) INTAKE DUCT (AS HIGH AS POSSIBLE).
- 25 20" X 12" (SCREENED) INTAKE DUCT (AS HIGH AS POSSIBLE).
- 26 VENTILATION FAN INTERLOCKED WITH OUTSIDE AIR INTAKE LOUVER (MOUNTED AS HIGH AS POSSIBLE).
- 27 (2) 60" X 68" OUTSIDE AIR INTAKE LOUVERS (MOUNTED AS HIGH AS POSSIBLE). PROVIDE MOTOR ACTUATOR TO INTERLOCK WITH VENTILATION FAN.

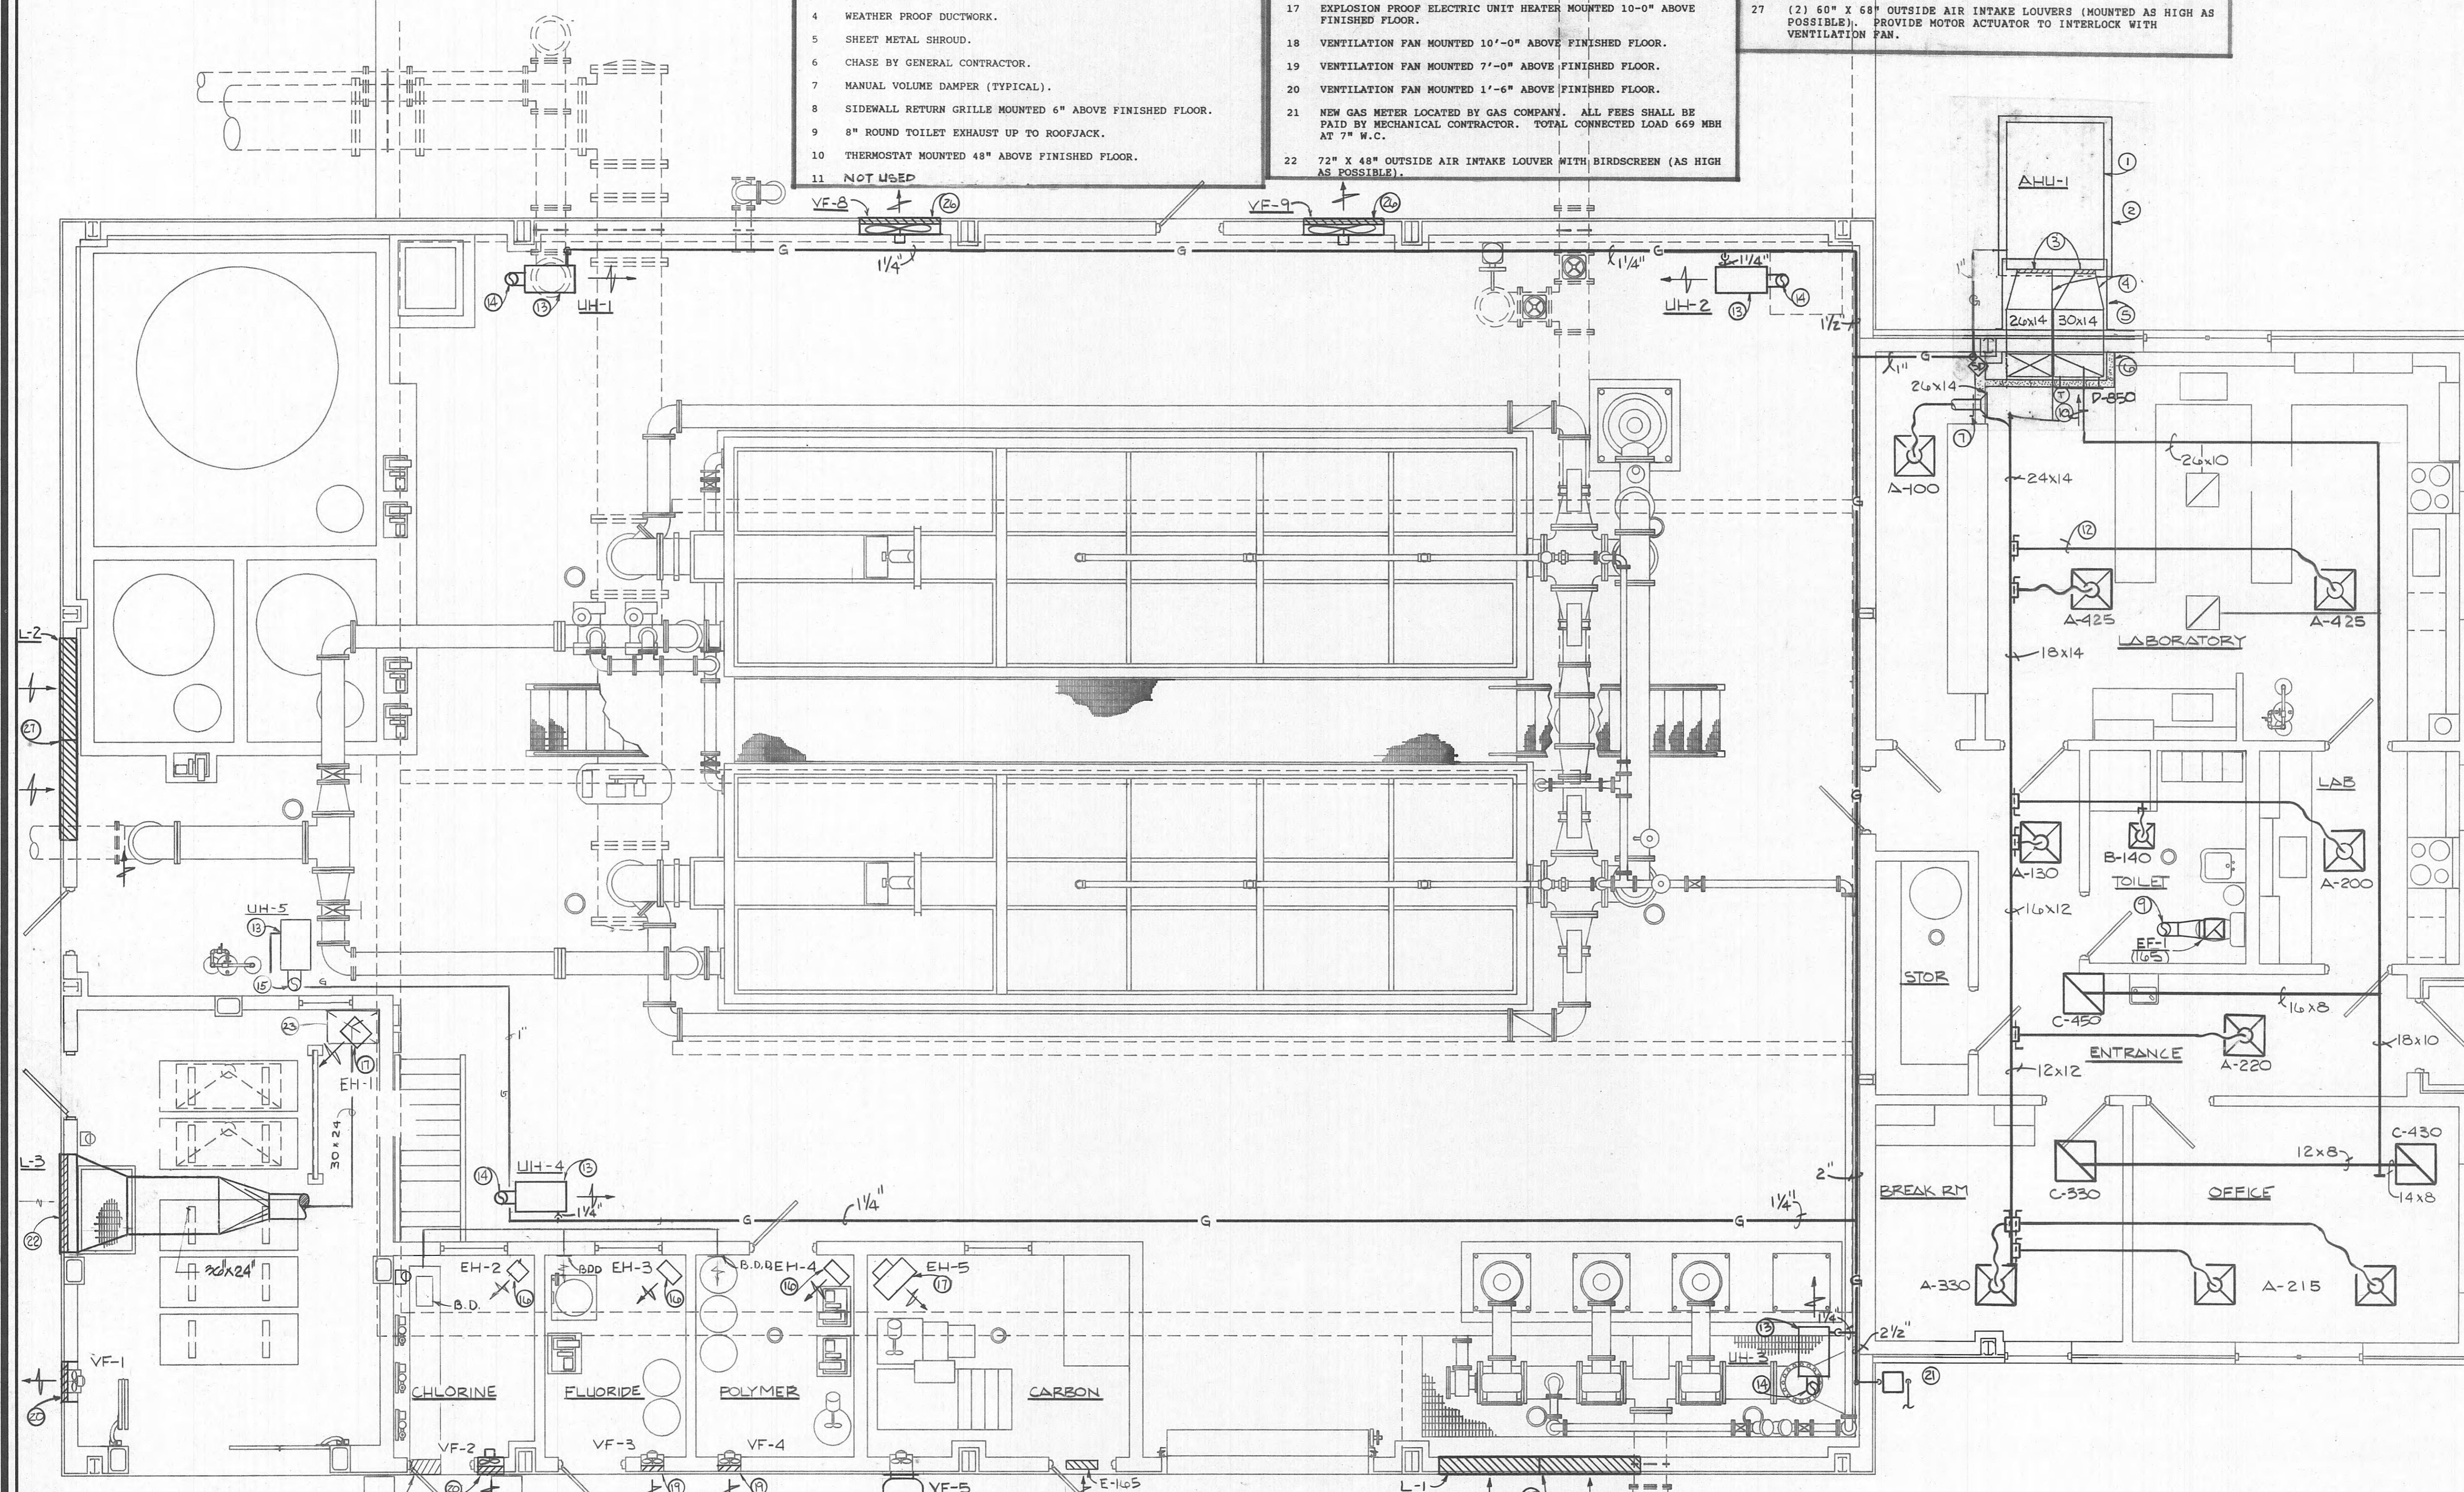


FILTER/OPERATIONS BLDG. MECHANICAL
SCALE: 1/4" = 1'-0"

AS BUILT
DATE: 3-20-95
APPROVED: *D.M.*

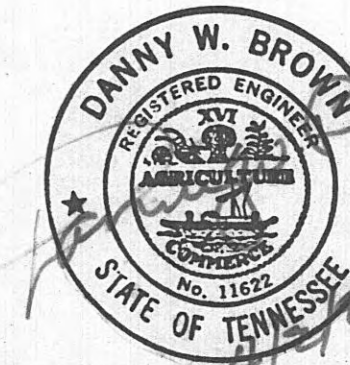

DUFF BROWN
ENGINEERING INC.
783 OLD HICKORY BLVD. BRENTWOOD, TN. 37027 (615) 377-3757

ELROD · DUNSON, INC.
CONSULTING ENGINEERS
NASHVILLE · KNOXVILLE
LEXINGTON, KY

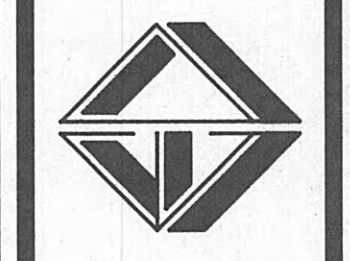

CONTRACT W63-04
HARRIMAN, TENNESSEE
FILTER BUILDING MECHANICAL PLAN


REVISIONS
DESIGNED: MAL
DRAWN: MAL
CHECKED: DVB
DATE: 3-31-93
SCALE: NOTED
PROJ. NO. 0592

SHEET 35
M-1
OF 36


GAS FIRED UNIT HEATERS

① SPARK-IGNITED
② THERMOSTAT AND RELAY & CONTROL TRANSFORMER


IDENT.	MFR.	MODEL NO.	FUEL	HTG. CAP.	CFM'S	HP	FLA	ELECT.	NOTES
UH-1	REZNER	F-130	NAT. GAS	130MBH	1600	1/20	4.0	115/1/60	①②
UH-2									
UH-3									
UH-4									
UH-5		F-75		75MBH	980	1/35	1.9		

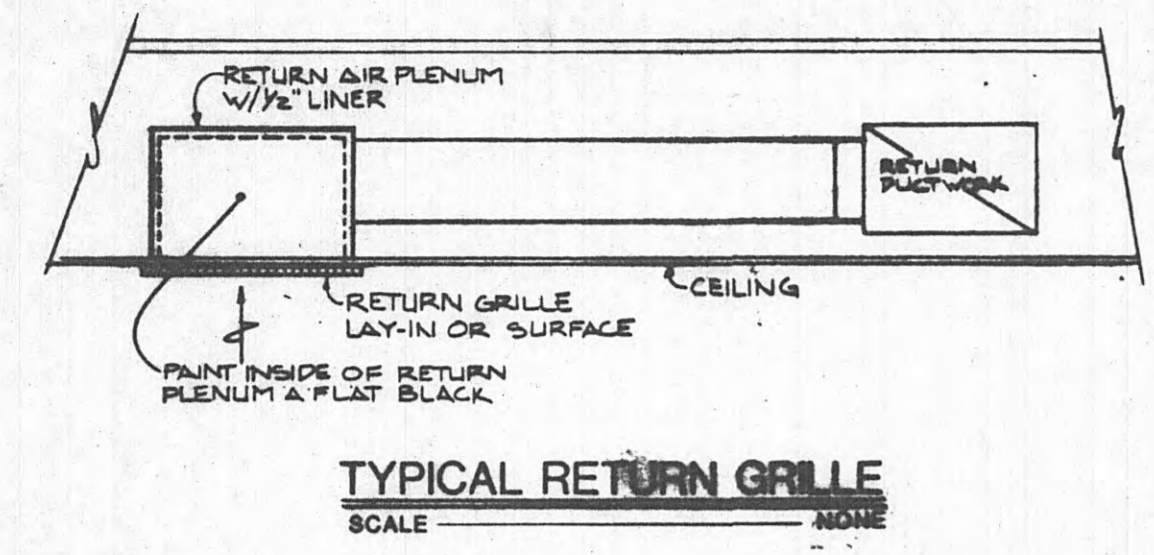


TYPICAL RETURN GRILLE
SCALE: NONE

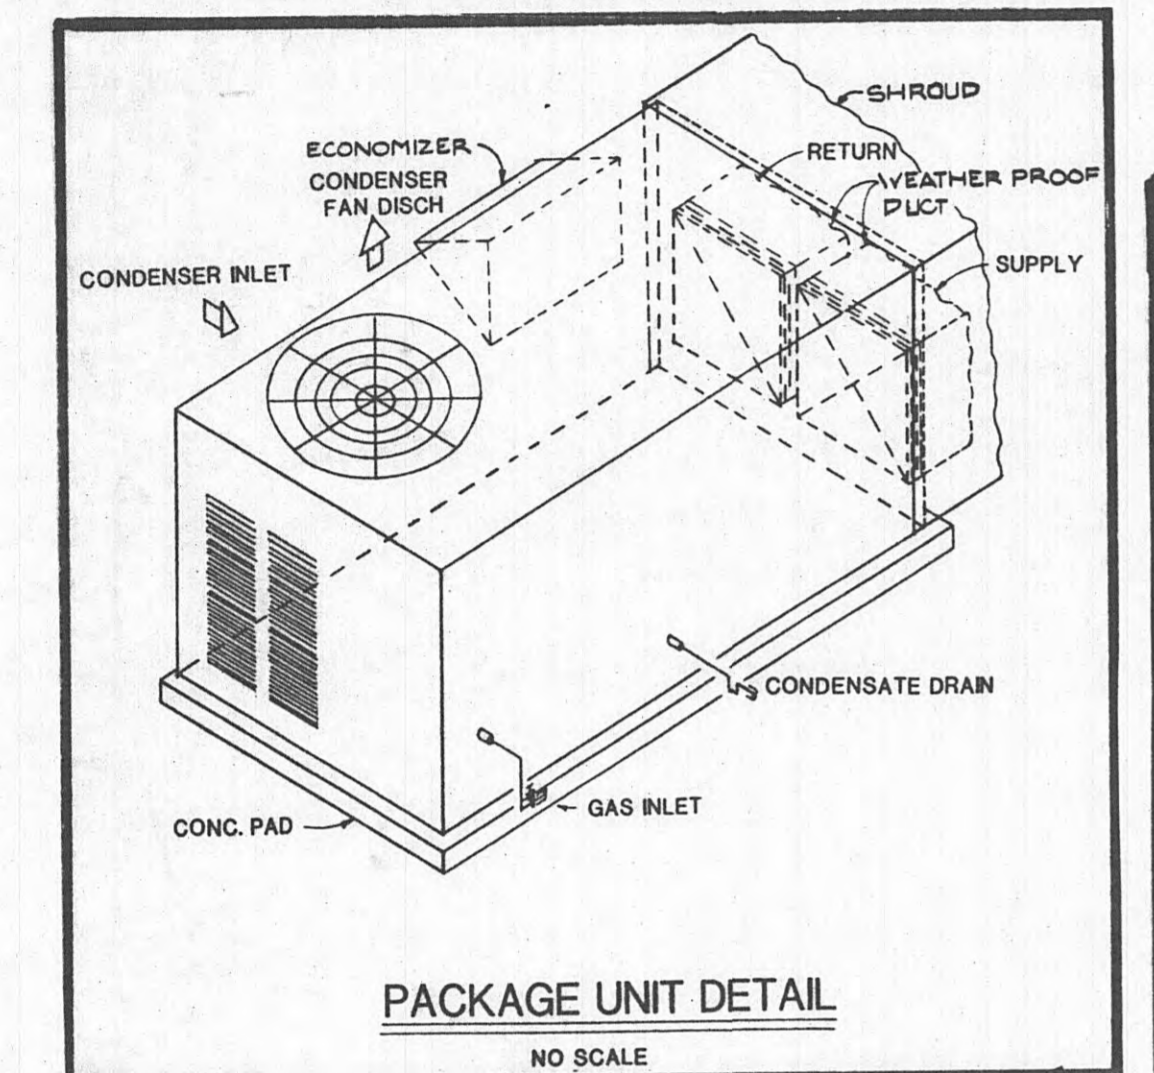

PACKAGE UNIT DETAIL
NO SCALE

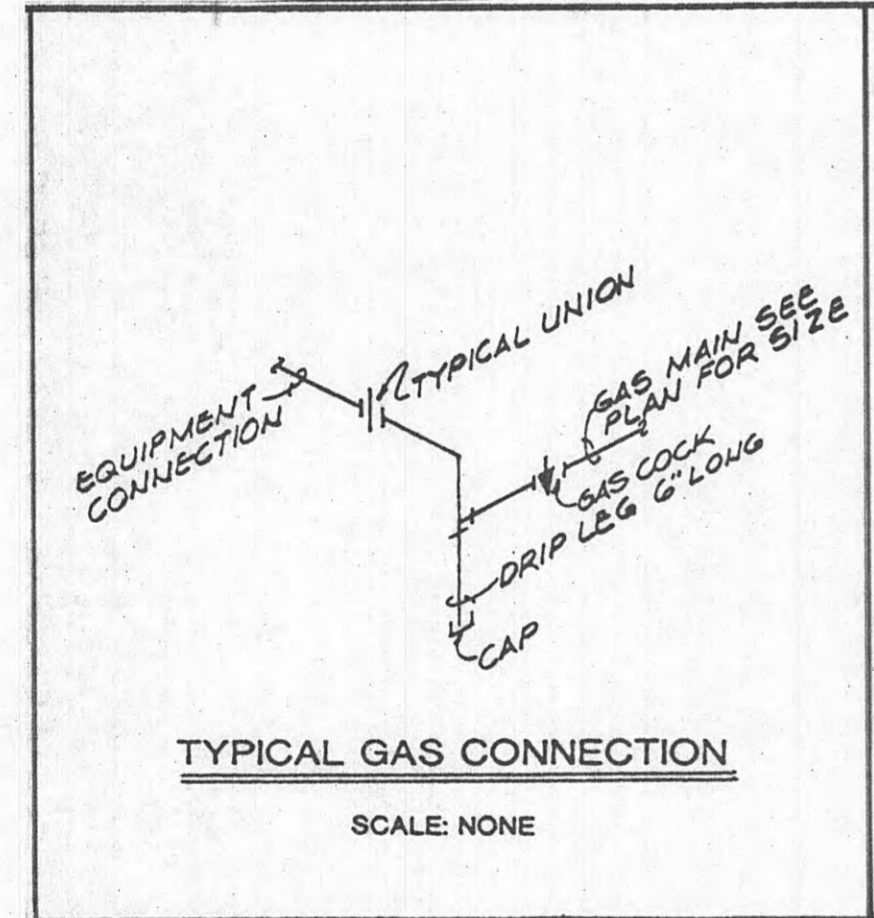

TYPICAL GAS CONNECTION
SCALE: NONE

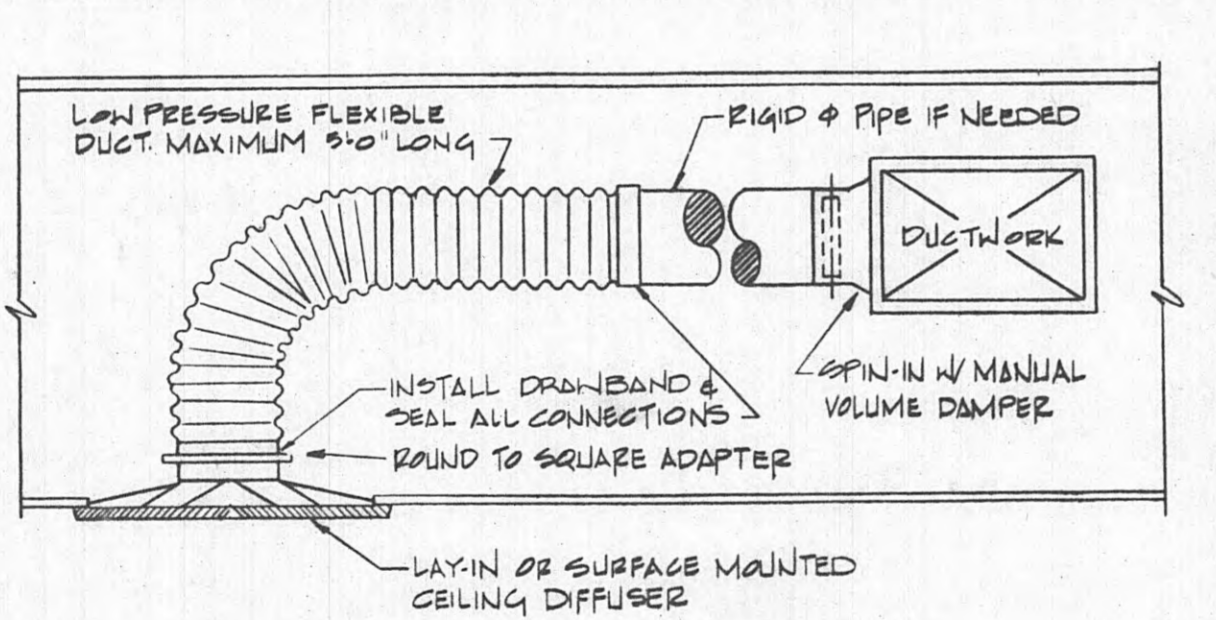

TYPICAL DIFFUSER CONNECTION
NO SCALE

LOUVER SCHEDULE

IDENT.	MANUF.	MODEL NO.	SIZE	ACCESSORIES
L-1	VENT. PRODUCTS	2000 ADJUST-O-VENT	240x48	①②③
L-2		2000 ADJUST-O-VENT	240x68	①②③
L-3		2700 ADJUST-O-VENT	72x48	②③
L-4			24x16	②③
L-5			12x12	②③

① AUTOMATIC ACTUATOR (120/1/60)
② BIRD SCREEN
③ MAX. FREE AREA VELOCITY 500 FPM.

ELECT. HEATER SCHEDULE


① MOUNTING KIT
② SINGLE POINT CONNECTION
③ CORROSION RESISTANT
④ EXPLOSION PROOF
⑤ UNIT MOUNTED THERMOSTAT
⑥ EXPLOSION PROOF THERMOSTAT

IDENT.	MFR.	MODEL NO.	HTG. CAP.	WATTS	ELECT.	NOTES
EH-1	Q MART	JUN750483	7.5KW	25,590	480/3/60	①②③⑤
EH-2		JUN20081	2 KW	6,824	208/1/60	①②③⑤
EH-3		MLH03-21	2.2KW	7,508		①②③
EH-4		MLH03-21	2.2KW	7,508		①②③
EH-5		6UX004831	3 KW	10,236	480/3/60	①②④⑥
EH-6		MLH03-21	2.2KW	7,508	208/1/60	①②③
EH-7		MLH03-01	5 KW	17,065		①②③
EH-8		MLH07-0	7.5KW	25,590		①②③

FAN SCHEDULE

① INTEGRAL DISCONNECT SWITCH
② SPEED CONTROL
③ ROOF CAP W/ CURB
④ CORROSION RESISTANT
⑤ EXPLOSION PROOF
⑥ INTERLOCK W/ LOUVER
⑦ ROOF CURB
⑧ WALL SHUTTER
⑨ WALL CAP
⑩ BACKDRAFT DFR
⑪ BIRD SCREEN
⑫ INTEGRAL GRILLE
⑬ FAN GUARD
⑭ EXPLOSION PROOF THERMOSTAT
⑮ INTERLOCK W/ LOUVER

IDENT.	MFR.	CFM	MODEL NO.	ESP	HP	RPM	ELECT.	NOTES
EF-1	LOREN-COOK	165	GEMINI 445A	.125	1/2	1469	115/1/60	②④⑤⑥⑨⑪
VF-1		5900	245PUB		3/4	824	208/1/60	①②④⑤
VF-2		1300	165PIOD		1/4	803	120/1/60	①②④⑤
VF-3		60	85PI5D		1/8	1087		①④⑤
VF-4		70	85PI5D		1/8	1268		①④⑤
VF-5		165	ACV-100VZB		1/4	442		①⑤④
VF-6		80	85PI5D		1/8	1450		①④⑤
VF-7		480	105PI5D		1/2	1158		①④⑤
VF-8/9		13,500	485P5B		1/2	258		①②④⑤⑥

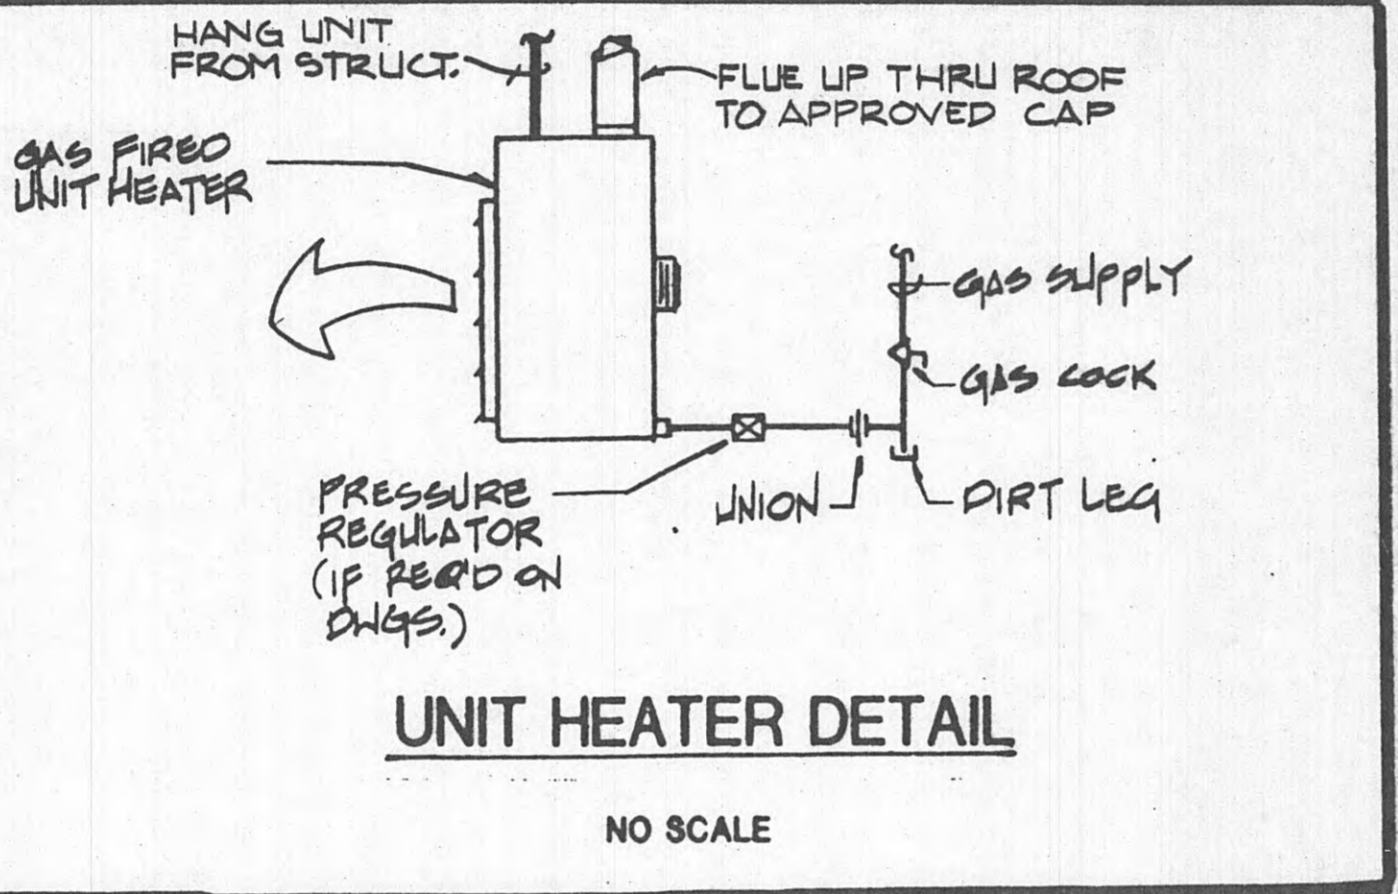

UNIT HEATER DETAIL
NO SCALE

AIR DEVICE SCHEDULE

CD-CEILING SUPPLY DIFFUSER
SSR-SIDEWALL SUPPLY REGISTER
LD-LINEAR DEFUSER
SSR-SIDEWALL RETURN REGISTER
RQ-RETURN GRILLE
EQ-EXHAUST GRILLE
TQ-TRANSFER GRILLE
DG-DOOR GRILLE
FSR-FLOOR SUPPLY DIFFUSER

IDENT.	MODEL NO.	CFM RANGE	NECK SIZE	TYPE	NOTES
A	5800A-6	60-100	6" φ	CP24x24	②③④
		101-220	8" φ		
		221-400	10" φ		
		401-550	12" φ		
B	5800-6	101-220	8" φ	CP12x12	
C	CCS	0-1250	SEE DRAW	R624x24	
D	RH	0-1000	24x24	SSR24x24	
E	DGDF	0-200	18x6	DG 18x6	②④


- ① STEEL CONSTRUCTION
② ALUM. CONSTRUCTION
③ OPPOSED BLADE DAMPER
④ OFF-WHITE ENAMEL
⑤ ANODIZED FINISH
⑥ GOLDEN SAND ENAMEL
- PROVIDE METALAREAS SPECIFIED ABOVE, OR APPROVED EQUAL.

PACKAGE UNIT SCHEDULE


IDENT.	MFR.	MODEL NO.	SUPPLY CFM	OA CFM	ESP(W.G.)	COOLING CAPACITY	HEATING CAPACITY
AH-1	CARRIER	48LIP	2400	2400	.5		
						TOTAL (BTUH) 17,700	
						OA DB 95°F	
						ENT. DB/WB 80°/67°F	
						INPUT (BTUH) 14,000	
						OUTPUT (BTUH) 59,200	
						TYPE NAT. GAS	
						EVAP HP 1 1/2	
						FLA 1.8	
						LRA	
						COND HP 1/3	
						FLA 1	
						LRA	
						COMP. LRA 69	
						FLA 10.4	
						TOTAL WT. 700 lbs	
						VOLTAGE 480/3/60	
						NOTES ②③④⑤	

KEY NOTES:
① ROOF CURB
② CURB ISOLATION RALS
③ ECONOMICIZER
④ LOW AMBIENT CONTROL-0 DEGS.
⑤ THROWAWAY FILTERS
⑥ THERMOSTAT
⑦ FIRESTAT IN RETURN
⑧ SMOKE DETECTOR IN SUPPLY
⑨ SMOKE DETECTOR IN RETURN
* FURNISHED BY MECH. CONTR. INSTALLED BY MECH. CONTR.


- KEY NOTES ARE INDICATED ON DRAWING BY NUMBER ENCLOSED INSIDE SYMBOL
- ELECTRIC UNIT HEATER MOUNTED 7'-0" ABOVE FINISHED FLOOR.
 - VENTILATION FAN MOUNTED 7'-0" ABOVE FINISHED FLOOR.
 - ELECTRIC UNIT HEATER MOUNTED 10'-0" ABOVE FINISHED FLOOR.
 - EH-7 ELECTRIC UNIT HEATER LOCATED IN BASEMENT MOUNTED AT 7'-0" ABOVE FINISHED FLOOR.
 - VENTILATION FAN MOUNTED 10'-0" ABOVE FINISHED FLOOR.
 - 24" X 18" OUTSIDE AIR INTAKE LOUVER (AS HIGH AS POSSIBLE).
 - 12" X 12" OUTSIDE AIR INTAKE LOUVER (AS HIGH AS POSSIBLE).

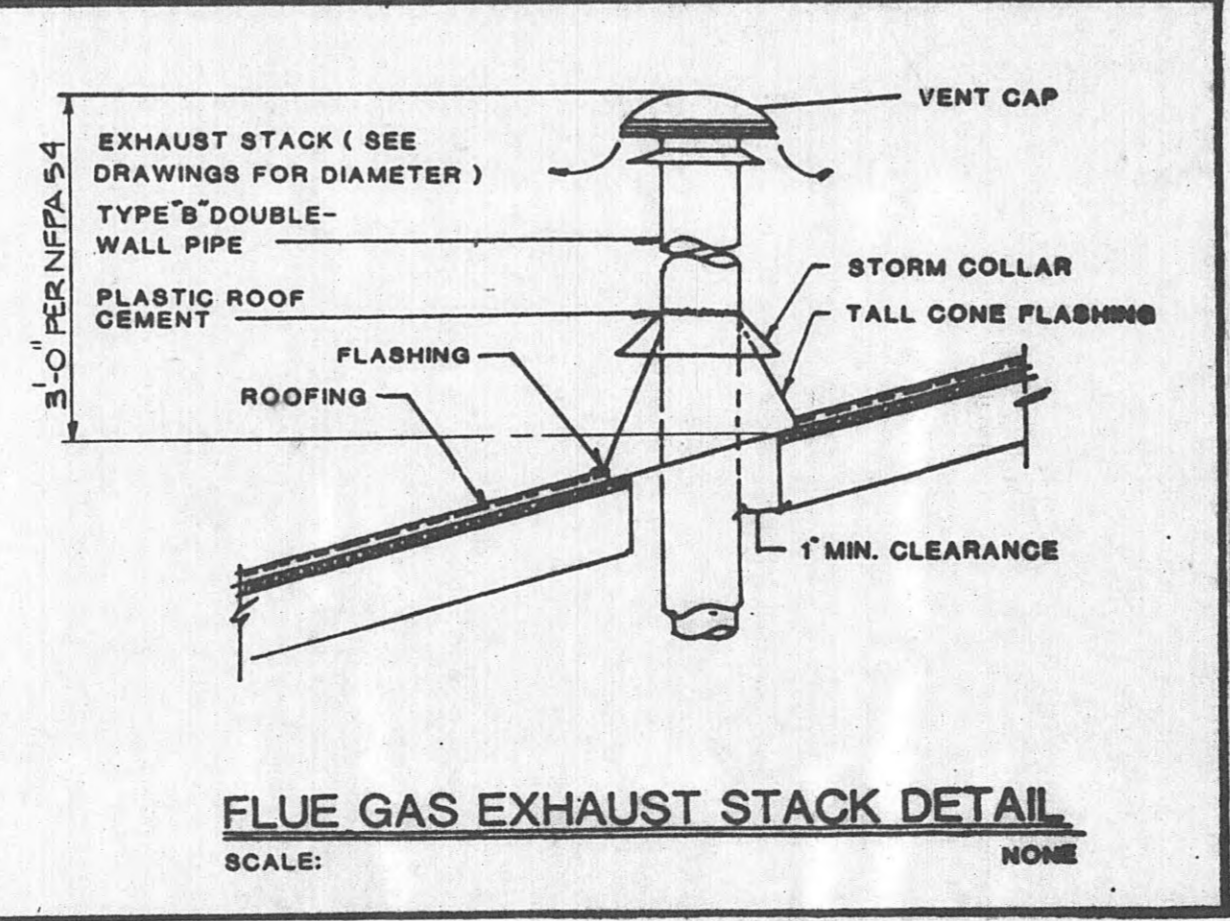

FLUE GAS EXHAUST STACK DETAIL
SCALE: NONE

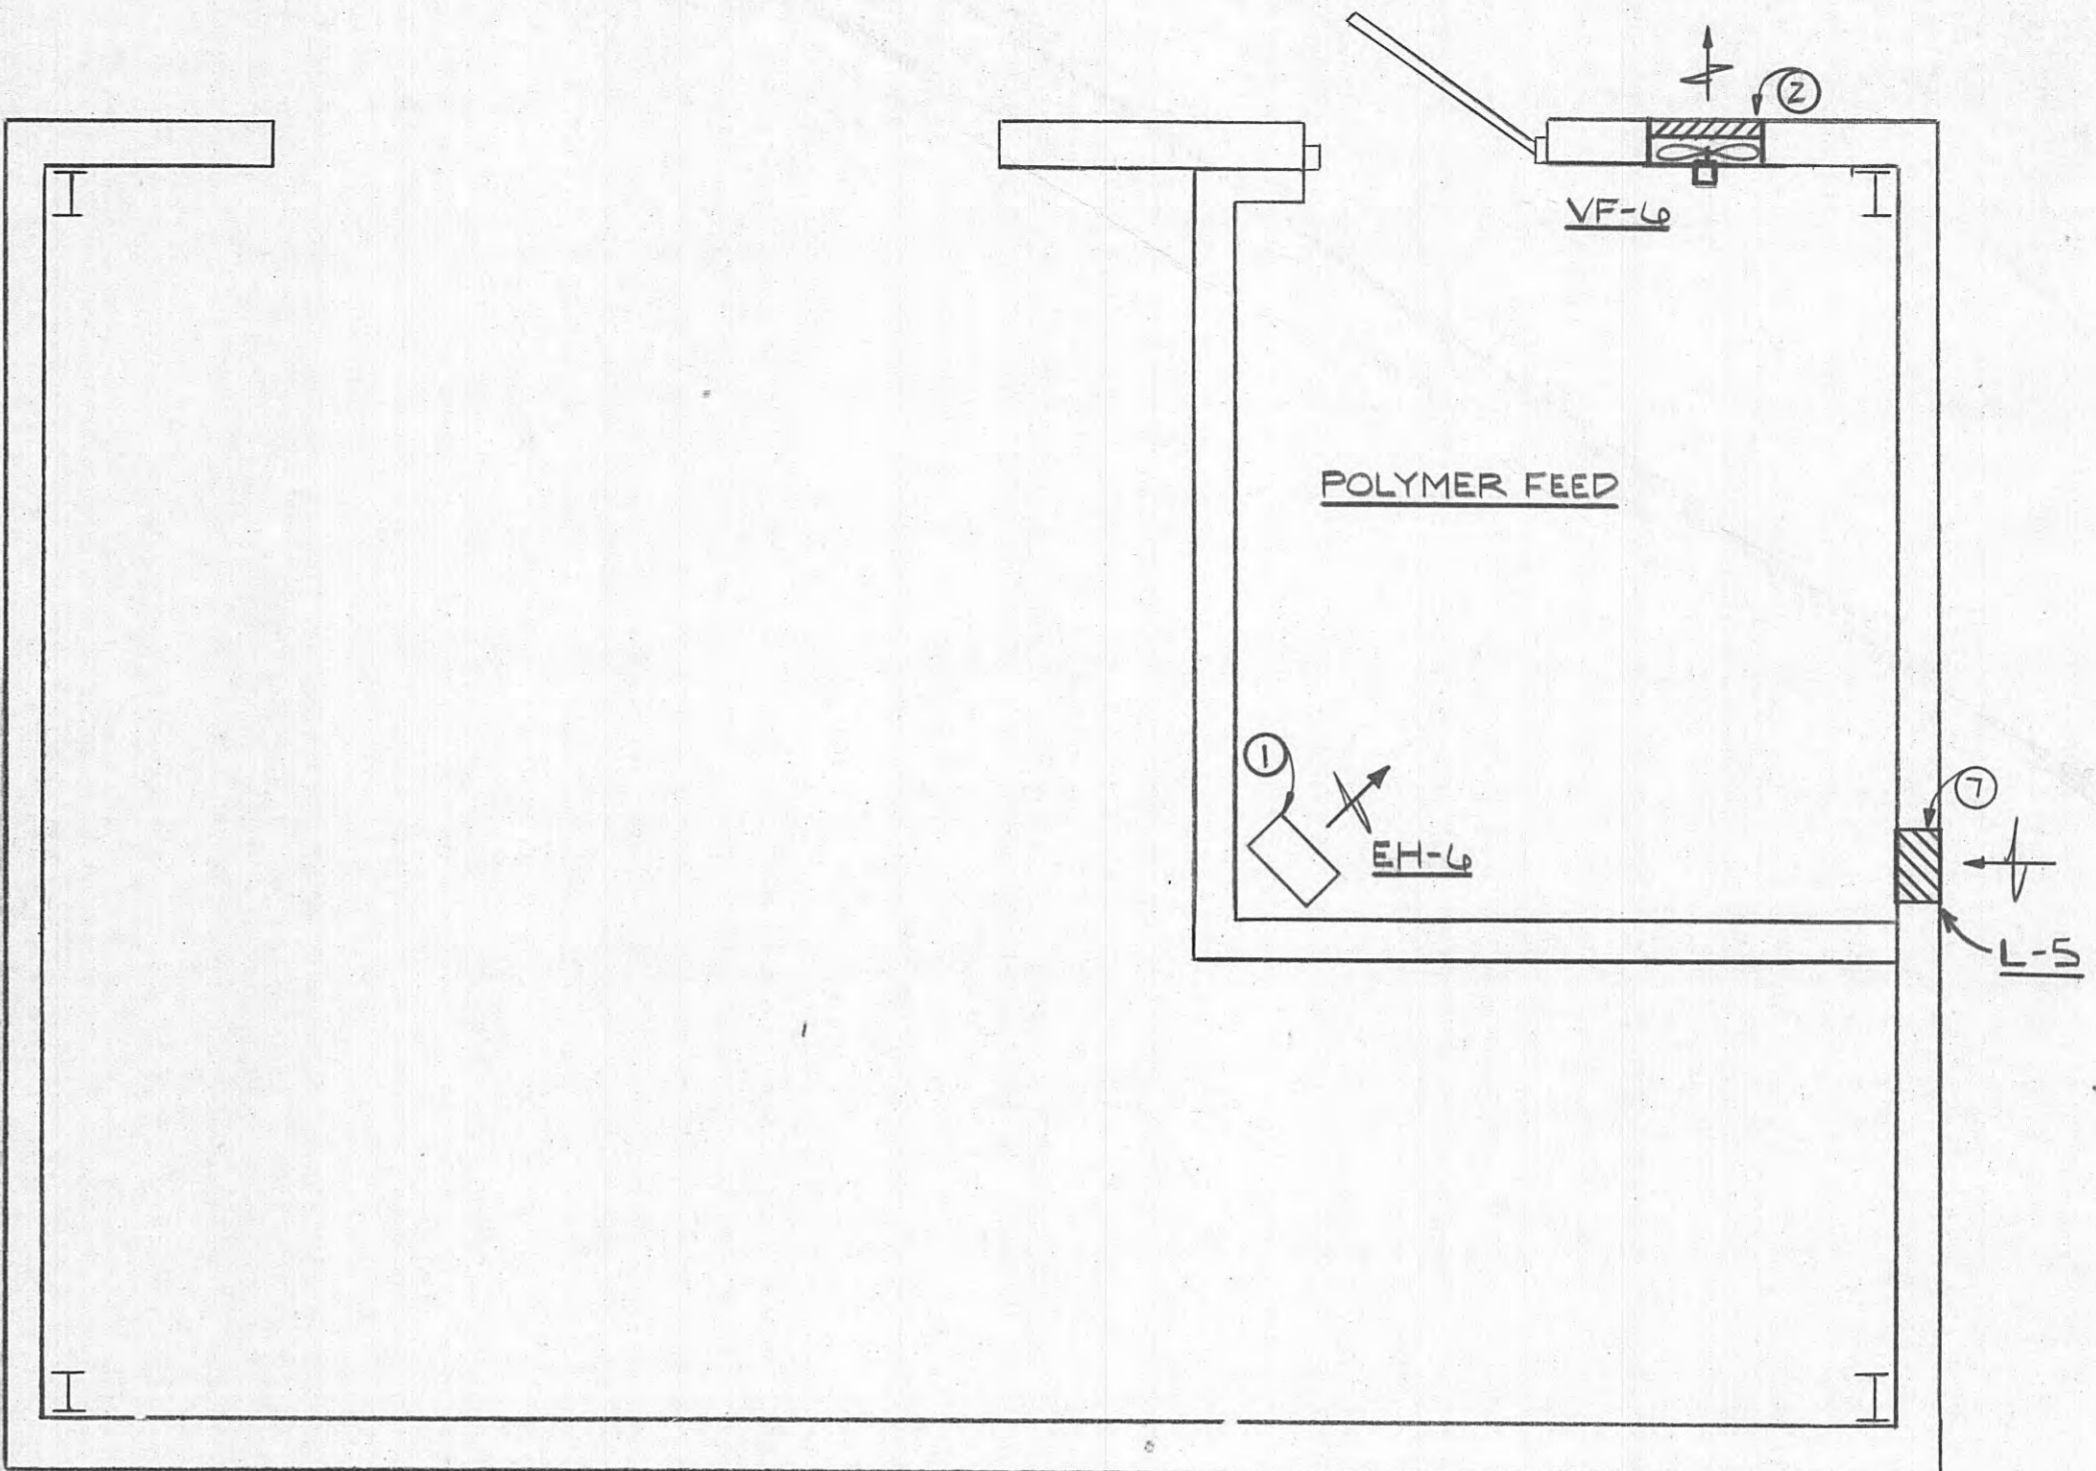


STORAGE BLDG.
SCALE: 3/8" = 1'-0"

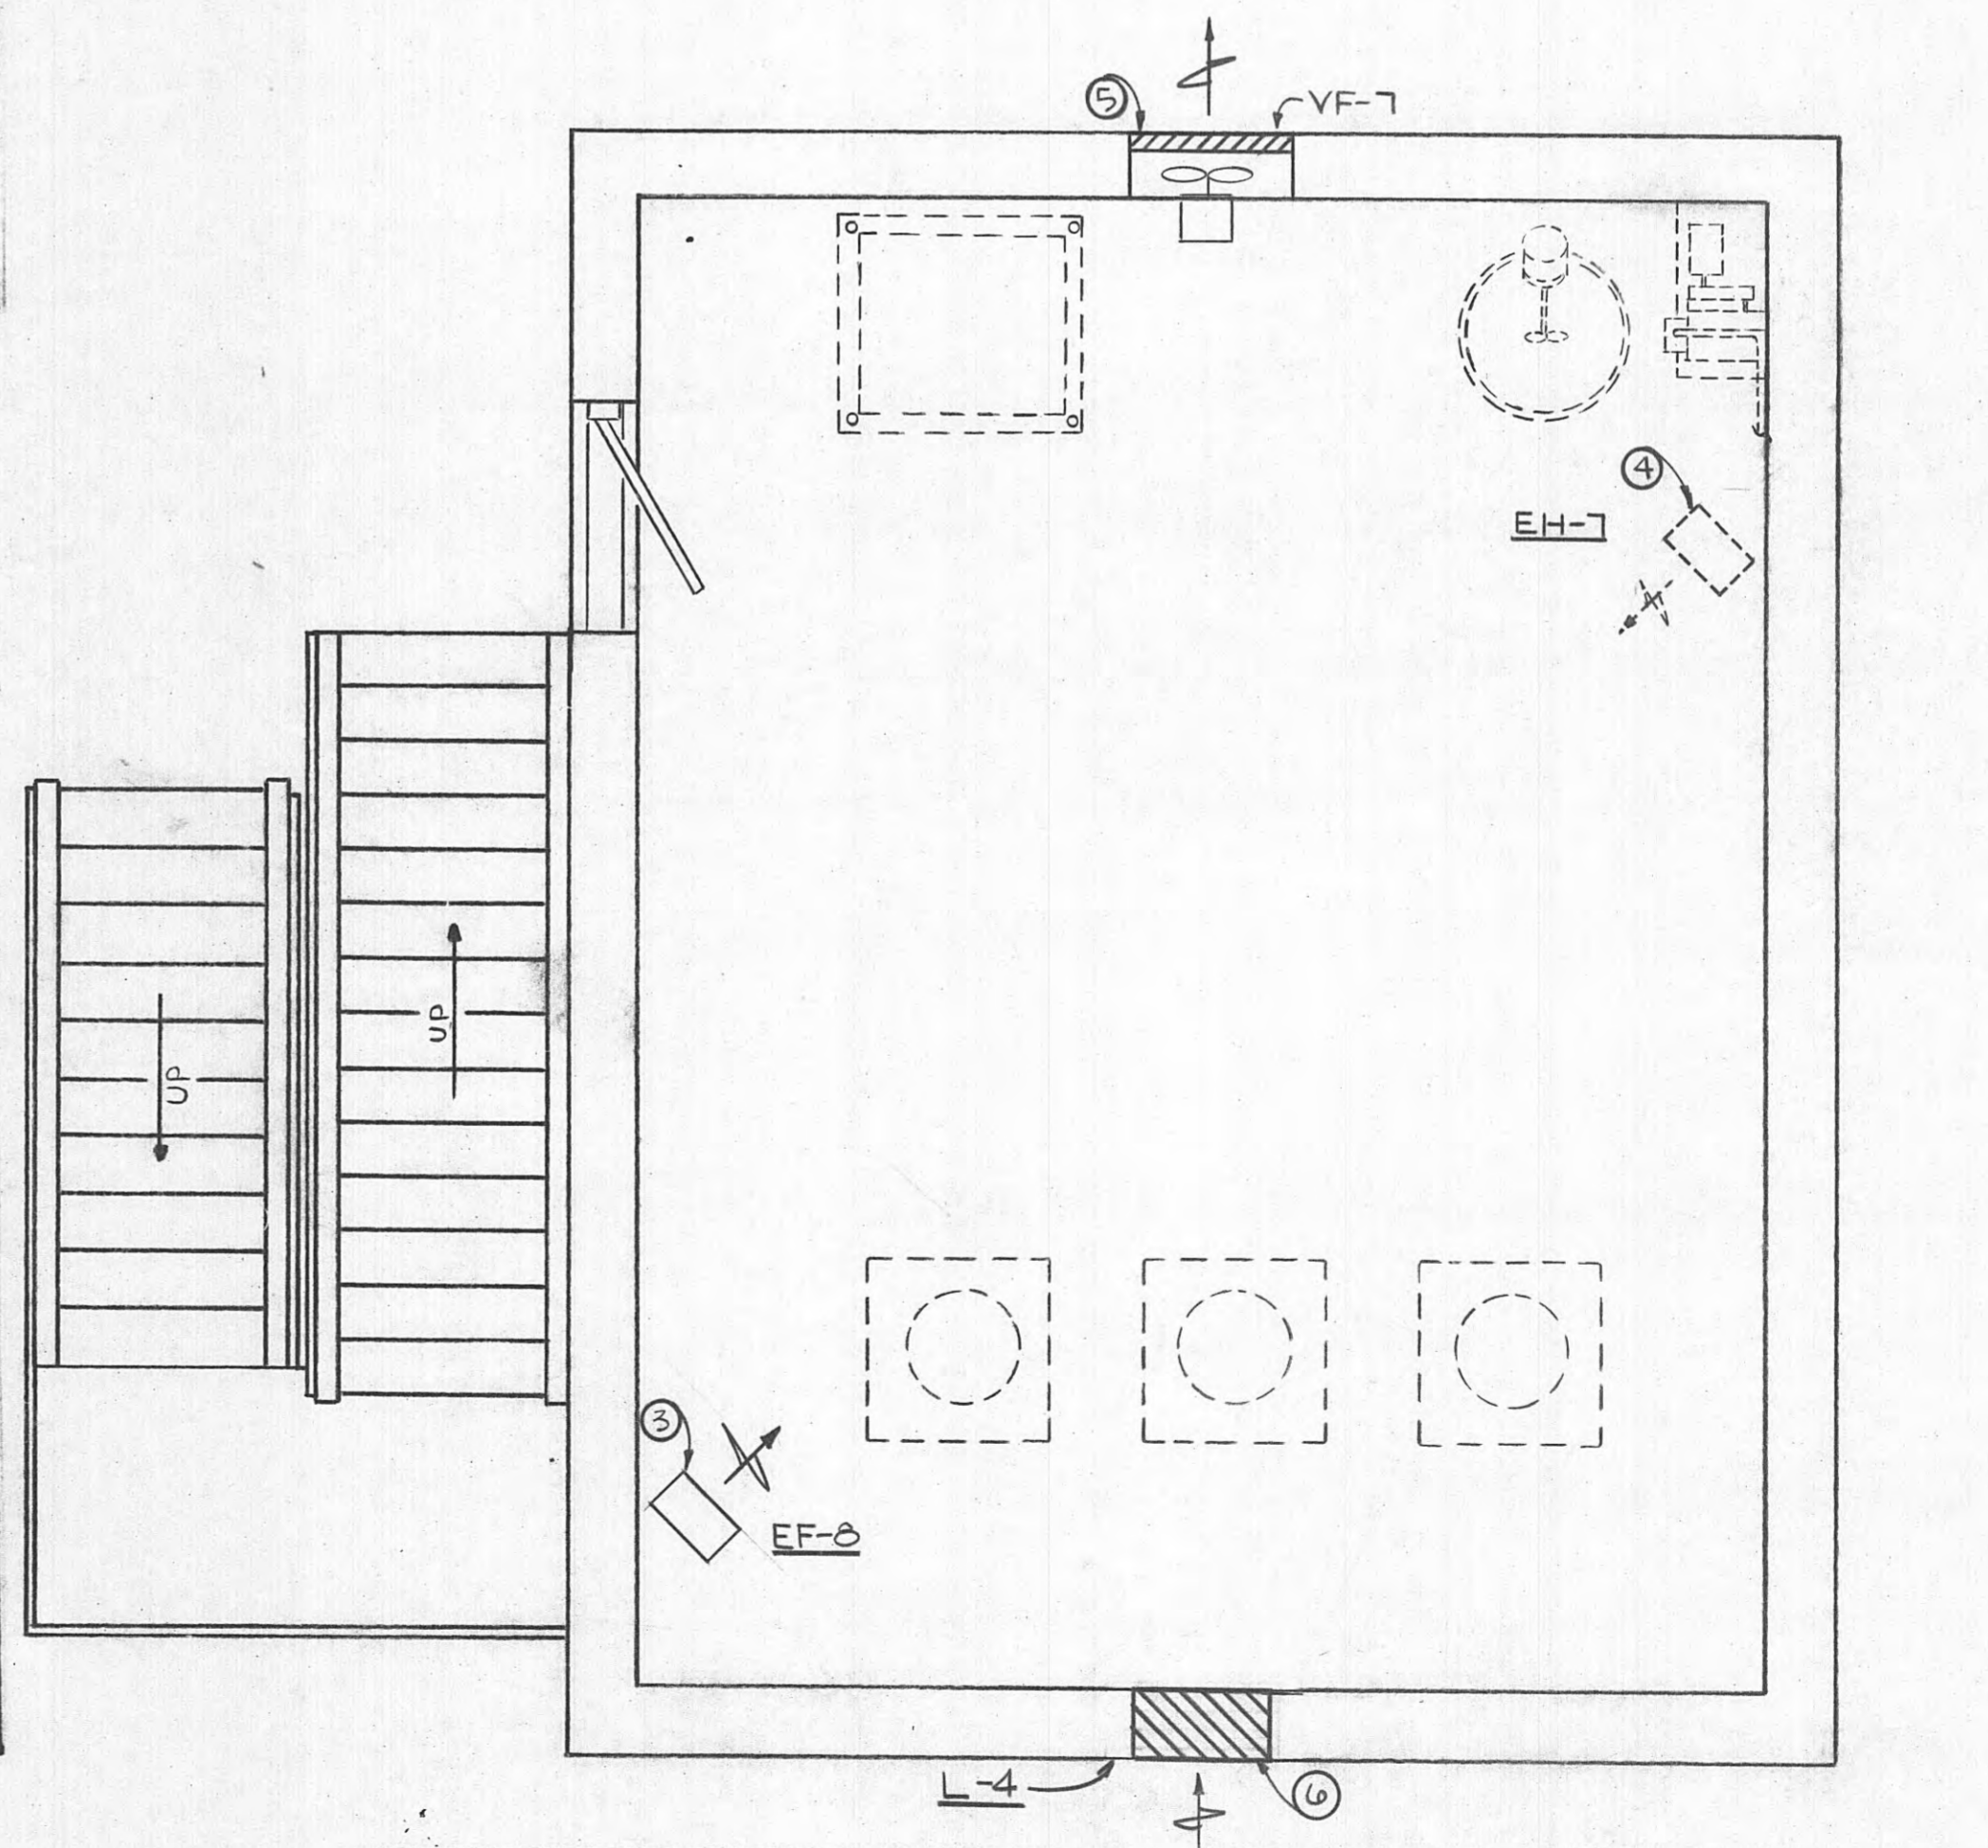

RAW WATER INTAKE PUMP BLDG. MECHANICAL
SCALE: 3/8" = 1'-0"

AS BUILT
DATE: 3-20-95
APPROVED: D.M.

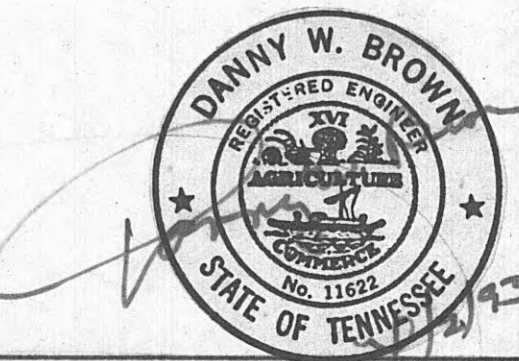

DUFF BROWN ENGINEERING INC.
783 OLD HICKORY BLVD. BRENTWOOD, TN. 37027 (615) 377-3757

ELROD · DUNSON, INC.
CONSULTING ENGINEERS
NASHVILLE · KNOXVILLE
LEXINGTON, KY

CONTRACT W93-04
HARRIMAN, TENNESSEE
POLYMER/INTAKE BUILDING MECHANICAL - SCHEDULES

REVISIONS

DESIGNED: MAL
DRAWN: MAL
CHECKED: DVB
DATE: 3-31-93
SCALE: NOTED
PROJ. NO. 0592


SHEET 36
M-2
OF 36



REVISIONS

1-19-93 ADDED
DRAIN TO PIPE
CHASE OF 36" PIPE

DESIGNED: L.E.R.
DRAWN: S.C.G.
CHECKED: L.E.R.
DATE: MARCH, 1993
SCALE: 1" = 20'-0"
PROJ. NO. 0592

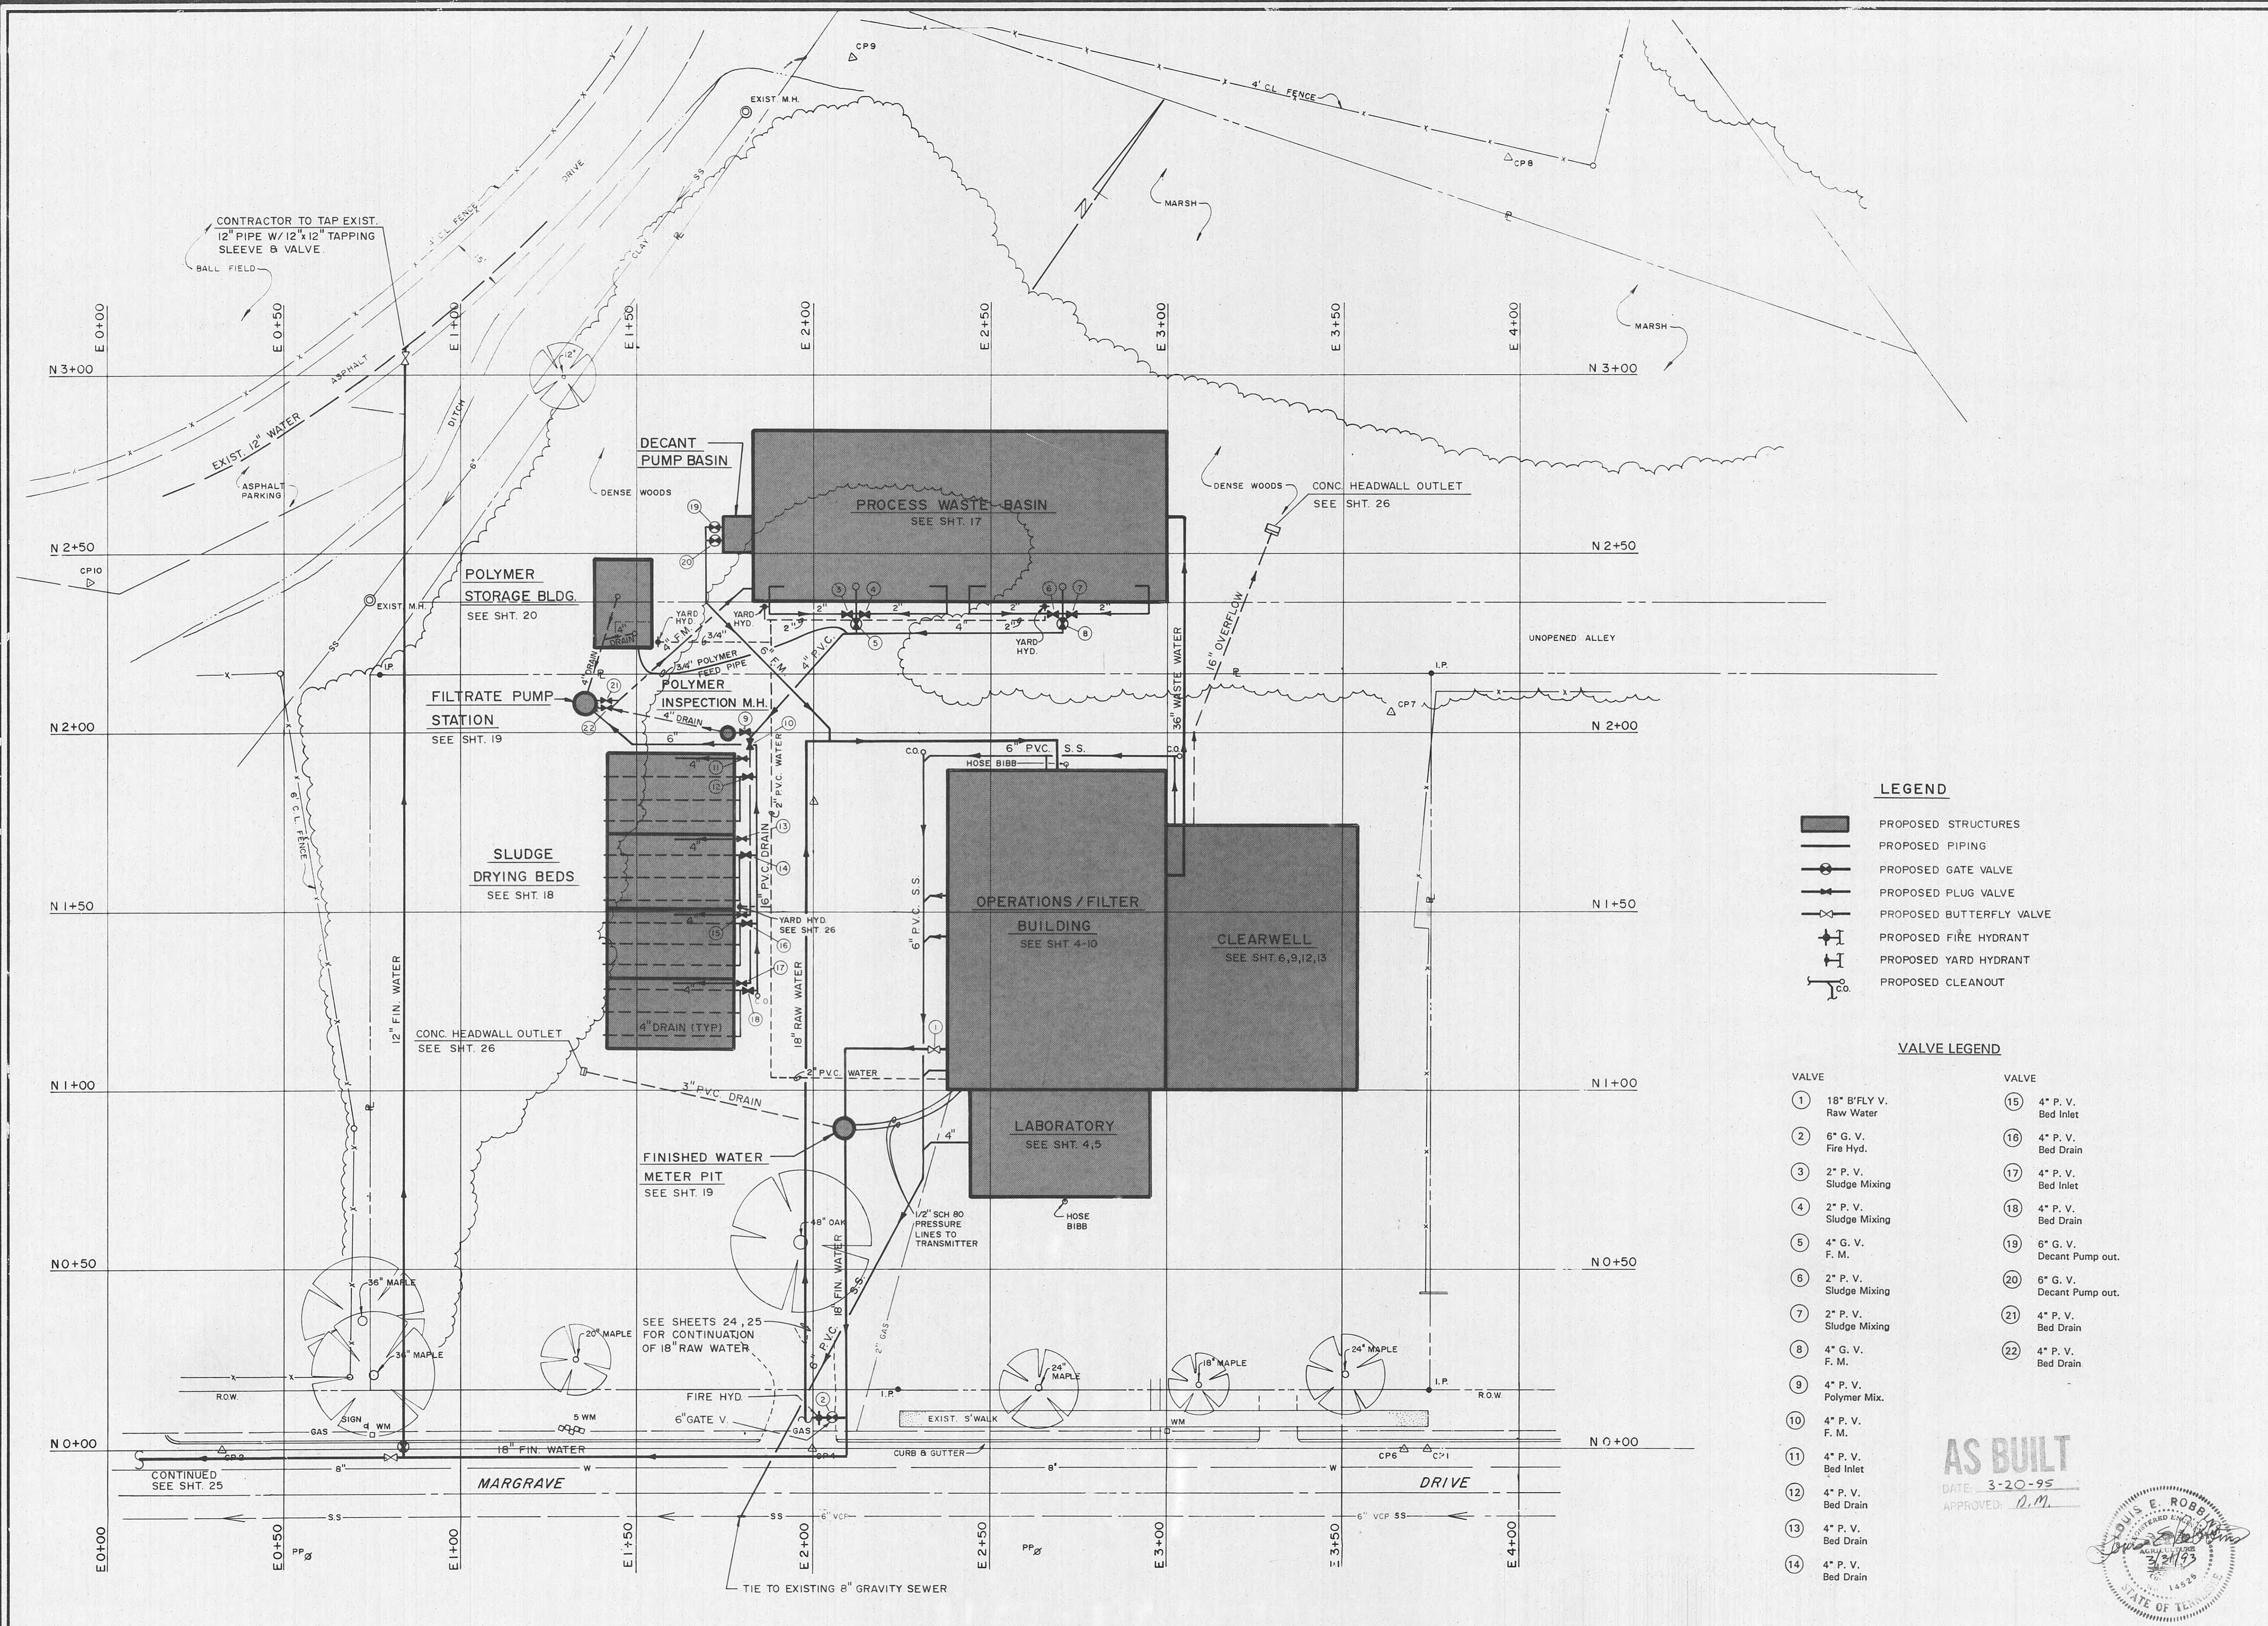


LEGEND

- PROPOSED STRUCTURES
- PROPOSED PIPING
- PROPOSED GATE VALVE
- PROPOSED PLUG VALVE
- PROPOSED BUTTERFLY VALVE
- PROPOSED FIRE HYDRANT
- PROPOSED YARD HYDRANT
- PROPOSED CLEANOUT


VALVE LEGEND

- | | |
|--------------------------|------------------------------|
| VALVE | VALVE |
| 1 18" B'FLY V. Raw Water | 15 4" P. V. Bed Inlet |
| 2 6" G. V. Fire Hyd. | 16 4" P. V. Bed Drain |
| 3 2" P. V. Sludge Mixing | 17 4" P. V. Bed Inlet |
| 4 2" P. V. Sludge Mixing | 18 4" P. V. Bed Drain |
| 5 4" G. V. F. M. | 19 6" G. V. Decant Pump out. |
| 6 2" P. V. Sludge Mixing | 20 6" G. V. Decant Pump out. |
| 7 2" P. V. Sludge Mixing | 21 4" P. V. Bed Drain |
| 8 4" G. V. F. M. | 22 4" P. V. Bed Drain |
| 9 4" P. V. Polymer Mix. | |
| 10 4" P. V. F. M. | |
| 11 4" P. V. Bed Inlet | |
| 12 4" P. V. Bed Drain | |
| 13 4" P. V. Bed Drain | |
| 14 4" P. V. Bed Drain | |

AS BUILT
DATE: 3-20-95
APPROVED: *[Signature]*

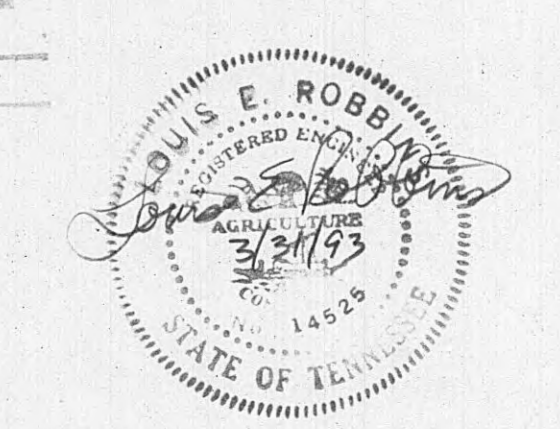

DRAWING BY THE FORM 4815

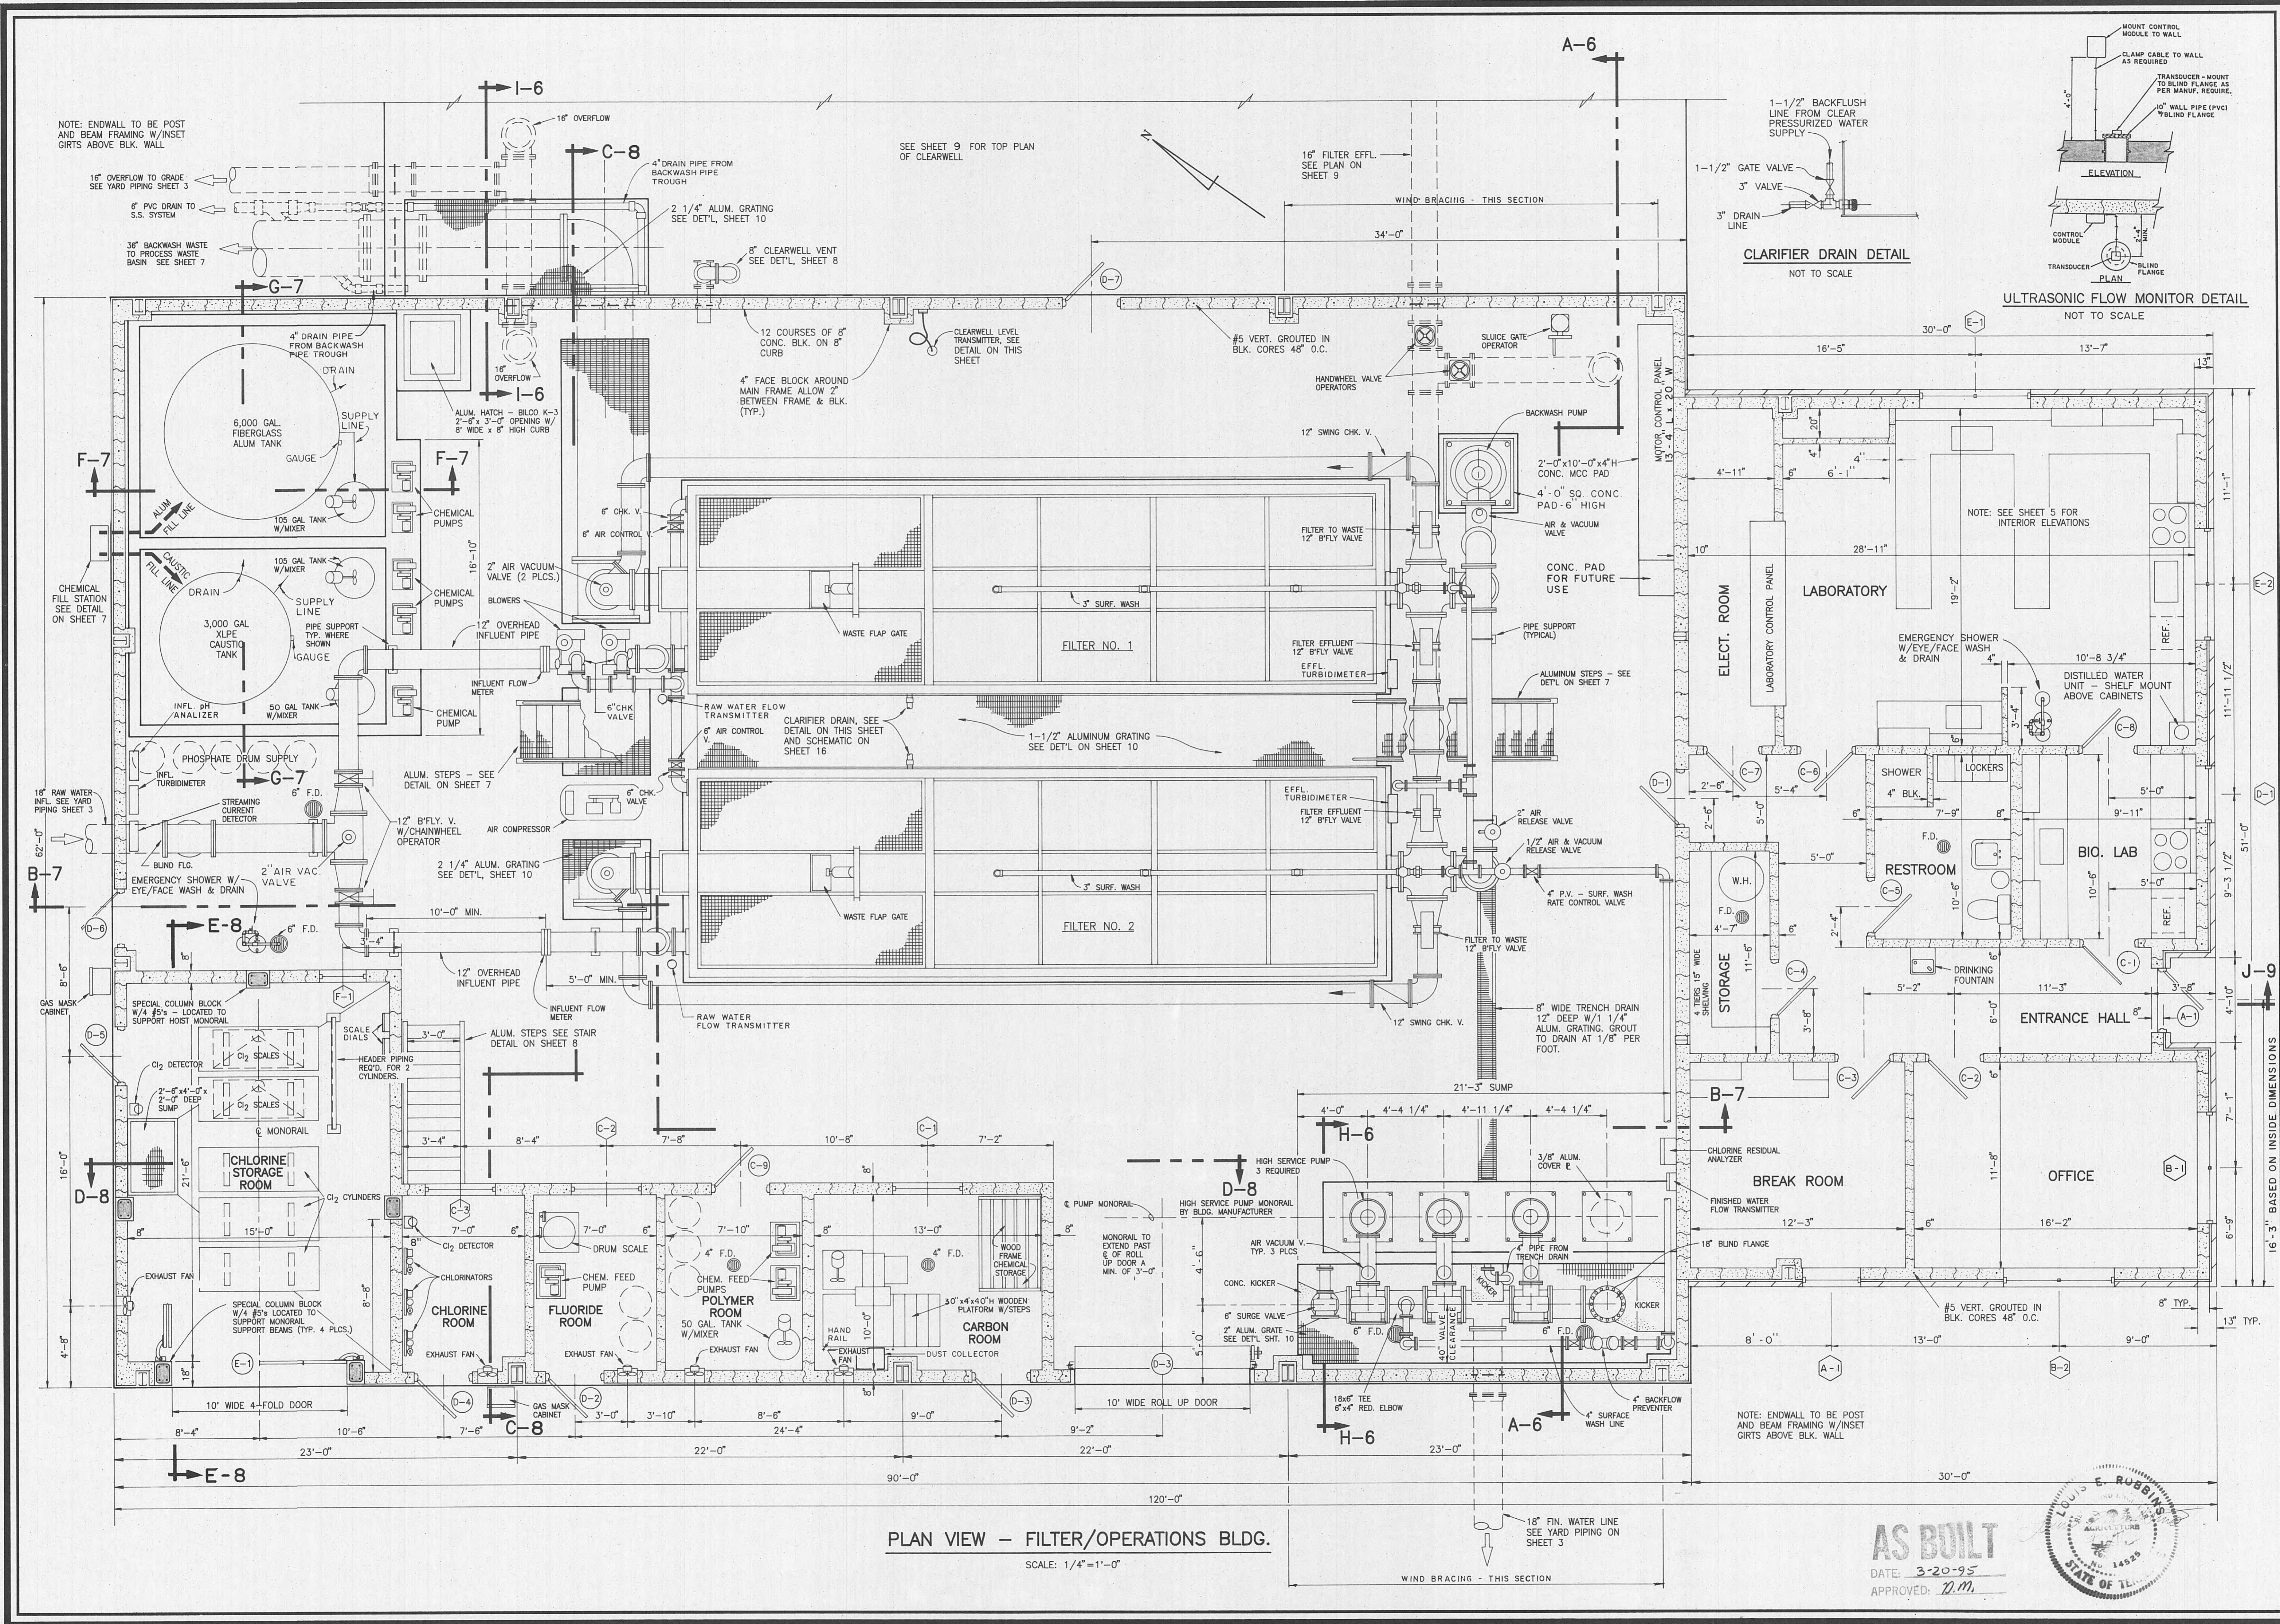

PLAN VIEW - FILTER/OPERATIONS BLDG.
SCALE: 1/4" = 1'-0"

CLARIFIER DRAIN DETAIL
NOT TO SCALE

ULTRASONIC FLOW MONITOR DETAIL
NOT TO SCALE

ELROD · DUNSON, INC.
CONSULTING ENGINEERS
NASHVILLE · KNOXVILLE
LEXINGTON, KY

CONTRACT W93-04
HARRIMAN, TENNESSEE
PLAN VIEW - FILTER/OPERATIONS BUILDING










REVISIONS
4/19/93
INSTALLED 36" BACKWASH PIPE IN TROUGH. ADDED 8" WIDE TRENCH DRAIN.

DESIGNED: L.E.R.
DRAWN: S.C.G.
CHECKED: L.E.R.
DATE: MARCH, 1993
SCALE: 1/4" = 1'-0"
PROJ. NO. 0592

SHEET 4
OF 36

AS BUILT
DATE: 3-20-95
APPROVED: *[Signature]*



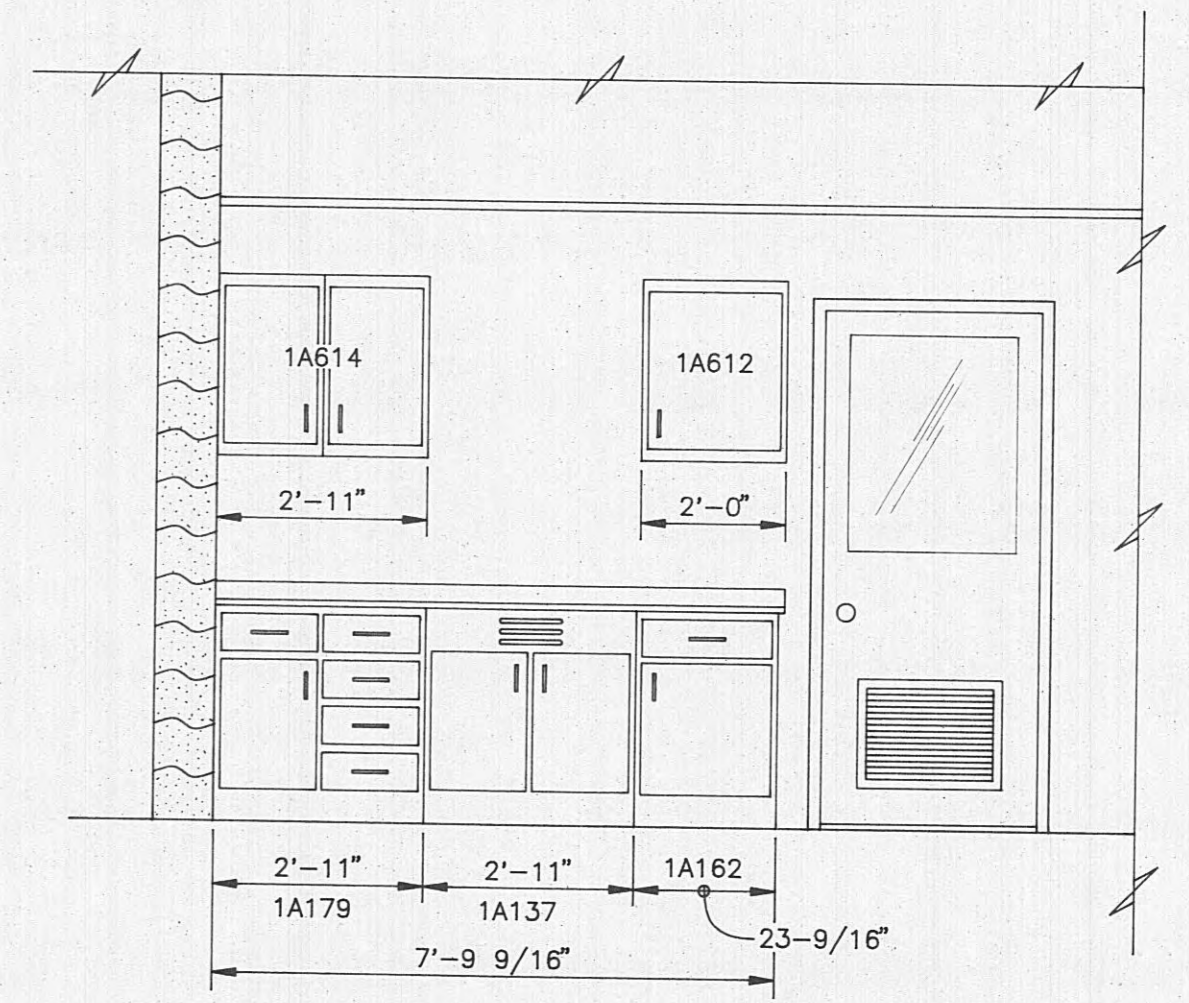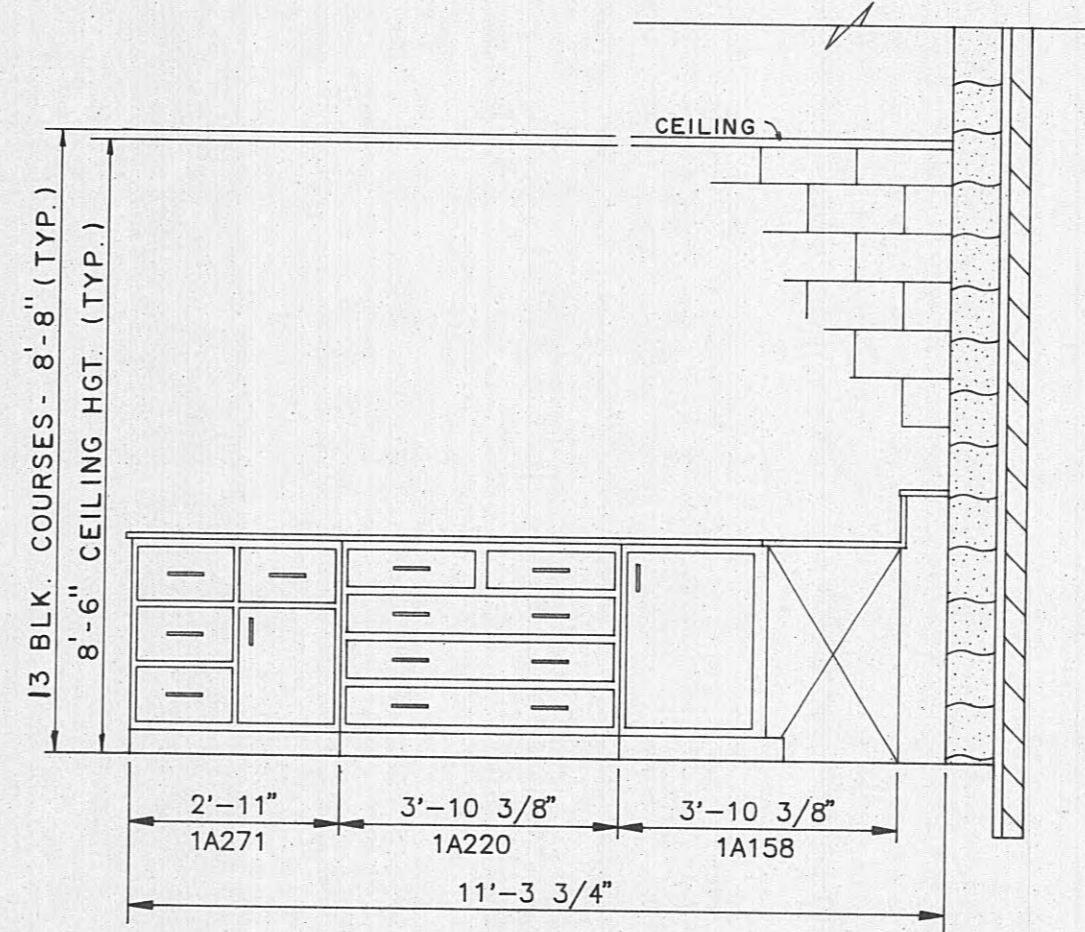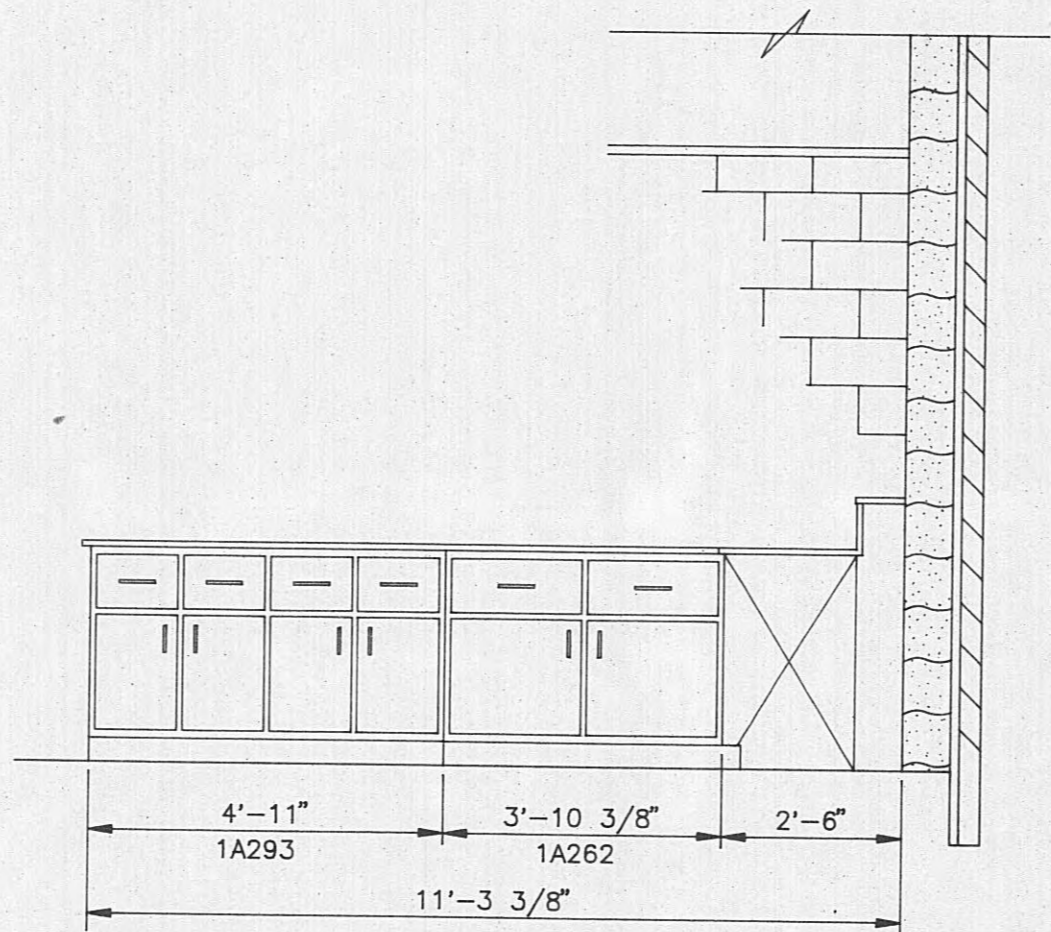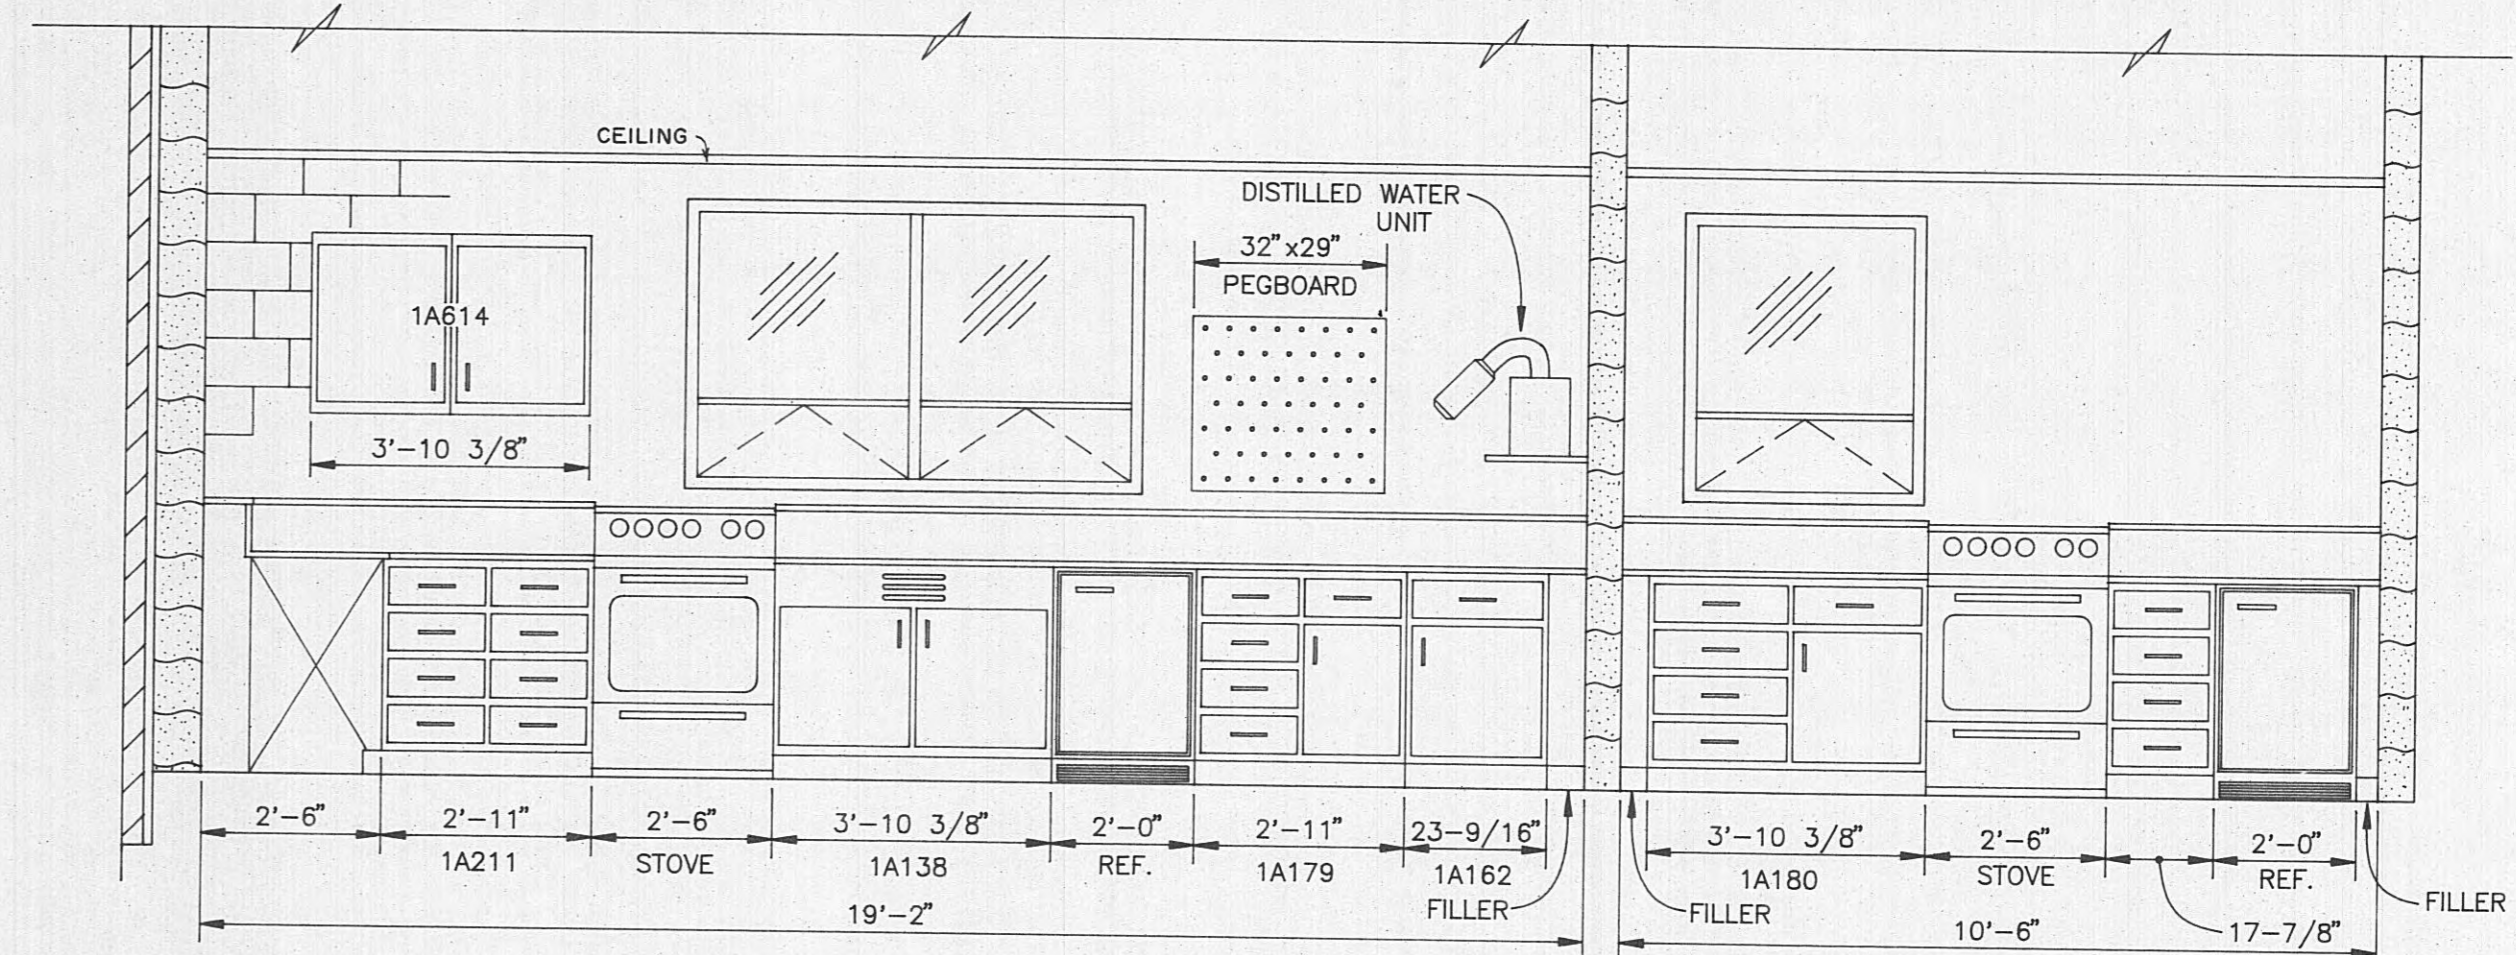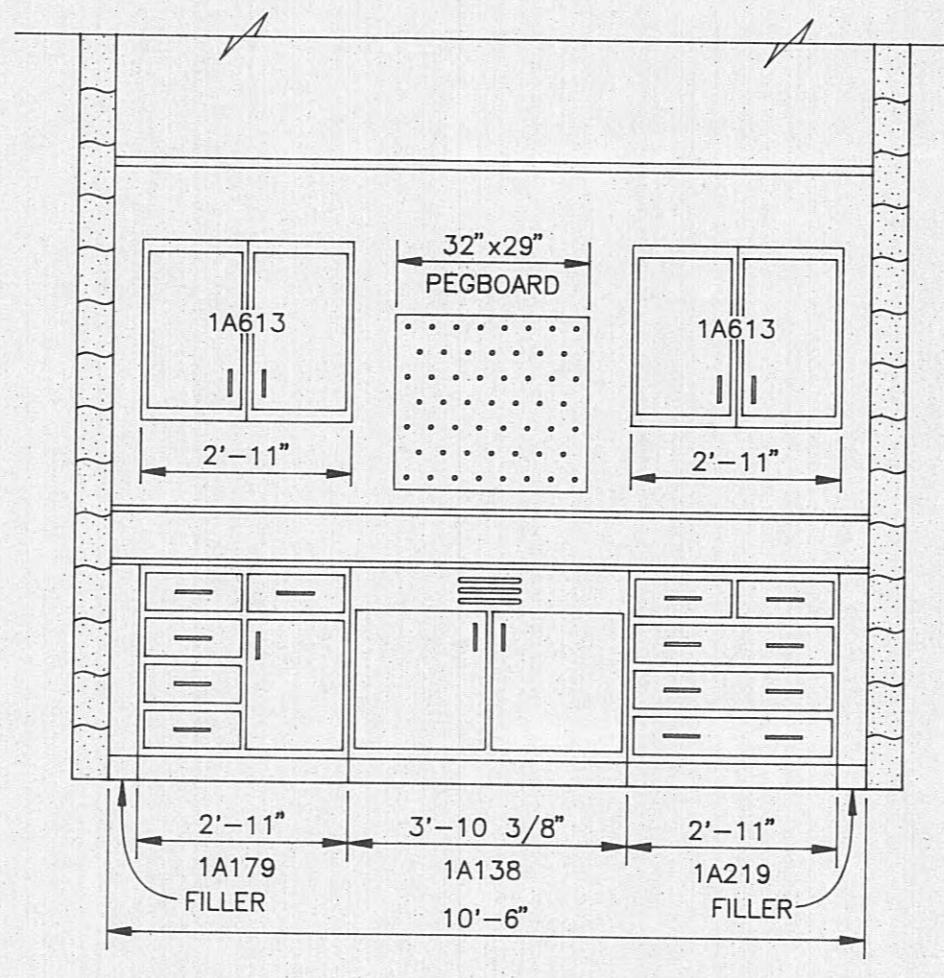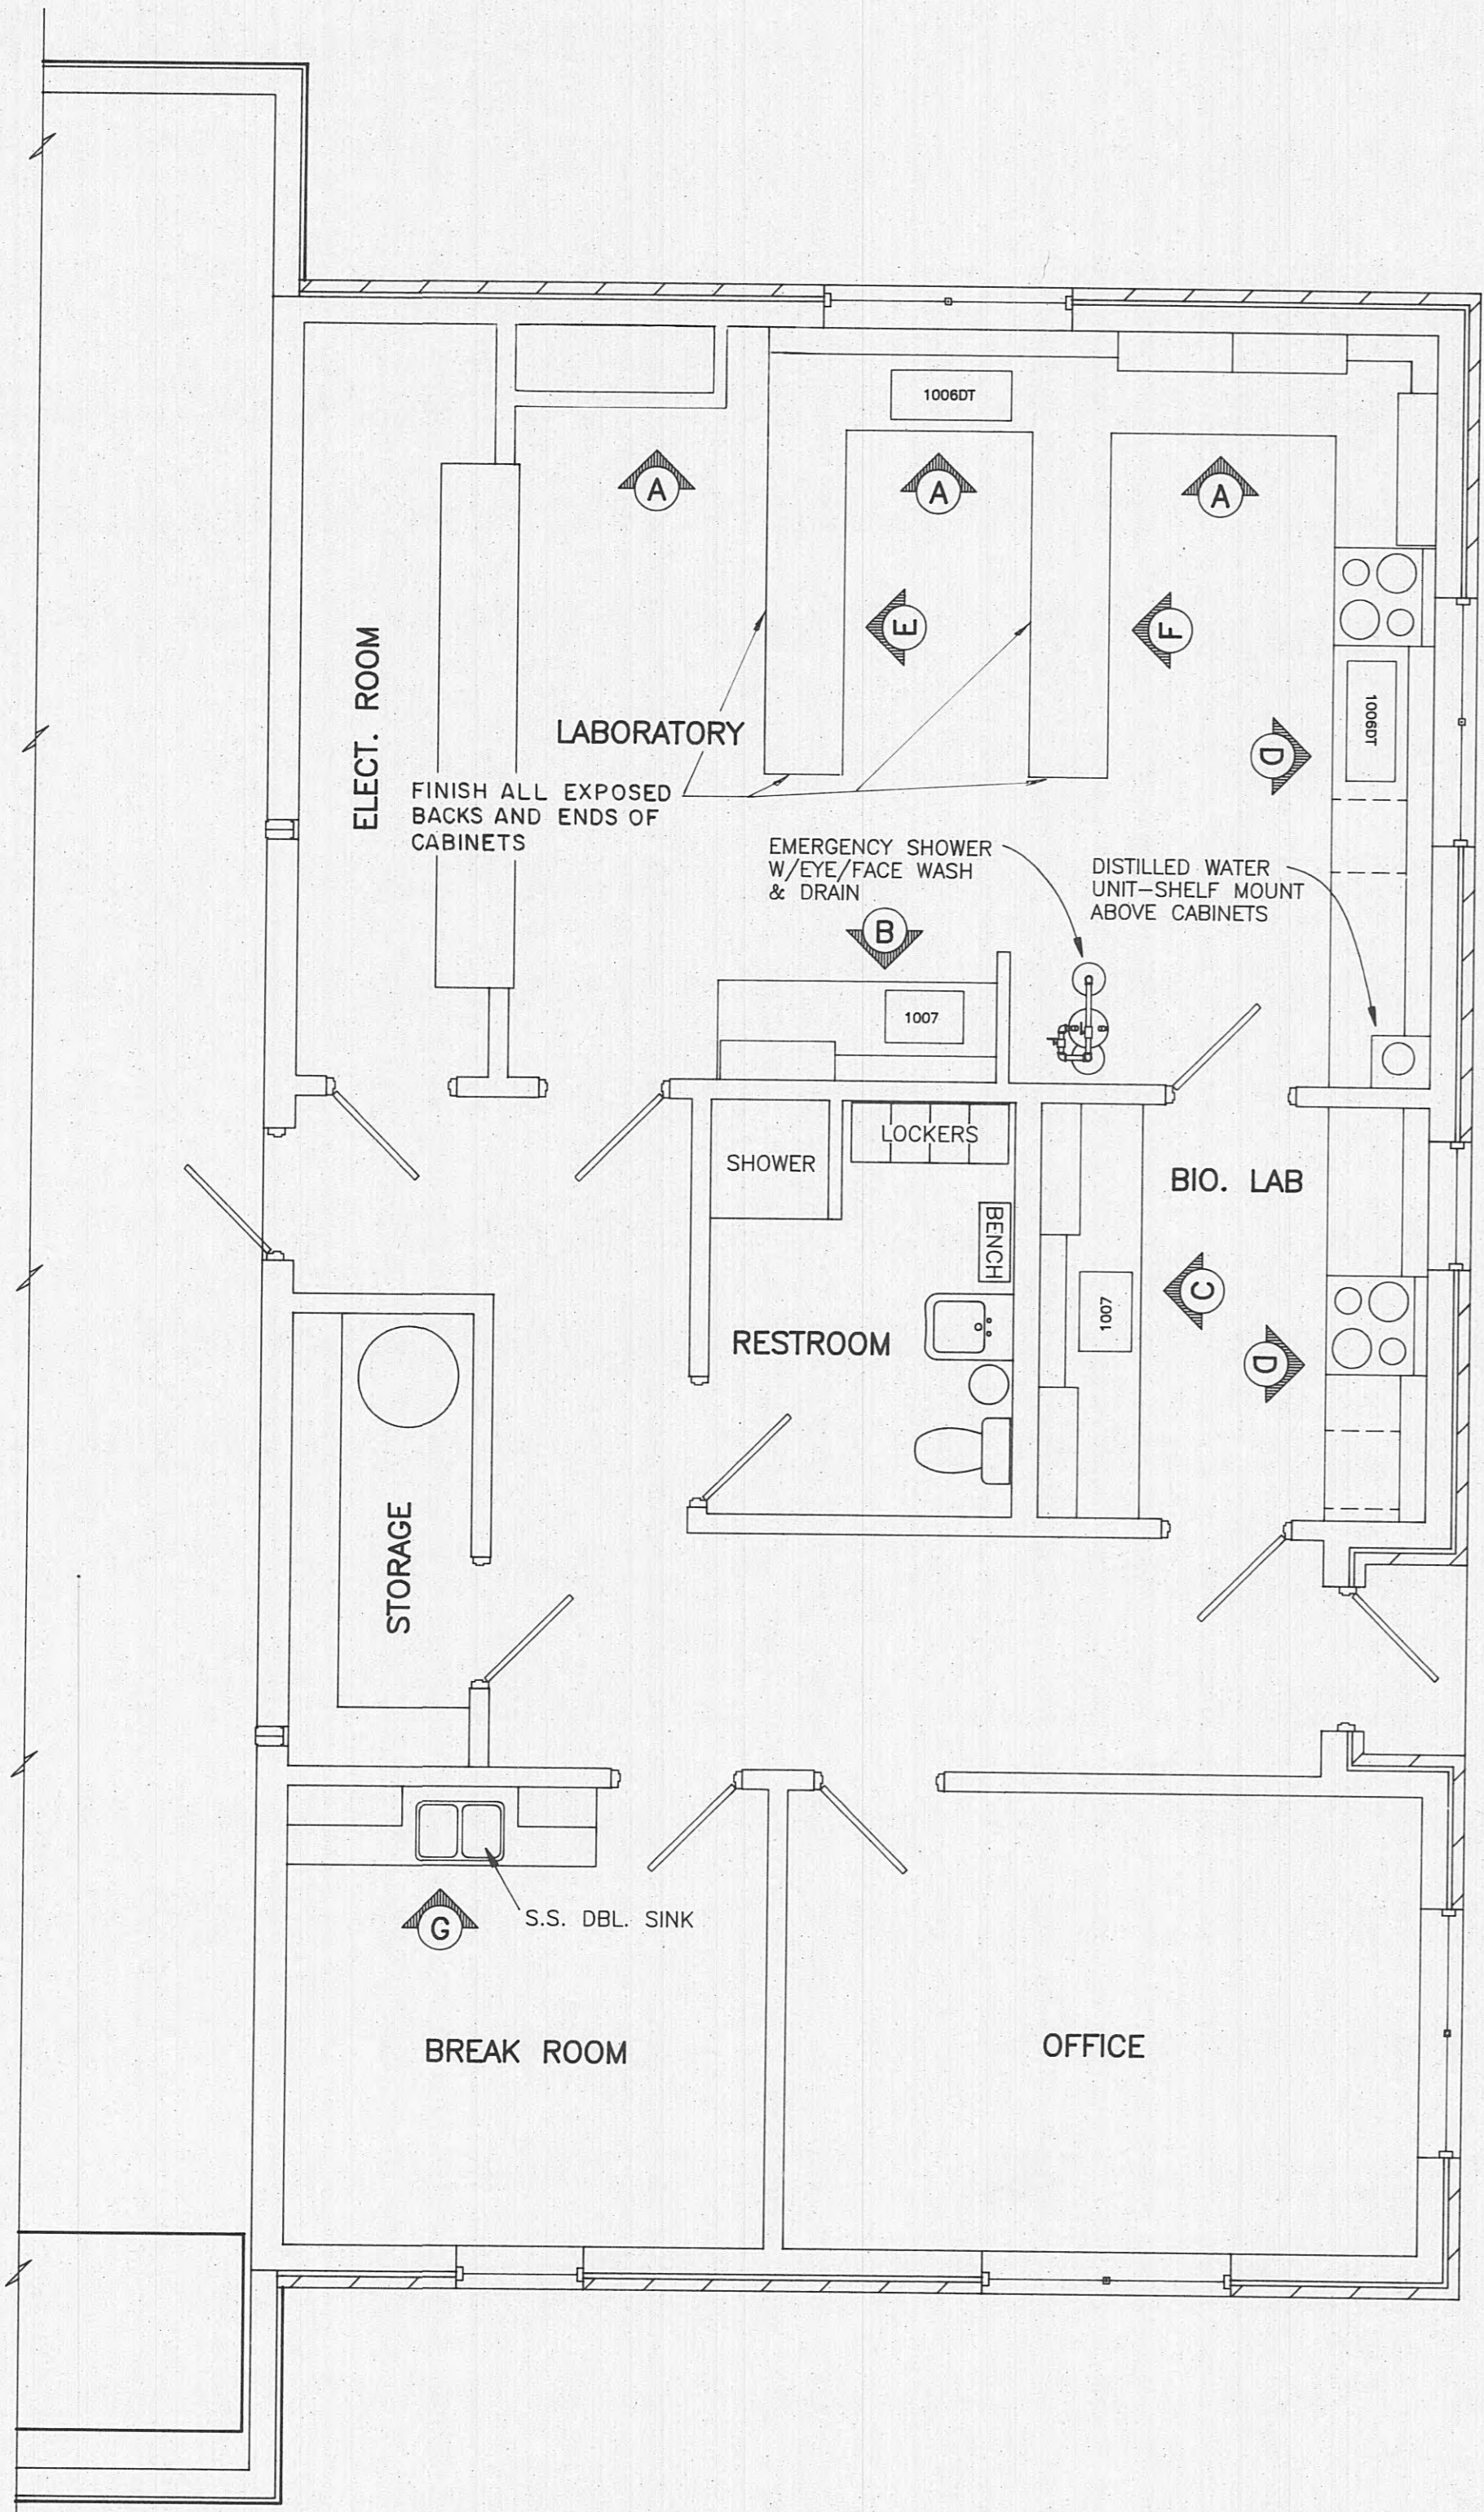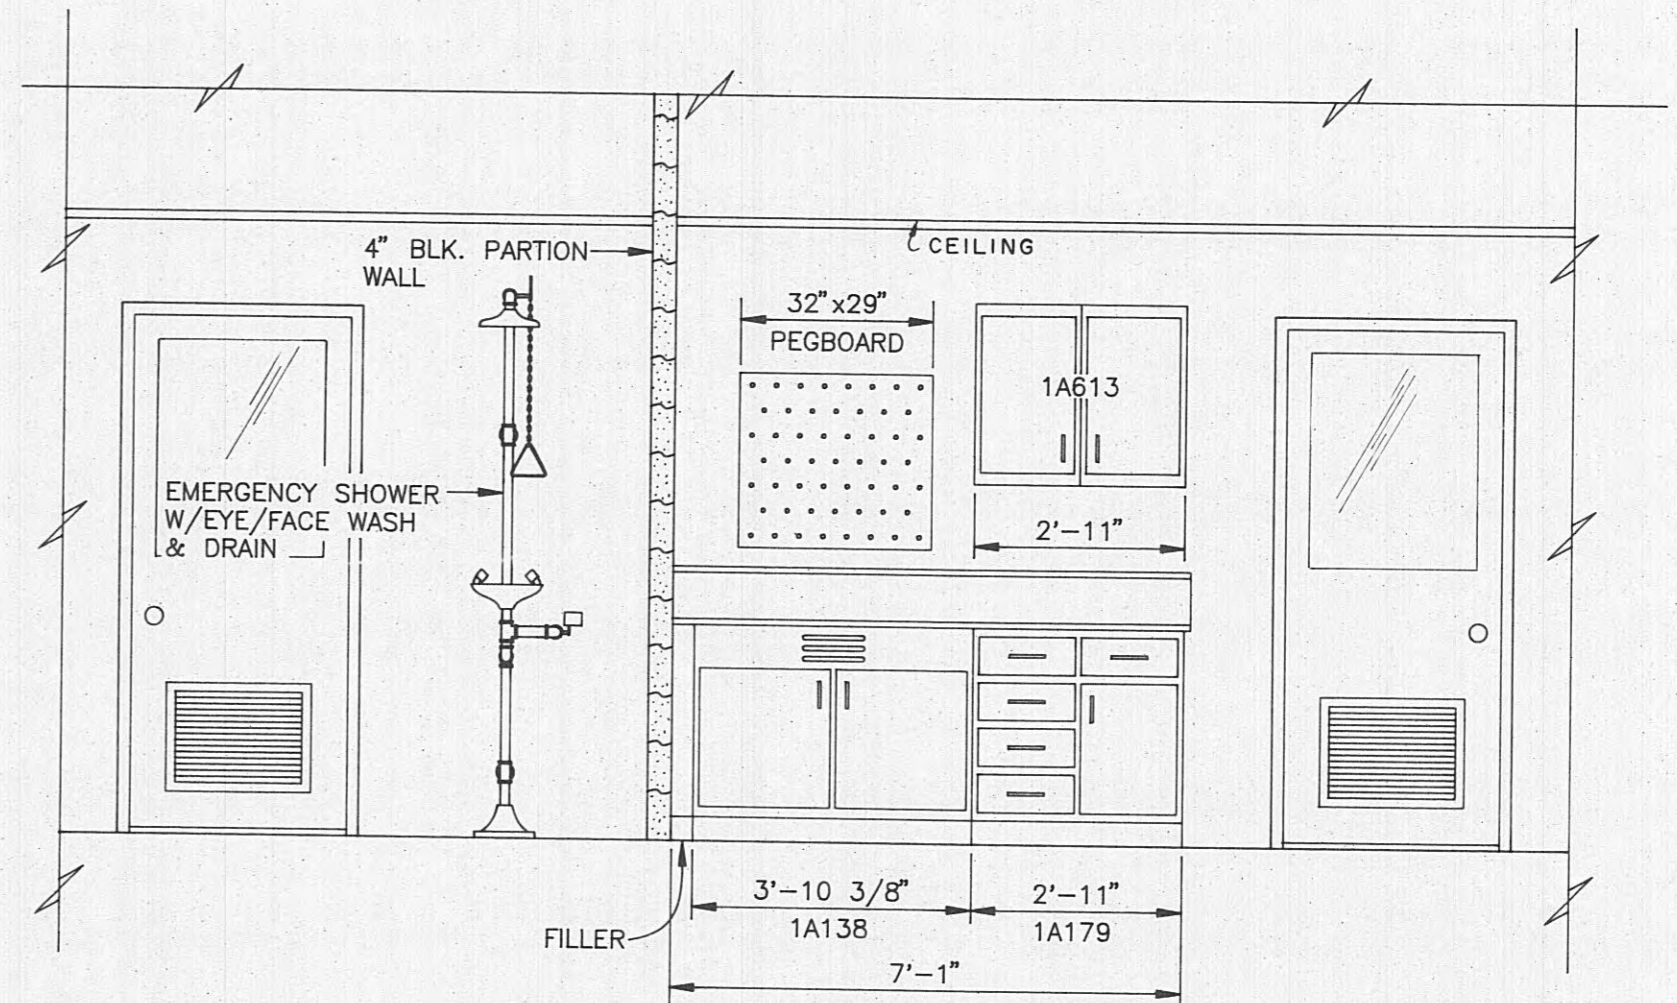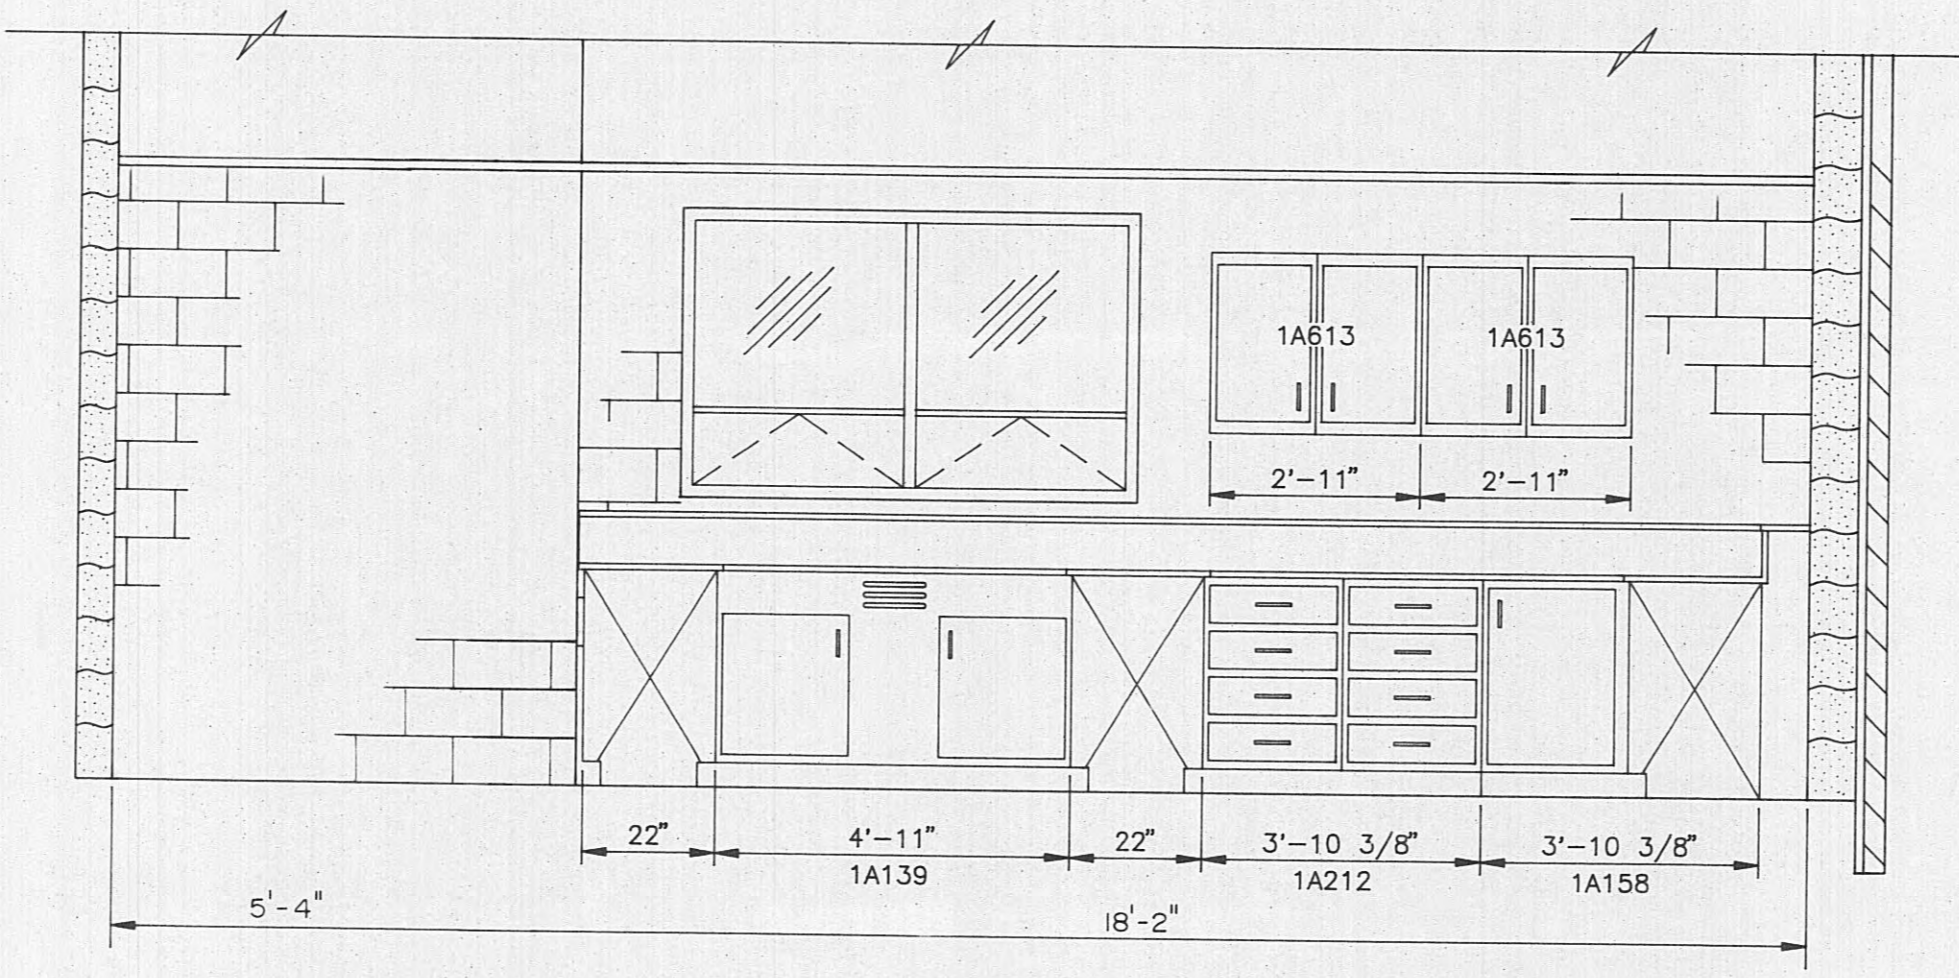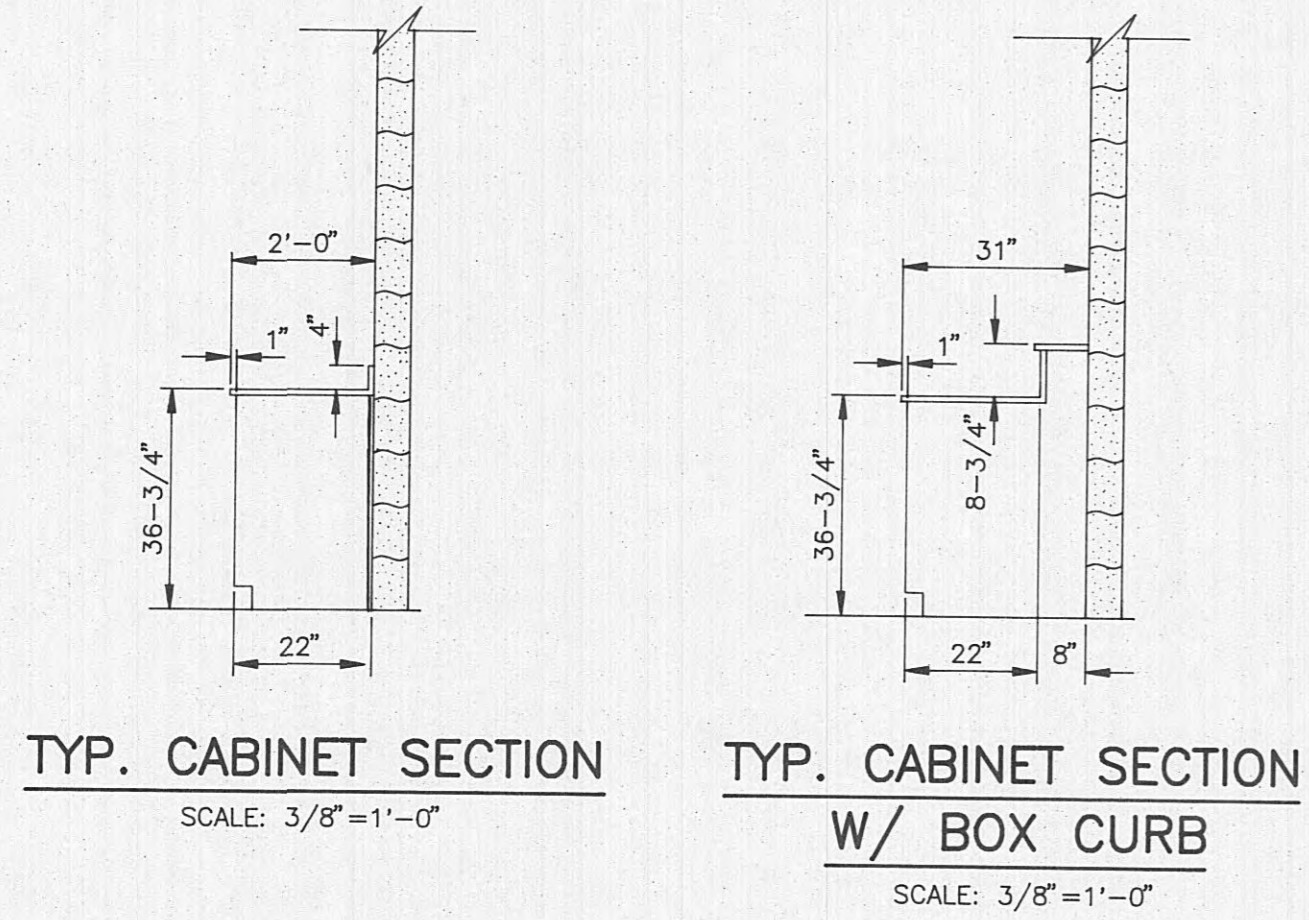


ELROD · DUNSON, INC.
CONSULTING ENGINEERS
NASHVILLE · KNOXVILLE
LEXINGTON, KY

CONTRACT W93-04
HARRIMAN, TENNESSEE
OPERATIONS BLDG. - FLOOR PLAN AND INTERIOR DETAILS


REVISIONS

DESIGNED: L. E. R.
DRAWN: S. C. G.
CHECKED: L. E. R.
DATE: MARCH, 1993
SCALE: AS NOTED
PROJ. NO. 0592


AS BUILT
DATE: 3-20-95
APPROVED: *D.M.*

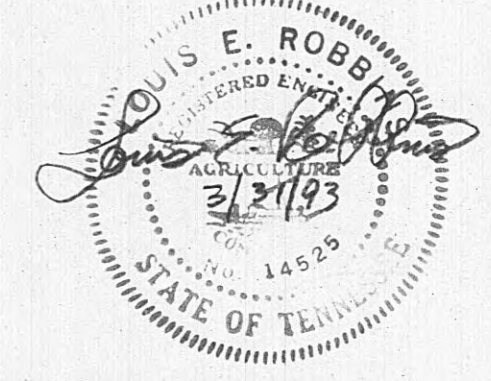


SHEET 5
OF 36

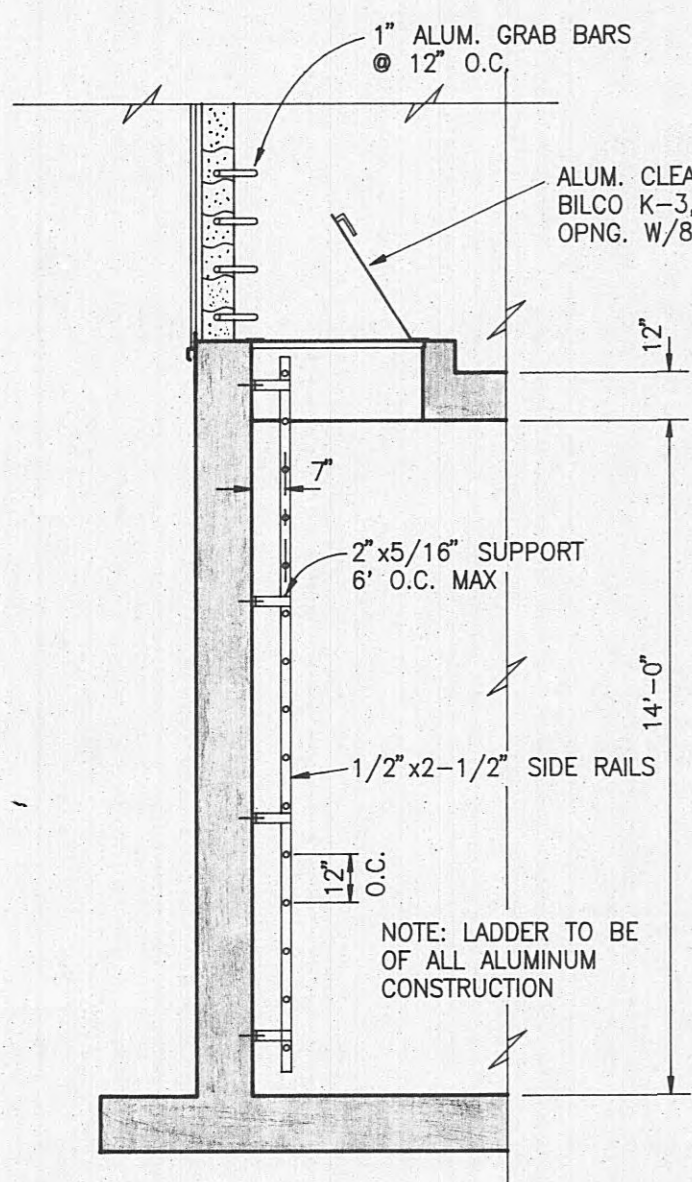


CLEARWELL LADDER DETAIL
SCALE: 1/4"=1'-0"

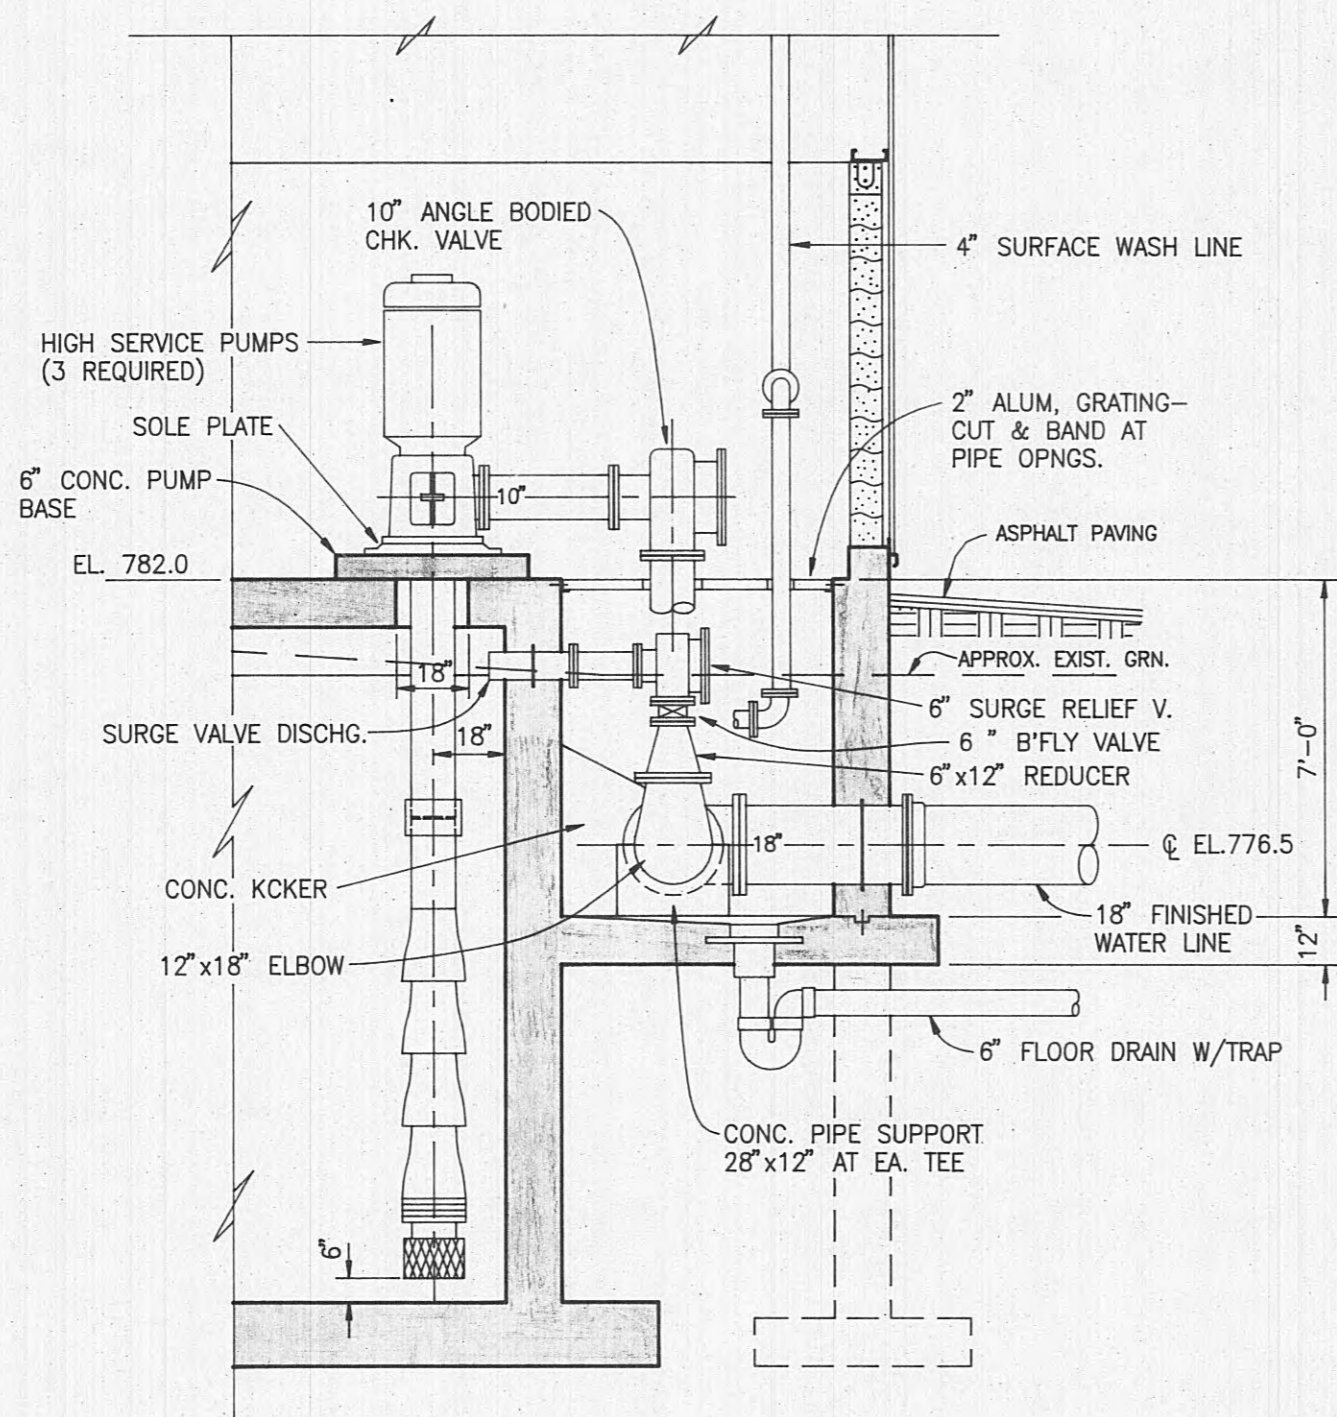

SECTION H-6
SCALE: 1/4"=1'-0"

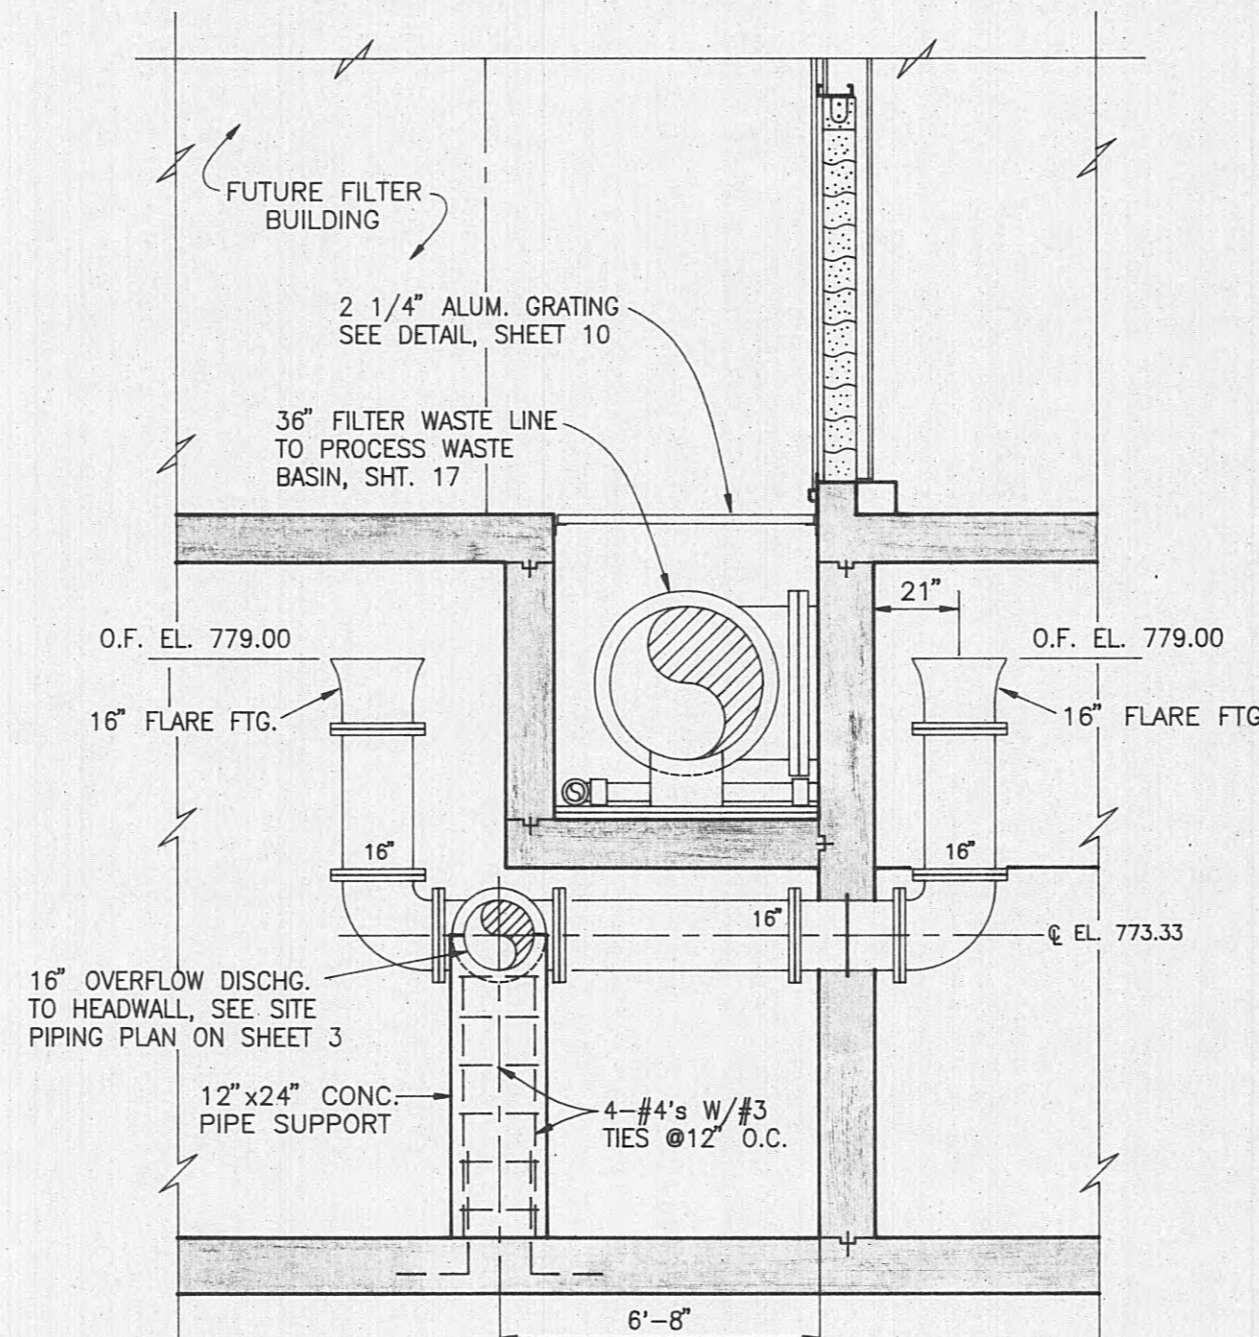


SECTION I-6
OVERFLOW PIPING DETAIL
SCALE: 1/4"=1'-0"

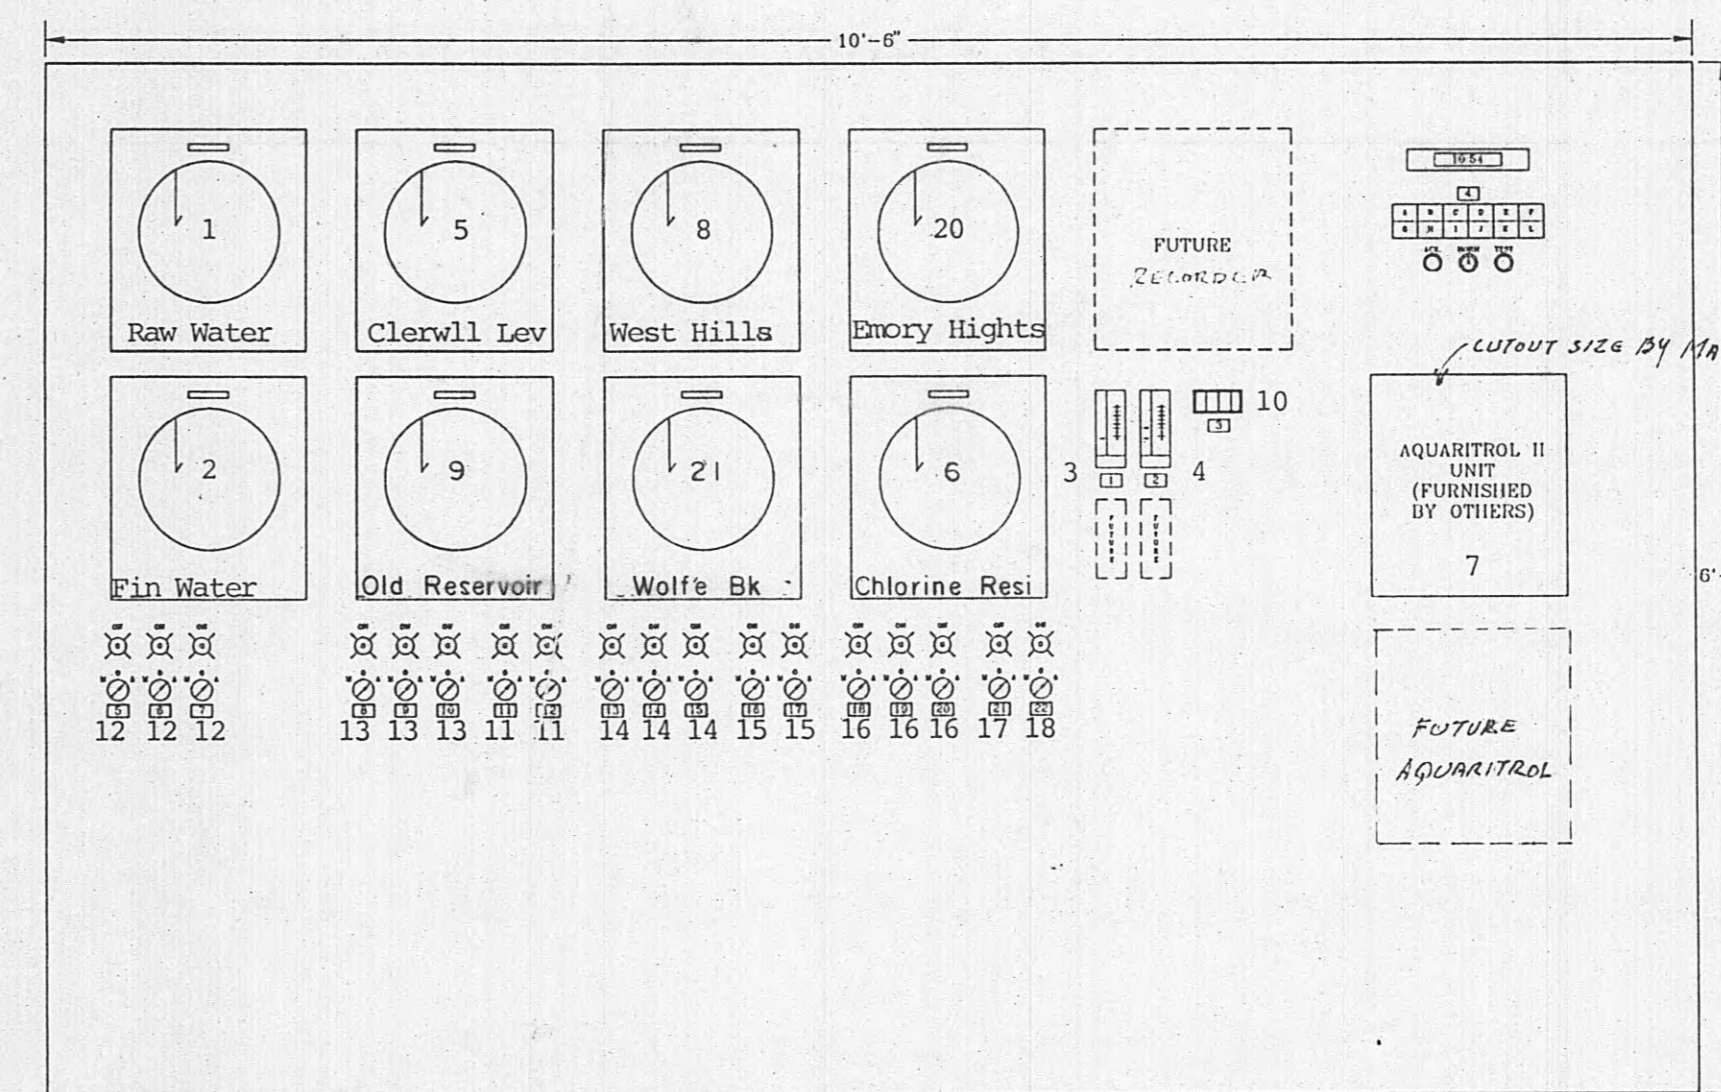


- MAIN CONTROL PANEL NAMEPLATE SCHEDULE**
- RAW WATER TURBIDITY
 - FINISHED WATER TURBIDITY
 - PROCESS WASTE BASIN LEVEL
 - ANNUNCIATOR
 - HIGH SERVICE PUMP NO.1
 - HIGH SERVICE PUMP NO.2
 - HIGH SERVICE PUMP NO.3
 - RAW WATER PUMP NO.1
 - RAW WATER PUMP NO.2
 - RAW WATER PUMP NO.3
 - DECANT PUMP NO.1
 - DECANT PUMP NO.2
 - CHLORINATOR NO.1
 - CHLORINATOR NO.2
 - MIXER
 - POLYMER FEED NO.1
 - POLYMER FEED NO.2
 - CARBON FEEDER NO.1
 - CARBON FEEDER NO.2
 - CARBON FEEDER NO.3
 - CORROSION INHIBITOR FEED PUMP
 - FLUORIDE FEED PUMP

- ANNUNCIATOR SCHEDULE**
- HIGH RAW WATER TURBIDITY
 - HIGH FINISHED WATER TURBIDITY
 - HIGH/LOW PH
 - LOW CHLORINE RESIDUAL
 - CLEARWELL LOW LEVEL
 - CLEARWELL HIGH LEVEL
 - PROCESS WASTE BASIN HIGH LEVEL
 - OLD RESERVOIR TANK HIGH LEVEL
 - OLD RESERVOIR TANK LOW LEVEL
 - CHLORINE LEAK ALARM
 - "BLANK"
 - "BLANK"

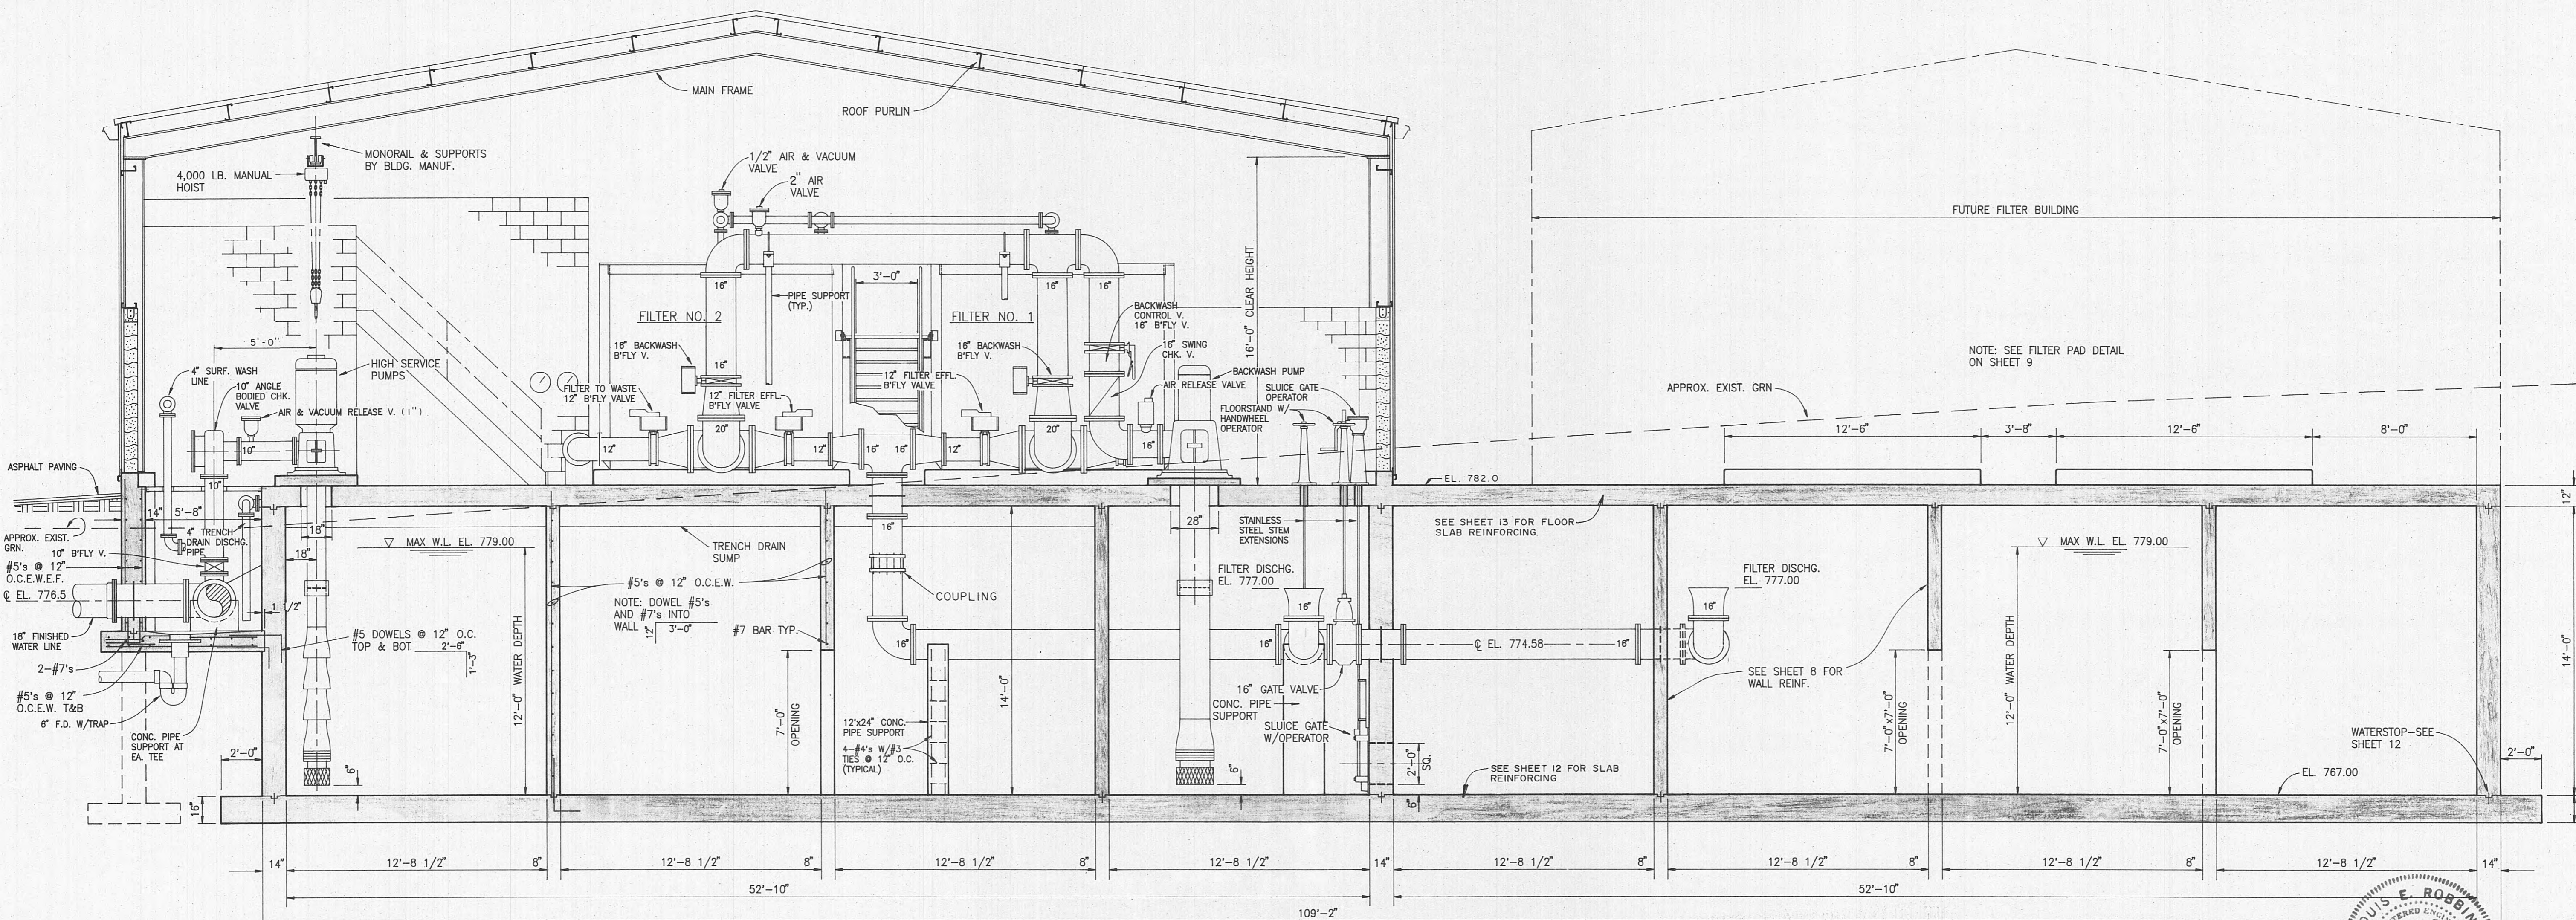


SECTION A-6
SCALE: 1/4"=1'-0"

AS BUILT
DATE: 3-20-95
APPROVED: *D.M.*

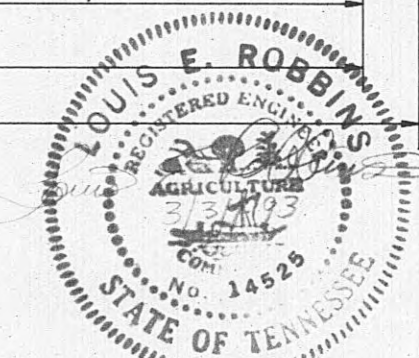

REVISIONS
4/19/93
ADDED TRENCH DRAIN AND OVER-FLOW PIPING DET'L







DESIGNED: L.E.R.
DRAWN: S.C.G.
CHECKED: L.E.R.
DATE: MARCH, 1993
SCALE: NOTED
PROJ. NO. 0592

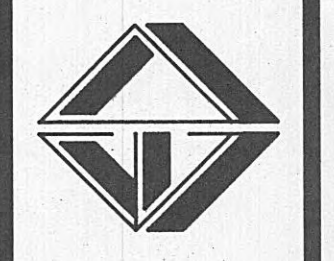

REVISIONS

4-19-93 ADDED 36" PIPE TRENCH AND TRENCH DRAIN

DESIGNED: L.E.R.
DRAWN: S.C.G.
CHECKED: L.E.R.
DATE: MARCH, 1993
SCALE: NOTED
PROJ. NO. 0592

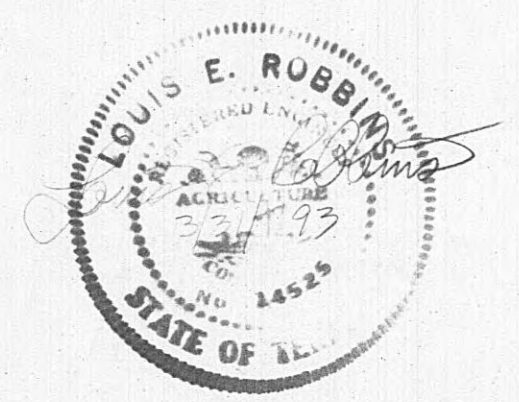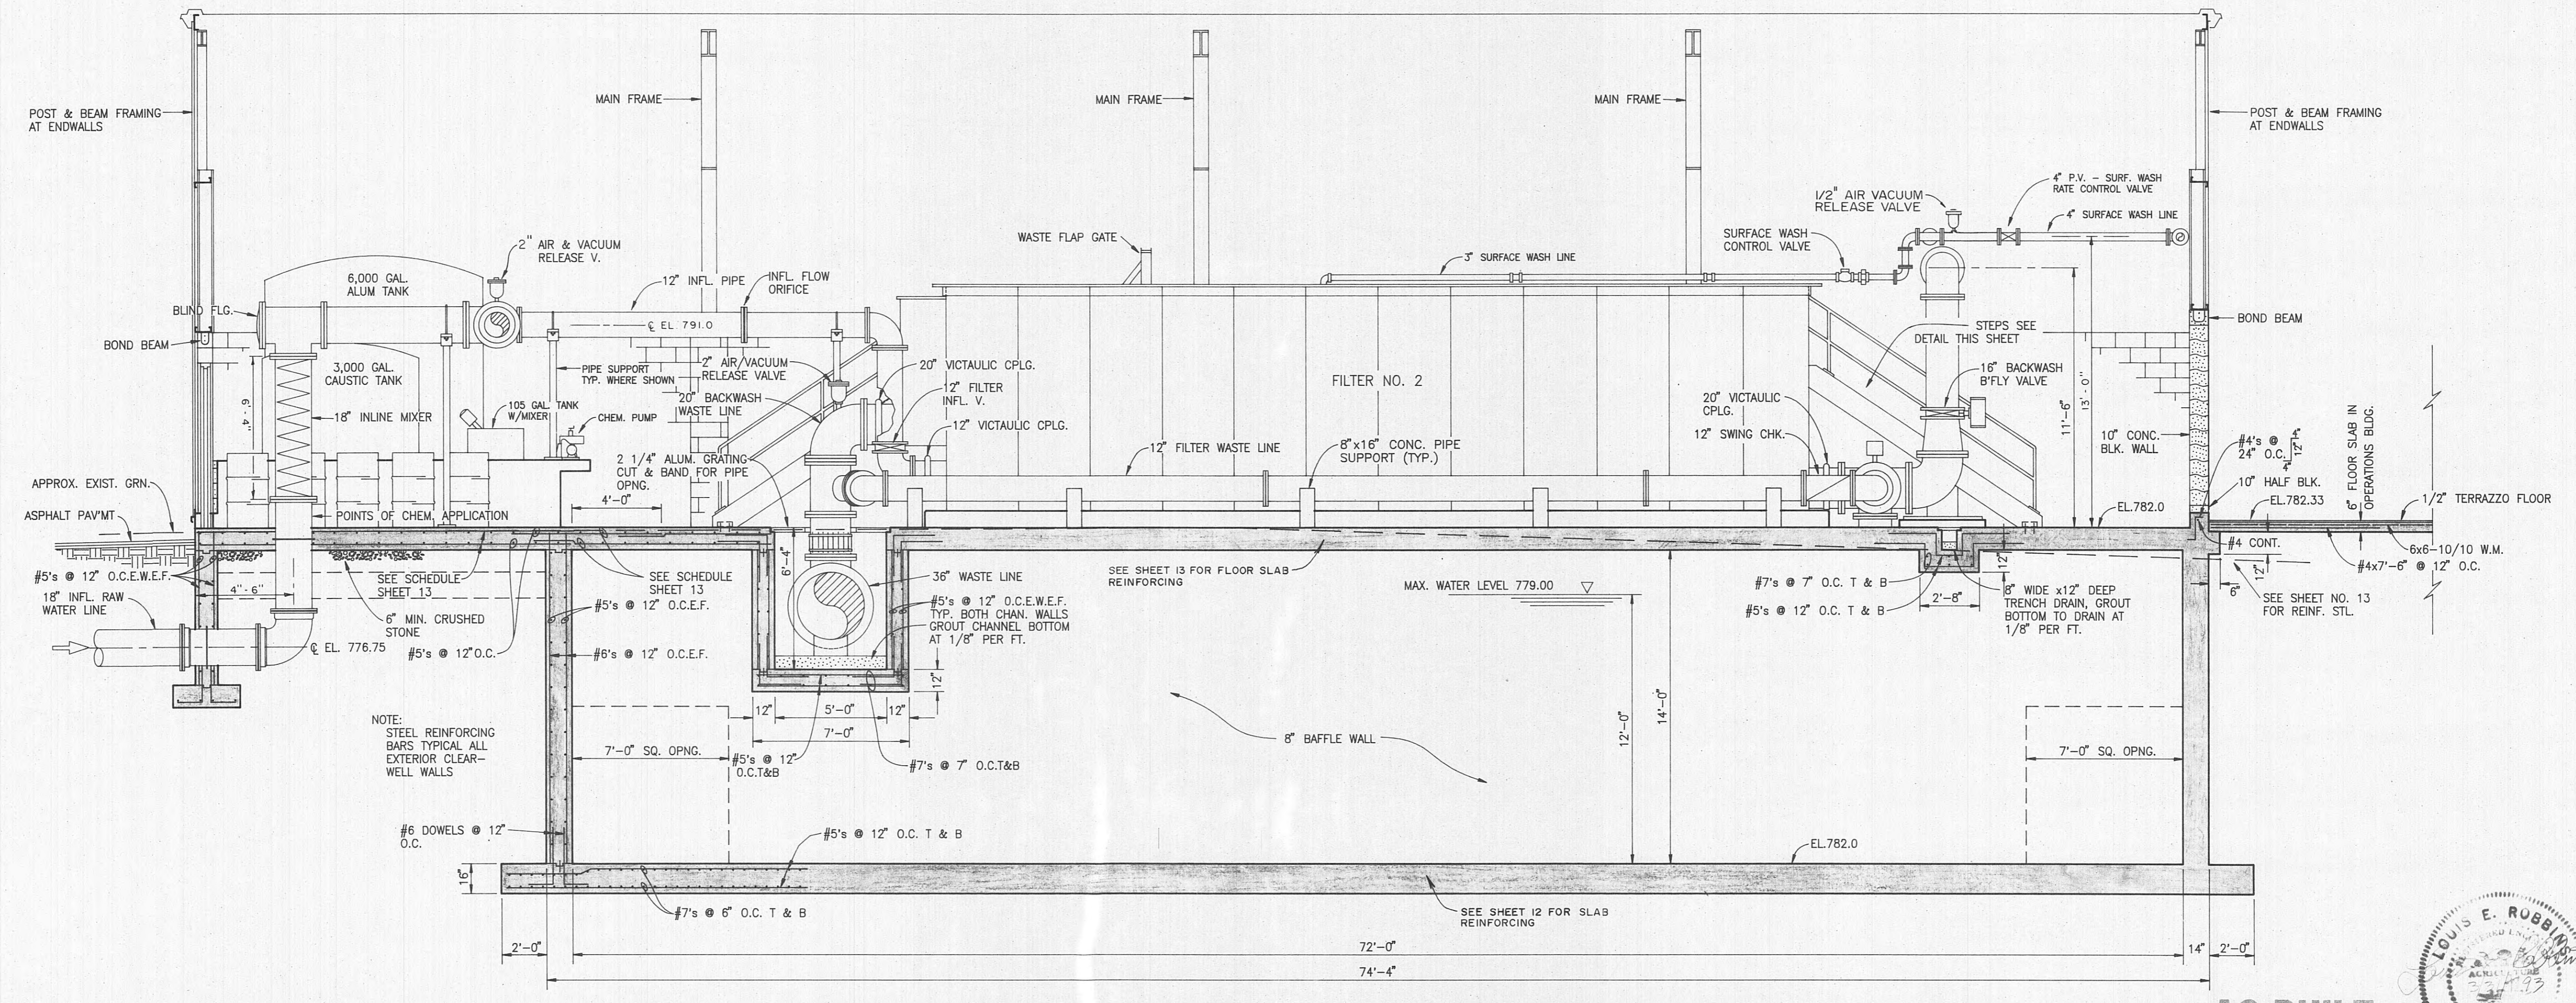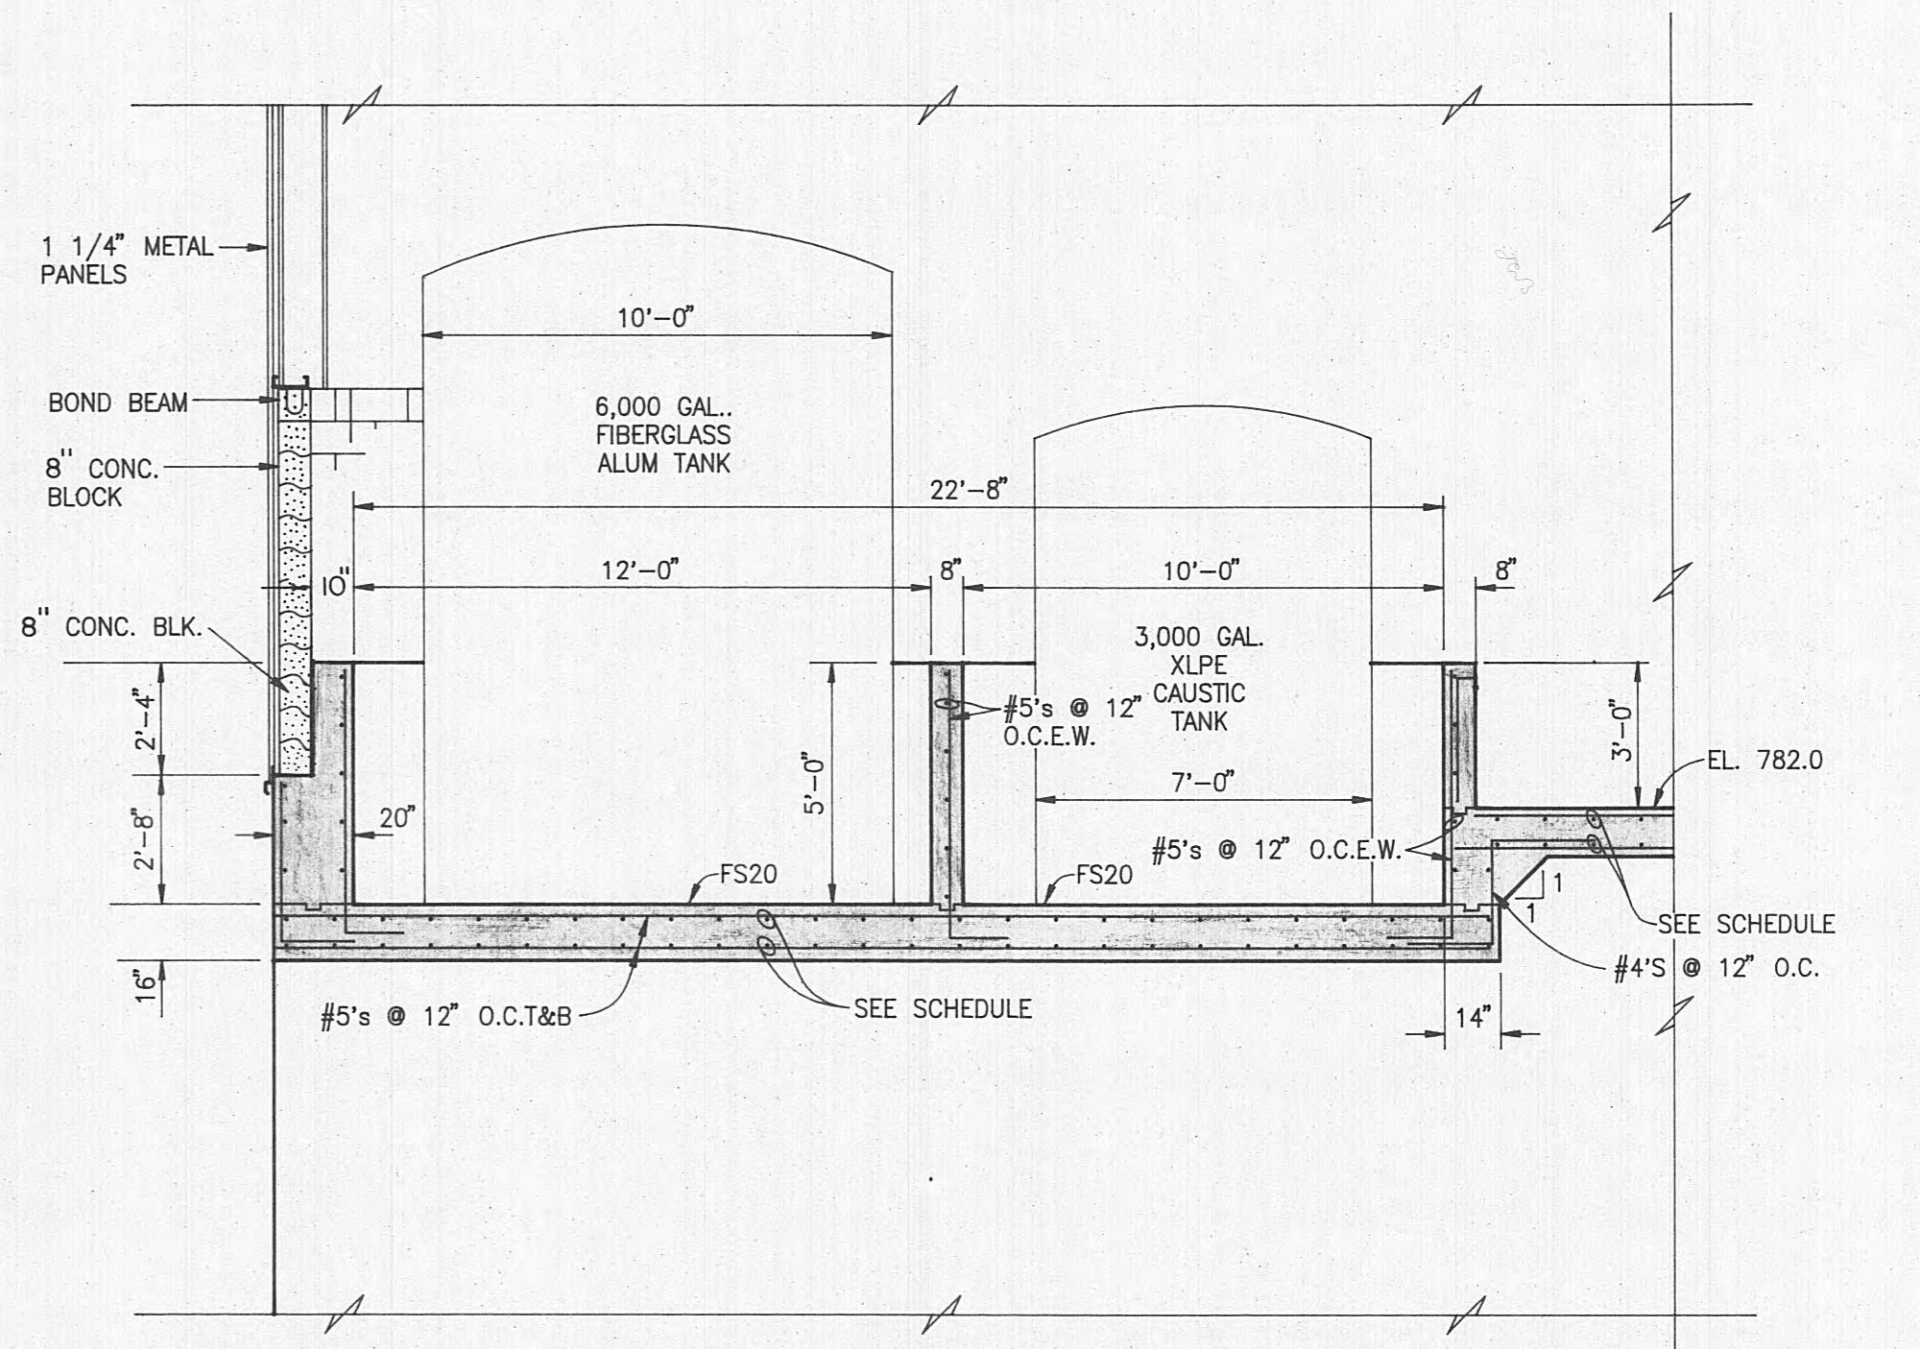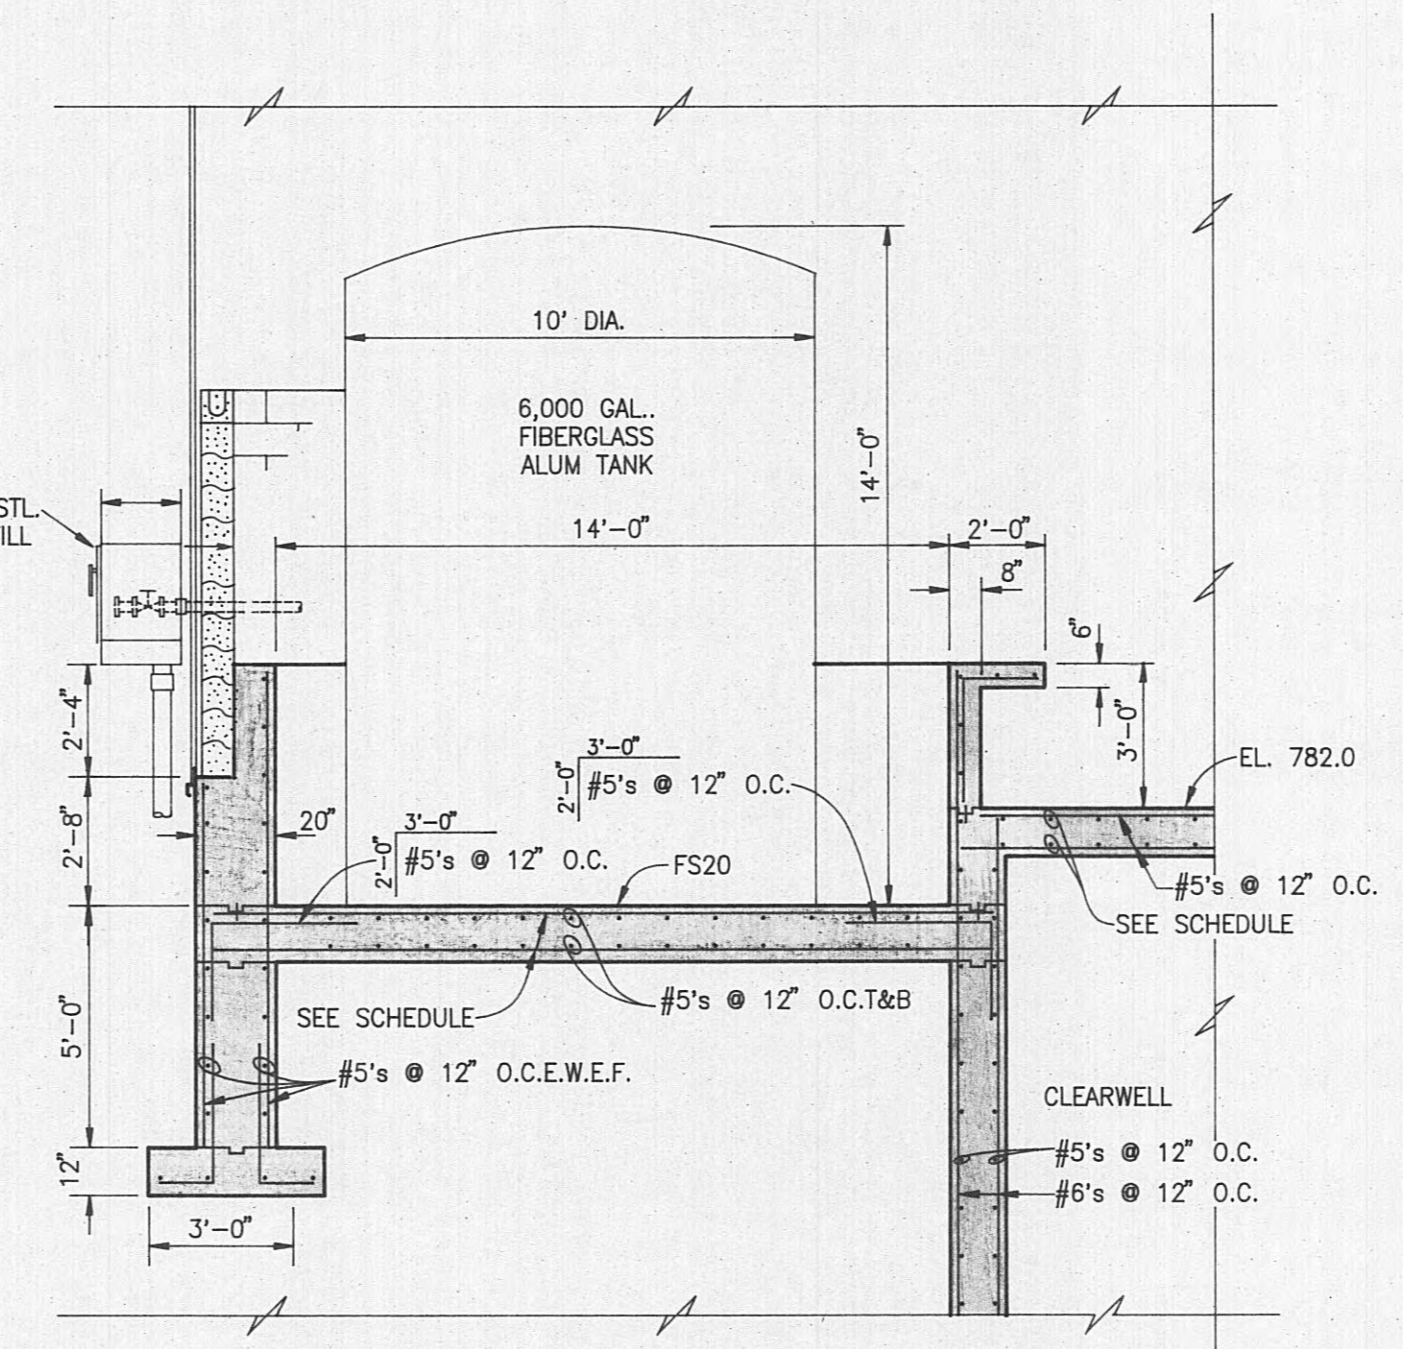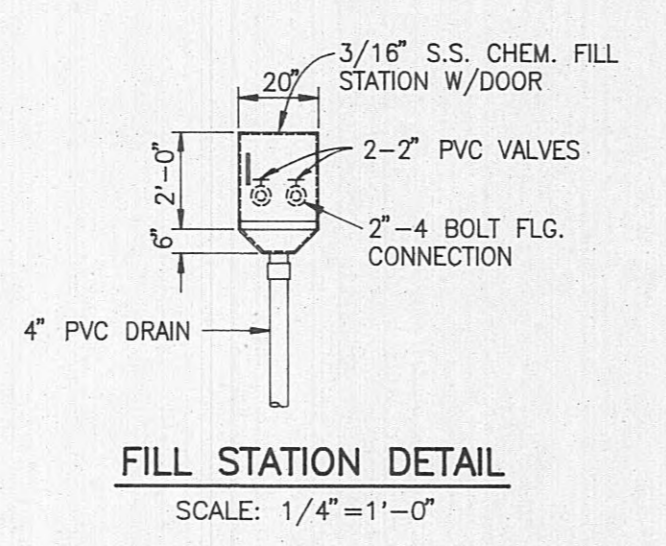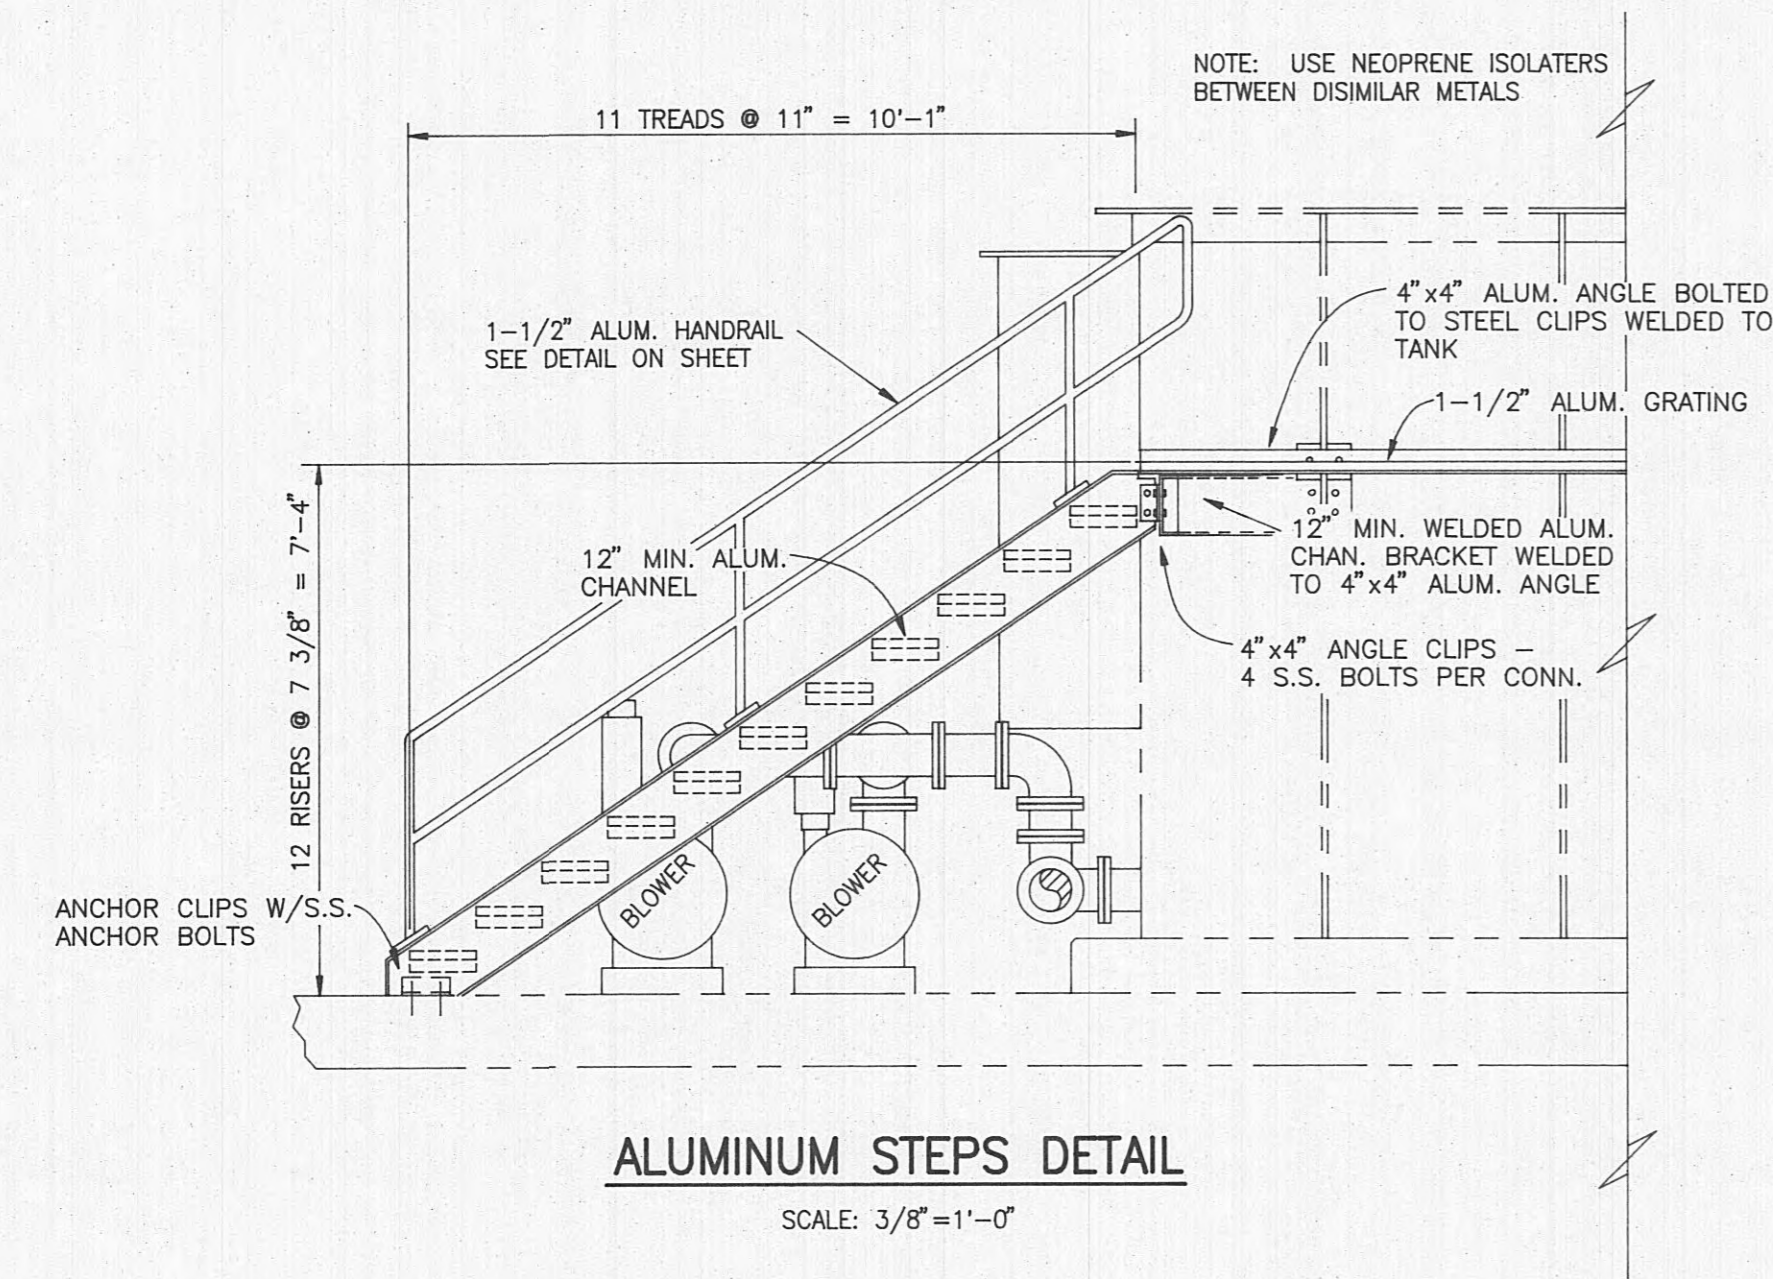

AS BUILT
DATE: 3-20-95
APPROVED: D.M.

